



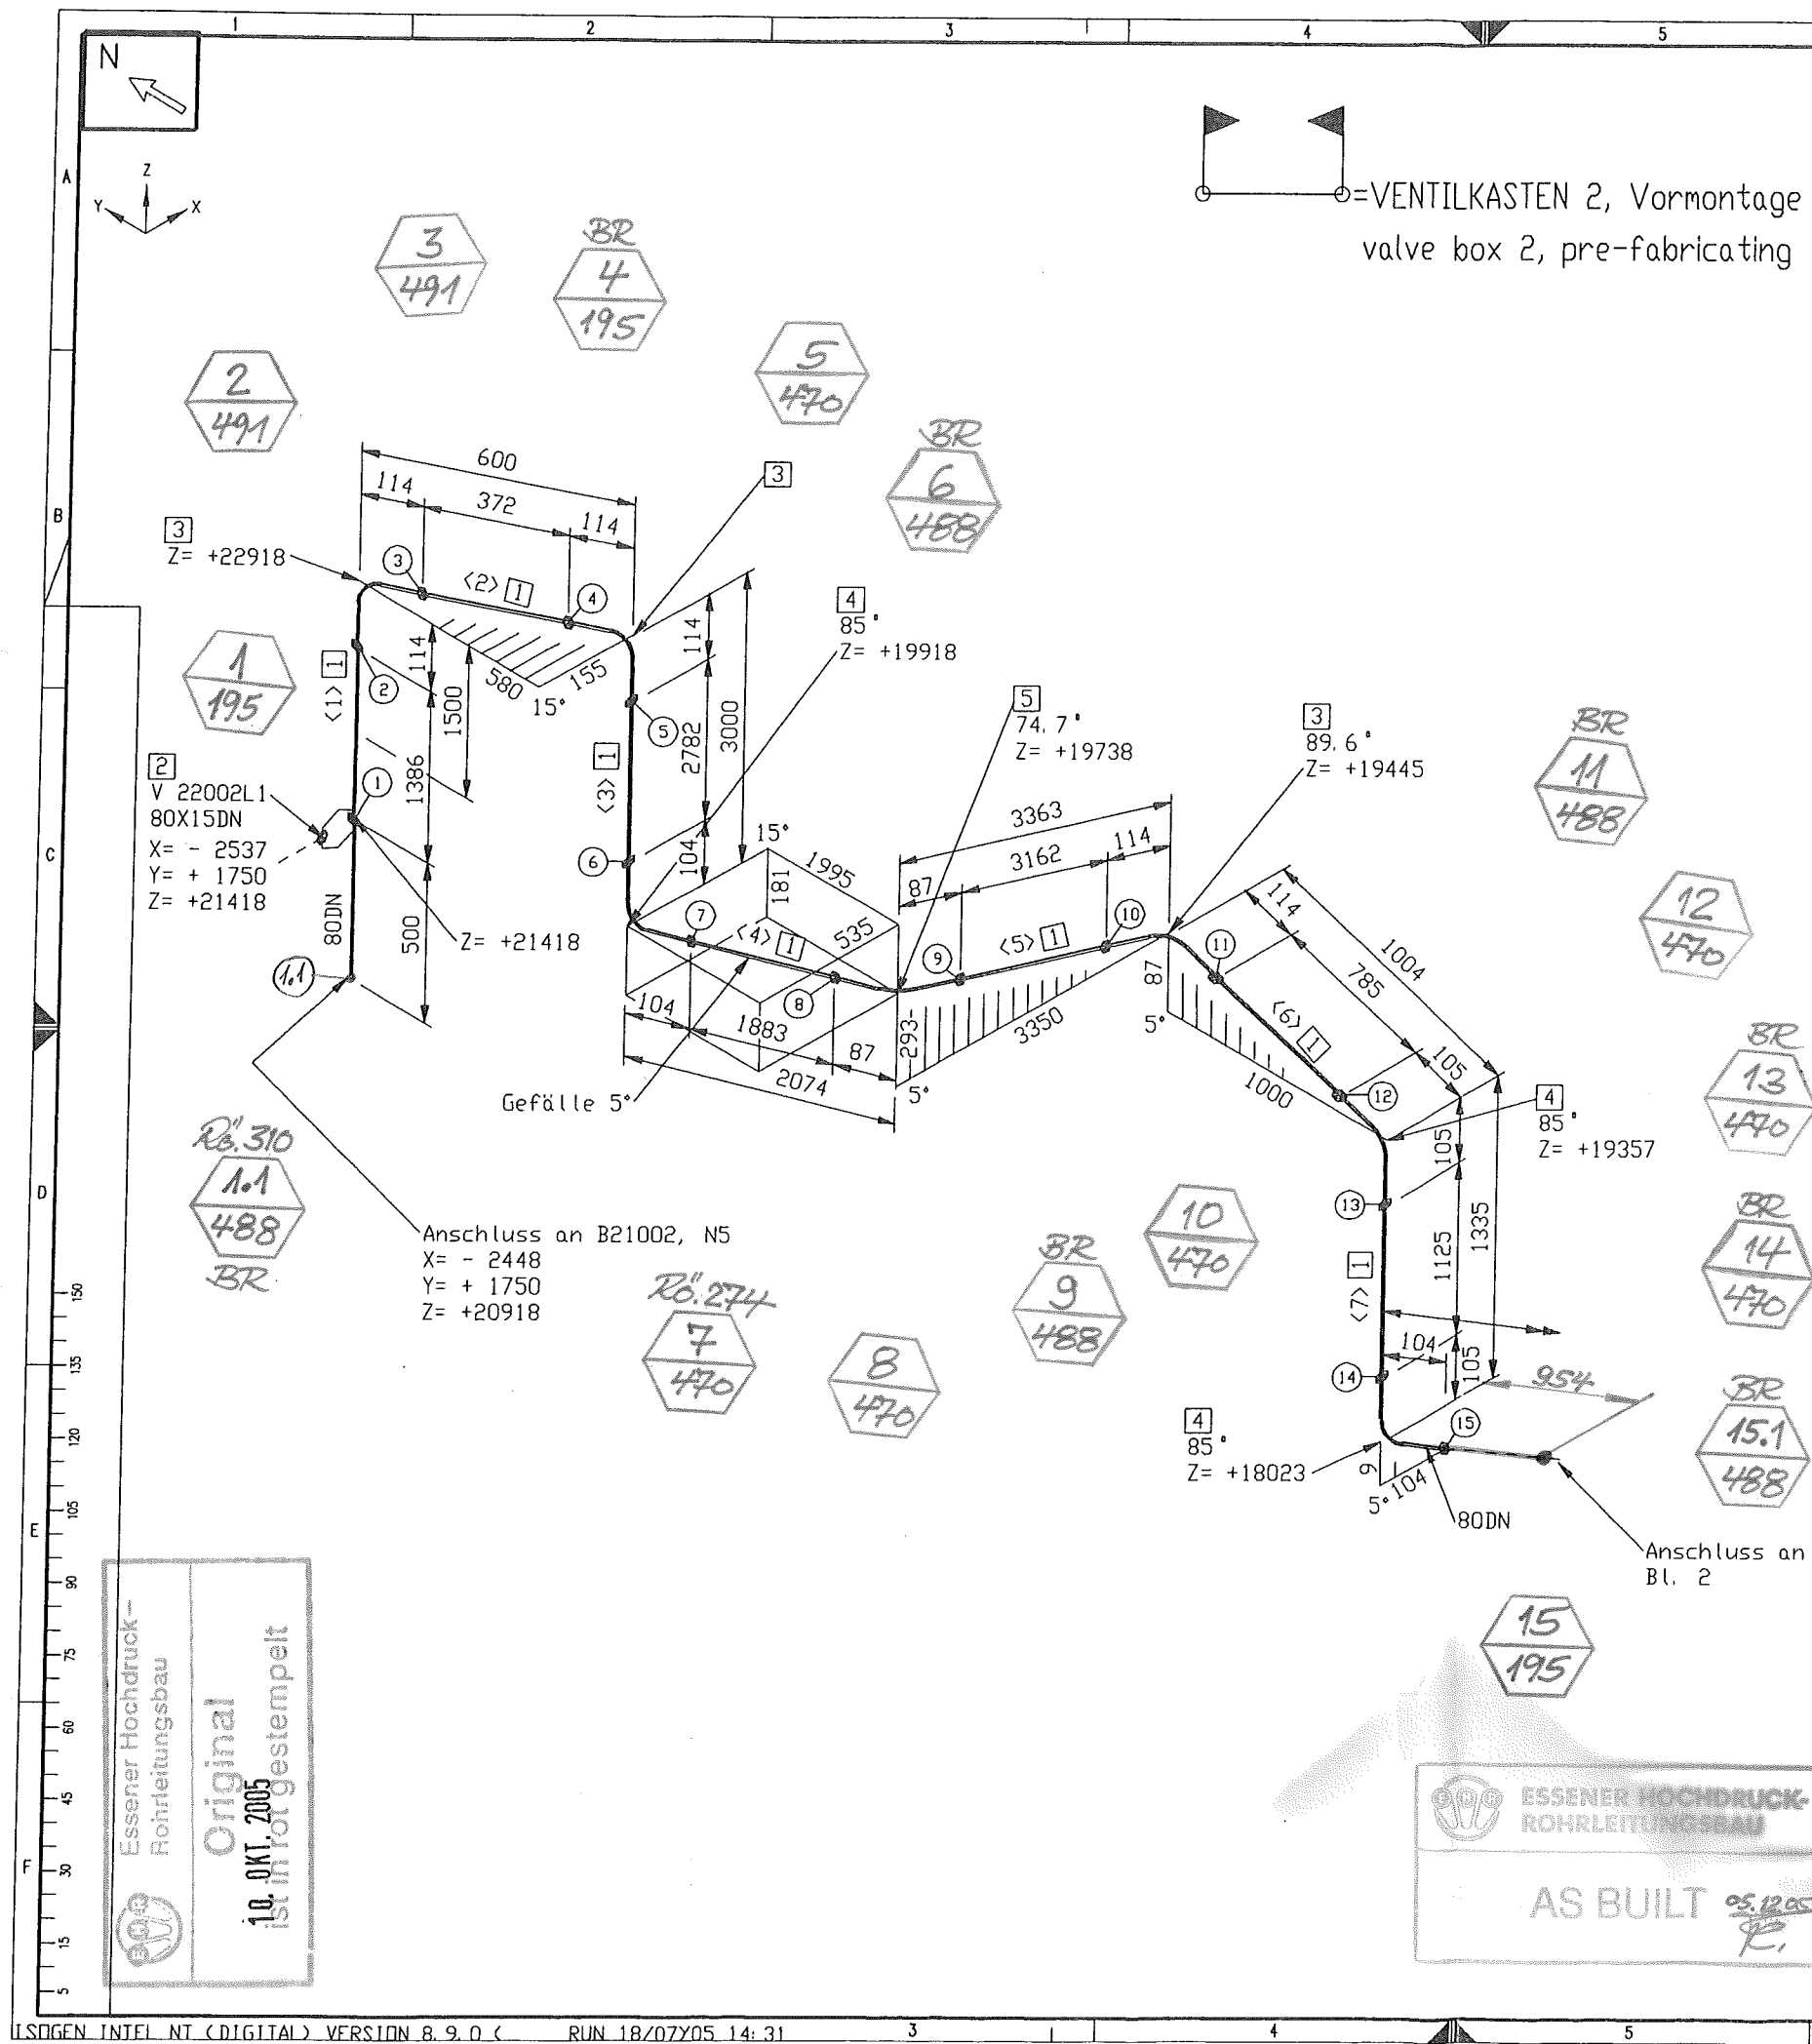

| Stückliste  |                                          |         |            |          |              |
|-------------|------------------------------------------|---------|------------|----------|--------------|
| Lfd Nr.     | Benennung                                | DN (MM) | Sachnummer | Menge    | Gewicht (kg) |
| 1           | Rohr 88,9 X 5,5 ALMG4, 5MN W27           | 80      | 77038147   | 17616 MM | 68.5         |
| Fitting     |                                          |         |            |          |              |
| 2           | MESS-STUTZEN                             | 80X15   | 793.10694  | 1        | 0.1          |
| 3           | BOGEN 88,9x5,5 DIN2605-2-90-3 ALMG4, 5MN | 80      | 77038156   | 4        | 2.8          |
| 4           | BOGEN 88,9x5,5 DIN2605-2-90-3 ALMG4, 5MN | 80      | 77038156_1 | 3        | 2.1          |
| 5           | Stutzen auf 85                           |         |            |          |              |
| 5           | BOGEN 88,9x5,5 DIN2605-2-90-3 ALMG4, 5MN | 80      | 77038156_2 | 1        | 0.7          |
| 6           | Stutzen auf 74.67                        |         |            |          |              |
| 6           | BOGEN 88,9x5,5 DIN2605-2-90-3 ALMG4, 5MN | 80      | 77038156_3 | 1        | 0.7          |
| 7           | Stutzen auf 70                           |         |            |          |              |
| 7           | BOGEN 88,9x5,5 DIN2605-2-90-3 ALMG4, 5MN | 80      | 77038156_4 | 1        | 0.7          |
| 8           | Stutzen auf 15                           |         |            |          |              |
| 8           | BOGEN 88,9x5,5 DIN2605-2-90-3 ALMG4, 5MN | 80      | 77038156_5 | 1        | 0.7          |
| 9           | Stutzen auf 45.87                        |         |            |          |              |
| 9           | BOGEN 88,9x5,5 DIN2605-2-90-3 ALMG4, 5MN | 80      | 77038156_6 | 1        | 0.7          |
| 10          | Stutzen auf 46.92                        |         |            |          |              |
| Ventil      |                                          |         |            |          |              |
| 10          | Eck-Ventil AL DN 80 / PN 40              | 80      | 770.38867  | 1        | 80.0         |
| Summe Masse |                                          |         |            |          | 157.0        |

| Rohrzuschnitt |            |         |           |             |             |            |
|---------------|------------|---------|-----------|-------------|-------------|------------|
| Rohr Stk.     | Länge (MM) | DN (MM) | Bemerkung | Rohr Ende 1 | Rohr Ende 2 | Sachnummer |
| <1>           | 501        | 80      |           |             |             | 77038147   |
| <2>           | 1385       | 80      |           |             |             | 77038147   |
| <3>           | 372        | 80      |           |             |             | 77038147   |
| <4>           | 2782       | 80      |           |             |             | 77038147   |
| <5>           | 1883       | 80      |           |             |             | 77038147   |
| <6>           | 3162       | 80      |           |             |             | 77038147   |
| <7>           | 785        | 80      |           |             |             | 77038147   |
| <8>           | 1125       | 80      |           |             |             | 77038147   |
| <9>           | 1336       | 80      |           |             |             | 77038147   |
| <10>          | 421        | 80      |           |             |             | 77038147   |
| <11>          | 1392       | 80      |           |             |             | 77038147   |
| <12>          | 1340       | 80      |           |             |             | 77038147   |
| <13>          | 772        | 80      |           |             |             | 77038147   |
| <14>          | 360        | 80      |           |             |             | 77038147   |

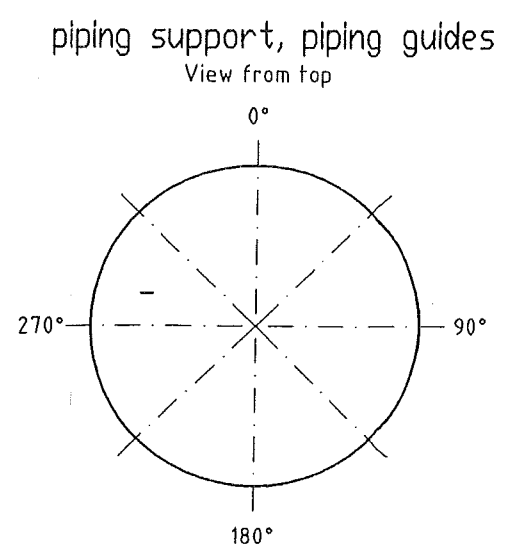

Rohr DN (MM) 80 15  
CL Länge (MM) 20023 89

|   |  |  |                                                               |  |                                                                      |  |
|---|--|--|---------------------------------------------------------------|--|----------------------------------------------------------------------|--|
| <b>E</b> MATERIAL: HANAU AL<br><b>D</b> Workpiece edges<br><b>C</b> $\pm 0.5$ $\pm 0.3$<br><b>B</b> outside inside<br><b>A</b> |  |  | SCALE<br>TOLERANCES:<br>DN 28005<br>DN 8570<br>DN 7168 mittel |  | All components cleaned for oxygen<br>Smilor:<br>Subst.:<br>Replaced: |  |
| DATE: 18.07.2005<br>NAME: H.Schneider<br>CHECK: Frickhöfer 18/07/05                                                            |  |  | <b>AIR LIQUIDE</b>                                            |  |                                                                      |  |
| JOB CODE / REFERENCE:<br>K70101, ASU No.9 Kosice                                                                               |  |  | SHEET: 1 OF SHEET: 2                                          |  |                                                                      |  |
| Title:<br>N 21019   |  |  | DRAWING No.:<br>79319828                                      |  |                                                                      |  |

This drawing is not to be reproduced, copied or used directly or indirectly in any way detrimental to our interests unless specifically authorized in writing by  
 Air Liquide AGS GmbH Hanau