



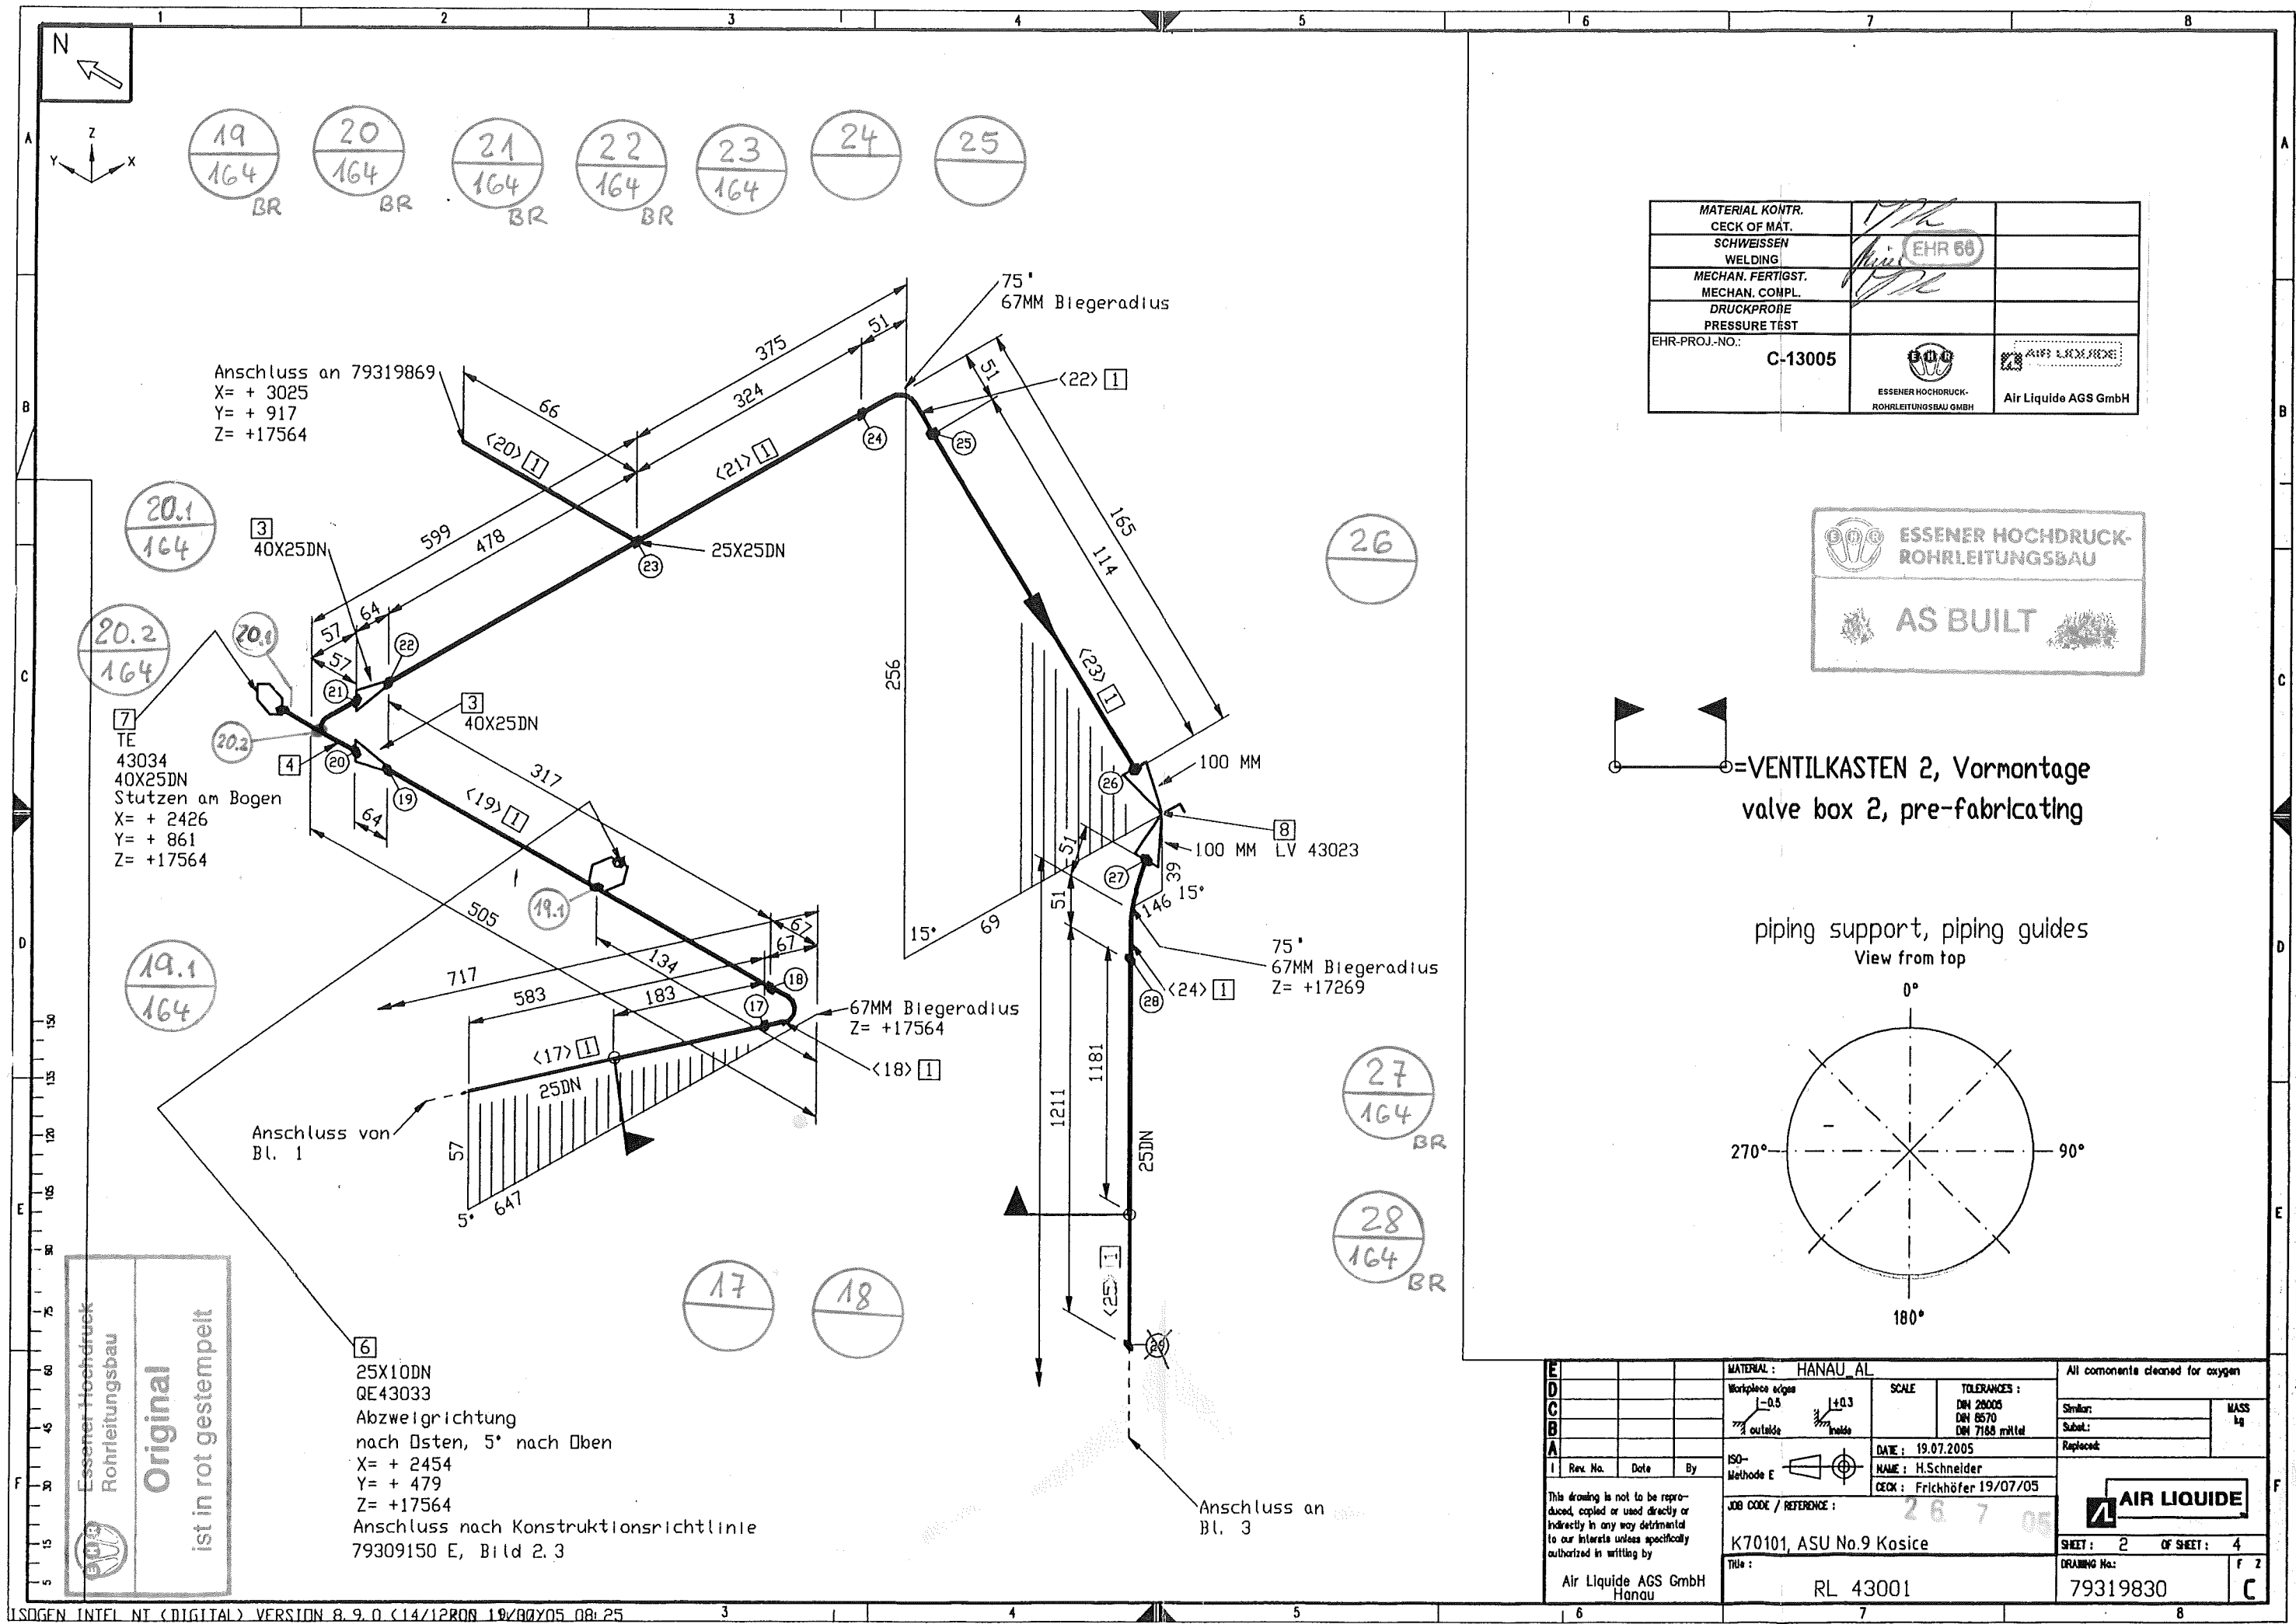


MATERIAL KONTR.		
CHECK OF MAT.		
SCHWEISSEN		
WELDING		
MECHAN. FERTIGST.		
MECHAN. COMPL.		
DRUCKPROBE		
PRESSURE TEST		
EHR-PROJ.-NO.:	C-13005	

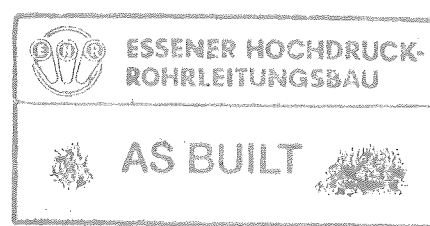

= VENTILKASTEN 2, Vormontage
valve box 2, pre-fabricating

piping support, piping guides
View from top

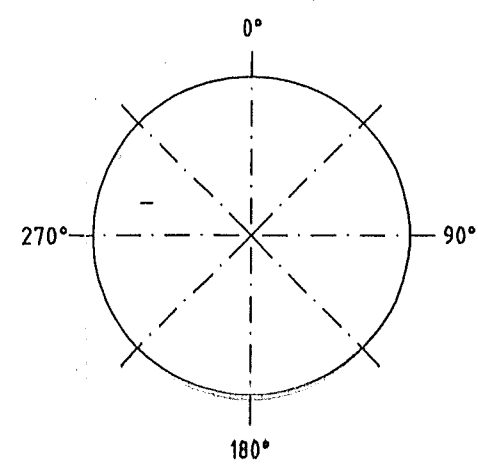

E			MATERIAL: HANAU AL		All components cleaned for oxygen	
D			Workpiece edges		SCALE	
C			-0.5		TOLERANCES:	
B			outside		DN 28005	
A			ISO-Methode E		DN 6570	
I			Rev. No.		DATE: 19.07.2005	
			Date		NAME: H.Schneider	
			By		CHECK: Frickhöfer 19/07/05	
			This drawing is not to be reproduced, copied or used directly or indirectly in any way detrimental to our interests unless specifically authorized in writing by		JOB CODE / REFERENCE:	
			Air Liquide AGS GmbH Hanau		K70101, ASU No.9 Kosice	
			Title:		26705	
			RL 43001		SHEET: 2 OF SHEET: 4	
					DRAWING No.: 79319830	
					F 2 C	