
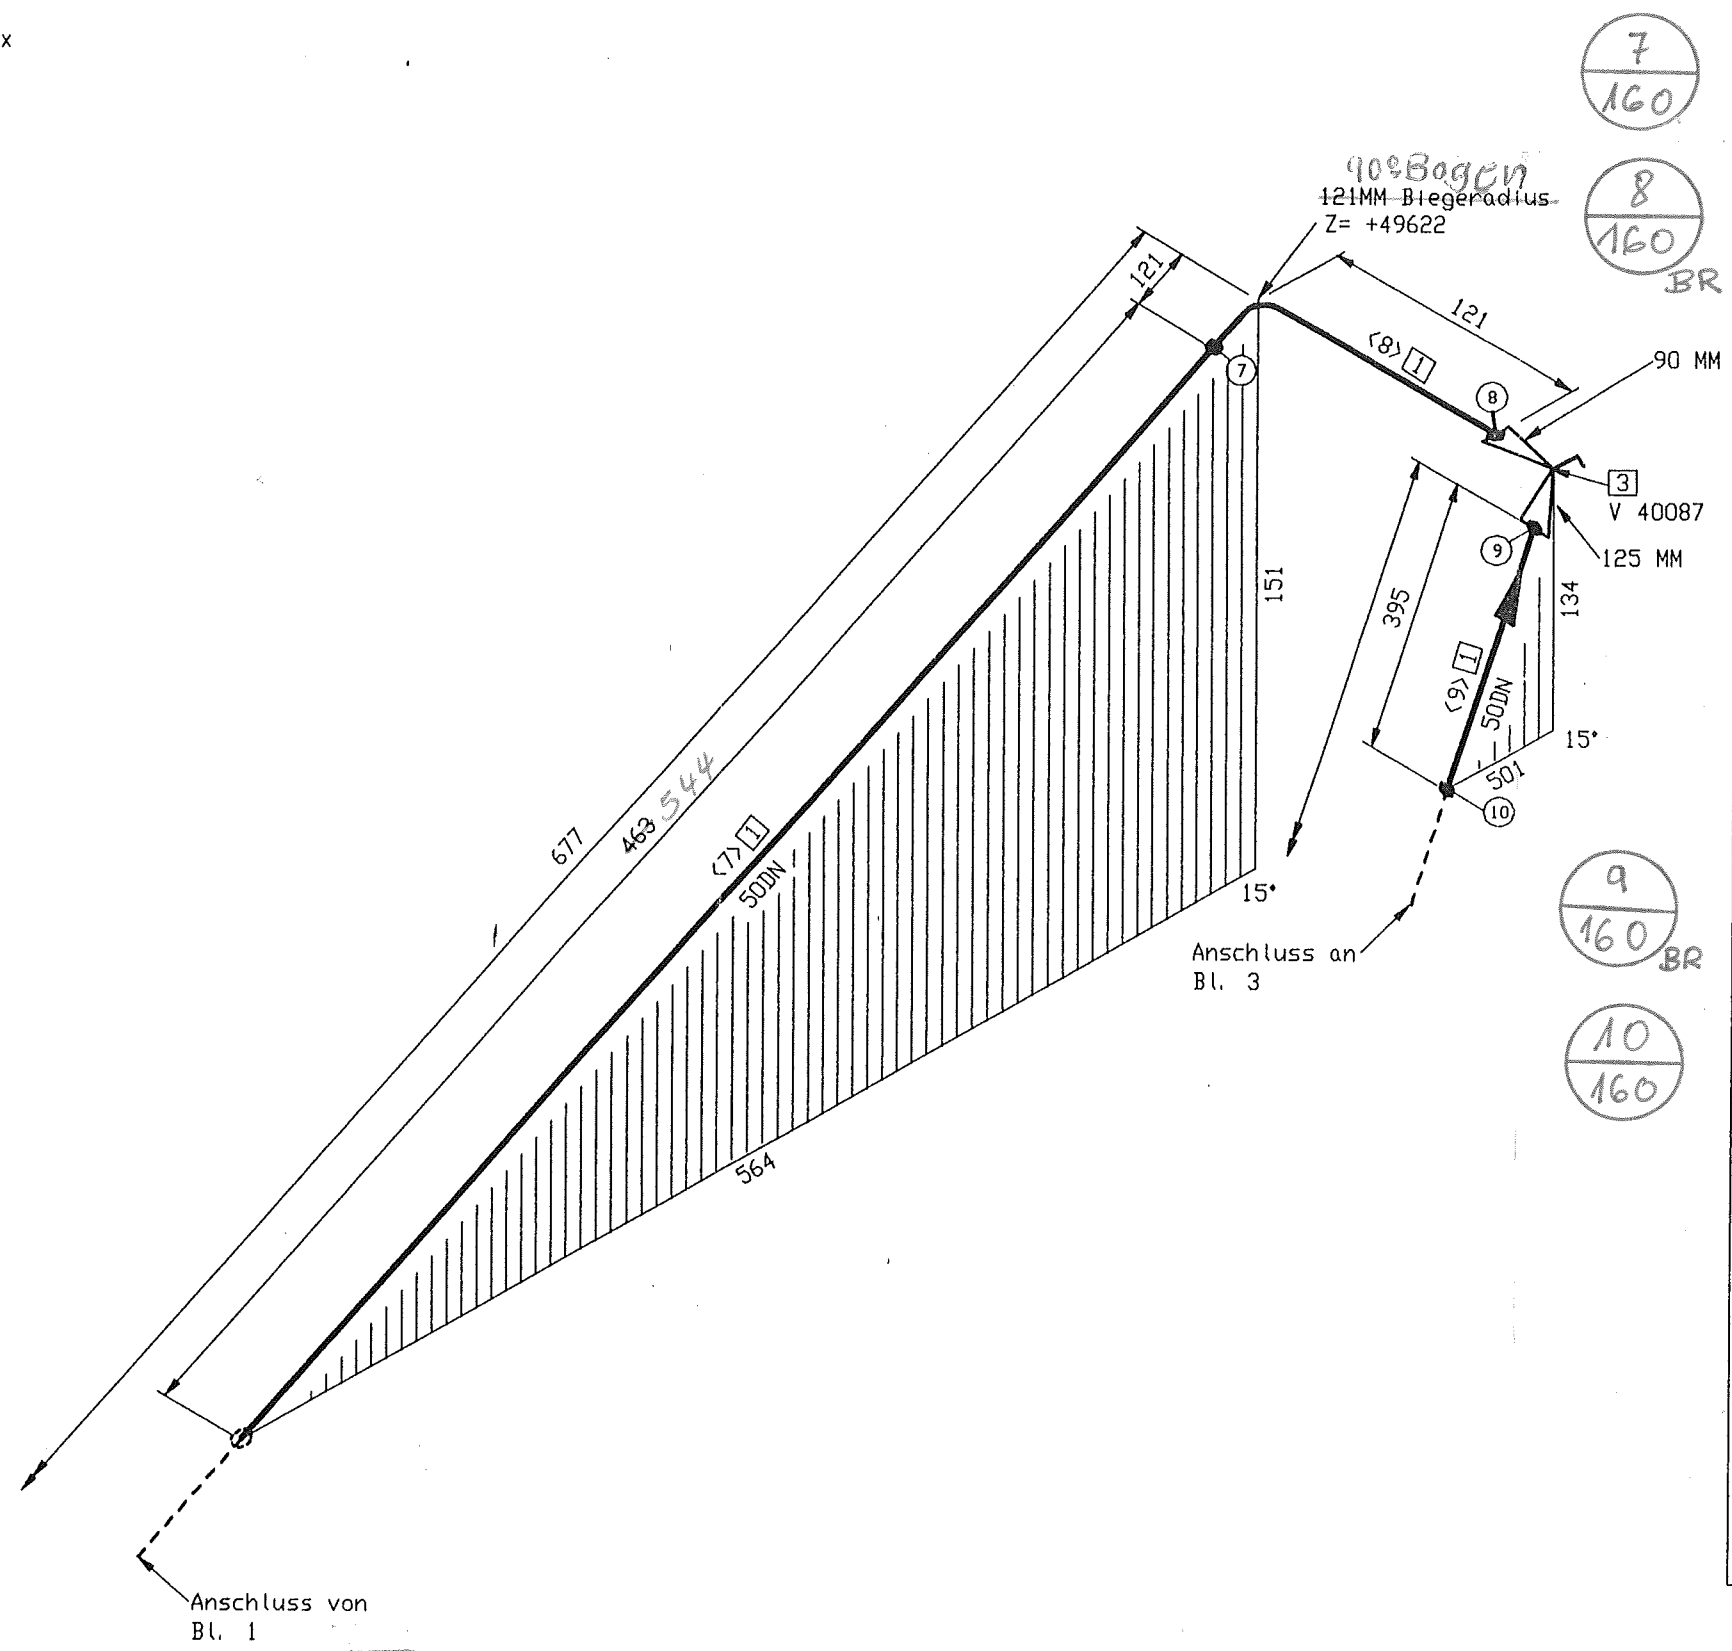




ISOMETRIE UM 45° GEDREHT GEZEICHNET

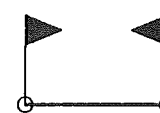


 = VENTILKASTEN 3, Vormontage
valve box 3, pre-fabricating

MATERIAL KONTR.		
CHECK OF MAT.		
SCHWEISSEN		
WELDING		
MECHAN. FERTIGST.		
MECHAN. COMPL.		
DRUCKPROBE		
PRESSURE TEST		
EHR-PROJ.-NO.:	C-13005	 Air Liquide AGS GmbH

pipng support, piping guides
View from top

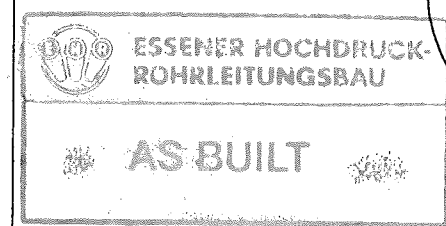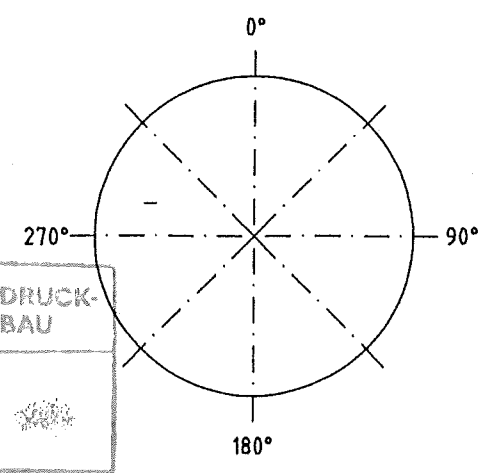

 Essener Hochdruck-
Rohrleitungsbau
Original
ist in rot gestempelt

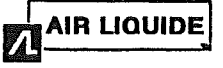MATERIAL : HANAU AL			All components cleaned for oxygen	
Workpiece edges	±0.5	SCALE	TOLERANCES :	Similar:
outside	inside		DN 28005	MASS
			DN 6570	kg
			DN 7168 mittel	Subst.:
ISO- Methode C		DATE : 05.07.2005	Replaced:	
Rev. No.	Date	By	NAME : H. Schneider	
			CHECK : Frickhöfer 05/07/05	
JOB CODE / REFERENCE :				
K70101, ASU No.9 Kosice			SHEET : 2	OF SHEET : 3
Title :			DRAWING No.:	F 2
Air Liquide AGS GmbH Hanau			79319837	C