

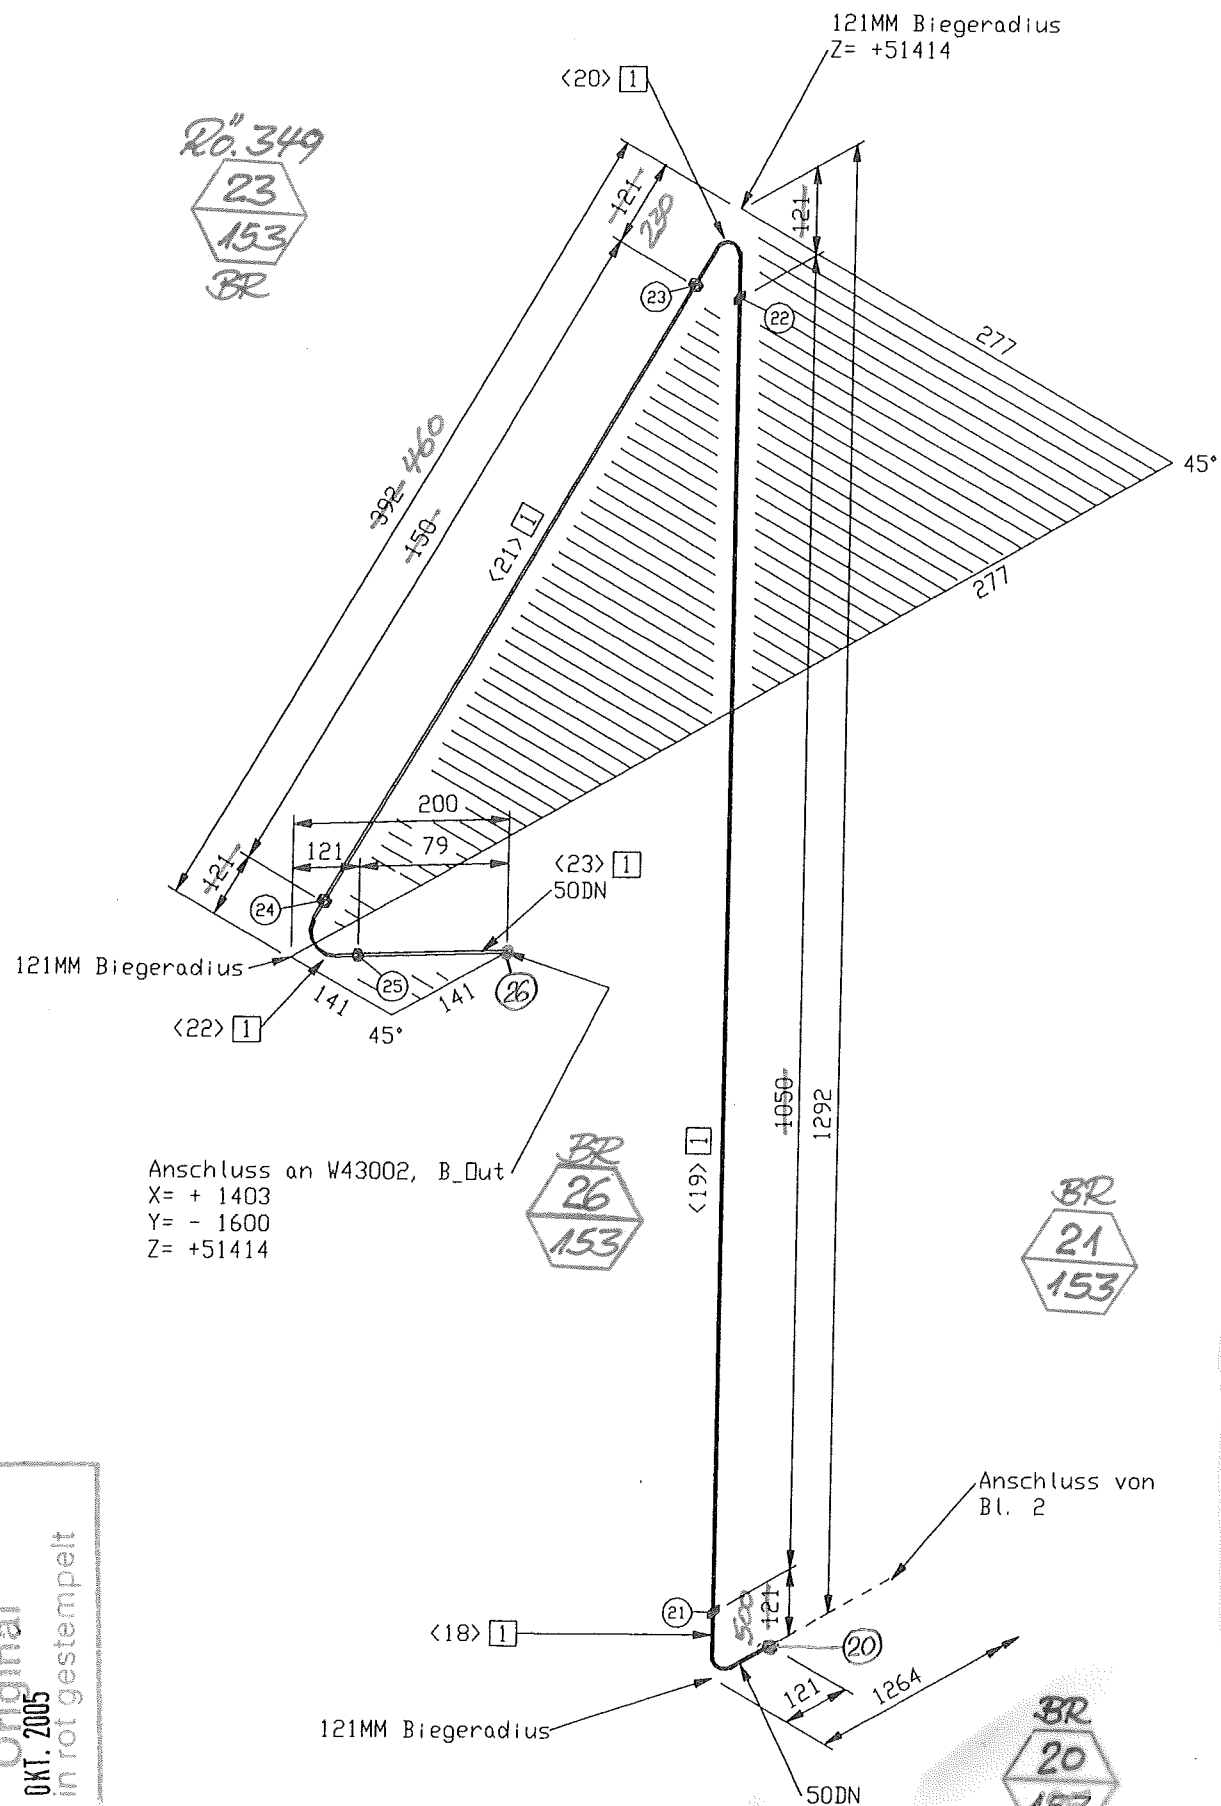
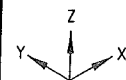


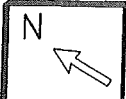


ISOMETRIE UM 45° GEDREHT GEZEICHNET

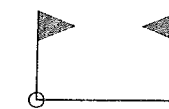

=VENTILKASTEN 3, Vormontage
valve box 3, pre-fabricating


piping support, piping guides
View from top

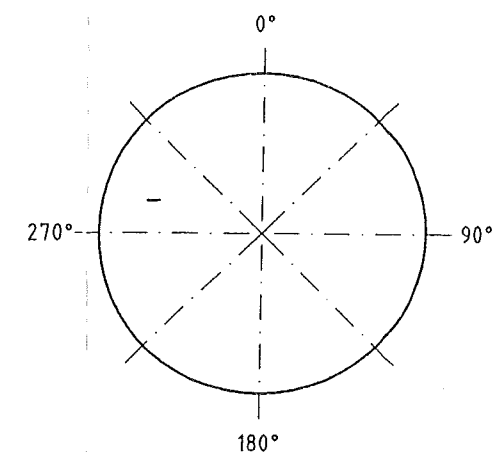

Essener Hochdruck-
Rohrleitungsbau

Original

10. OKT. 2005
ist in rot gestempelt

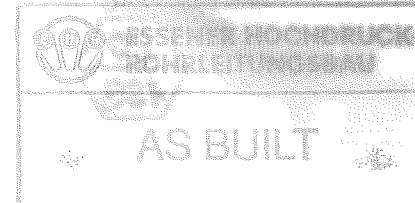

E			MATERIAL: HANAU AL		All components cleaned for oxygen	
D			Workplace edges	SCALE	TOLERANCES:	StmBar:
C			-0.5		DIN 28005	MASS
B			outside		DIN 8570	kg
A			inside		DIN 7168 mittel	Subst:
I	Rev. No.	Date	By	ISO-Methode E	DATE: 05.07.2005	Replaced:
					NAME: H.Schneider	
					CECK: Frickhöfer 05/07/05	
JOB CODE / REFERENCE:					AIR LIQUIDE	
K70101, ASU No.9 Kosice					SHEET: 3	OF SHEET: 3
Title:					DRAWING No.:	F Z
Air Liquide AGS GmbH Hanau					79319838	C
RL 43006						