


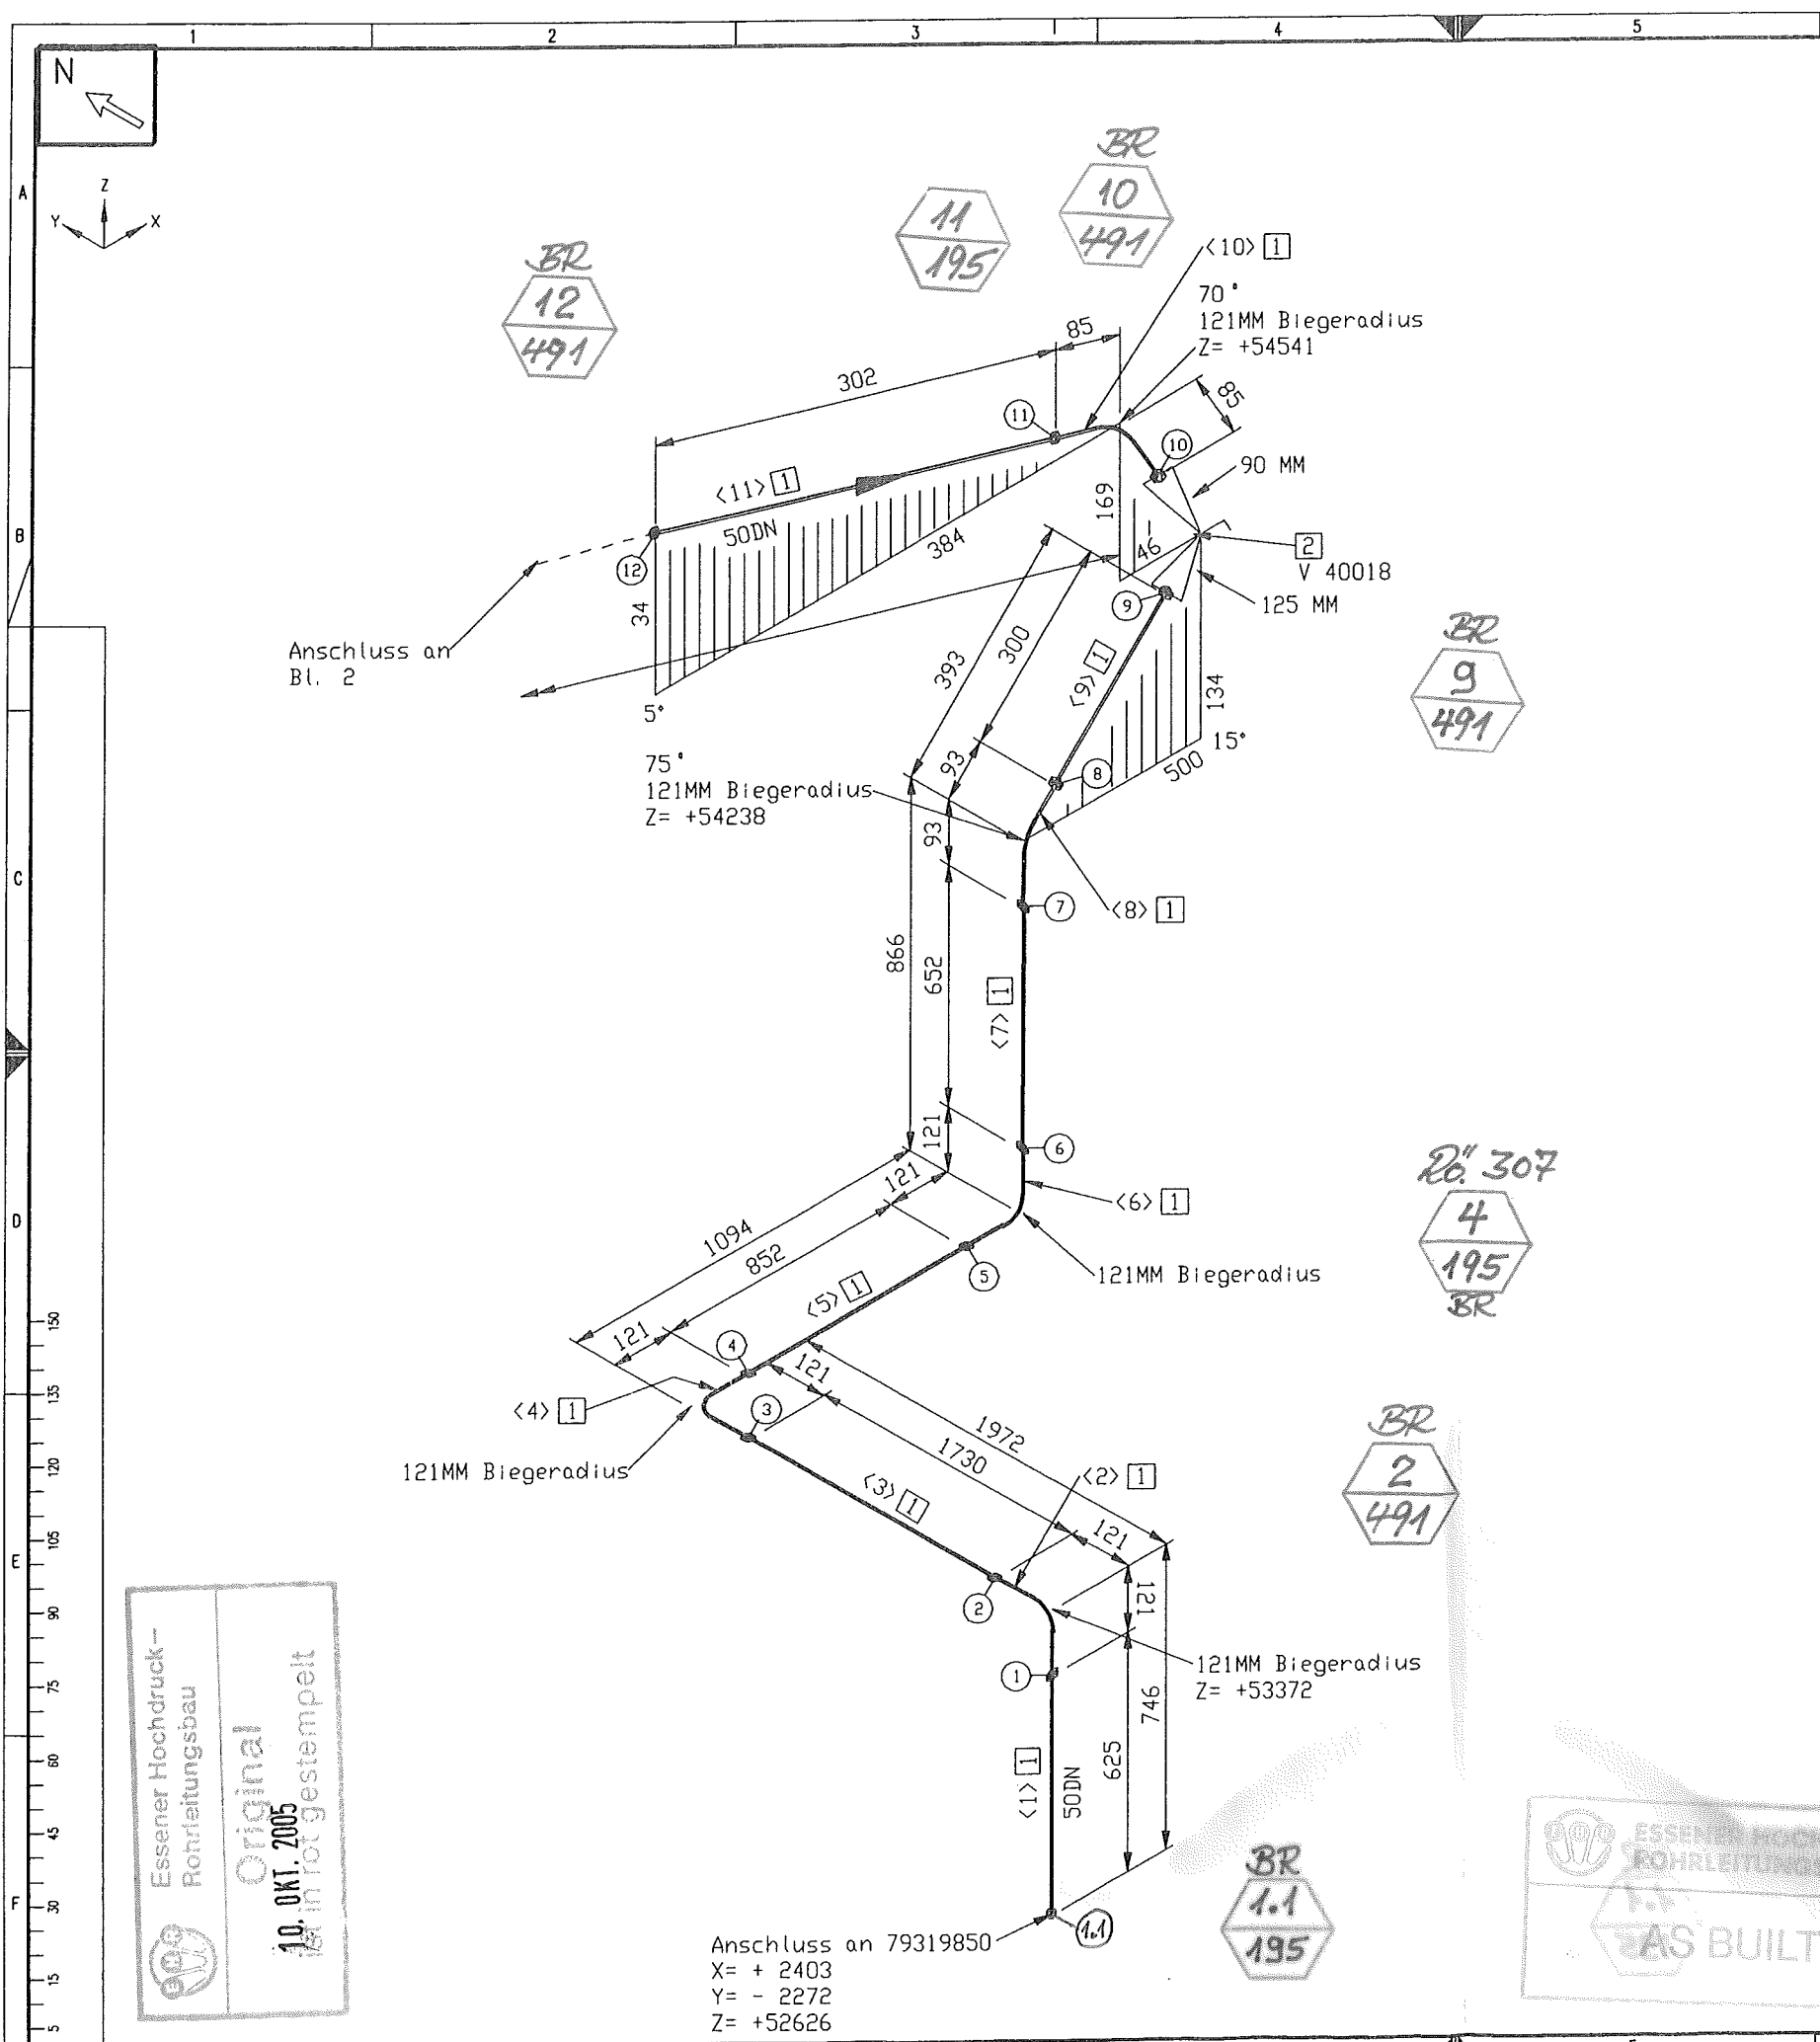


Stückliste

Lfd Nr.	Benennung	DN (MM)	Sachnummer	Menge	Gewicht (kg)
1	ROHR 60,3 X 3,9 ALMG4,5MN V27	50	77038146	11907 MM	22.2
2	Eck-Ventil AL DN 50 / PN 40 Handrad	50	770.38860	1	50.0
Summe Masse					72.2

Rohrzuschnitt


Rohr Stk.	Länge (MM)	DN (MM)	Bemerkung	Rohr Ende 1	Rohr Ende 2	Sachnummer
<1>	625	50				77038146
<2>	190	50	PLD BEND<1>			77038146
<3>	1730	50				77038146
<4>	190	50	PLD BEND<1>			77038146
<5>	852	50				77038146
<6>	190	50	PLD BEND<1>			77038146
<7>	652	50				77038146
<8>	159	50	PLD BEND<1>			77038146
<9>	300	50				77038146
<10>	148	50	PLD BEND<1>			77038146
<11>	302	50				77038146
<12>	126	50	PLD BEND<1>			77038146
<13>	1002	50				77038146
<14>	169	50	PLD BEND<1>			77038146
<15>	2245	50				77038146
<16>	159	50	PLD BEND<1>			77038146
<17>	689	50				77038146
<18>	183	50	PLD BEND<1>			77038146
<19>	1547	50				77038146
<20>	190	50	PLD BEND<1>			77038146
<21>	259	50				77038146

pipng support, piping guides
View from top

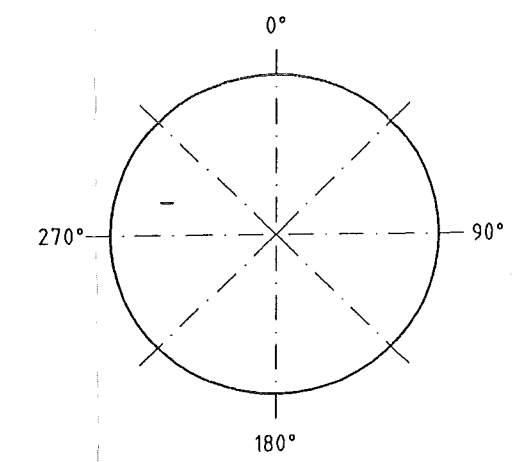

Rohr DN (MM) 50
CL Länge (MM) 12122

Essener Hochdruck-
Rohrleitungsbau
Original
10. Okt. 2005
in rot gestempelt

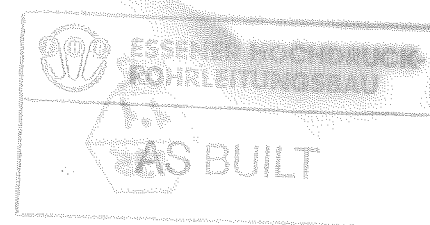

MATERIAL: HANAU AL Workplace edges: -0.5 outside, +0.3 inside SCALE: 1:1 TOLERANCES: DN 28005, DN 8570, DN 7168 mittel			All components cleaned for oxygen Similar: Subst.: Replaced:	
DATE: 11.08.2005 NAME: H.Schneider CHECK: Frickhöfer 11/08/05			AIR LIQUIDE SHEET: 1 OF SHEET: 2 DRAWING No.: 79319840	
JOB CODE / REFERENCE: K70101, ASU No.9 Kosice Title: R 40011			F Z C	