

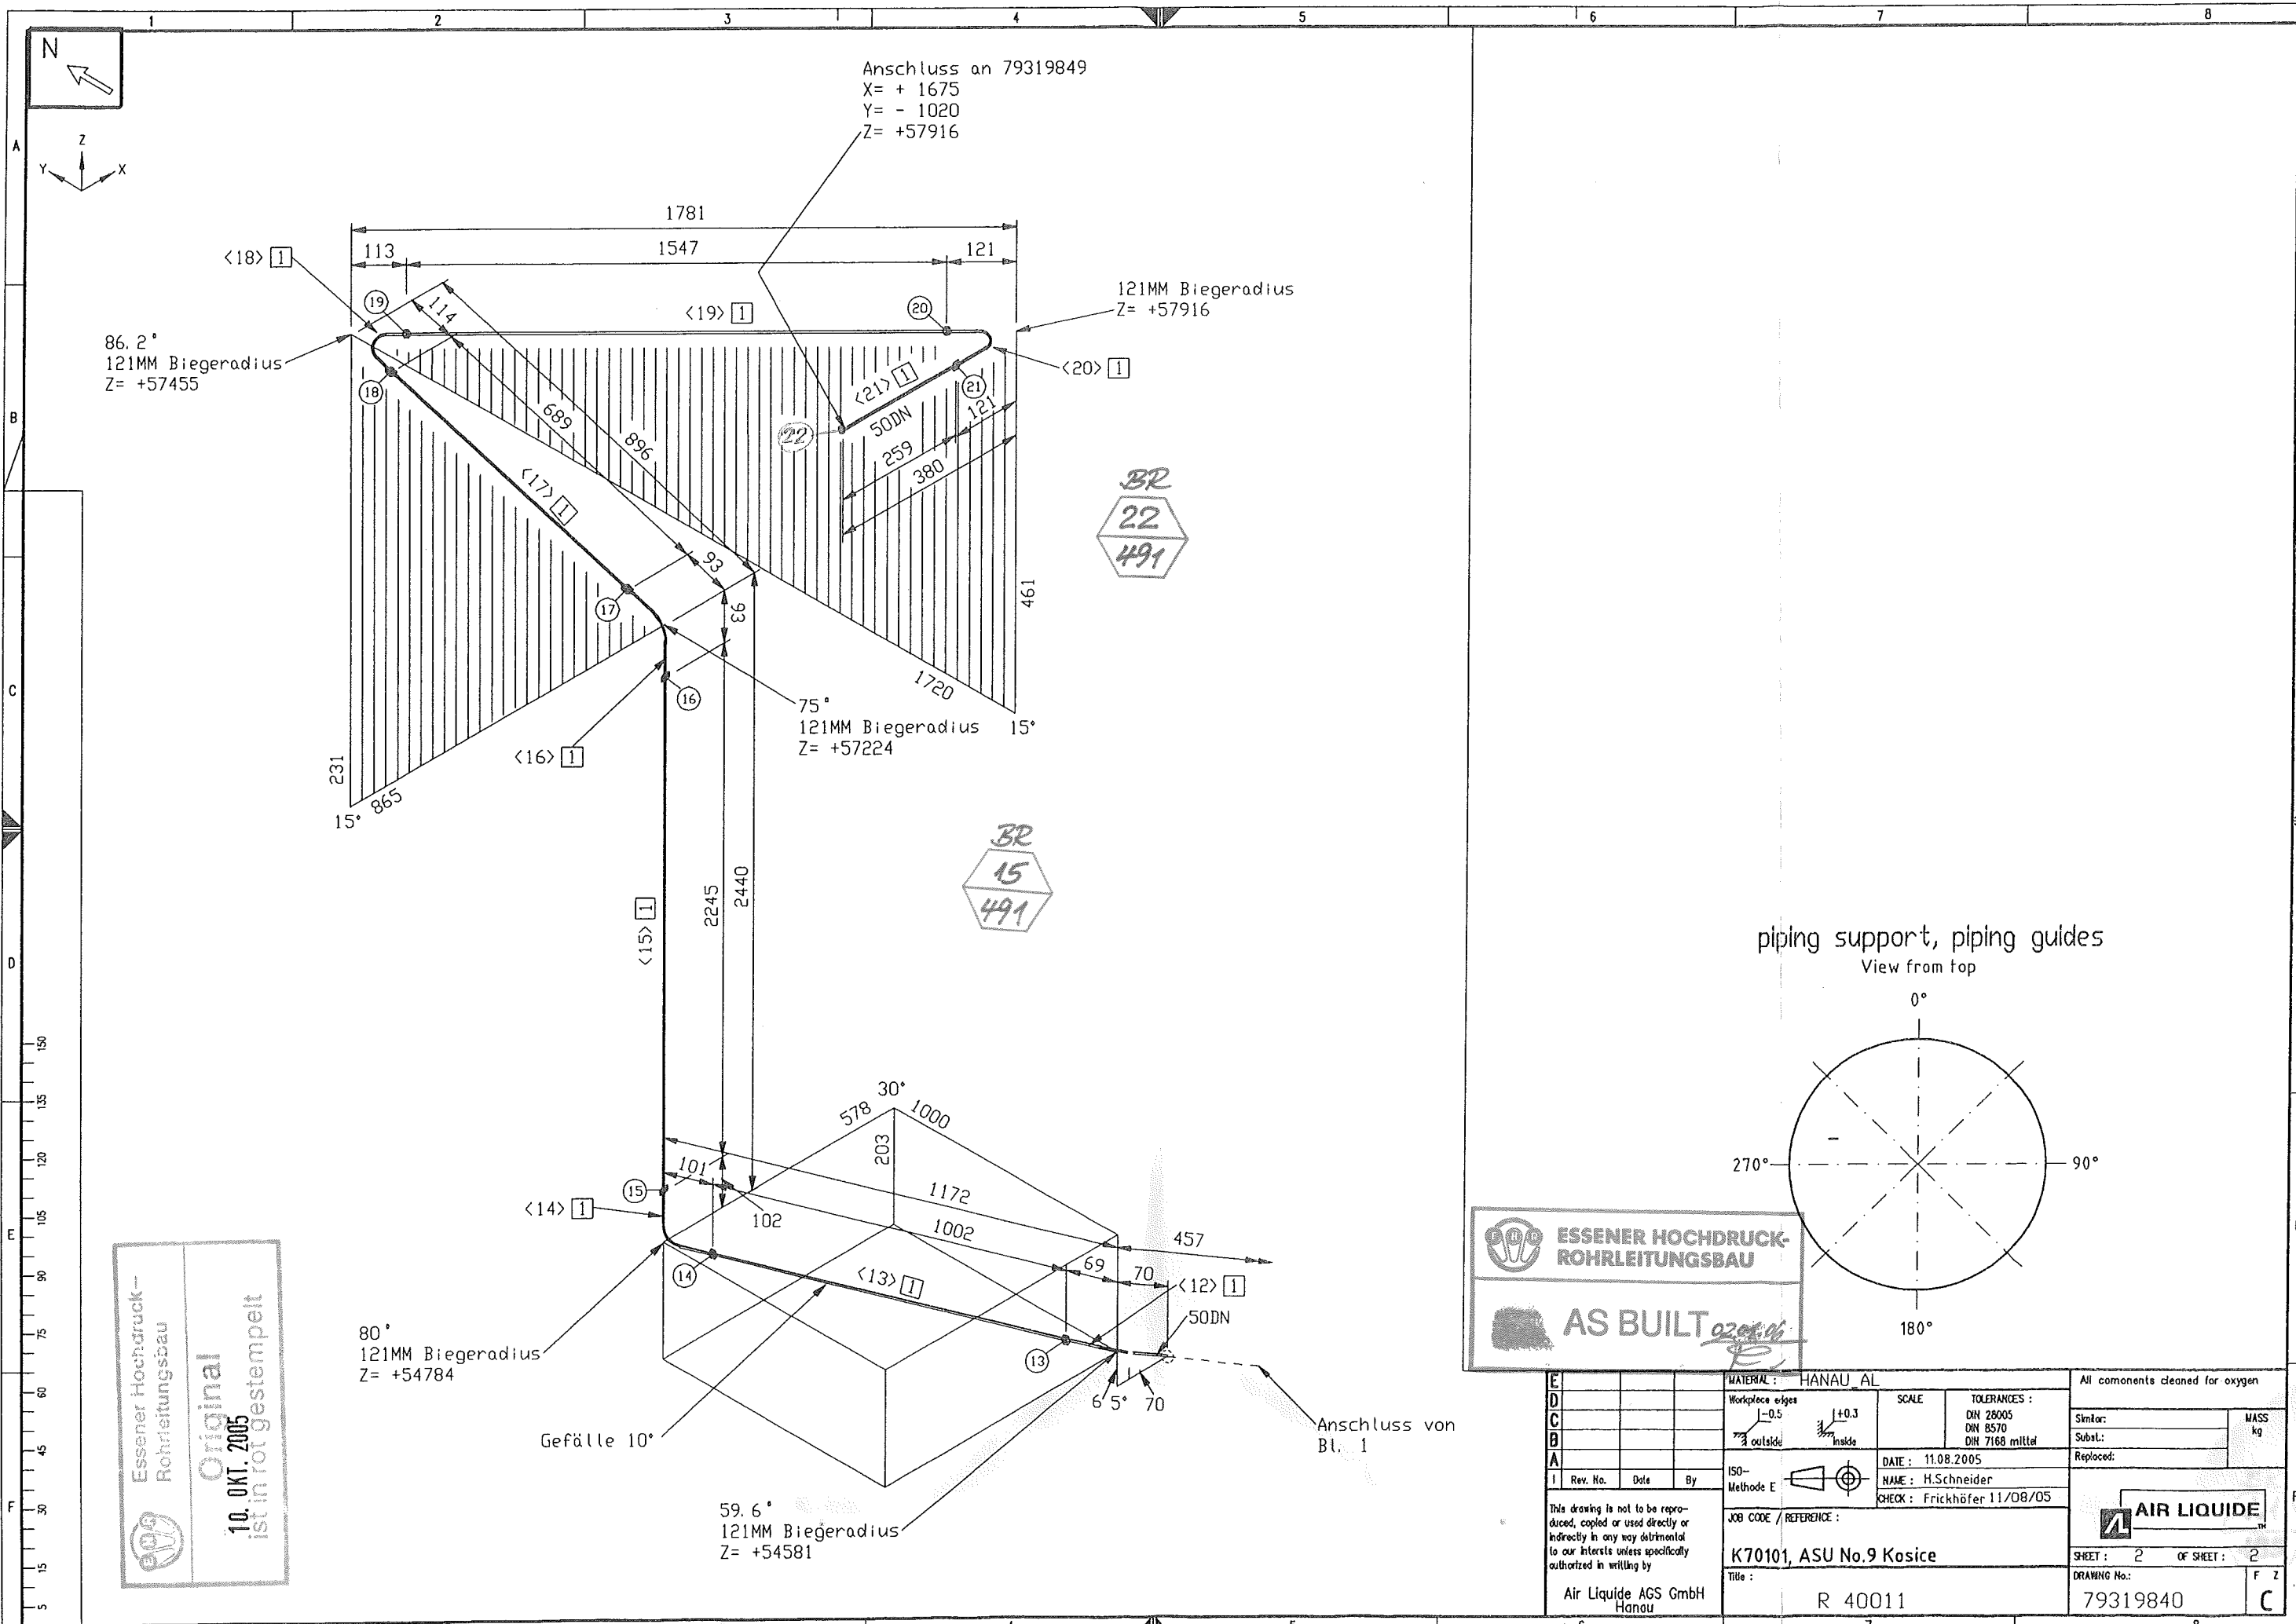
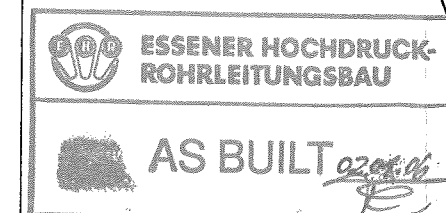


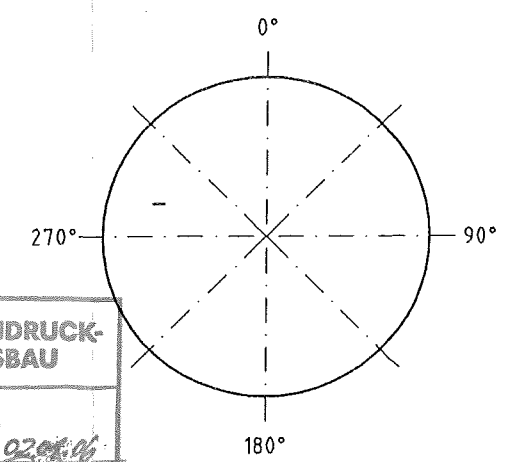

pipng support, piping guides
View from top

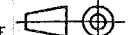

E				MATERIAL : HANAU AL		All components cleaned for oxygen		
D				Workplace edges 	SCALE	TOLERANCES : DIN 28005 DIN 8570 DIN 7168 mittel	Similar: Subst.: Replaced:	MASS kg
C								
B				ISO- Methode E		DATE : 11.08.2005 NAME : H.Schneider CHECK : Frickhöfer 11/08/05	 AIR LIQUIDE TM	
A								
1	Rev. No.	Date	By	JOB CODE / REFERENCE : K70101, ASU No.9 Kosice		SHEET : 2 OF SHEET : 2		
This drawing is not to be reproduced, copied or used directly or indirectly in any way detrimental to our interests unless specifically authorized in writing by				Title : R 40011		DRAWING No.: 79319840		F Z C
Air Liquide AGS GmbH Hanau								

Essener Hochdruck-
Rohrleitungsbau
Original
10. OKT. 2005
ist in rot gestempelt