

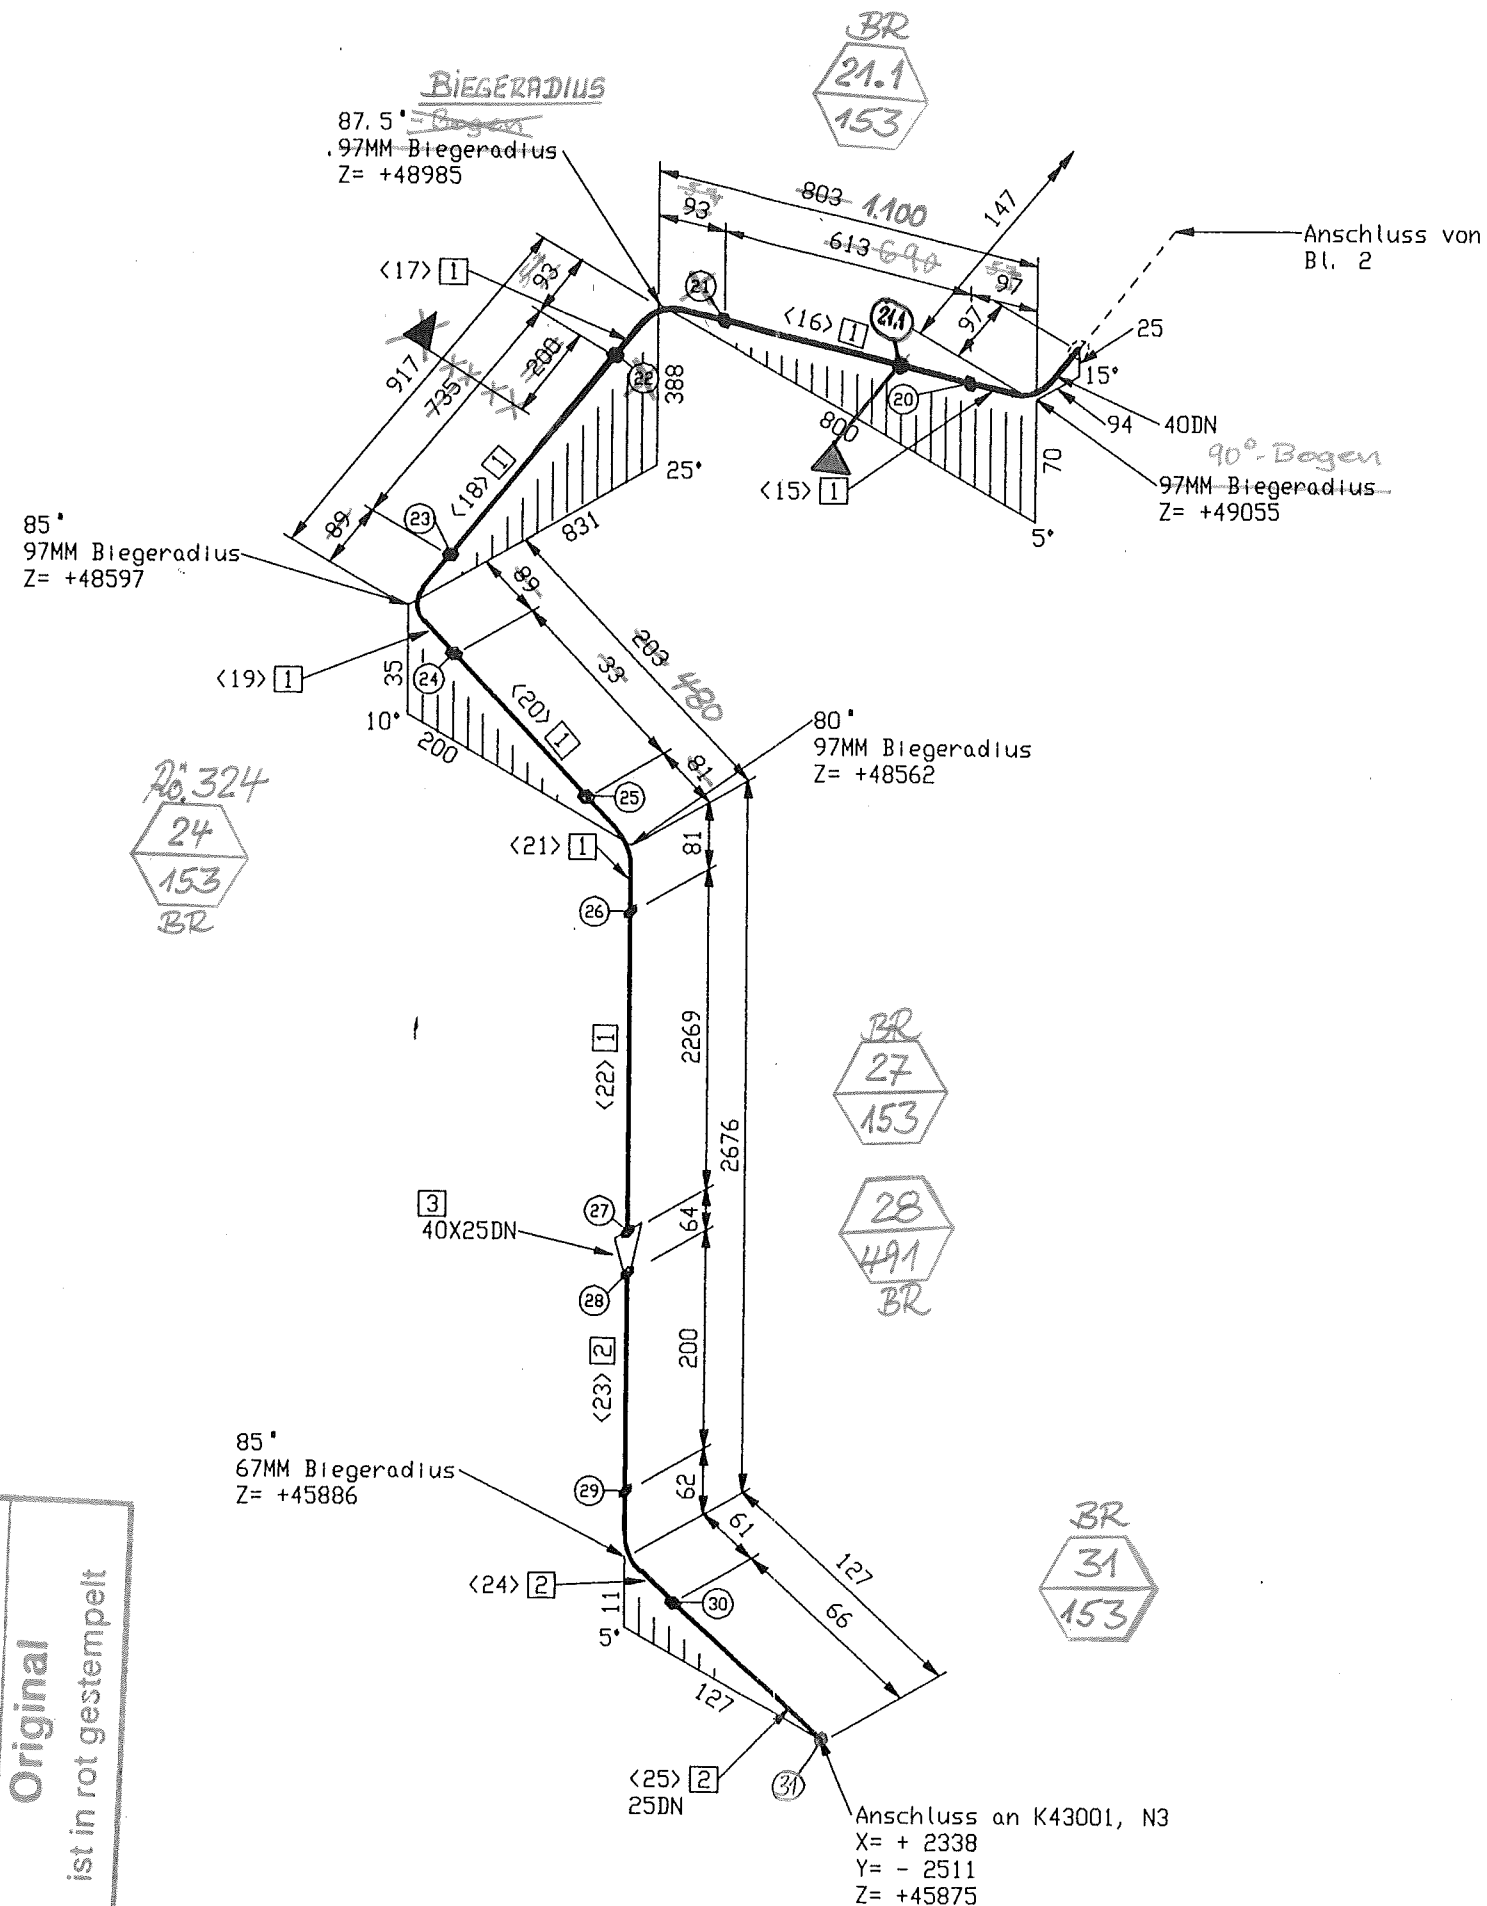


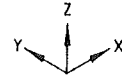



ISOMETRIE UM 45° GEDREHT GEZEICHNET

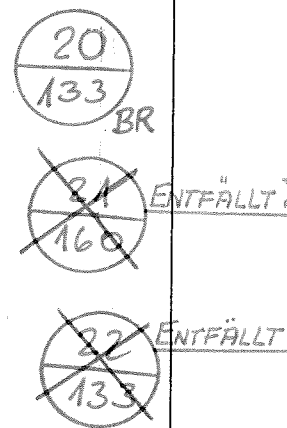

MATERIAL KONTR.		
CECK OF MAT.		
SCHWEISSEN		
WELDING		
MECHAN. FERTIGST.		
MECHAN. COMPL.		
DRUCKPROBE		
PRESSURE TEST		
EHR-PROJ.-NO.:	C-13005	
	ESSENER HOCHDRUCK-ROHRLEITUNGSBAU	Air Liquide AGS GmbH

=VENTILKASTEN 3, Vormontage
valve box 3, pre-fabricating

piping support, piping guides
View from top

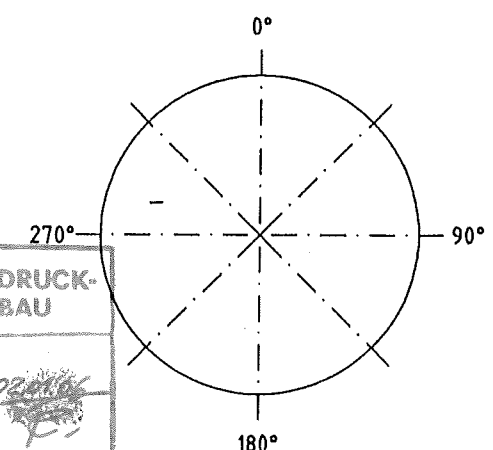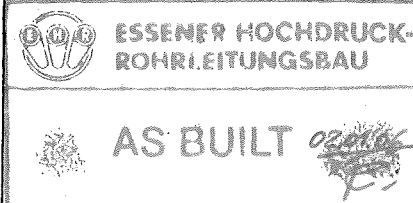

MATERIAL: HANAU AL			All components cleaned for oxygen	
Workpiece edges			Similar:	MASS
1-0.5			Subst:	kg
outside			Replaced:	
ISO-Methode E				
DATE: 06.07.2005			SHEET: 3 OF SHEET: 3	
NAME: H.Schneider			DRAWING No.: 79319848	
CHECK: Frickhöfer 06/07/05			F 2	
JOB CODE / REFERENCE:			C	
K70101, ASU No.9 Kosice				
Title:				
Air Liquide AGS GmbH Hanau				
RL 40004				

Essener Hochdruck-Rohrleitungsbau
Original
ist in rot gestempelt