


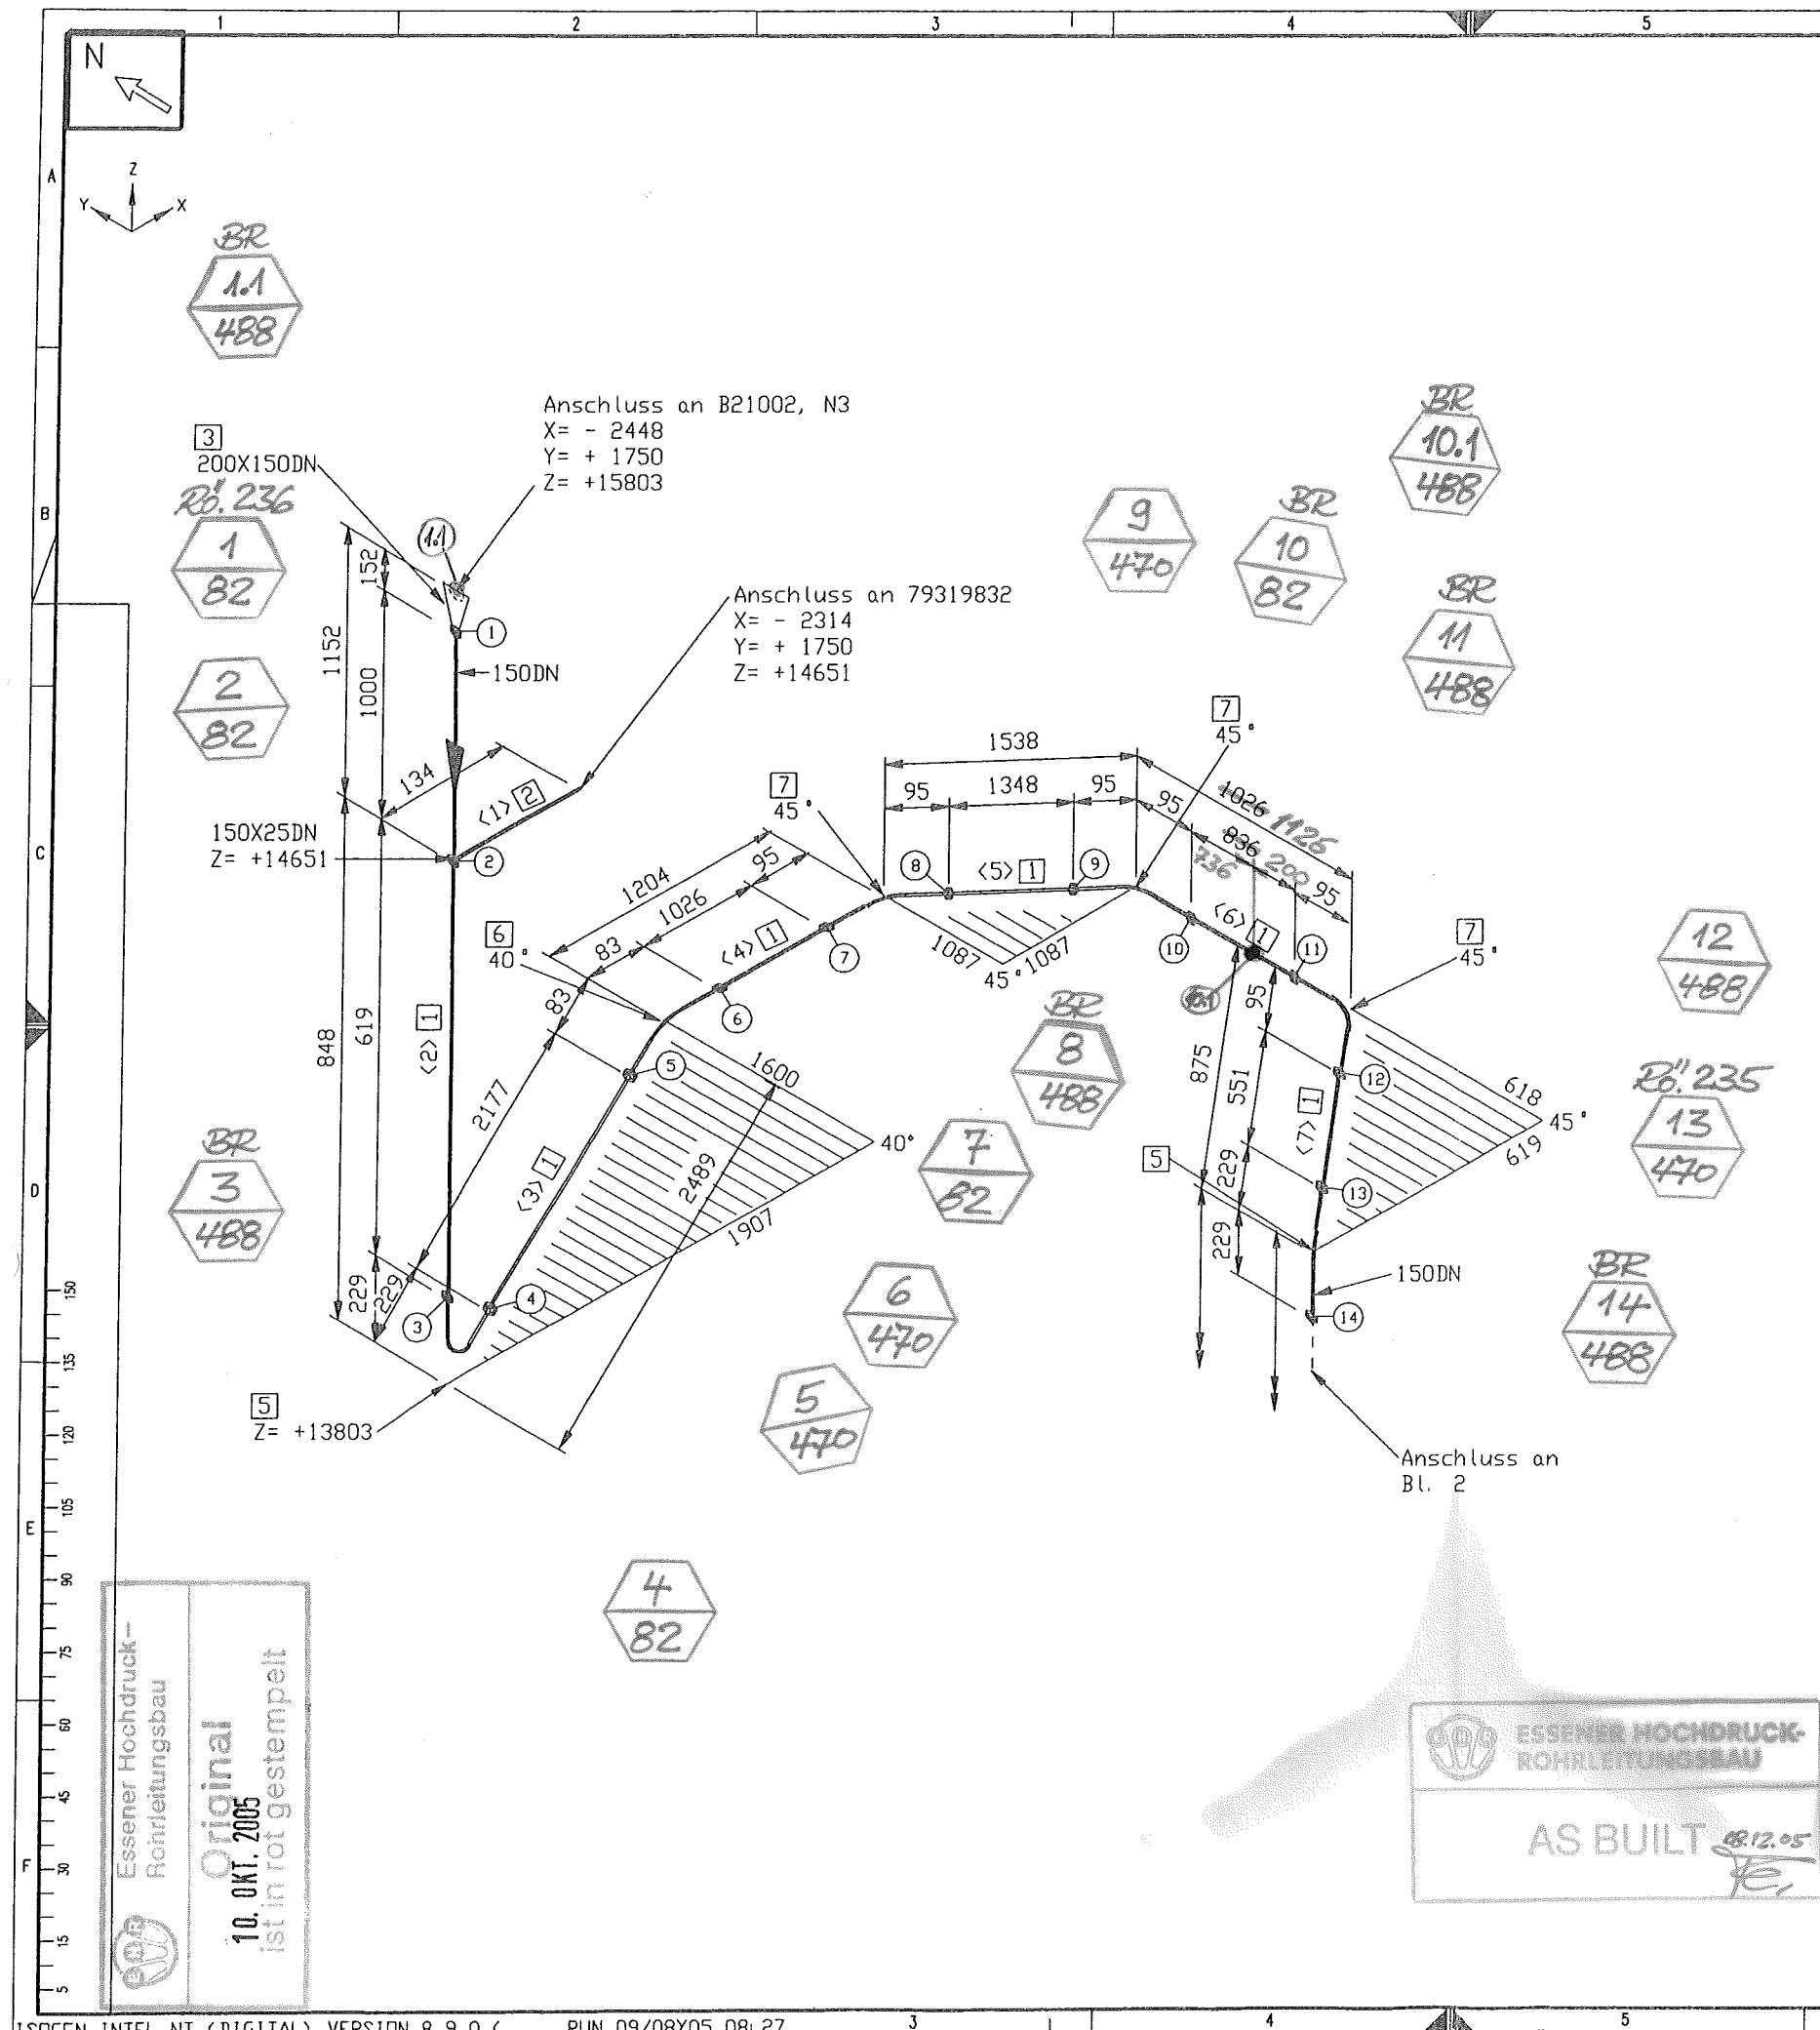

Stückliste					
Lfd. Nr.	Benennung	DN (MM)	Sachnummer	Menge	Gewicht (kg)
1	ROHR 168,3 X 7,1 ALMG4,5MN W27	150	77038150	22578	218.2
2	ROHR 33,4 X 3,4 ALMG4,5MN W27	25	77038144	50 MM	0.1
Fitting					
3	RED.-STUCK-K-219,1 x 6,0-168,3 x 6,0	200X150	79314059	1	1.5
4	gez. auf 79312884				
4	T-Stutzen 168,3x7,1 - 88,9x5,5	150X80	79313672	1	0.2
5	gez. auf 79311532				
5	BOGEN 168,3x7,1 DIN2605-2-90-3 ALMG4,5MN	150	77038158	4	14.0
6	BOGEN 168,3x7,1 DIN2605-2-90-3 ALMG4,5MN	150	77038158_1	1	3.5
7	Stutzen auf 40				
7	BOGEN 168,3x7,1 DIN2605-2-90-3 ALMG4,5MN	150	77038158_2	3	10.5
	Stutzen auf 45				
Halterung					
8	Rohrhalterung gezeichnet auf 79312892	150	79313053	1	1.6
9	Führung A gezeichnet auf 79318176, L1=353	150	79320096	2	22.7
Summe Masse					272.2

Rohrzuschnitt						
Rohr Stk.	Länge (MM)	DN (MM)	Bemerkung	Rohr Ende 1	Rohr Ende 2	Sachnummer
<1>	50	25				77038144
<2>	1619	150				77038150
<3>	2177	150				77038150
<4>	1026	150				77038150
<5>	1348	150				77038150
<6>	836	150				77038150
<7>	551	150				77038150
<8>	6000	150				77038150
<9>	3145	150				77038150
<10>	561	150				77038150
<11>	5215	150				77038150

View from top

Rohr DN (MM)	200	150	80	25
CL Länge (MM)	152	25046	125	50

WATER: HANAU AL	SCALE	TOLERANCES:	DATE: 09.08.2005
Workplace edges	1:0.5	DN 28005	NAME: H.Schneider
1/2 outside	1:0.3	DN 8570	CHECK: Frickhöfer 09/08/05
1/2 inside		DN 7168 milled	

Rev. No.	Date	By	ISO-Methode E	JOB CODE / REFERENCE:	NAME: H.Schneider
				K70101, ASU No.9 Kosice	
				Title:	NL 21018

All components cleaned for oxygen	Similar:	MASS kg
Subst.:	Replaced:	
AIR LIQUIDE		
SHEET: 1	OF SHEET: 2	
DRAWING No.:		F Z
79319856		C