


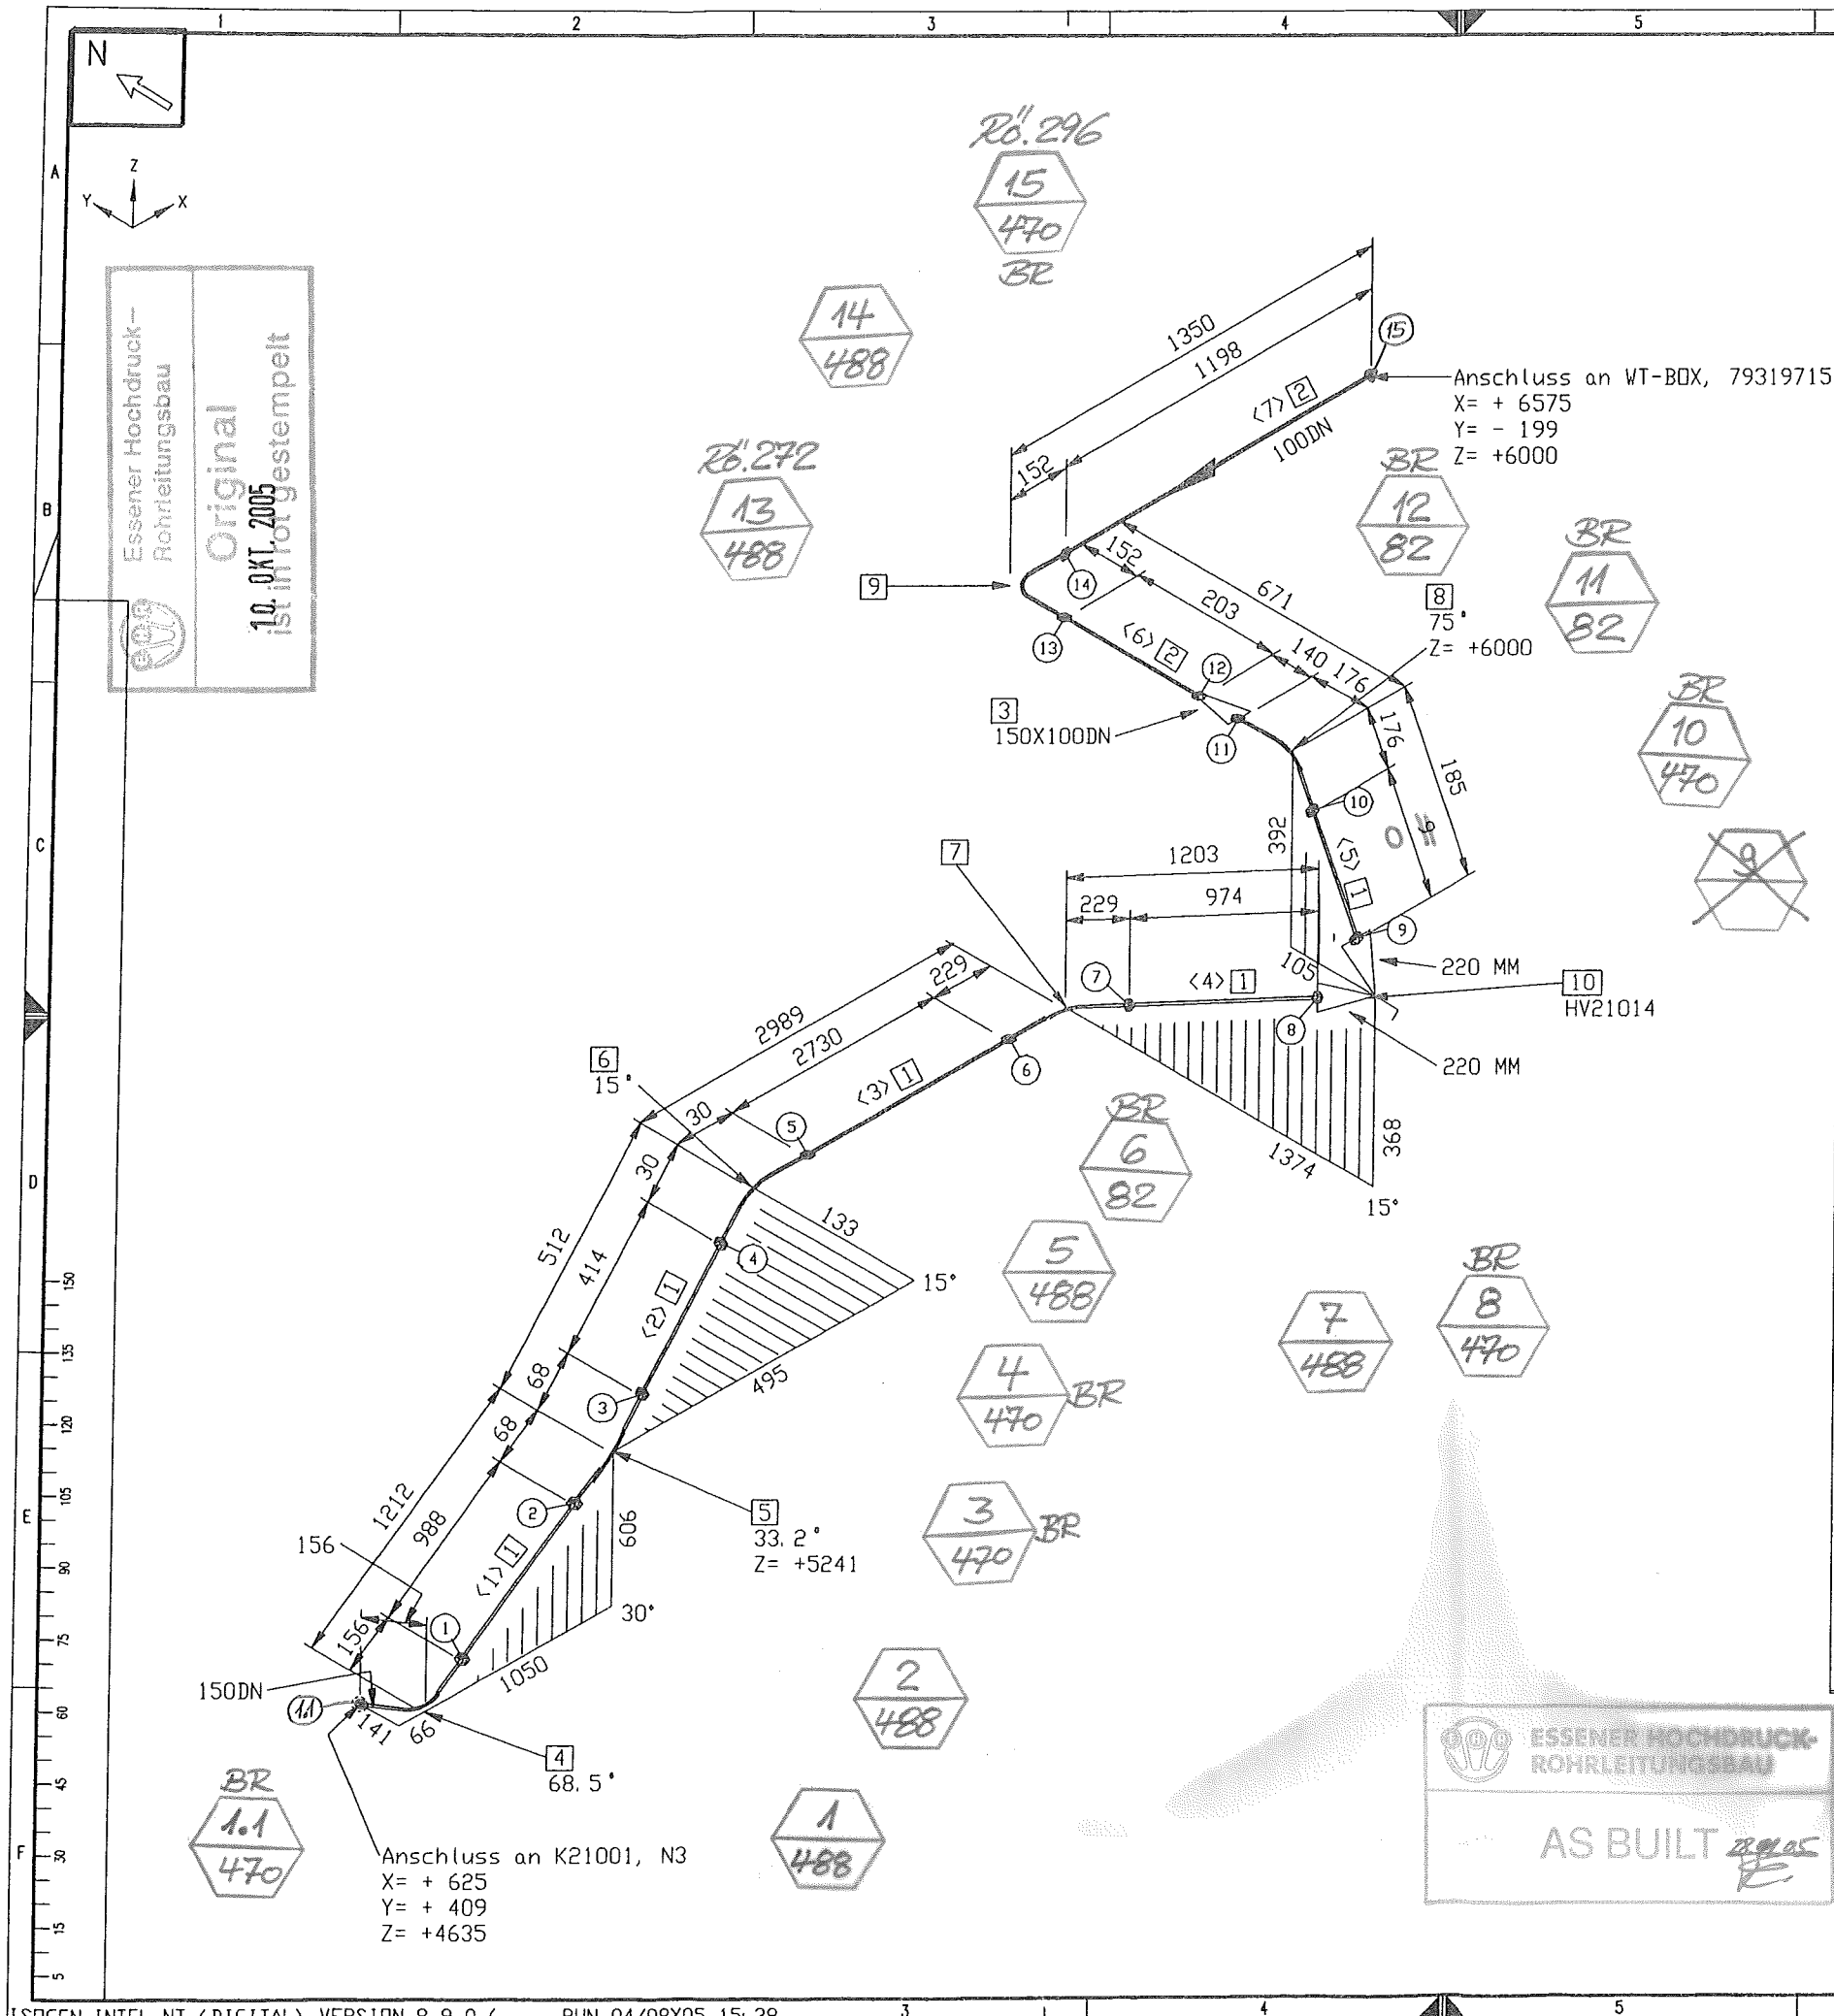

6


7

8

Stückliste

Lfd Nr.	Benennung	DN (MM)	Sachnummer	Menge	Gewicht (kg)
Rohr					
1	ROHR 168,3 X 7,1 ALMG4,5MN W27	150	77038150	5115 MM	49.7
2	ROHR 114,3 X 6 ALMG4,5MN W27	100	77038148	1401 MM	7.7
Fitting					
3	RED. -STÜCK-K-168,3 x 6,0-114,3 x 6,0 gez. auf 79312884	150X100	79313684	1	1.0
4	BOGEN 168,3x7,1 DIN2605-2-90-3 ALMG4,5MN Stutzen auf 68.53	150	77038158	1	3.5
5	BOGEN 168,3x7,1 DIN2605-2-90-3 ALMG4,5MN Stutzen auf 33.23	150	77038158_1	1	3.5
6	BOGEN 168,3x7,1 DIN2605-2-90-3 ALMG4,5MN Stutzen auf 15	150	77038158_2	1	3.5
7	BOGEN 168,3x7,1 DIN2605-2-90-3 ALMG4,5MN	150	77038158_3	1	3.5
8	BOGEN 168,3x7,1 DIN2605-2-90-3 ALMG4,5MN Stutzen auf 75	150	77038158_4	1	3.5
9	BOGEN 114,3x6 DIN2605-2-90-3 ALMG4,5MN	100	77038157	1	1.3
Ventil					
10	Eck-Ventil AL DN 150 / PN 40 (Kämmer)	150	77038869	1	100.0
Summe Masse					177.1

Rohrzuschnitt						
Rohr Stk.	Länge (MM)	DN (MM)	Bemerkung	Rohr Ende 1	Rohr Ende 2	Sachnummer
<1>	988	150				77038150
<2>	414	150				77038150
<3>	2730	150				77038150
<4>	974	150				77038150
<5>	9	150				77038150
<6>	203	100				77038148
<7>	1198	100				77038148

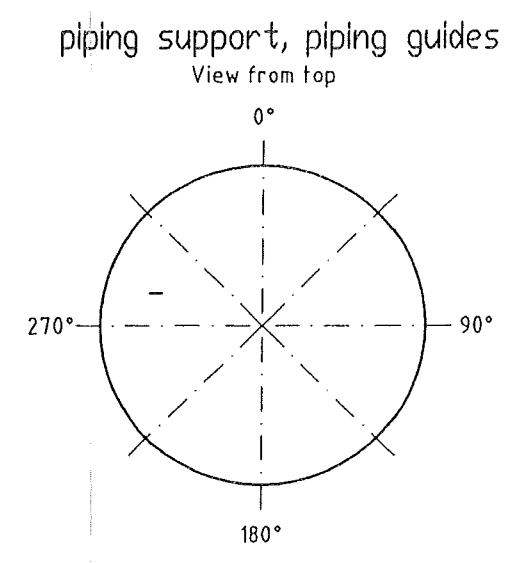

Rohr DN (MM) 150 100
CL Länge (MM) 7013 1705



MATERIAL: HANAU AL		All components cleaned for oxygen	
Workplace edges	SCALE	TOLERANCES:	Similar:
1-0.5		DIN 28005	MASS
outside		DIN 8570	kg
inside		DIN 7168 mittel	Subst:
ISO-Methoden E	DATE: 04.08.2005	Replaced:	
NAME: H.Schneider	CHECK: Frickhöfer 04/08/05		
JOB CODE / REFERENCE:		AIR LIQUIDE	
K70101, ASU No.9 Kosice		SHEET: 1 OF SHEET: 1	
Title:		DRAWING No: 79319857	
Air Liquide AGS GmbH Hanau		AL 21002	