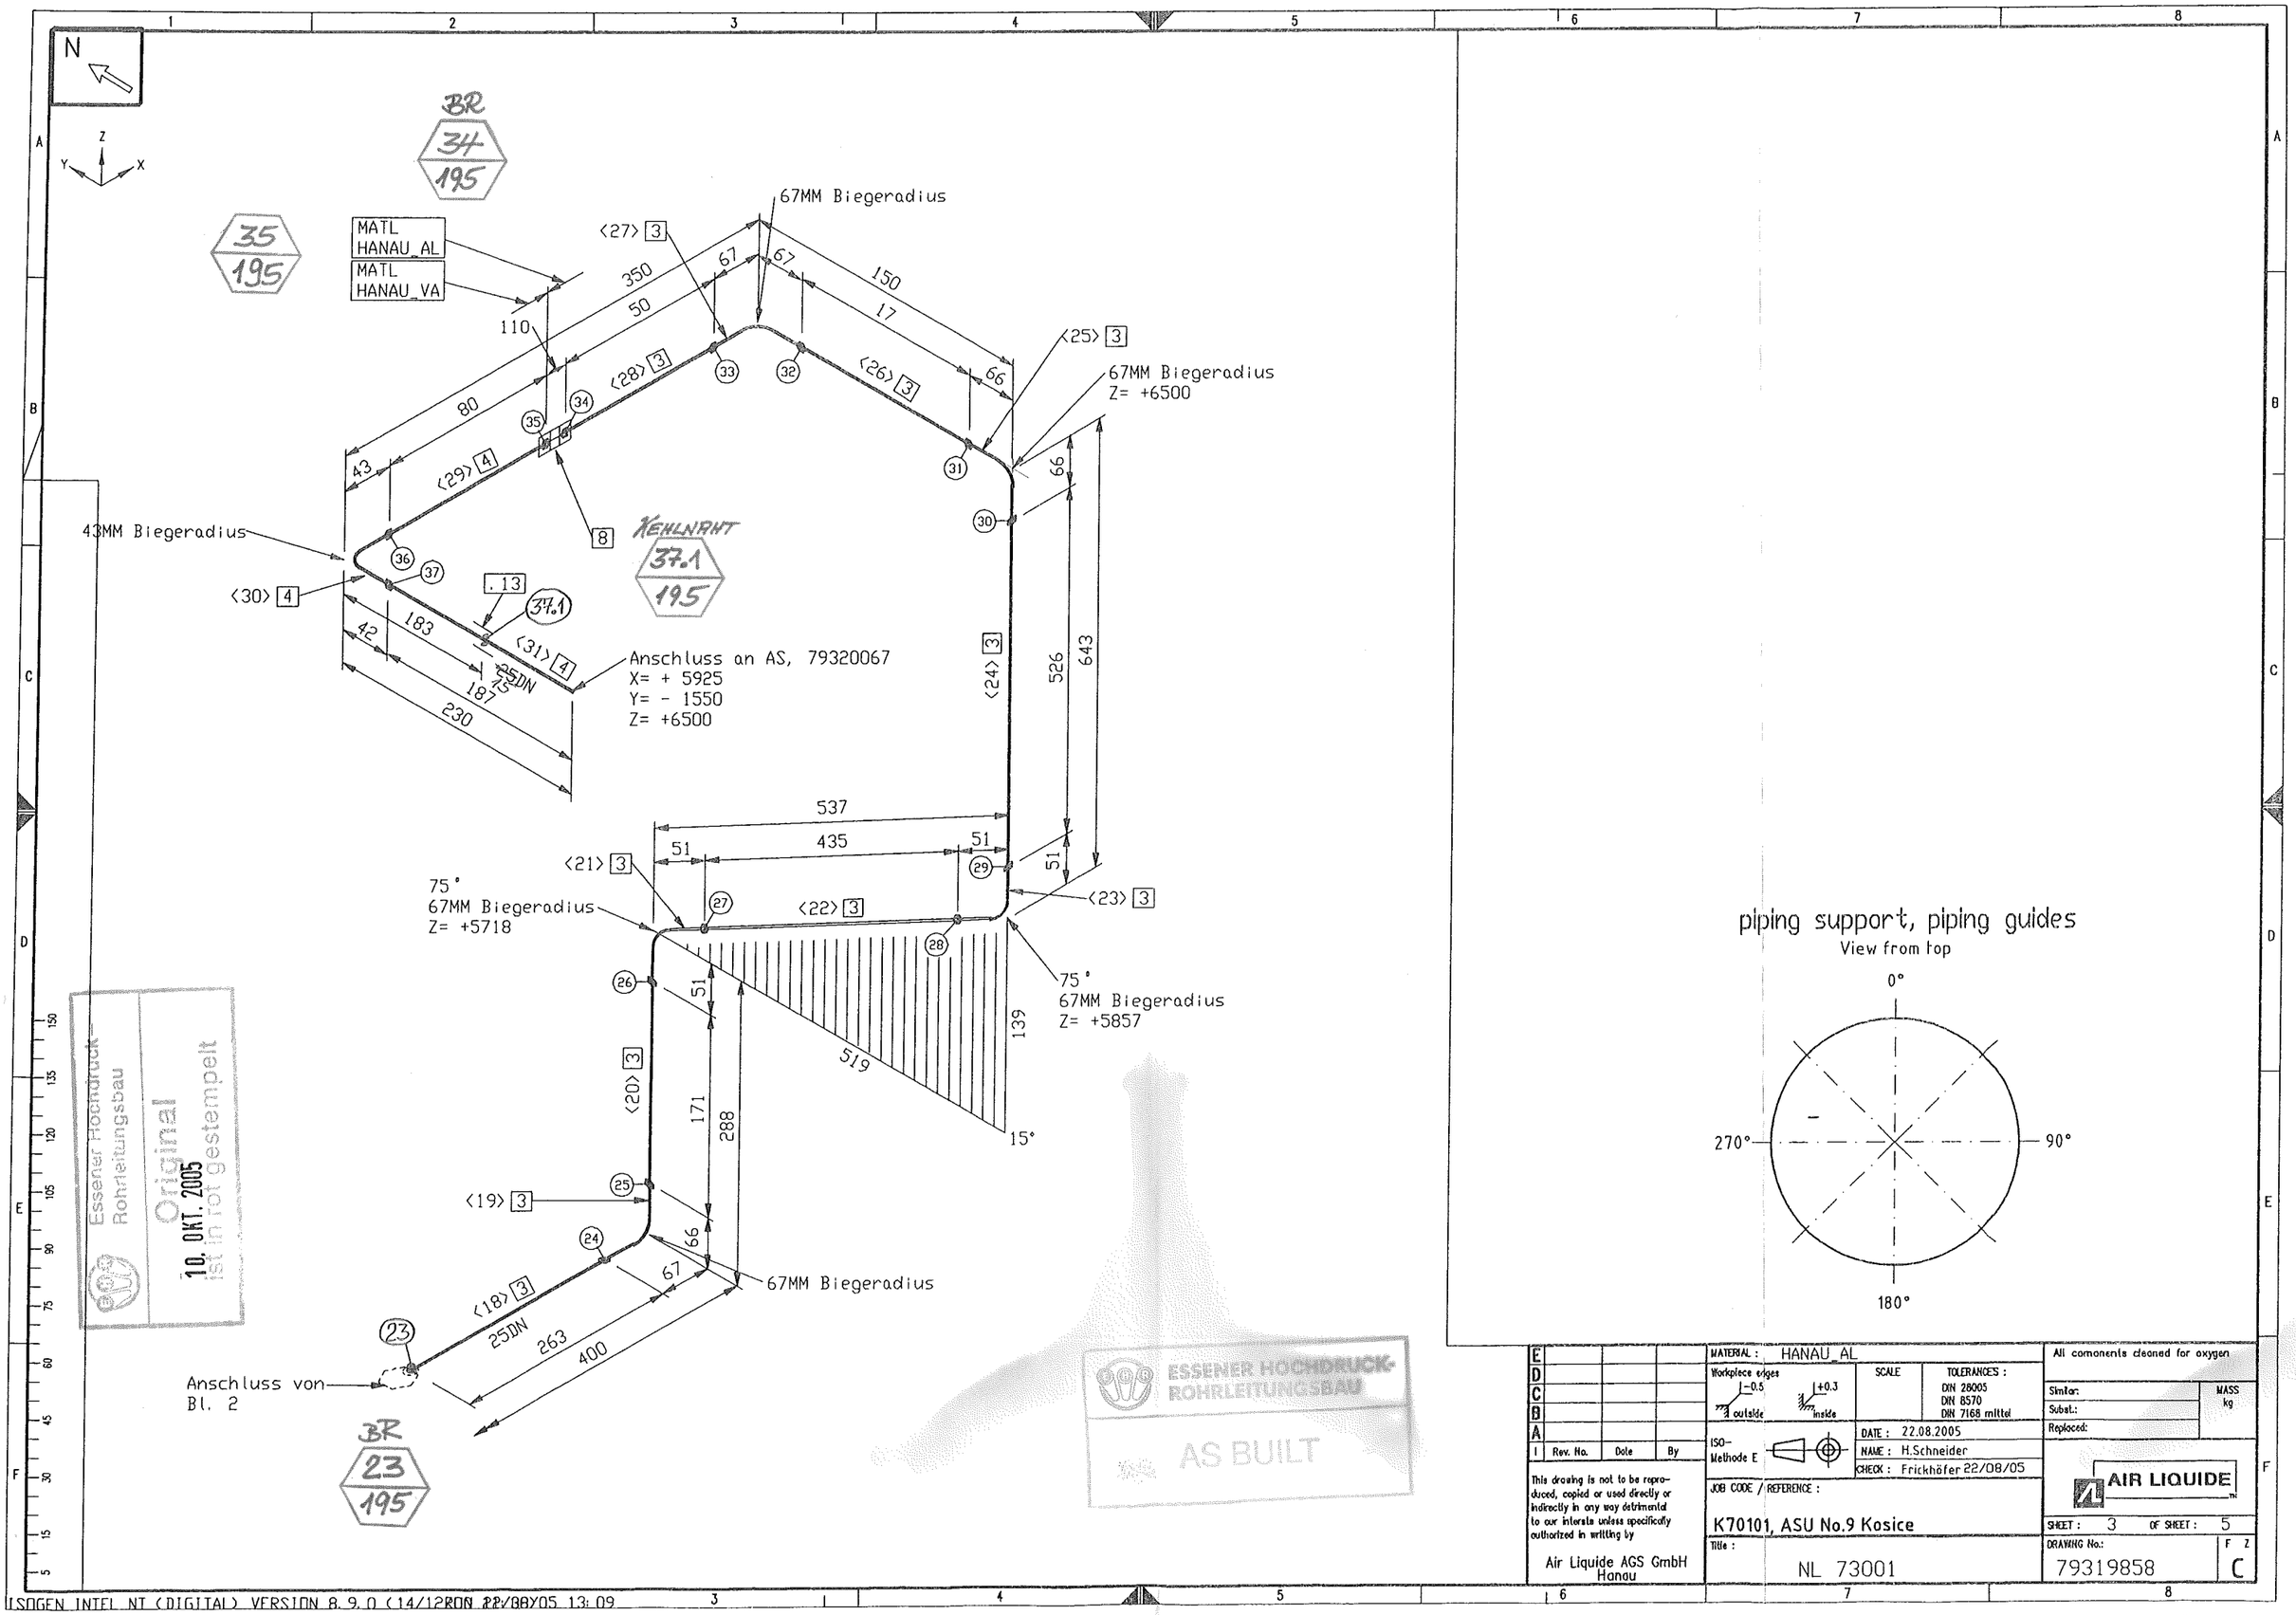

Rev. No.	Date	By

This drawing is not to be reproduced, copied or used directly or indirectly in any way detrimental to our interests unless specifically authorized in writing by

Air Liquide AGS GmbH
Hanau

MATERIAL : HANAU_AL

Workpiece edges: −0.5 outside, +0.3 inside

ISO-Methode E

SCALE

TOLERANCES : DIN 28005, DIN 8570, DIN 7168 mittel

DATE : 22.08.2005
NAME : H.Schneider
CHECK : Frickhöfer 22/08/05

JOB CODE / REFERENCE :

K70101, ASU No.9 Kosice

Title :

NL 73001

All components cleaned for oxygen

Similar:
Subst.:
Replaced:

MASS kg

AIR LIQUIDE

SHEET : 3 OF SHEET : 5

DRAWING No.: 79319858

F Z C