


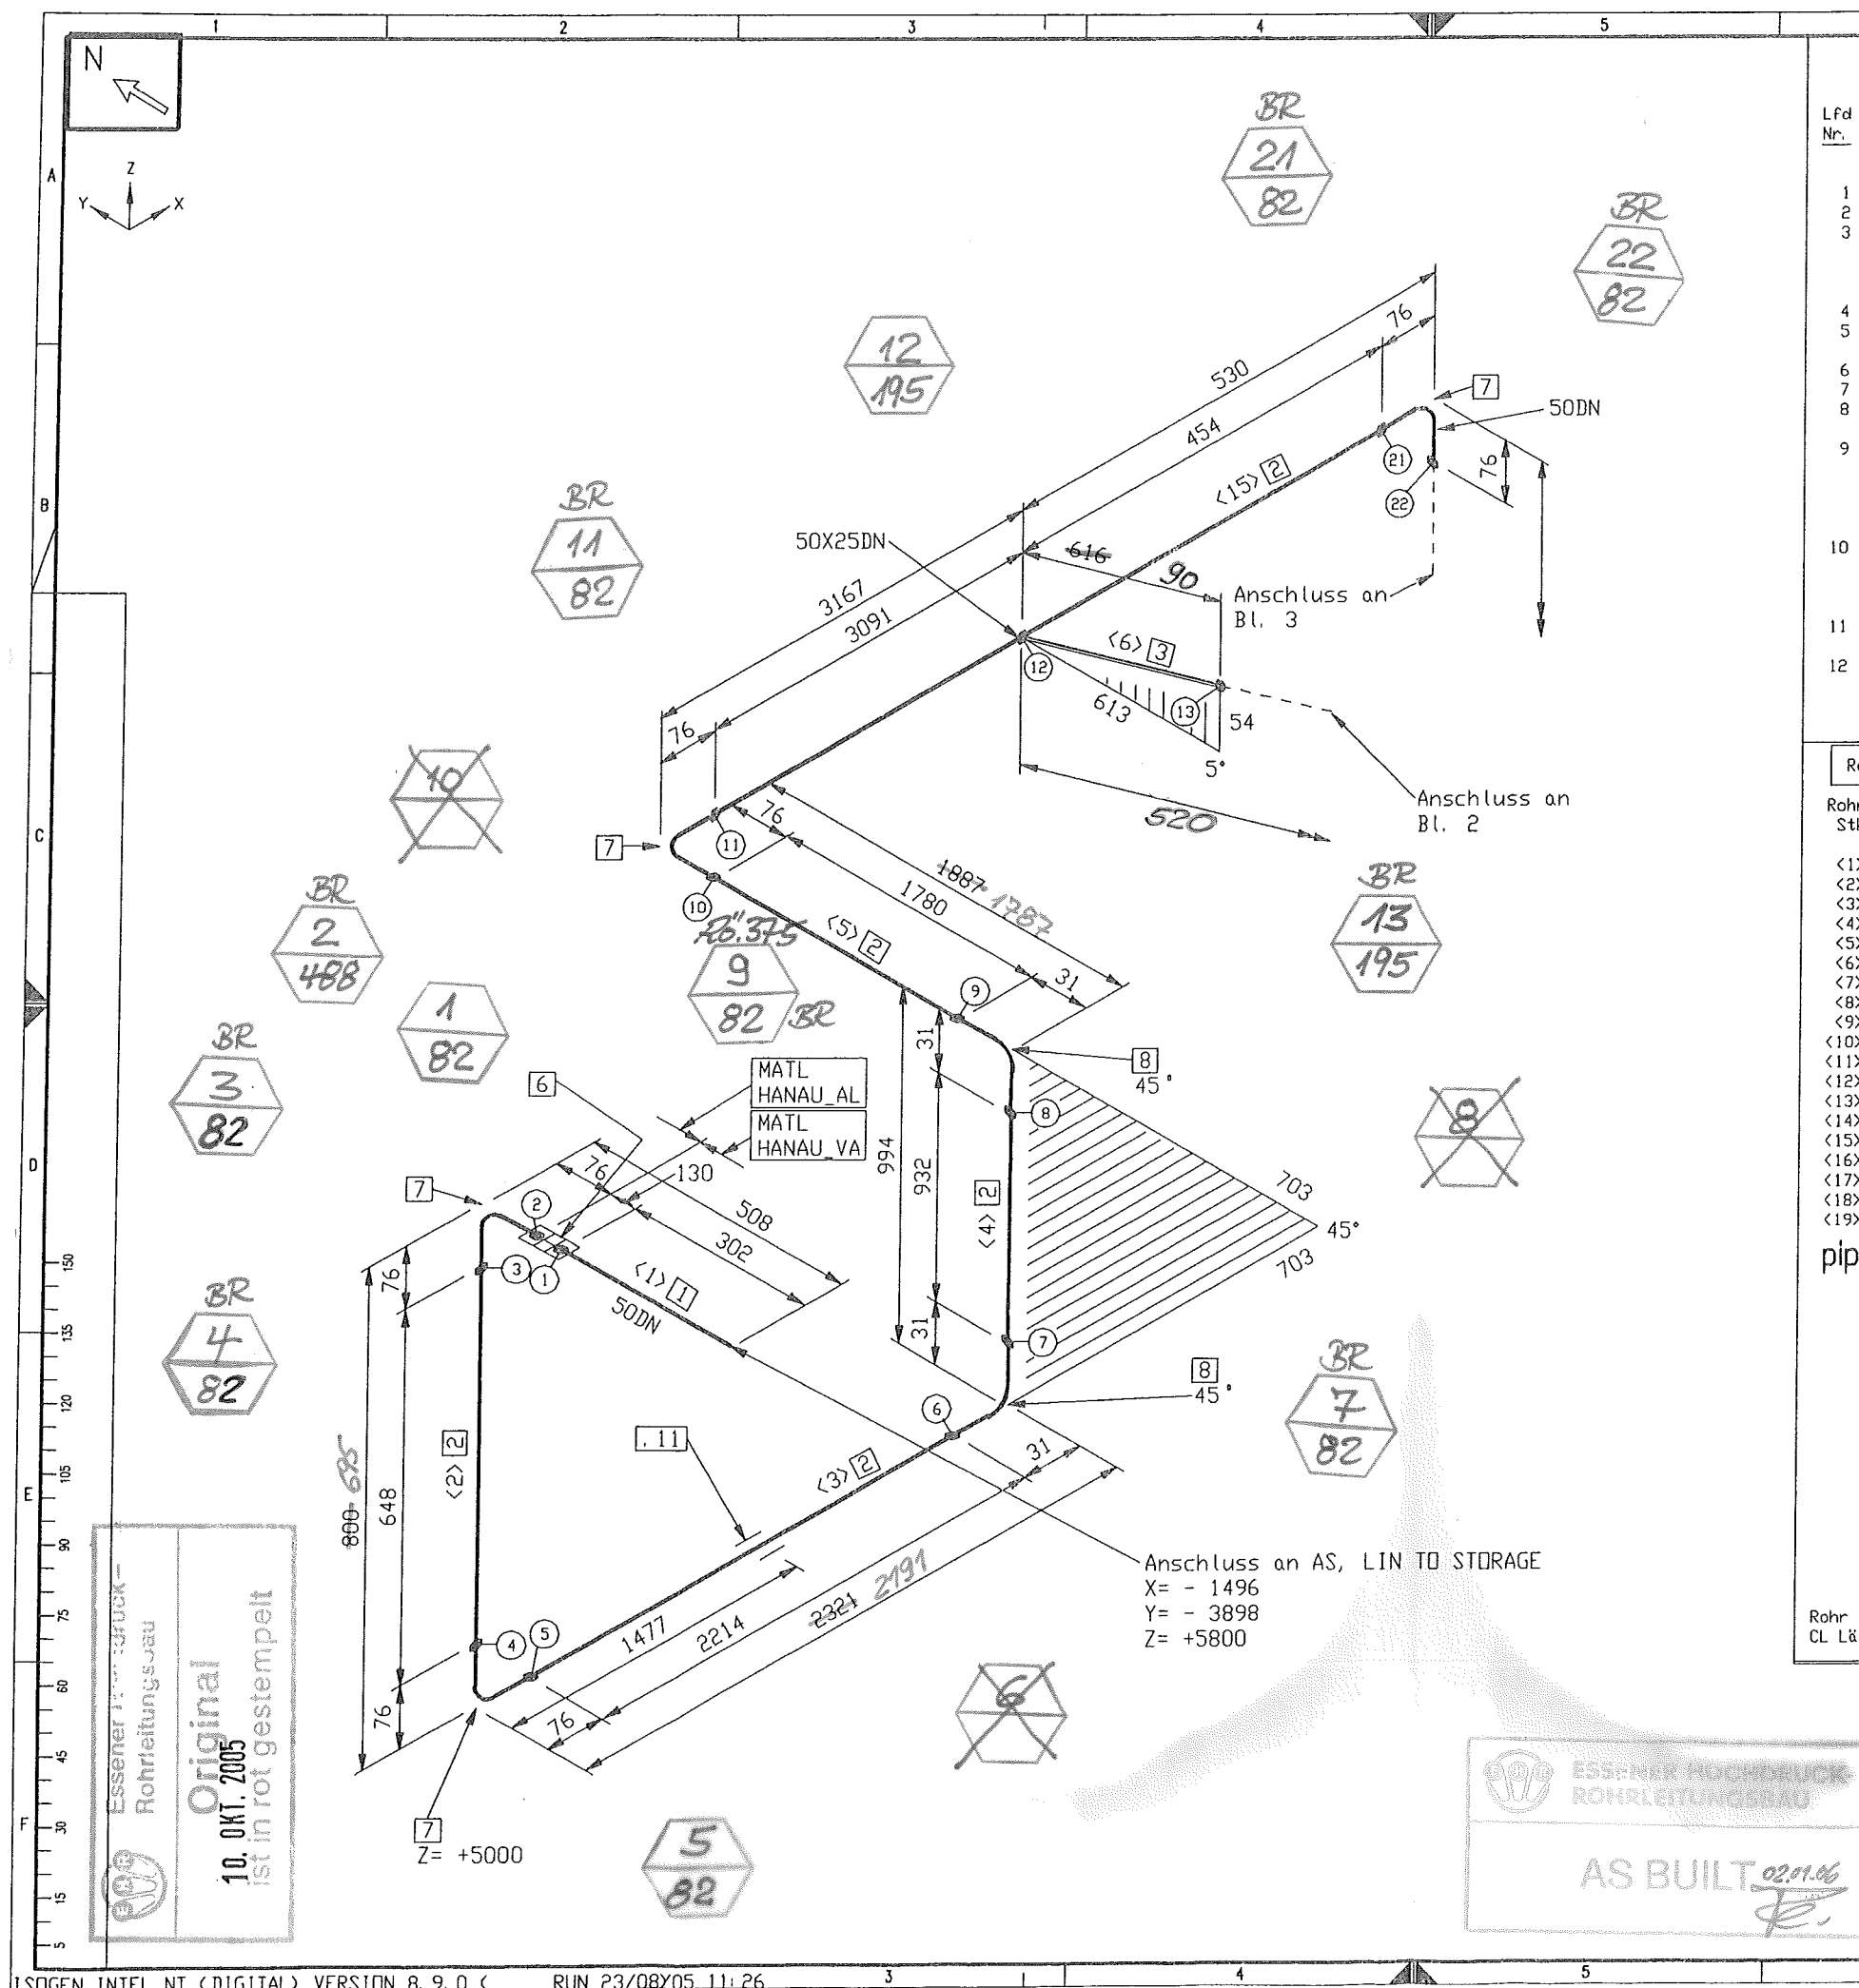

Stückliste					
Lfd Nr.	Benennung	DN (MM)	Sachnummer	Menge	Gewicht (kg)
Rohr					
1	ROHR 60,3 x 2,9 1.4541	50	0004980	302 MM	1.2
2	ROHR 60,3 x 3,9 ALMG4, 5MN W27	50	77038146	11963 MM	22.3
3	ROHR 33,4 x 3,4 ALMG4, 5MN W27	25	77038144	3054 MM	2.9
Fitting					
4	T-Stutzen 60,3x3,9 gez. auf 79311532	50X50	79313693	1	0.1
5	T-Stutzen 60,3x3,9 - 48,3x5,1 gez. auf 79311532	50X40	79314295	1	0.1
6	TRANSITIONJOINT DN 50/PN100	50	77038167	1	1.2
7	BOGEN 60,3x3,9 DIN2605-2-90-3 ALMG4, 5MN	50	77038155	6	1.4
8	BOGEN 60,3x3,9 DIN2605-2-90-3 ALMG4, 5MN	50	77038155_1	2	0.5
9	Stutzen auf 45 BOGEN 60,3x3,9 DIN2605-2-90-3 ALMG4, 5MN	50	77038155_2	1	0.2
Ventil					
10	Eck-Ventil AL DN 50 / PN 40	50	770.38866	1	50.0
Halterung					
11	Halterung B gezeichnet auf 79319026, L1=370	50	79320152	1	2.0
12	Bordscheibe gezeichnet auf 79313040	25	79313040	1	0.3
Summe Masse					82.2

Rohrzuschnitt						
Rohr Stk.	Länge (MM)	DN (MM)	Bemerkung	Rohr Ende 1	Rohr Ende 2	Sachnummer
<1>	302	50				0004980
<2>	648	50				77038146
<3>	2214	50				77038146
<4>	932	50				77038146
<5>	1780	50				77038146
<6>	586	25				77038144
<7>	100	25	PLD BEND(1)			77038144
<8>	1813	25				77038144
<9>	105	25	PLD BEND(1)			77038144
<10>	41	25				77038144
<11>	105	25	PLD BEND(1)			77038144
<12>	21	25				77038144
<13>	105	25	PLD BEND(1)			77038144
<14>	178	25				77038144
<15>	3545	50				77038146
<16>	1013	50				77038146
<17>	143	50				77038146
<18>	414	50				77038146
<19>	1274	50				77038146

piping support, piping guides
View from top