



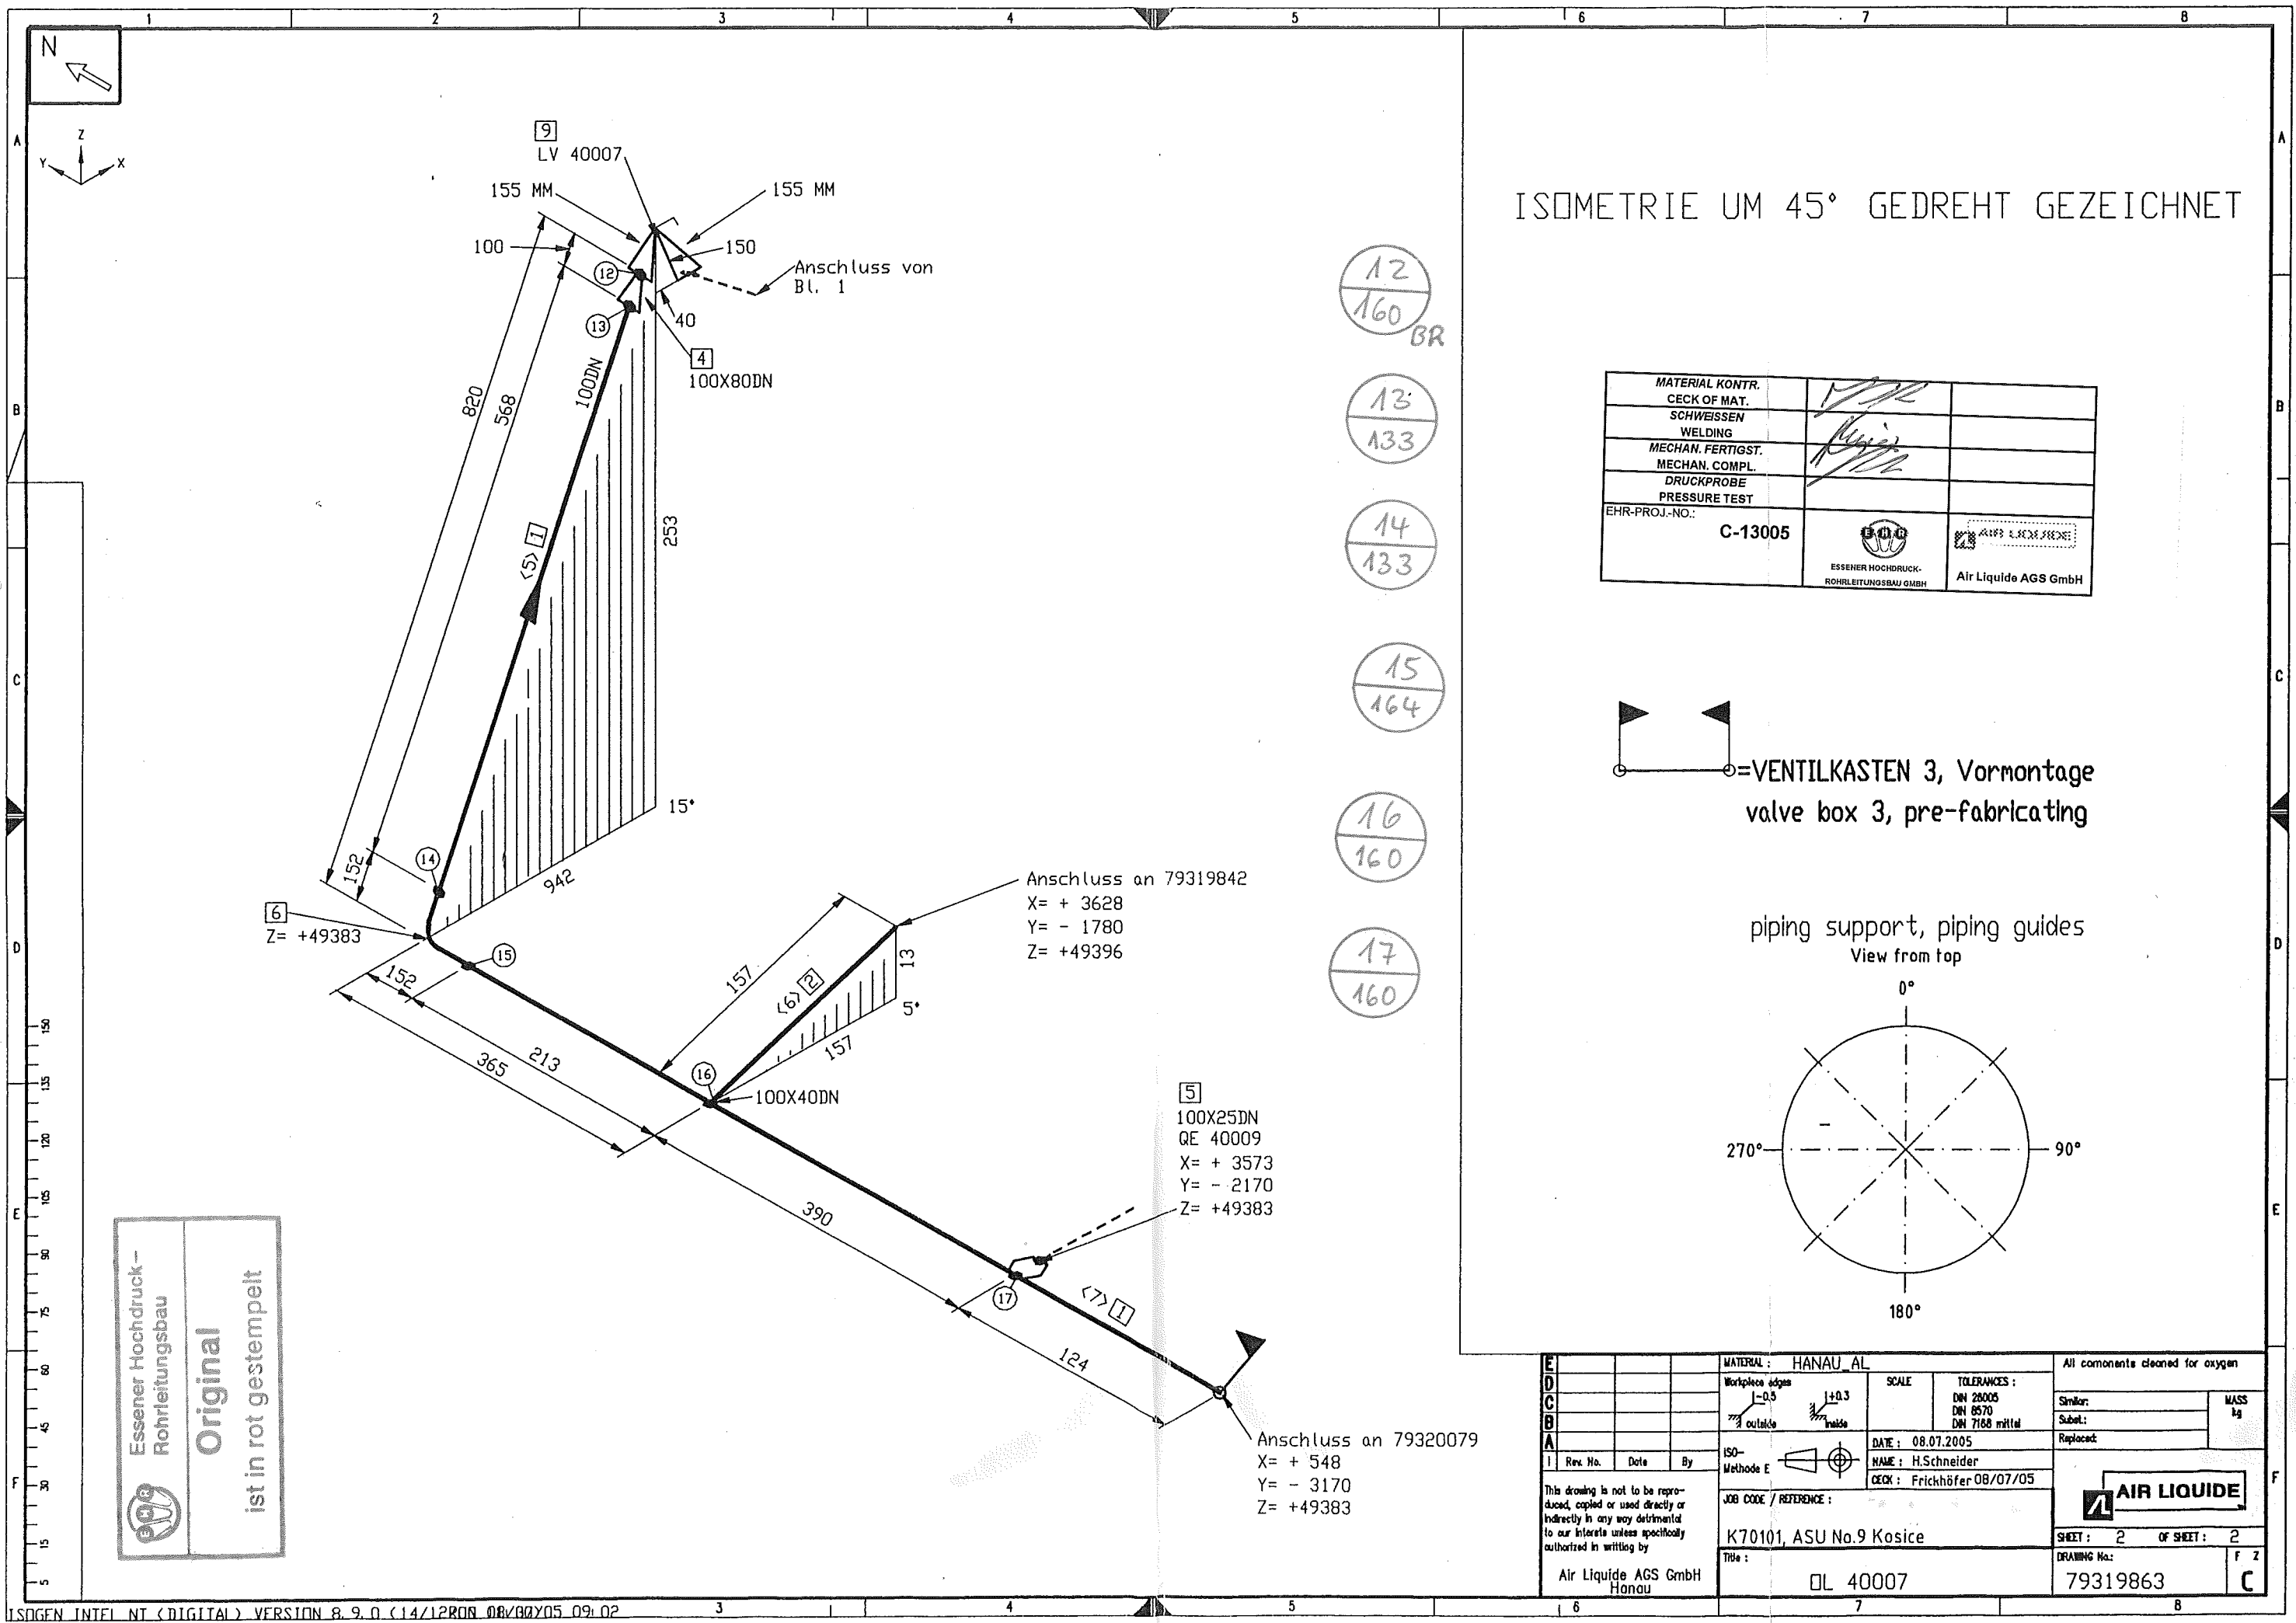

ISOMETRIE UM 45° GEDREHT GEZEICHNET

MATERIAL KONTR.		
CHECK OF MAT.		
SCHWEISSEN		
WELDING		
MECHAN. FERTIGST.		
MECHAN. COMPL.		
DRUCKPROBE		
PRESSURE TEST		
EHR-PROJ.-NO.:	C-13005	

VENTILKASTEN 3, Vormontage
valve box 3, pre-fabricating

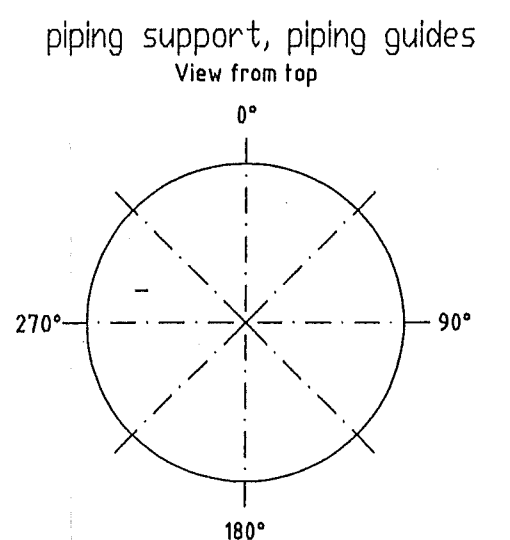

MATERIAL: HANAU_AL				All components cleaned for oxygen	
Workpiece edges		SCALE		TOLERANCES:	
-0.5		+0.3		DN 28005	
outside		inside		DN 8570	
ISO-Methode E		DATE: 08.07.2005		NAME: H.Schneider	
Rev. No.		Date		CHECK: Frickhöfer 08/07/05	
By		JOB CODE / REFERENCE:		K70101, ASU No.9 Kosice	
Title:		DL 40007		SHEET: 2 OF SHEET: 2	
Air Liquide AGS GmbH Hanau		DRAWING No.:		79319863	