


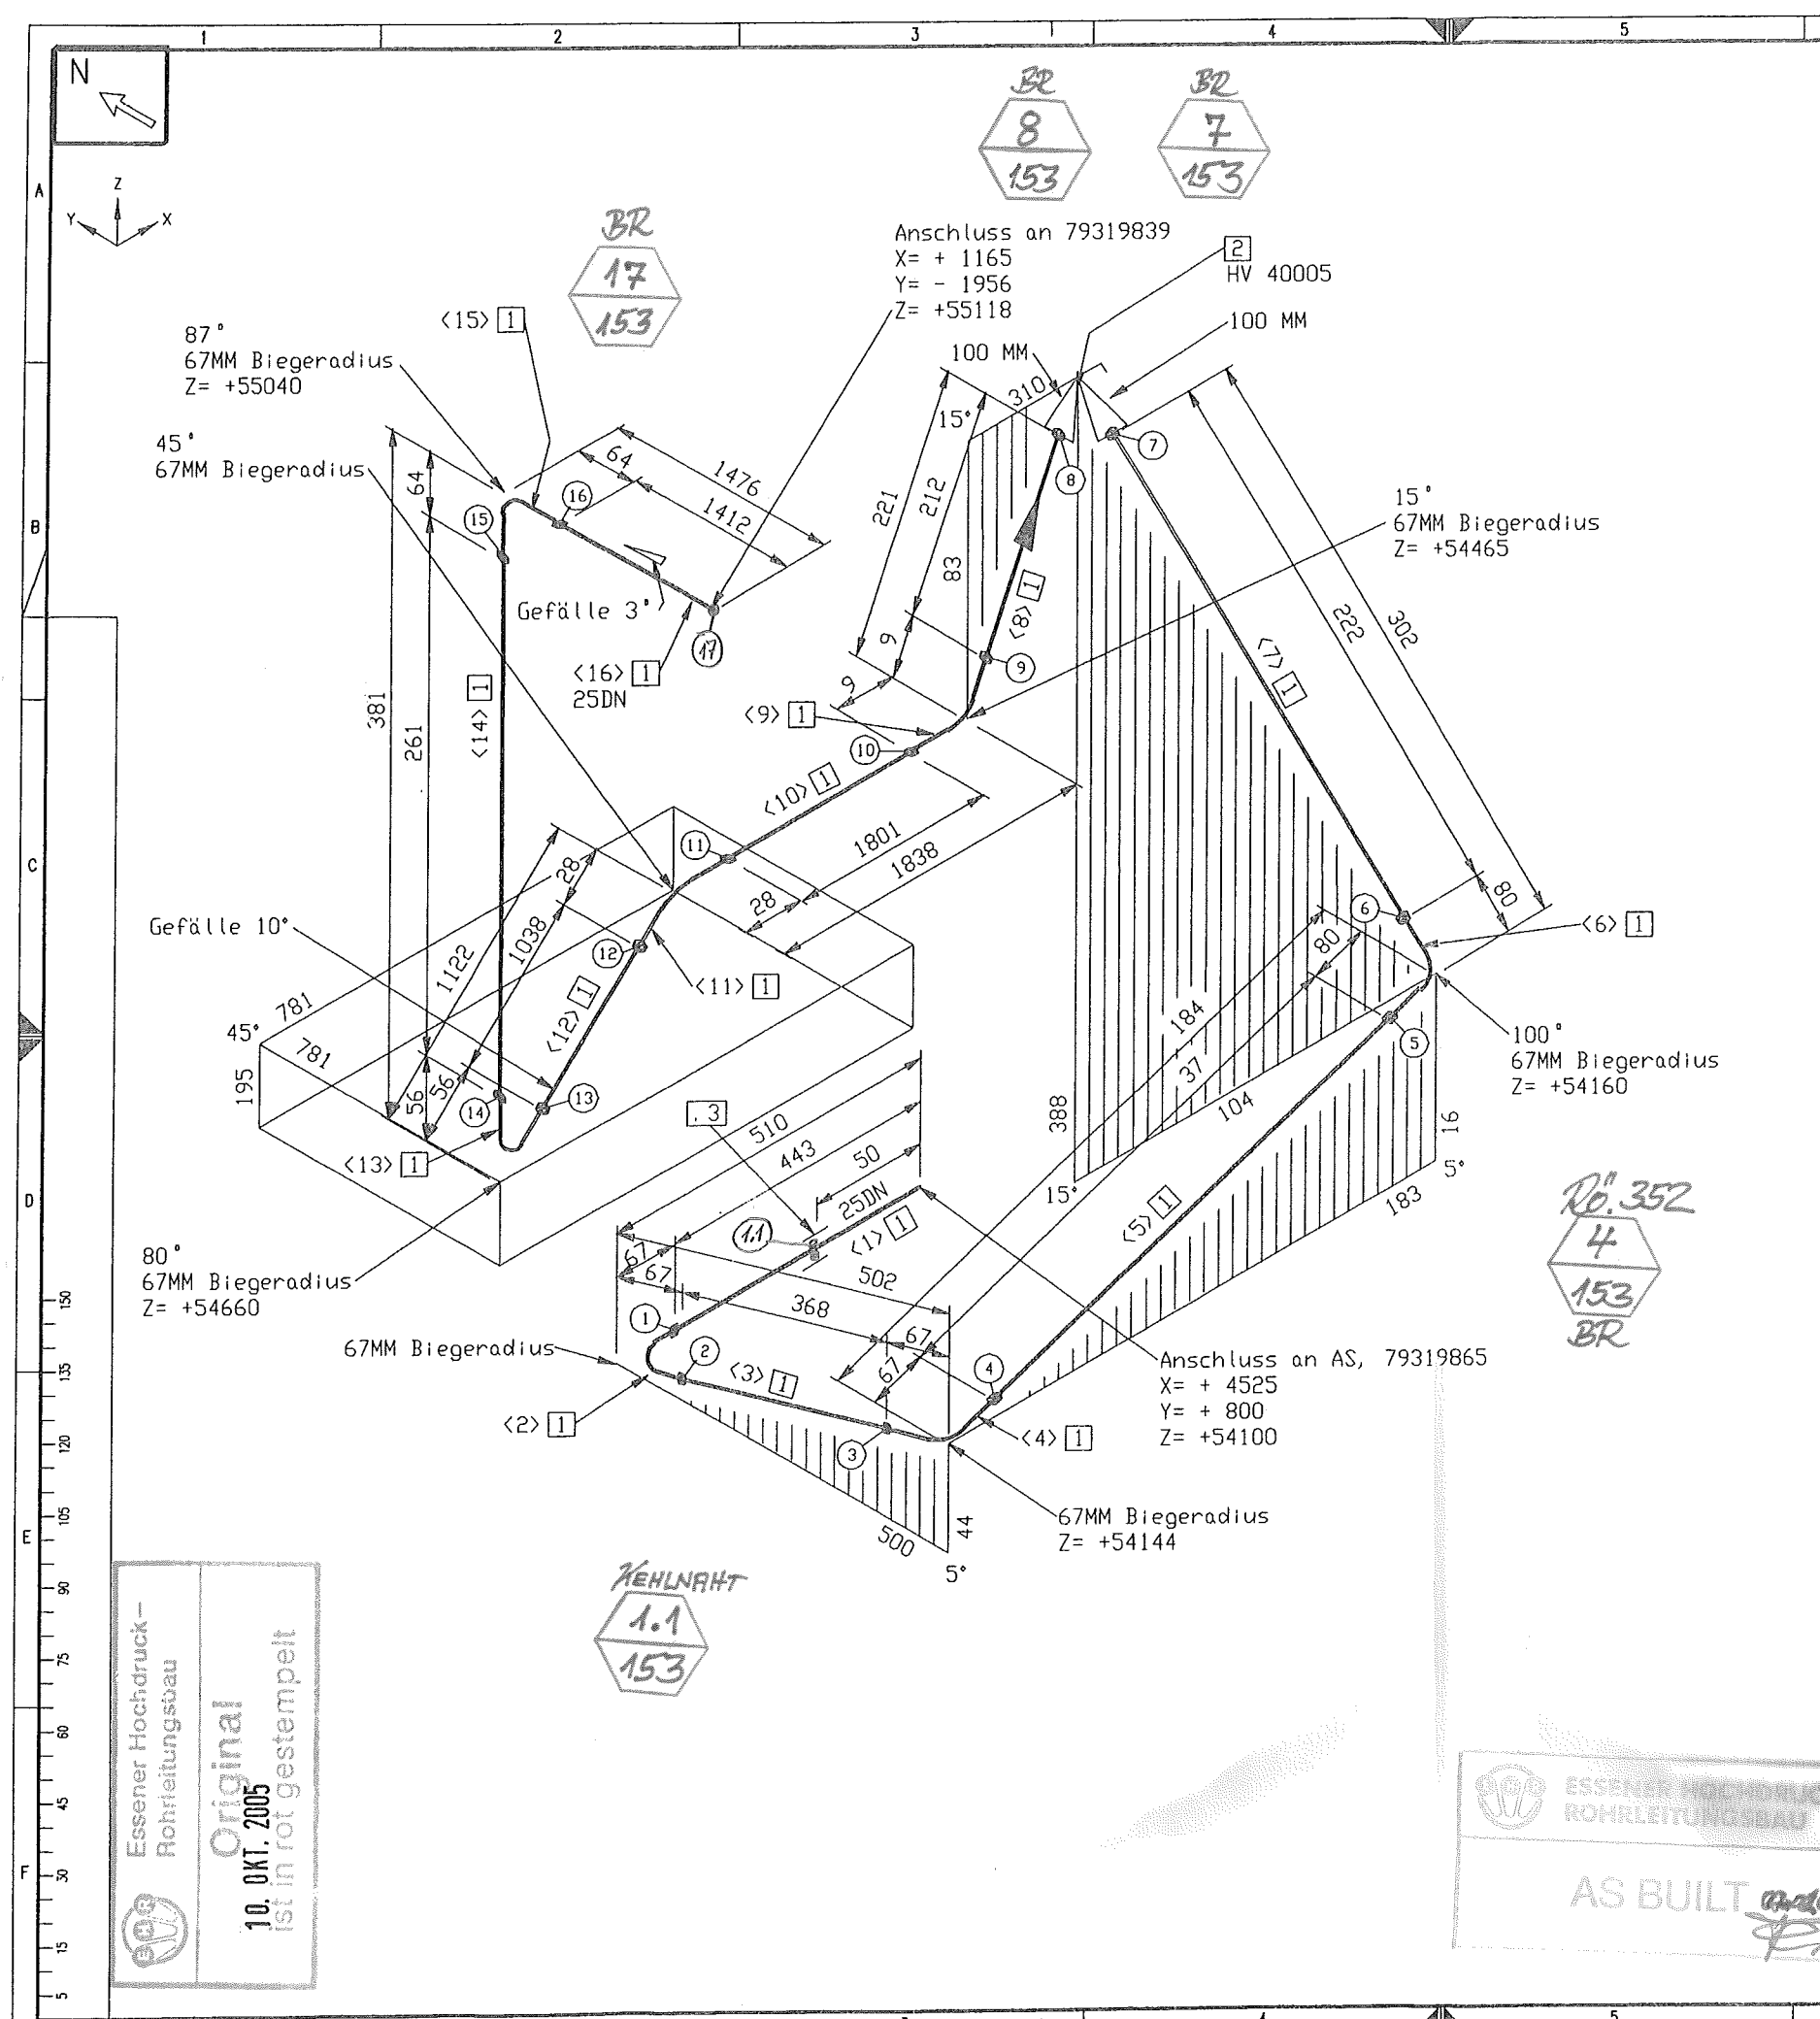

Stückliste					
Lfd. Nr.	Benennung	DN (MM)	Sachnummer	Menge	Gewicht (kg)
Rohr					
1	ROHR 33,4 X 3,4 ALMG4,5MN V27	25	77038144	6388 MM	5.5
Ventil					
2	Eck-Ventil AL DN 25 / PN 40	25	770.38864	1	40.0
Halterung					
3	Bordscheibe gez. auf 79313040	25	79313040	1	0.3
Summe Masse					45.9

Rohrzuschnitt					
Rohr Stk.	Länge (MM)	DN (MM)	Bemerkung	Rohr Ende 1	Rohr Ende 2
<1>	443	25			
<2>	105	25	PLD BEND(1)		
<3>	368	25			
<4>	105	25	PLD BEND(1)		
<5>	37	25			
<6>	117	25	PLD BEND(1)		
<7>	222	25			
<8>	212	25			
<9>	18	25	PLD BEND(1)		
<10>	1801	25			
<11>	53	25	PLD BEND(1)		
<12>	1038	25			
<13>	93	25	PLD BEND(1)		
<14>	261	25			
<15>	103	25	PLD BEND(1)		
<16>	1412	25			

Rohr DN (MM) 25
 CL Länge (MM) 6588

MATERIAL: HANAU AL
 Workpiece edges: 1+0.3
 SCALE: TOLERANCES: DN 28005, DN 8570, DN 7168 mittel
 DATE: 29.07.2005
 NAME: H.Schneider
 CHECK: Frickhöfer 29/07/05
 JOB CODE / REFERENCE: K70101, ASU No.9 Kosice
 Title: R 40014

All components cleaned for oxygen
 Shrink: MASS kg
 Subst.: Replaced
 AIR LIQUIDE
 SHEET: 1 OF SHEET: 1
 DRAWING No.: 79319864
 F Z C

