


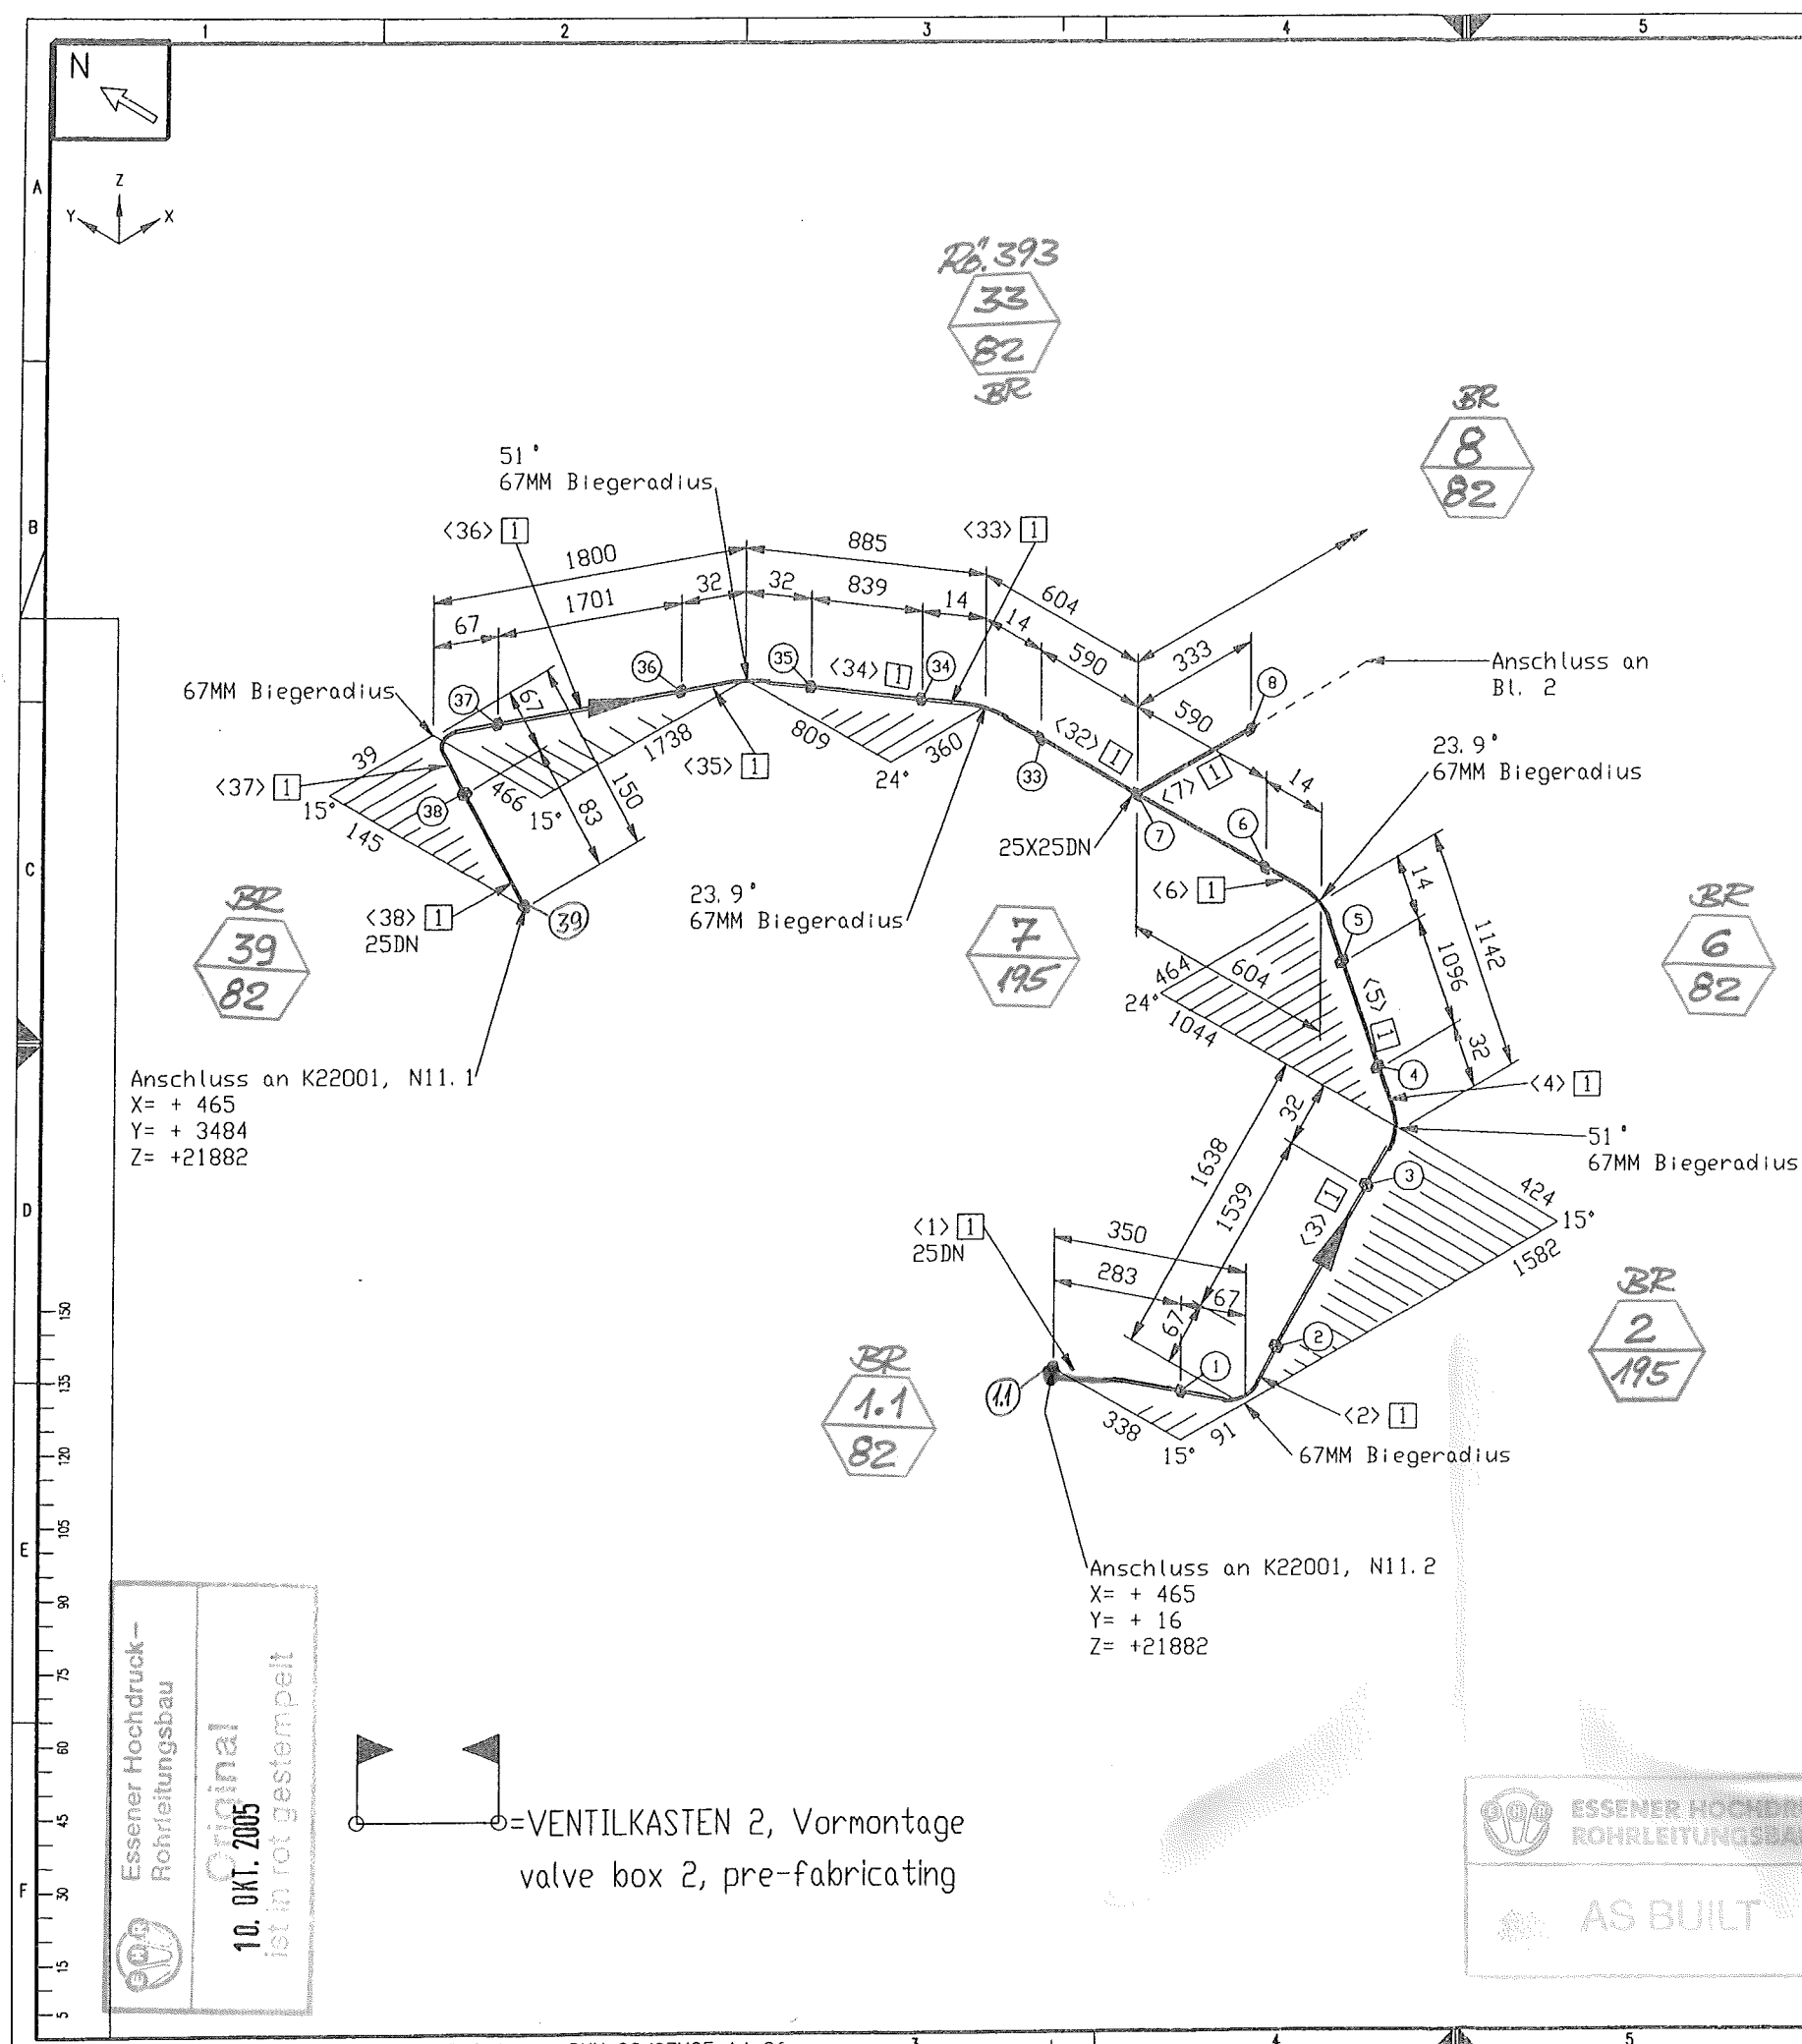

Stückliste					
Lfd. Nr.	Benennung	DN (MM)	Sachnummer	Menge	Gewicht (kg)
1	RDHR 33,4 X 3,4 ALMG4, 5MN V27	25	77038144	18121 MM	15.7
2	AUSSENMANTELDURCHFÜHRUNG DN 25	25	793.11515	1	2.0
Summe Masse					17.7

Rohrzuschnitt						
Rohr Stk.	Länge (MM)	DN (MM)	Bemerkung	Rohr Ende 1	Rohr Ende 2	Sachnummer
<1>	283	25				77038144
<2>	105	25	PLD BEND(1)			77038144
<3>	1539	25				77038144
<4>	60	25	PLD BEND(1)			77038144
<5>	1096	25				77038144
<6>	28	25	PLD BEND(1)			77038144
<7>	316	25				77038144
<8>	105	25	PLD BEND(1)			77038144
<9>	266	25				77038144
<10>	105	25	PLD BEND(1)			77038144
<11>	366	25				77038144
<12>	105	25	PLD BEND(1)			77038144
<13>	366	25				77038144
<14>	105	25	PLD BEND(1)			77038144
<15>	274	25				77038144
<16>	105	25	PLD BEND(1)			77038144
<17>	866	25				77038144
<18>	105	25	PLD BEND(1)			77038144
<19>	204	25				77038144
<20>	4	25	PLD BEND(1)			77038144
<21>	189	25				77038144
<22>	105	25	PLD BEND(1)			77038144
<23>	4256	25				77038144
<24>	87	25	PLD BEND(1)			77038144
<25>	699	25				77038144
<26>	87	25	PLD BEND(1)			77038144
<27>	1237	25				77038144
<28>	87	25	PLD BEND(1)			77038144
<29>	502	25				77038144
<30>	105	25	PLD BEND(1)			77038144
<31>	368	25				77038144
<32>	1180	25				77038144
<33>	28	25	PLD BEND(1)			77038144
<34>	839	25				77038144
<35>	60	25	PLD BEND(1)			77038144
<36>	1701	25				77038144
<37>	105	25	PLD BEND(1)			77038144
<38>	83	25				77038144

Rohr DN (MM)	25
CL Länge (MM)	18192

MATERIAL: HANAU AL	SCALE	TOLERANCES: DIN 28005 DIN 8570 DIN 7168 mittel	All components cleaned for oxygen
Workpiece edges: 1+0.3 inside, 1-0.5 outside	DATE: 20.07.2005	NAME: H.Schneider	Similar: MASS kg
ISO-Methode E	CHECK: Frickhöfer 20/07/05		Subst.: Replaced:
JOB CODE / REFERENCE: K70101, ASU No.9 Kosice			AIR LIQUIDE
Title: N 21025			SHEET: 1 OF SHEET: 3
Air Liquide AGS GmbH Hanau			DRAWING No.: 79319871 F 2