



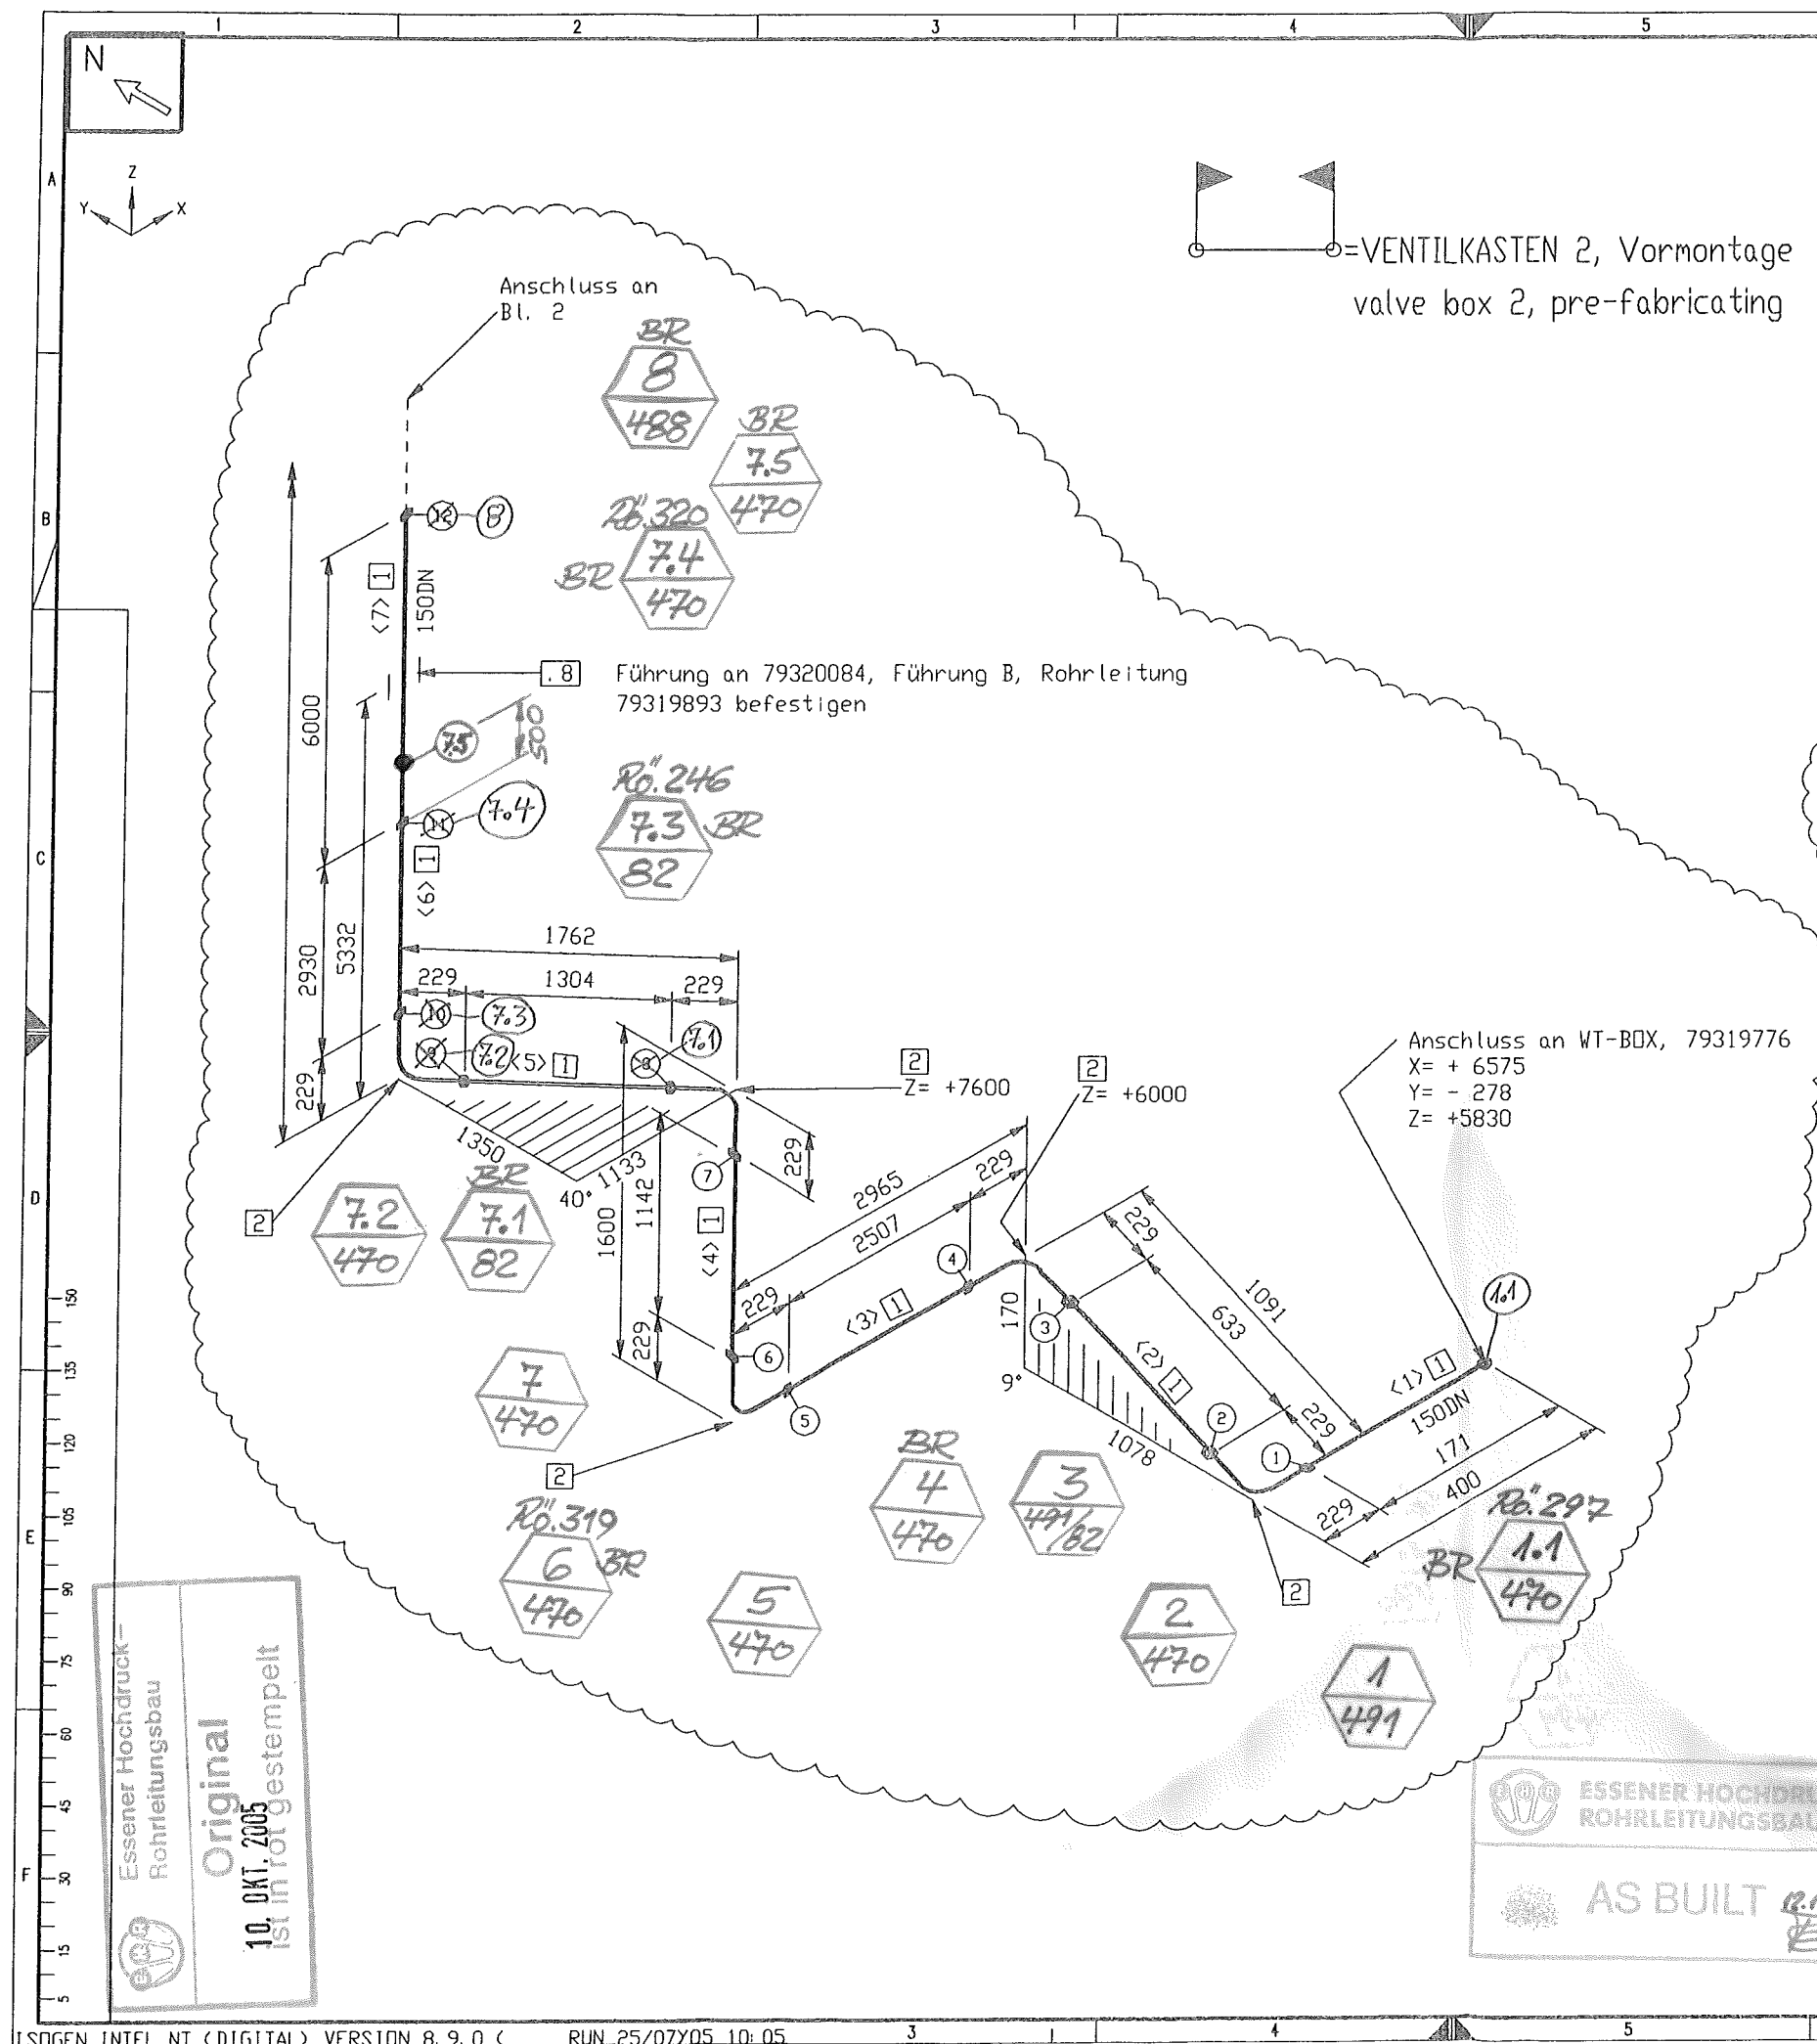

=VENTILKASTEN 2, Vormontage
 valve box 2, pre-fabricating

Stückliste					
Lfd. Nr.	Benennung	DN (MM)	Sachnummer	Menge	Gewicht (kg)
Rohr					
1	ROHR 168,3 X 7,1 ALMG4, 5MN W27	150	77038150	17098 MM	166.0
Fitting					
2	BOGEN 168,3x7,1 DIN2605-2-90-3 ALMG4, 5MN	150	77038158	5	17.5
3	BOGEN 168,3x7,1 DIN2605-2-90-3 ALMG4, 5MN	150	77038158_1	1	3.5
4	BOGEN 168,3x7,1 DIN2605-2-90-3 ALMG4, 5MN	150	77038158_2	1	3.5
5	BOGEN 168,3x7,1 DIN2605-2-90-3 ALMG4, 5MN	150	77038158_3	1	3.5
6	BOGEN 168,3x7,1 DIN2605-2-90-3 ALMG4, 5MN	150	77038158_4	1	3.5
Ventil					
7	Eck-Ventil AL DN 150 / PN 40 (Känner)	150	770.38869	1	100.0
Halterung					
8	Führung B gezeichnet auf 79318176, L1=622	150	79320085	1	8.6
Summe Masse					306.0

Rohrzuschnitt						
Rohr Stk.	Länge (MM)	DN (MM)	Bemerkung	Rohr Ende 1	Rohr Ende 2	Sachnummer
<1>	171	150				77038150
<2>	633	150				77038150
<3>	2507	150				77038150
<4>	1142	150				77038150
<5>	1304	150				77038150
<6>	2930	150				77038150
<7>	6000	150				77038150
<8>	895	150				77038150
<9>	867	150				77038150
<10>	649	150				77038150

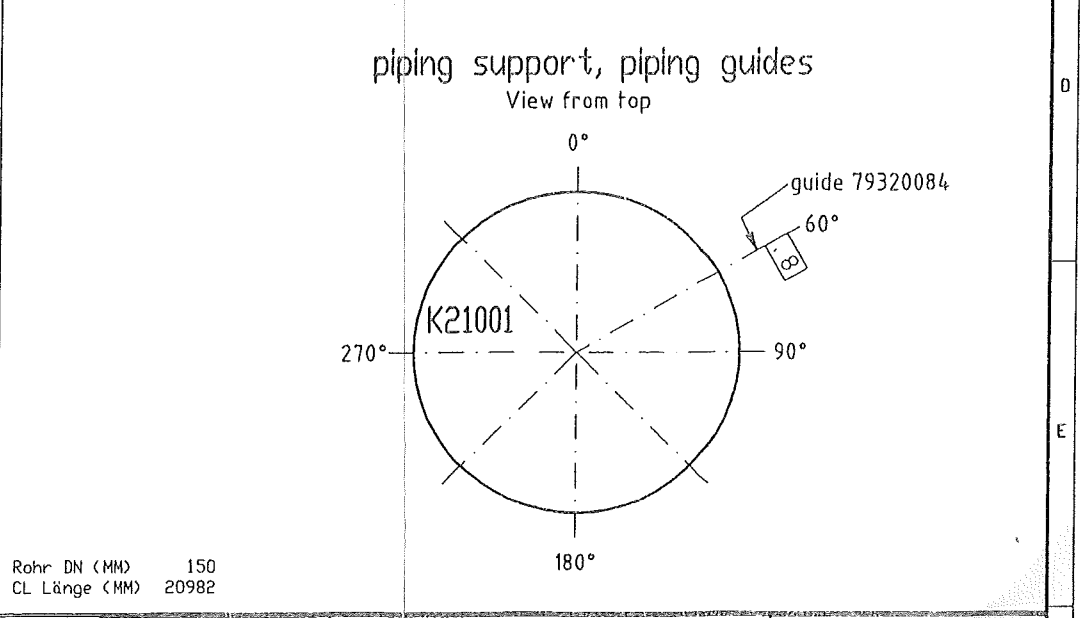

E		MATERIAL: HANAU AL		All components cleaned for oxygen	
D		Workplace edges		SCALE	
C		TOLERANCES:		TOLERANCES:	
B		ISO-Methode E		DATE: 25.07.2005	
A		Rev. No.		NAME: H.Schneider	
I		Date		CHECK: Frickhöfer 25/07/05	
By		JOB CODE / REFERENCE:		SHEET: 1 OF SHEET: 2	
This drawing is not to be reproduced, copied or used directly or indirectly in any way detrimental to our interests unless specifically authorized in writing by		K70101, ASU No.9 Kosice		DRAWING No.: 79319911	
Air Liquide AGS GmbH Hanau		□ 22002		F Z C	