



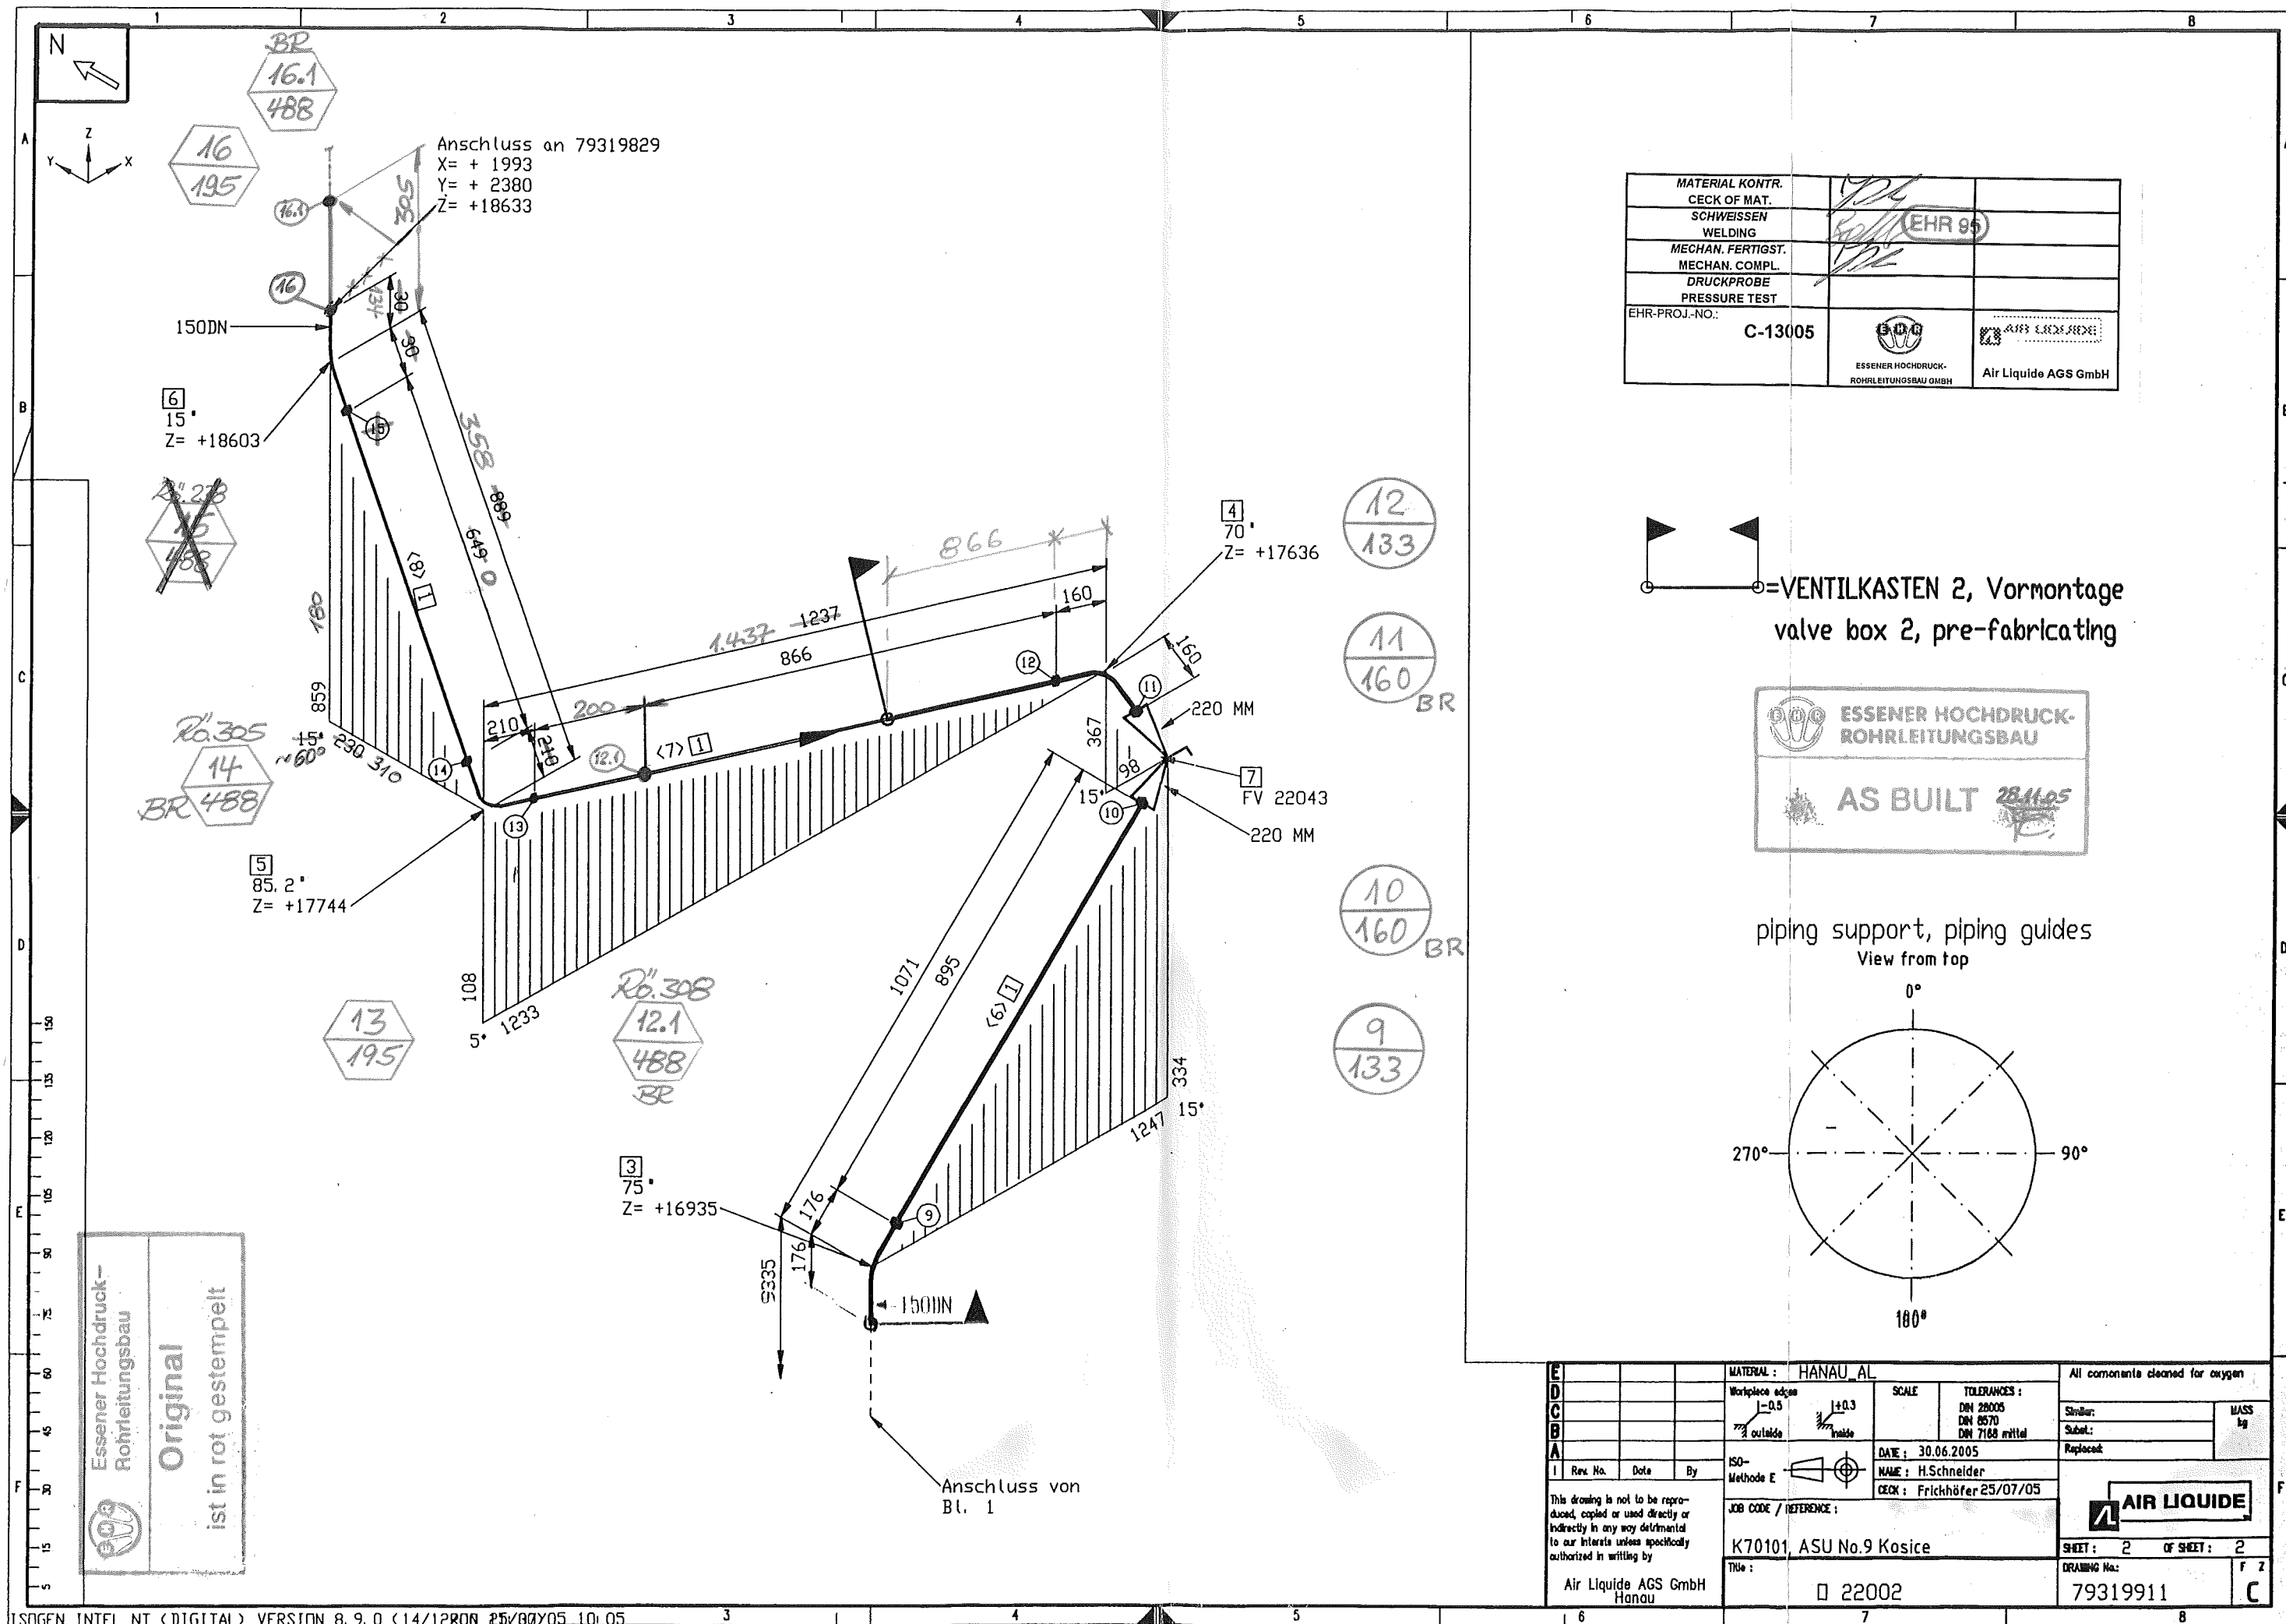


MATERIAL KONTR.		
CECK OF MAT.		
SCHWEISSEN		
WELDING		
MECHAN. FERTIGST.		
MECHAN. COMPL.		
DRUCKPROBE		
PRESSURE TEST		
EHR-PROJ.-NO.:	C-13005	
	ESSENER HOCHDRUCK-ROHRLEITUNGSBAU GMBH	Air Liquide AGS GmbH

VENTILKASTEN 2, Vormontage
valve box 2, pre-fabricating

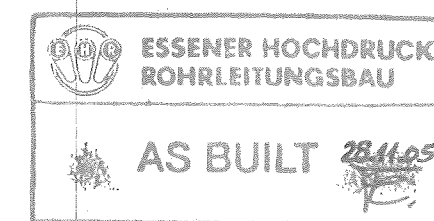

piping support, piping guides
View from top

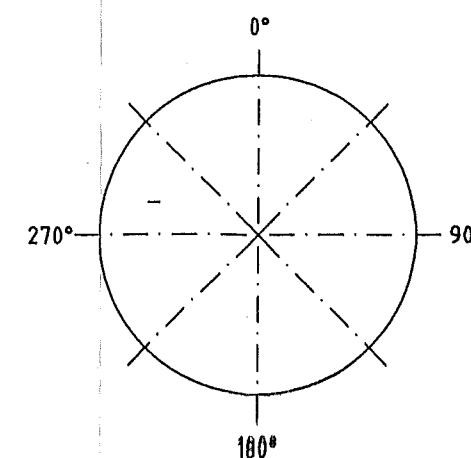

MATERIAL : HANAU_AL			SCALE		TOLERANCES :		All components cleaned for oxygen	
Workpiece edges			1:0.3		DIN 28005		Similar:	MASS
2 outside			inside		DIN 8570		Subst.:	kg
ISO-Methode E			DATE : 30.06.2005		NAME : H. Schneider		Replaced:	
JOB CODE / REFERENCE :			CECK : Frickhöfer 25/07/05		AIR LIQUIDE		SHEET : 2 OF SHEET : 2	
Title :			K70101, ASU No.9 Kosice		DRAWING No.:		79319911	
Air Liquide AGS GmbH Hanau			□ 22002				F Z	