



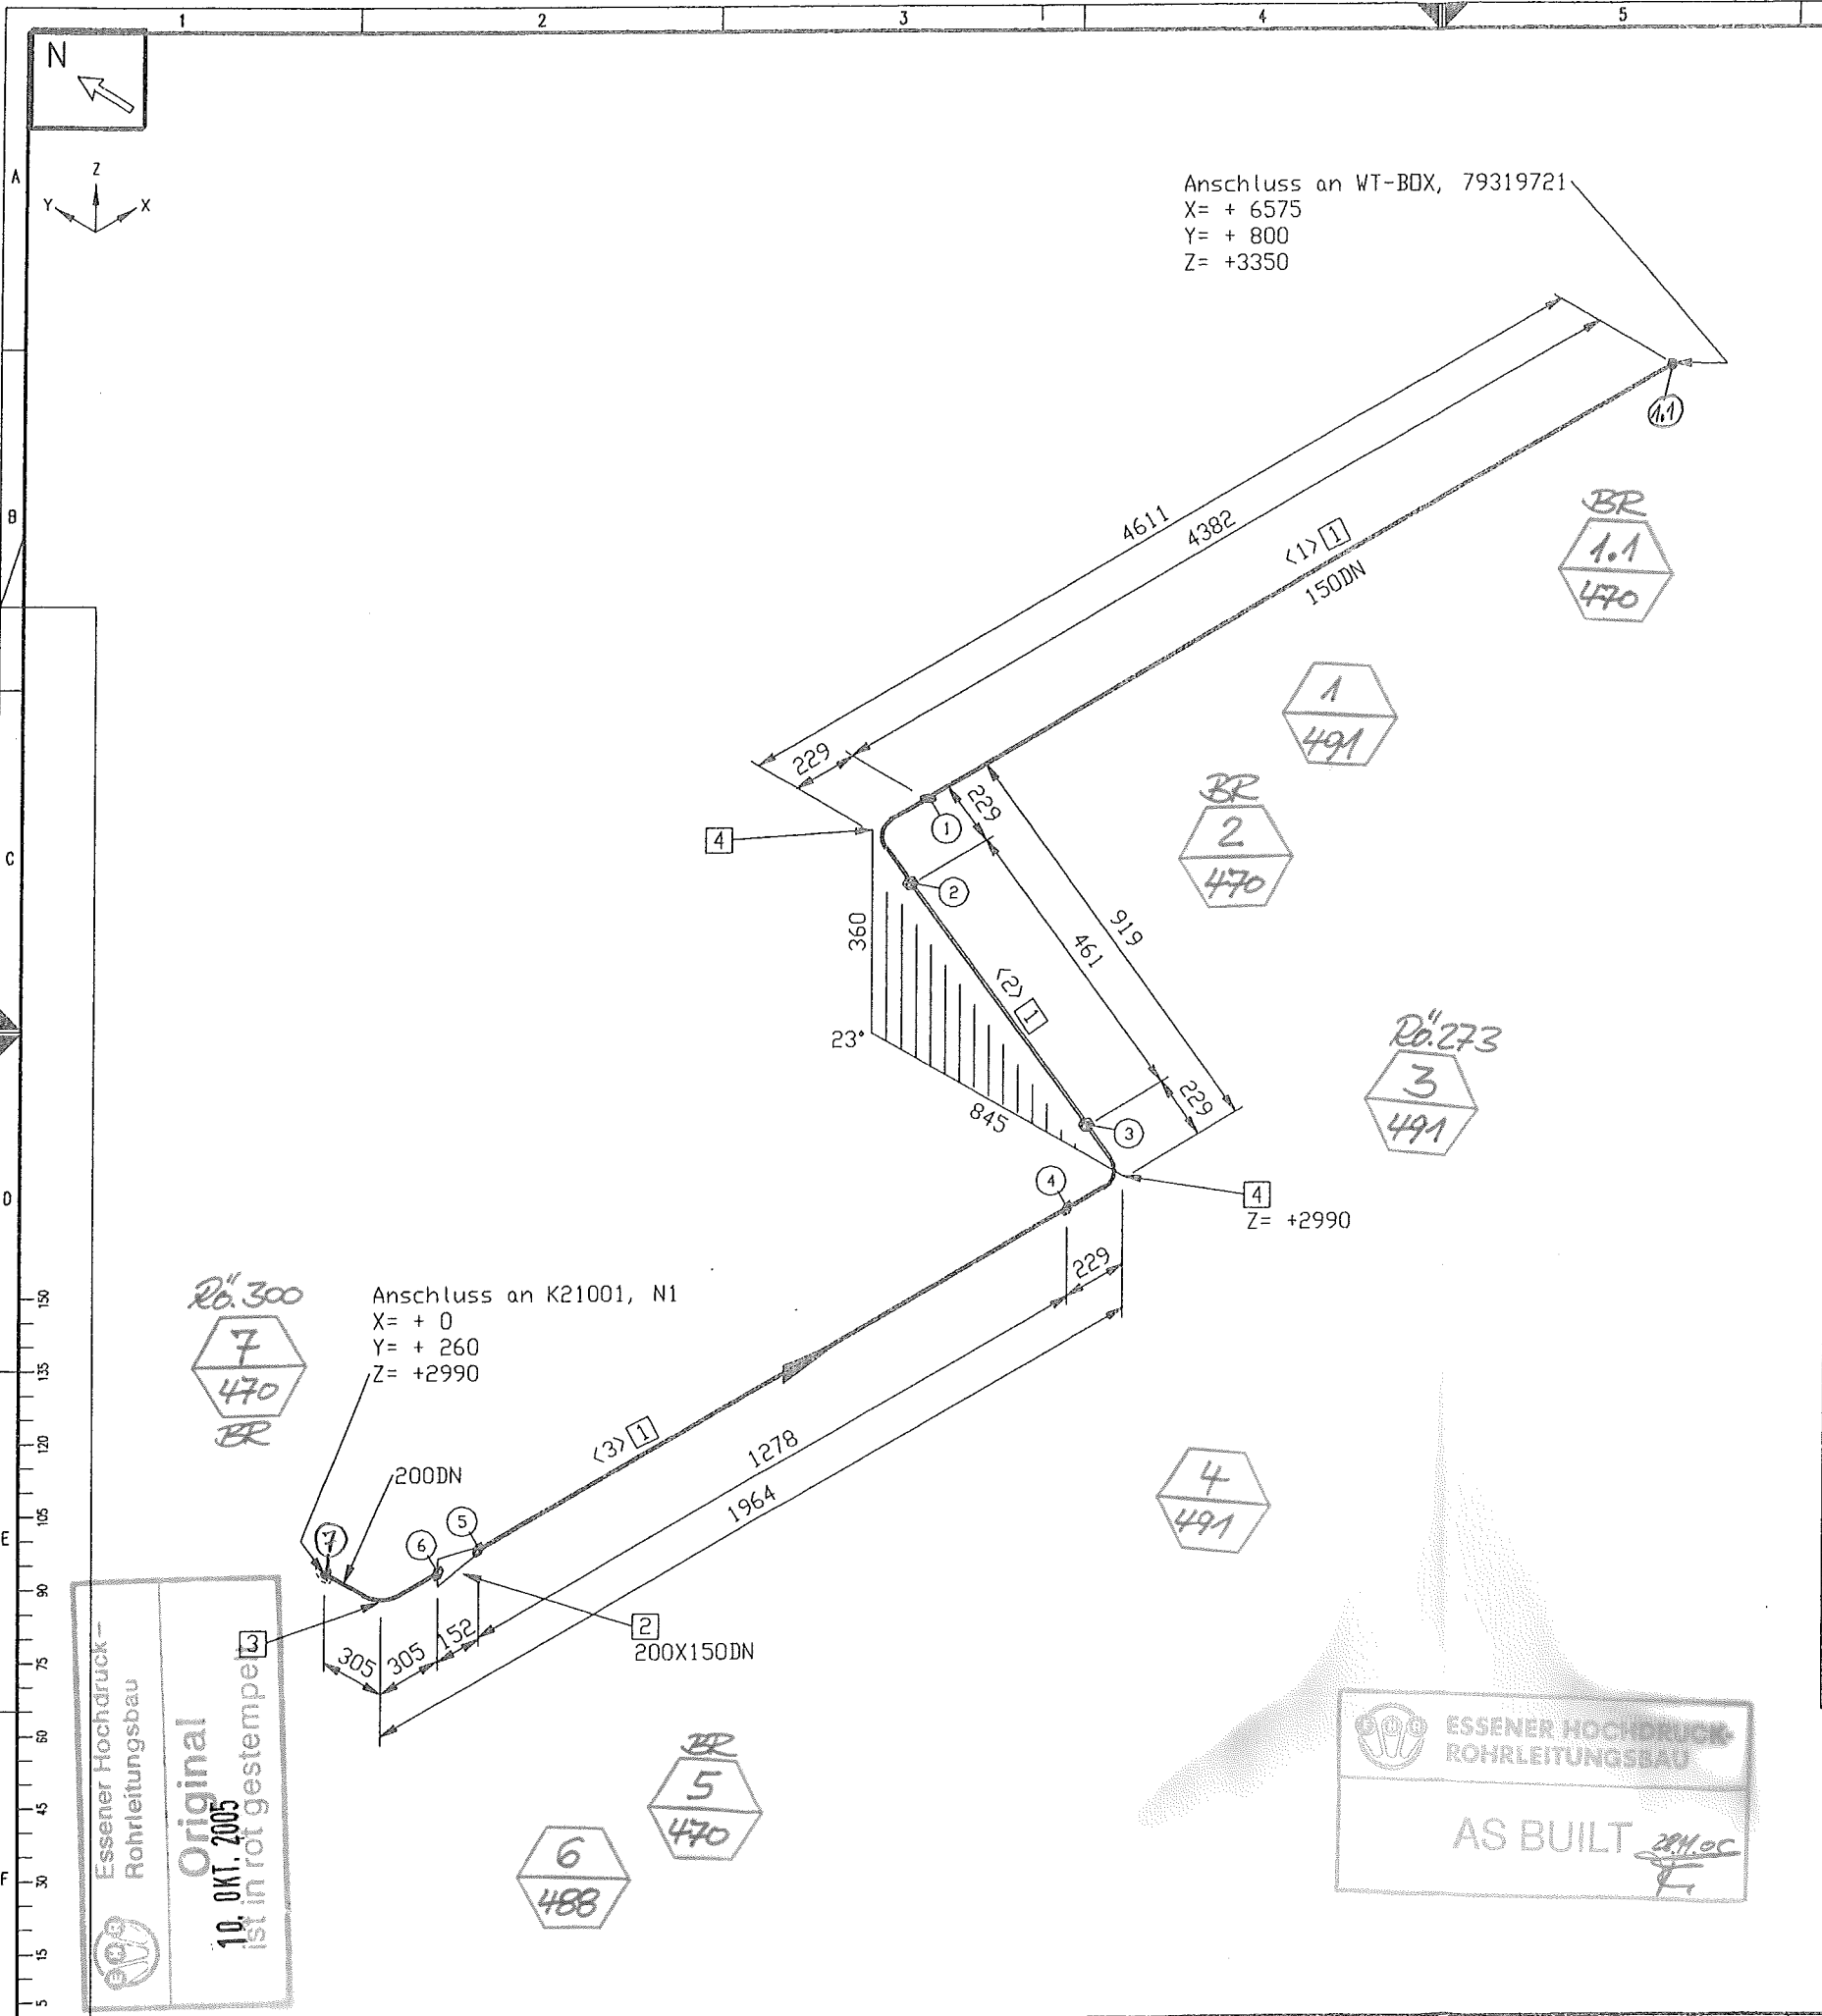

Stückliste					
Lfd. Nr.	Benennung	DN (MM)	Sachnummer	Menge	Gewicht (kg)
Rohr					
1	ROHR 168,3 X 7,1 ALMG4,5MN W27	150	77038150	6121 MM	59.4
Fitting					
2	RED. -STUCK-K-219,1 x 6,0-168,3 x 6,0	200X150	79314059	1	1.5
3	gez. auf 79312884				
3	BOGEN 219,1x6,4 DIN2605-2-90-3 ALMG4,5MN	200	77038159	1	5.5
4	BOGEN 168,3x7,1 DIN2605-2-90-3 ALMG4,5MN	150	77038158	2	7.0
Summe Masse					73.4

Rohrzuschnitt						
Rohr Stk.	Länge (MM)	DN (MM)	Bemerkung	Rohr Ende 1	Rohr Ende 2	Sachnummer
<1>	4382	150				77038150
<2>	461	150				77038150
<3>	1278	150				77038150

piping support, piping guides
View from top

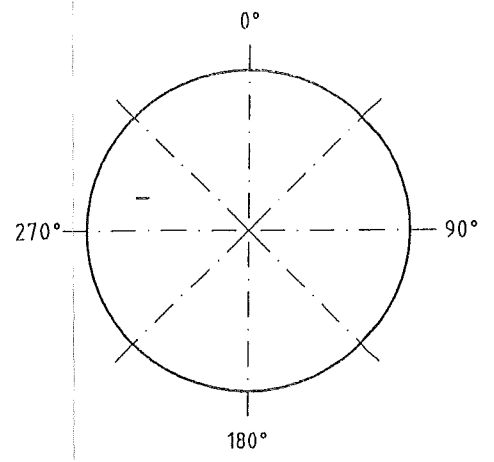

Rohr DN (MM)	200	150
CL Länge (MM)	762	7037

E		MATERIAL: HANAU AL		All components cleaned for oxygen	
D		Workplace edges	SCALE	TOLERANCES:	Simtor:
C		-0.5		DIN 28005	Subst:
B		outside		DIN 8570	Replaced:
A		inside		DIN 7168 milled	
Rev. No.		Date	By	DATE: 30.08.2005	
ISO-Methode E		NAME: H.Schneider		CHECK: Frickhöfer 30/08/05	
This drawing is not to be reproduced, copied or used directly or indirectly in any way detrimental to our interests unless specifically authorized in writing by					
Air Liquide AGS GmbH Hanau		JOB CODE / REFERENCE:		SHEET: 1 OF SHEET: 1	
		K70101, ASU No.9 Kosice		DRAWING No.: 79319915	
		Title: DL 21023		F Z C	