
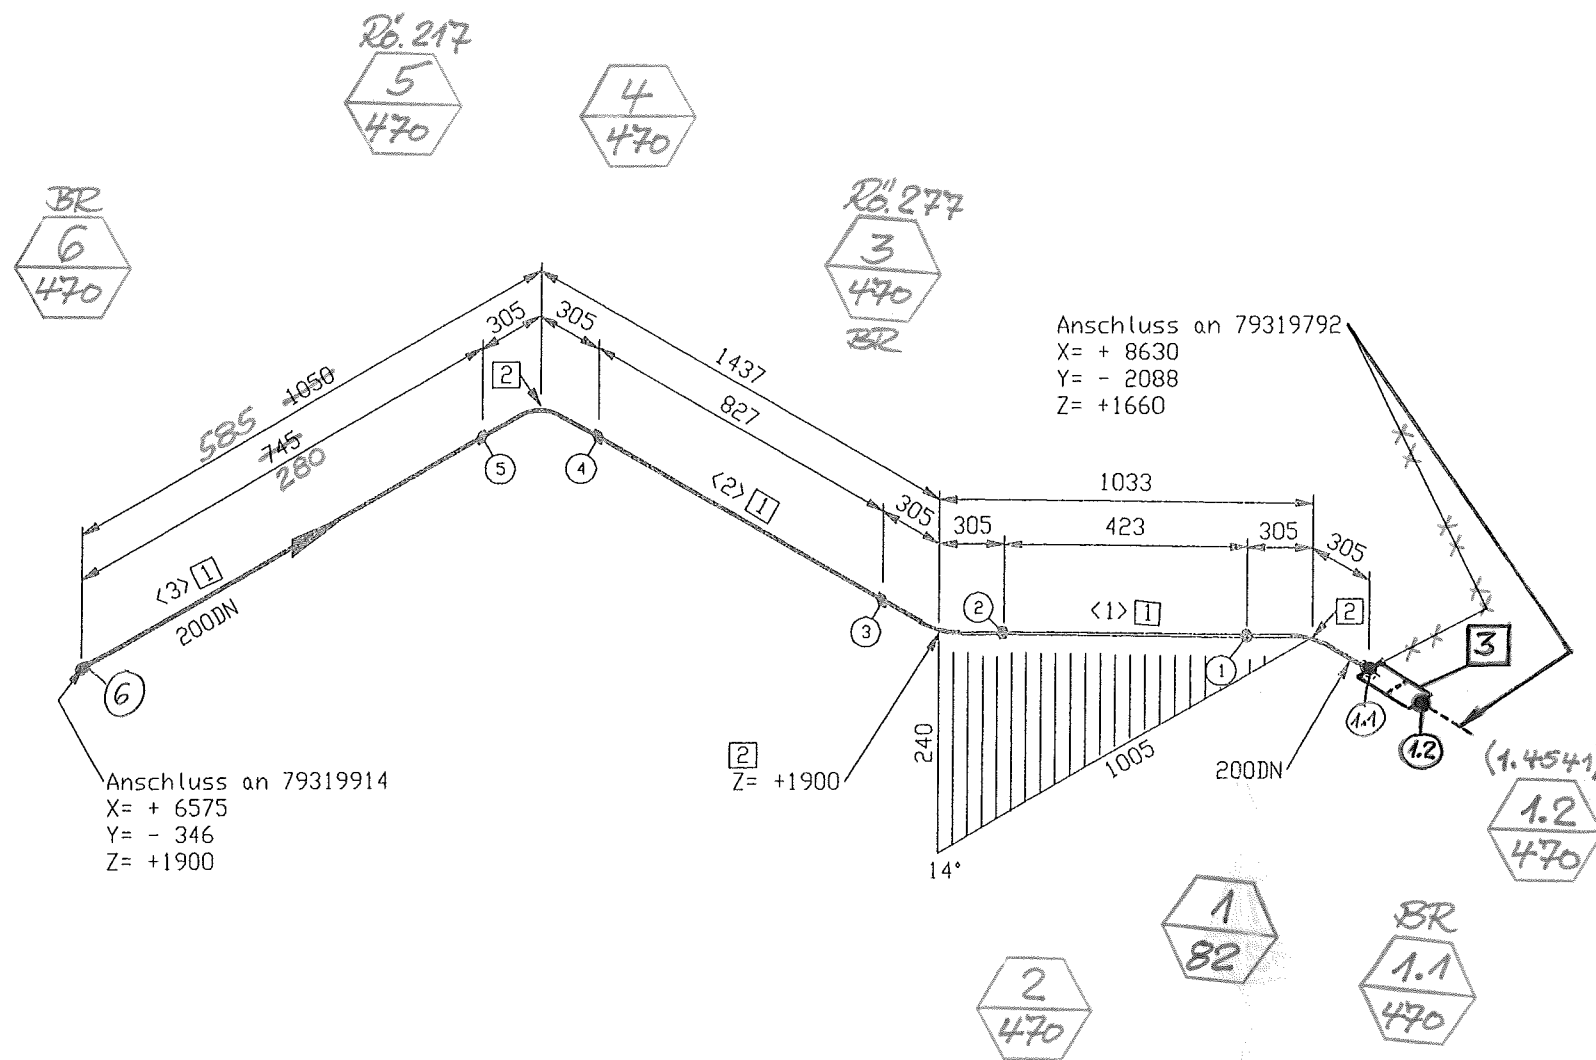
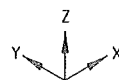


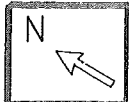

Anschluss an 79319914
X= + 6575
Y= - 346
Z= +1900

Anschluss an 79319792
X= + 8630
Y= - 2088
Z= +1660

Z= +1900


Stückliste

Lfd. Nr.	Benennung	DN (MM)	Sachnummer	Menge	Gewicht (kg)
Rohr					
1	RDHR 219,1 X 6,4 ALMG4,5MN W27	200	77038151	1995 MM	23.0
Fitting					
2	BOGEN 219,1x6,4 DIN2605-2-90-3 ALMG4,5MN	200	77038159	3	16.6
3	TRANSITIONSGEHT DN200/PN100	200	77038151	1	9.0
Summe Masse					48.6

Rohrzuschnitt

Rohr Stk.	Länge (MM)	DN (MM)	Benennung	Rohr Ende 1	Rohr Ende 2	Sachnummer
<1>	423	200				77038151
<2>	827	200				77038151
<3>	745	200				77038151

piping support, piping guides
View from top

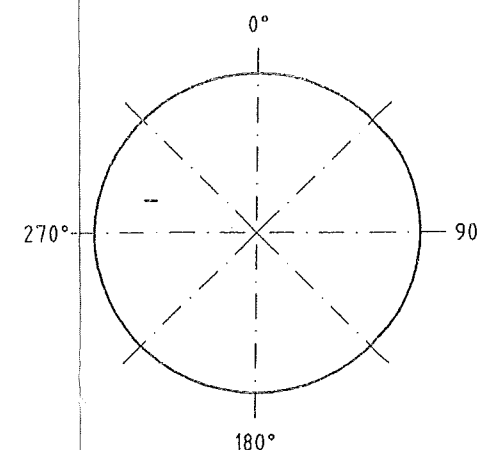

Rohr DN (MM) 200
CL Länge (MM) 3825

E		D		C		B		A		I		Rev. No.		Date		By		MATERIAL: HANAU AL		SCALE		TOLERANCES: DN 28005 DN 8570 DN 7168 mittel		All components cleaned for oxygen	
1		2		3		4		5		6		7		8		9		10		11		12		13	
1		2		3		4		5		6		7		8		9		10		11		12		13	
