


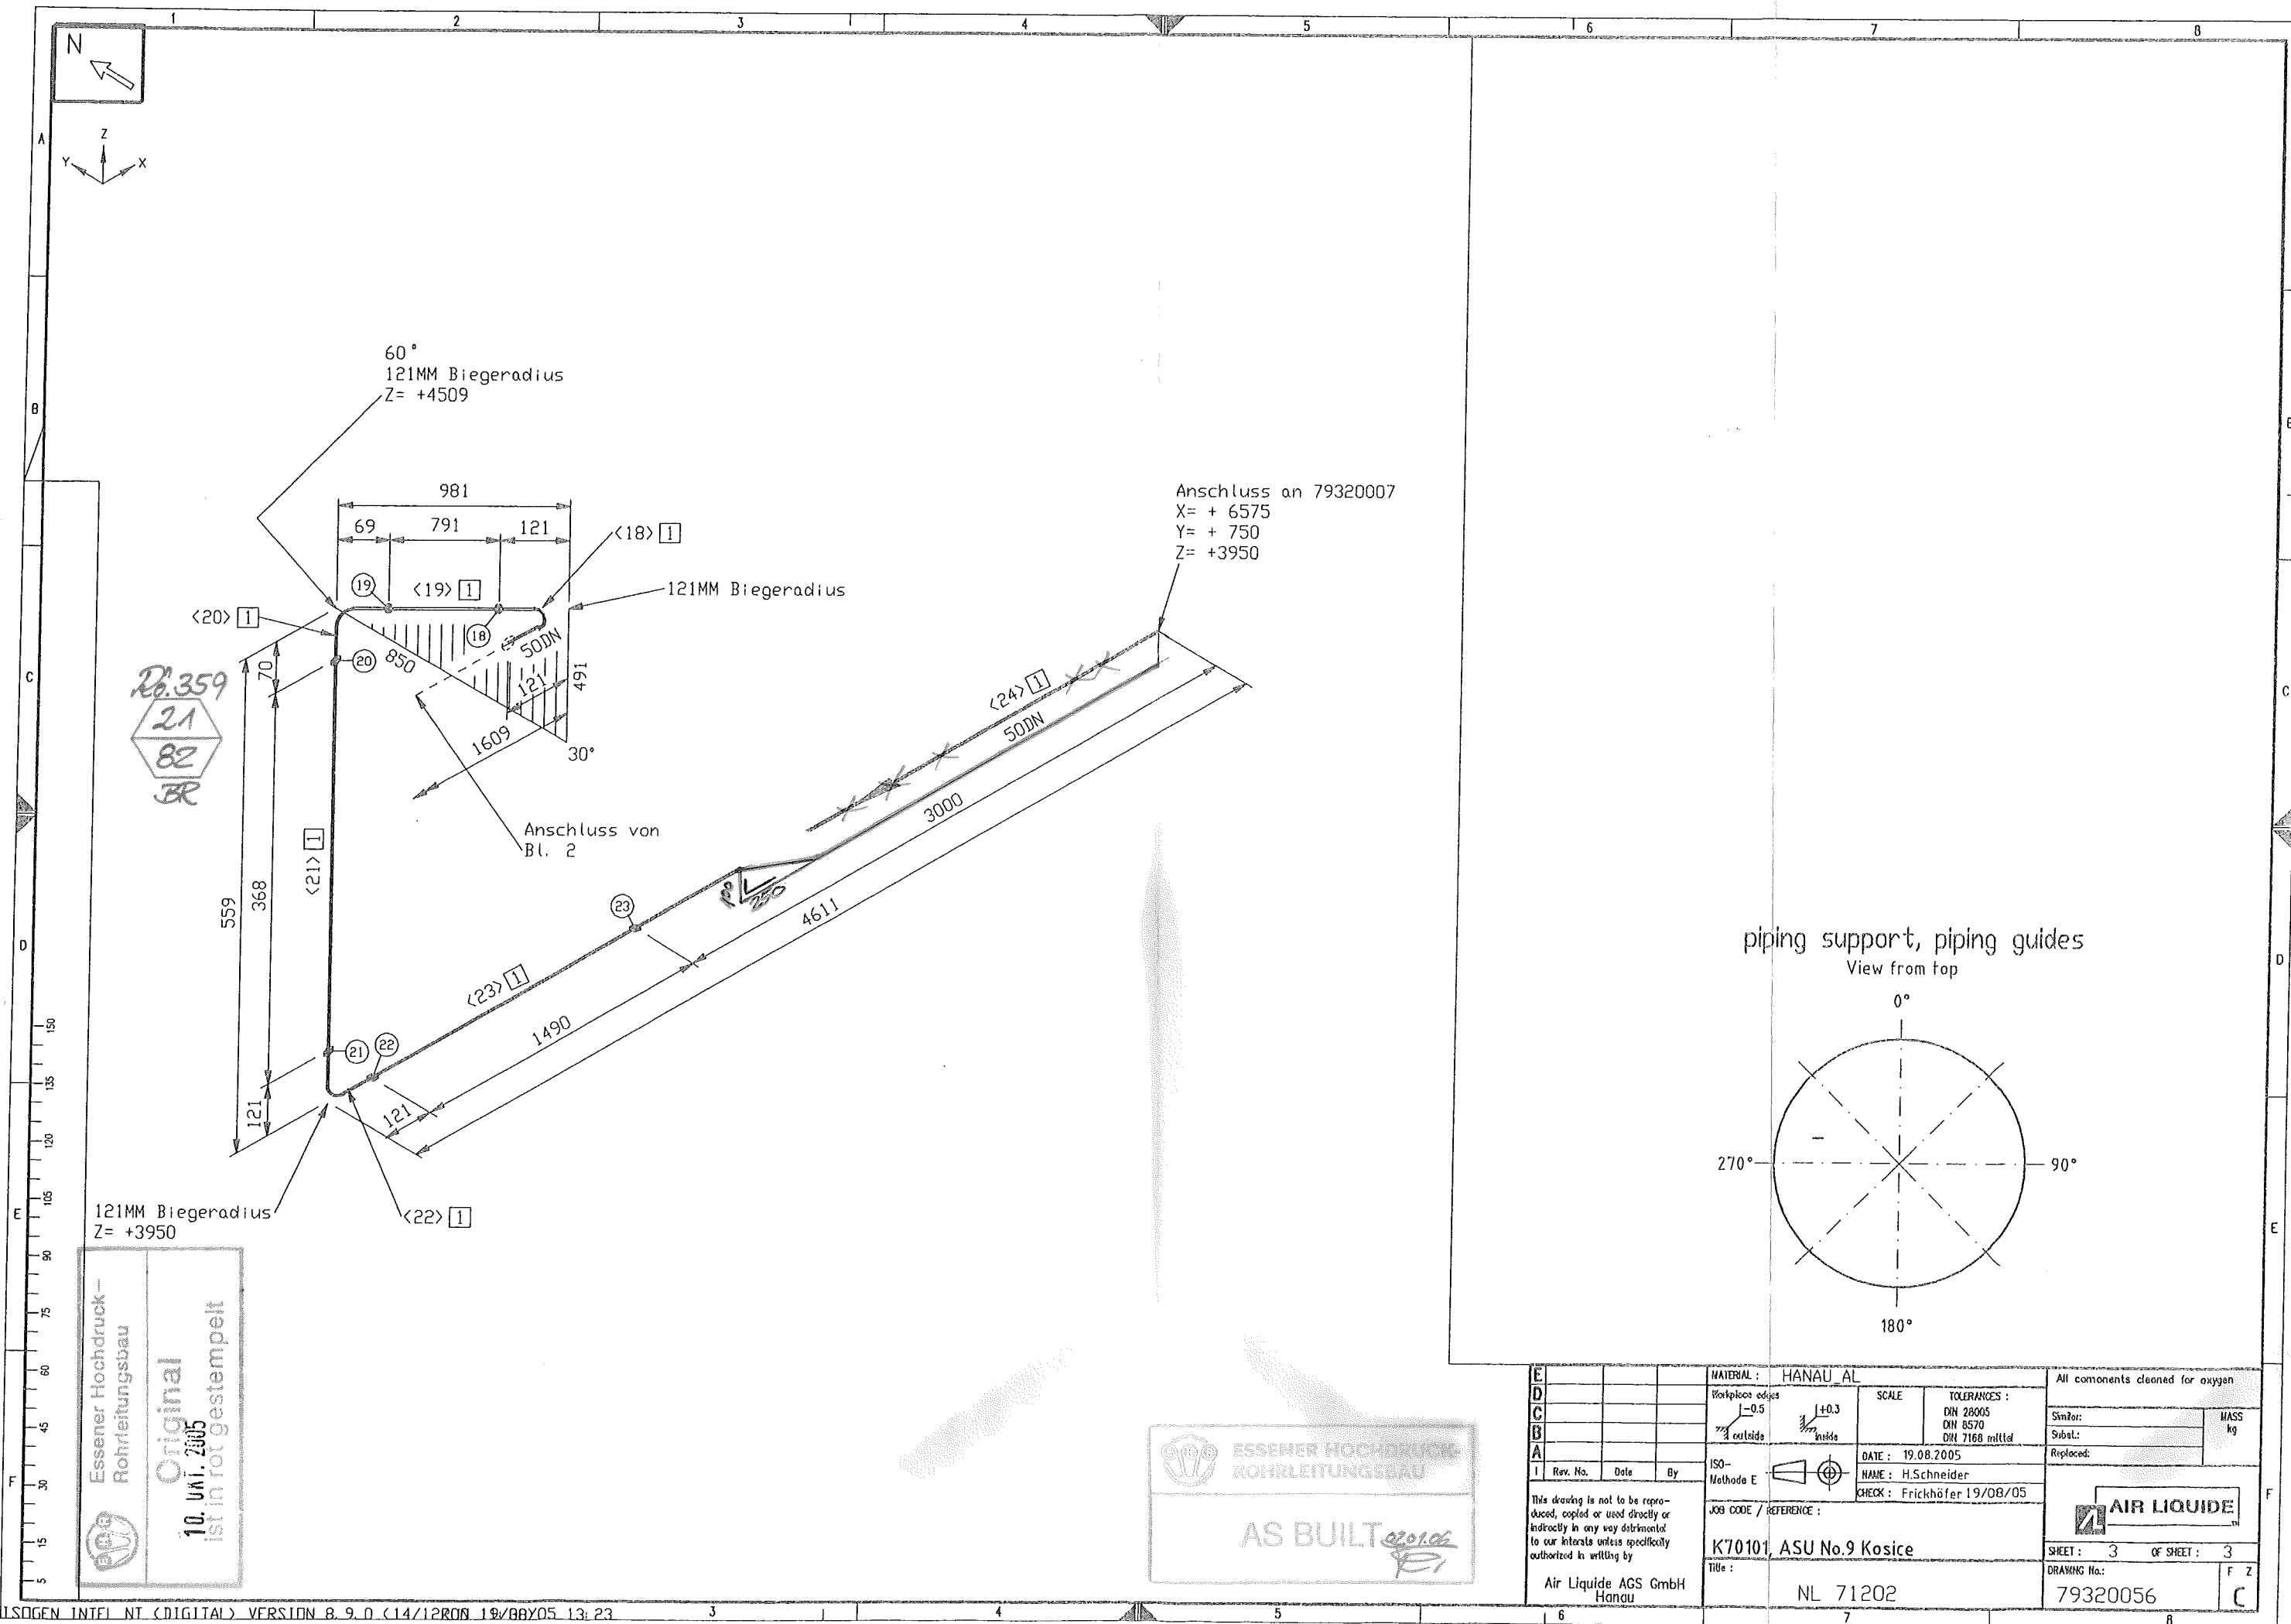

E			MATERIAL: HANAU AL			All components cleaned for oxygen		
D			Workpiece edges			SCALE		
C			-0.5			TOLERANCES:		
B			outside			DIN 28005		
A			inside			DIN 8570		
I			ISO-			DATE: 19.08.2005		
Rev. No.			Methode E			NAME: H.Schneider		
Date			DATE: 19.08.2005			CHECK: Frickhöfer 19/08/05		
By			JOB CODE / REFERENCE:			SHEET: 3 OF SHEET: 3		
This drawing is not to be reproduced, copied or used directly or indirectly in any way detrimental to our interests unless specifically authorized in writing by			K70101, ASU No.9 Kosice			DRAWING No:		
Air Liquide AGS GmbH Hanau			Title:			79320056		
			NL 71202			F Z C		