

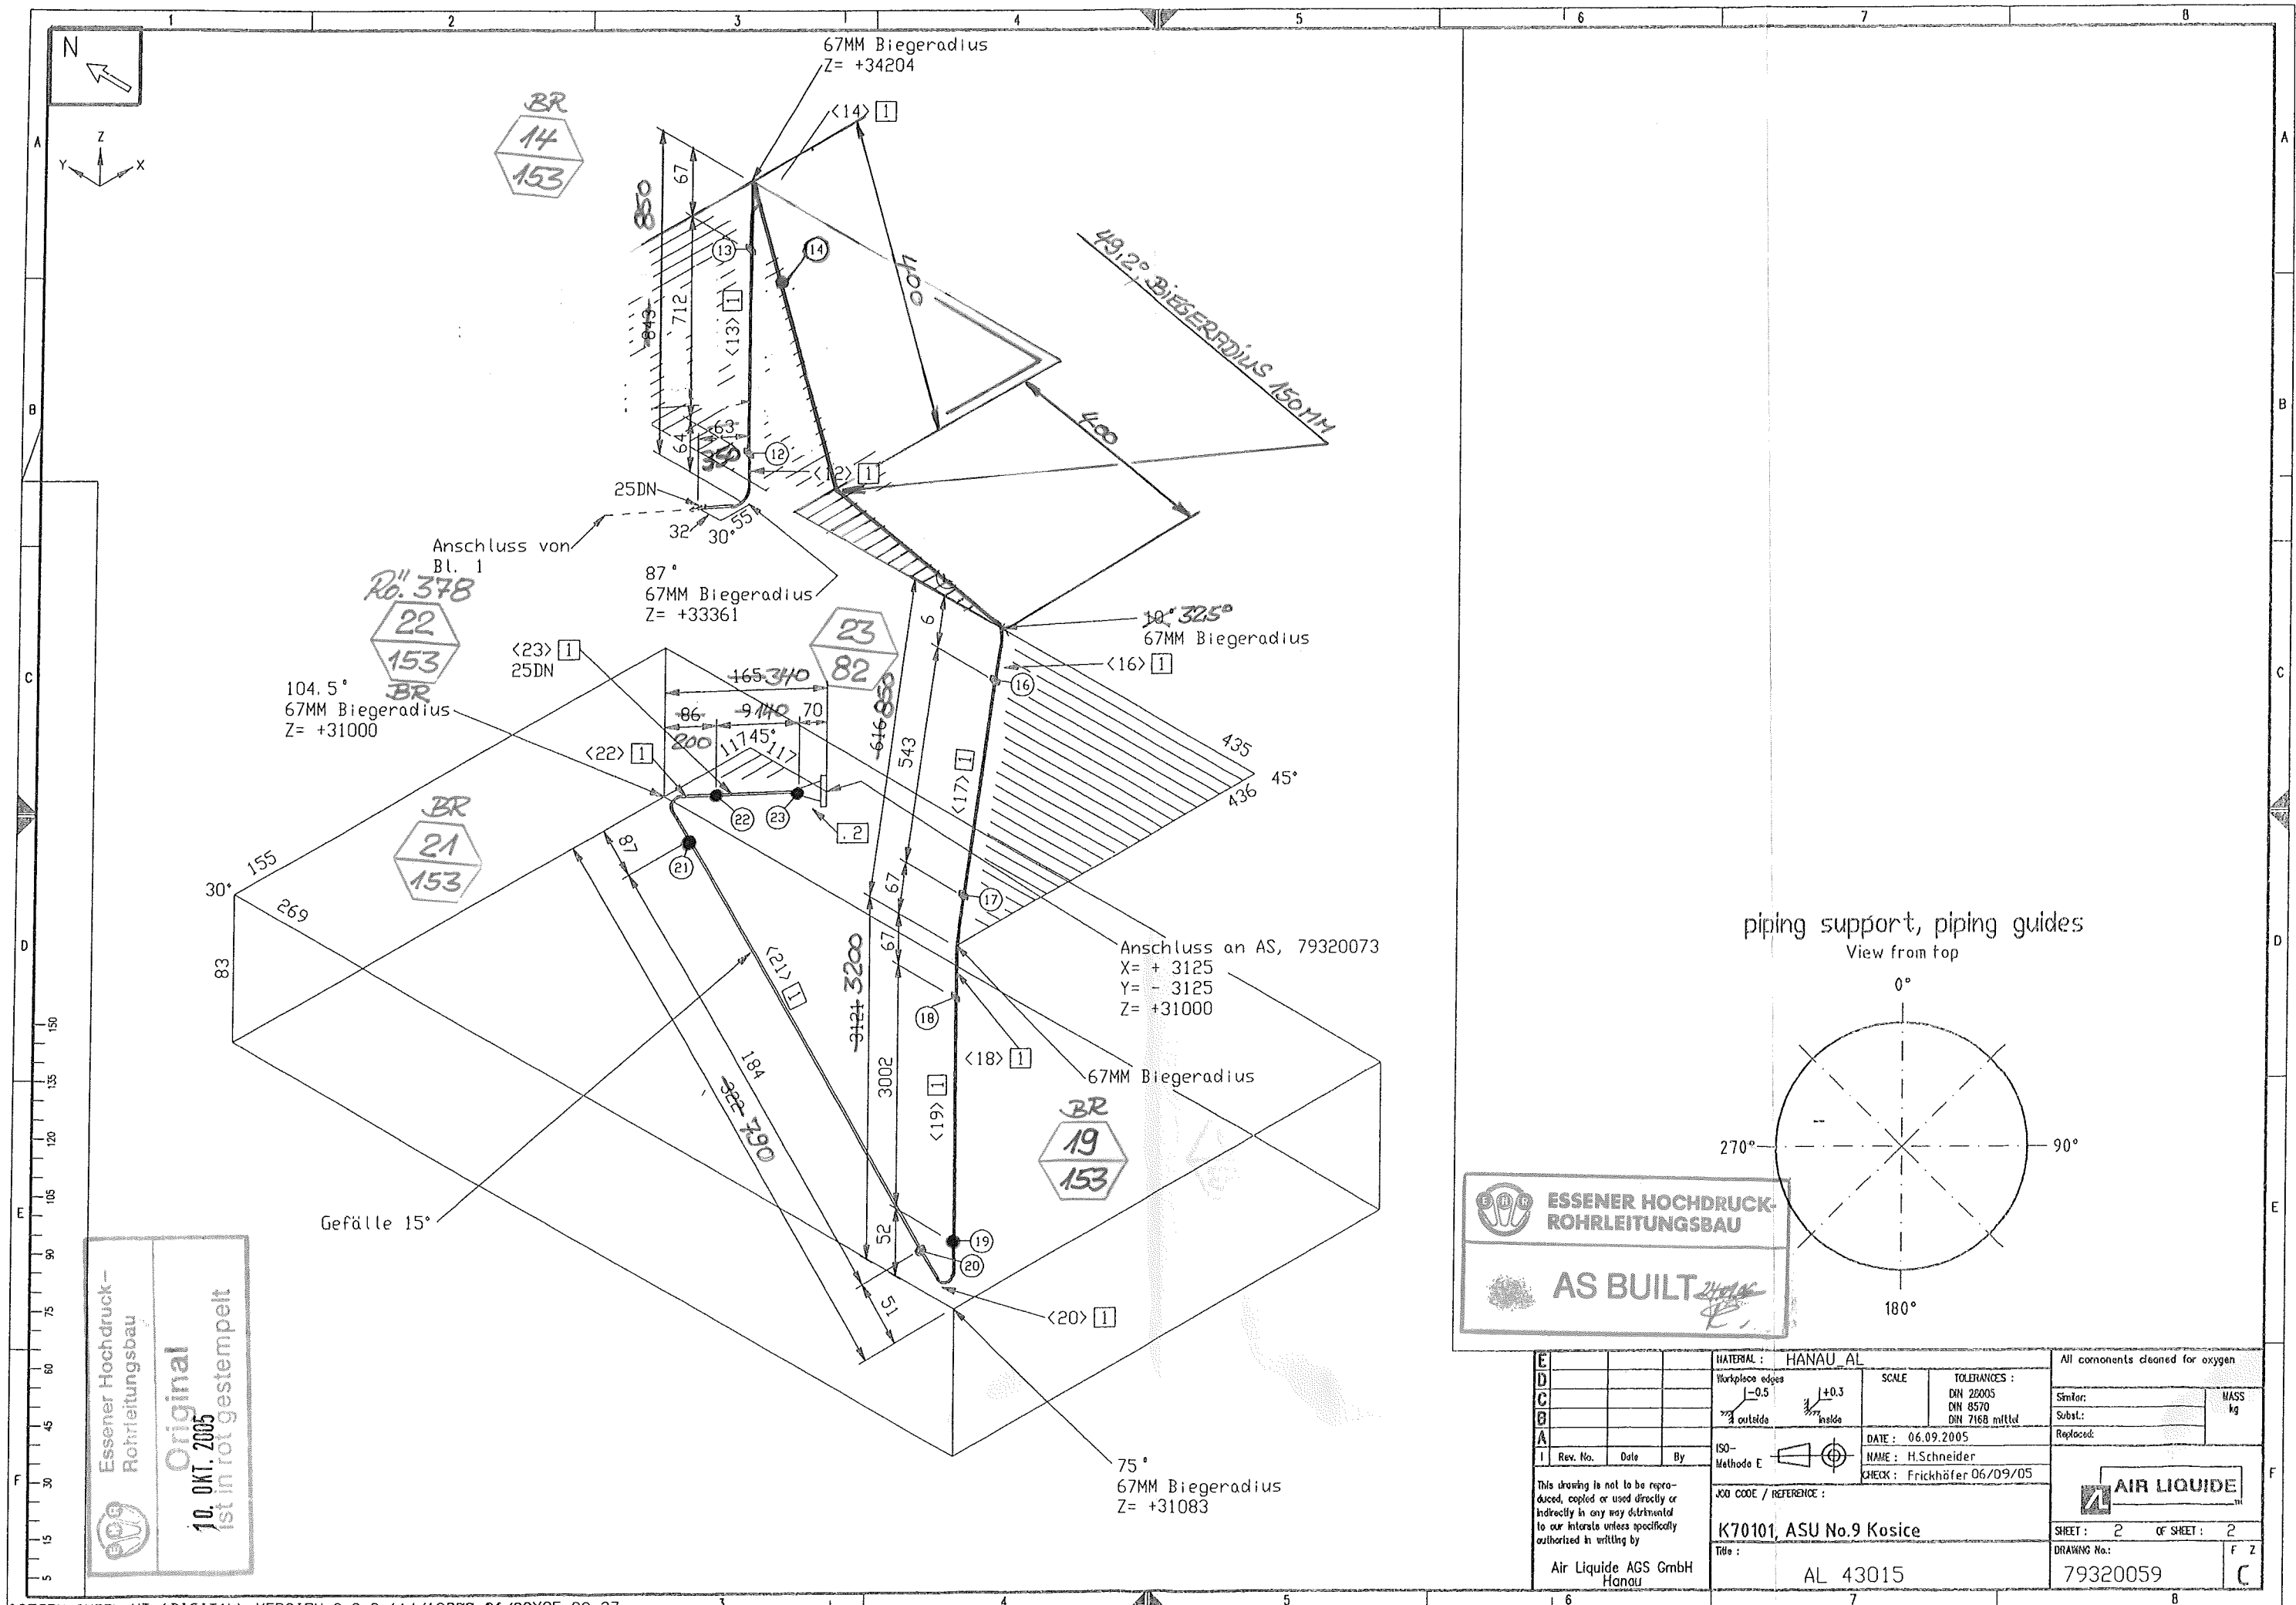


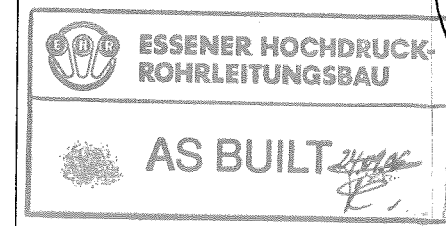

piping support, piping guides
View from top

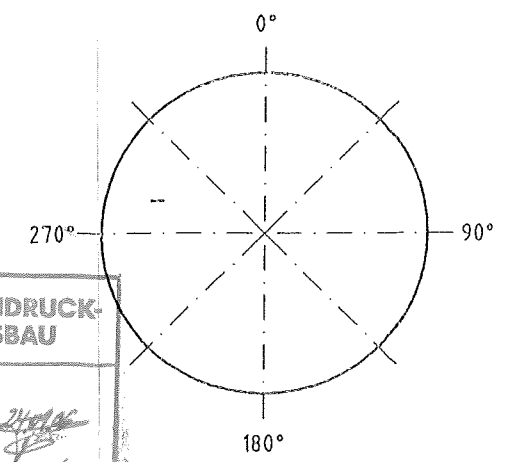

E			HANAU AL			All components cleaned for oxygen		
D			Workpiece edges			Similar:		
C			-0.5			Subst.:		
B			outside			Replaced:		
A			inside			AIR LIQUIDE		
I			ISO-Method E			SHEET: 2 OF SHEET: 2		
Rev. No.			Date			DRAWING No.:		
1			06.09.2005			79320059		
This drawing is not to be reproduced, copied or used directly or indirectly in any way detrimental to our interests unless specifically authorized in writing by			NAME: H. Schneider			F Z		
Air Liquide AGS GmbH Hanau			CHECK: Frickhöfer 06/09/05			C		
JCO CODE / REFERENCE:			K70101, ASU No.9 Kosice					
Title:			AL 43015					