


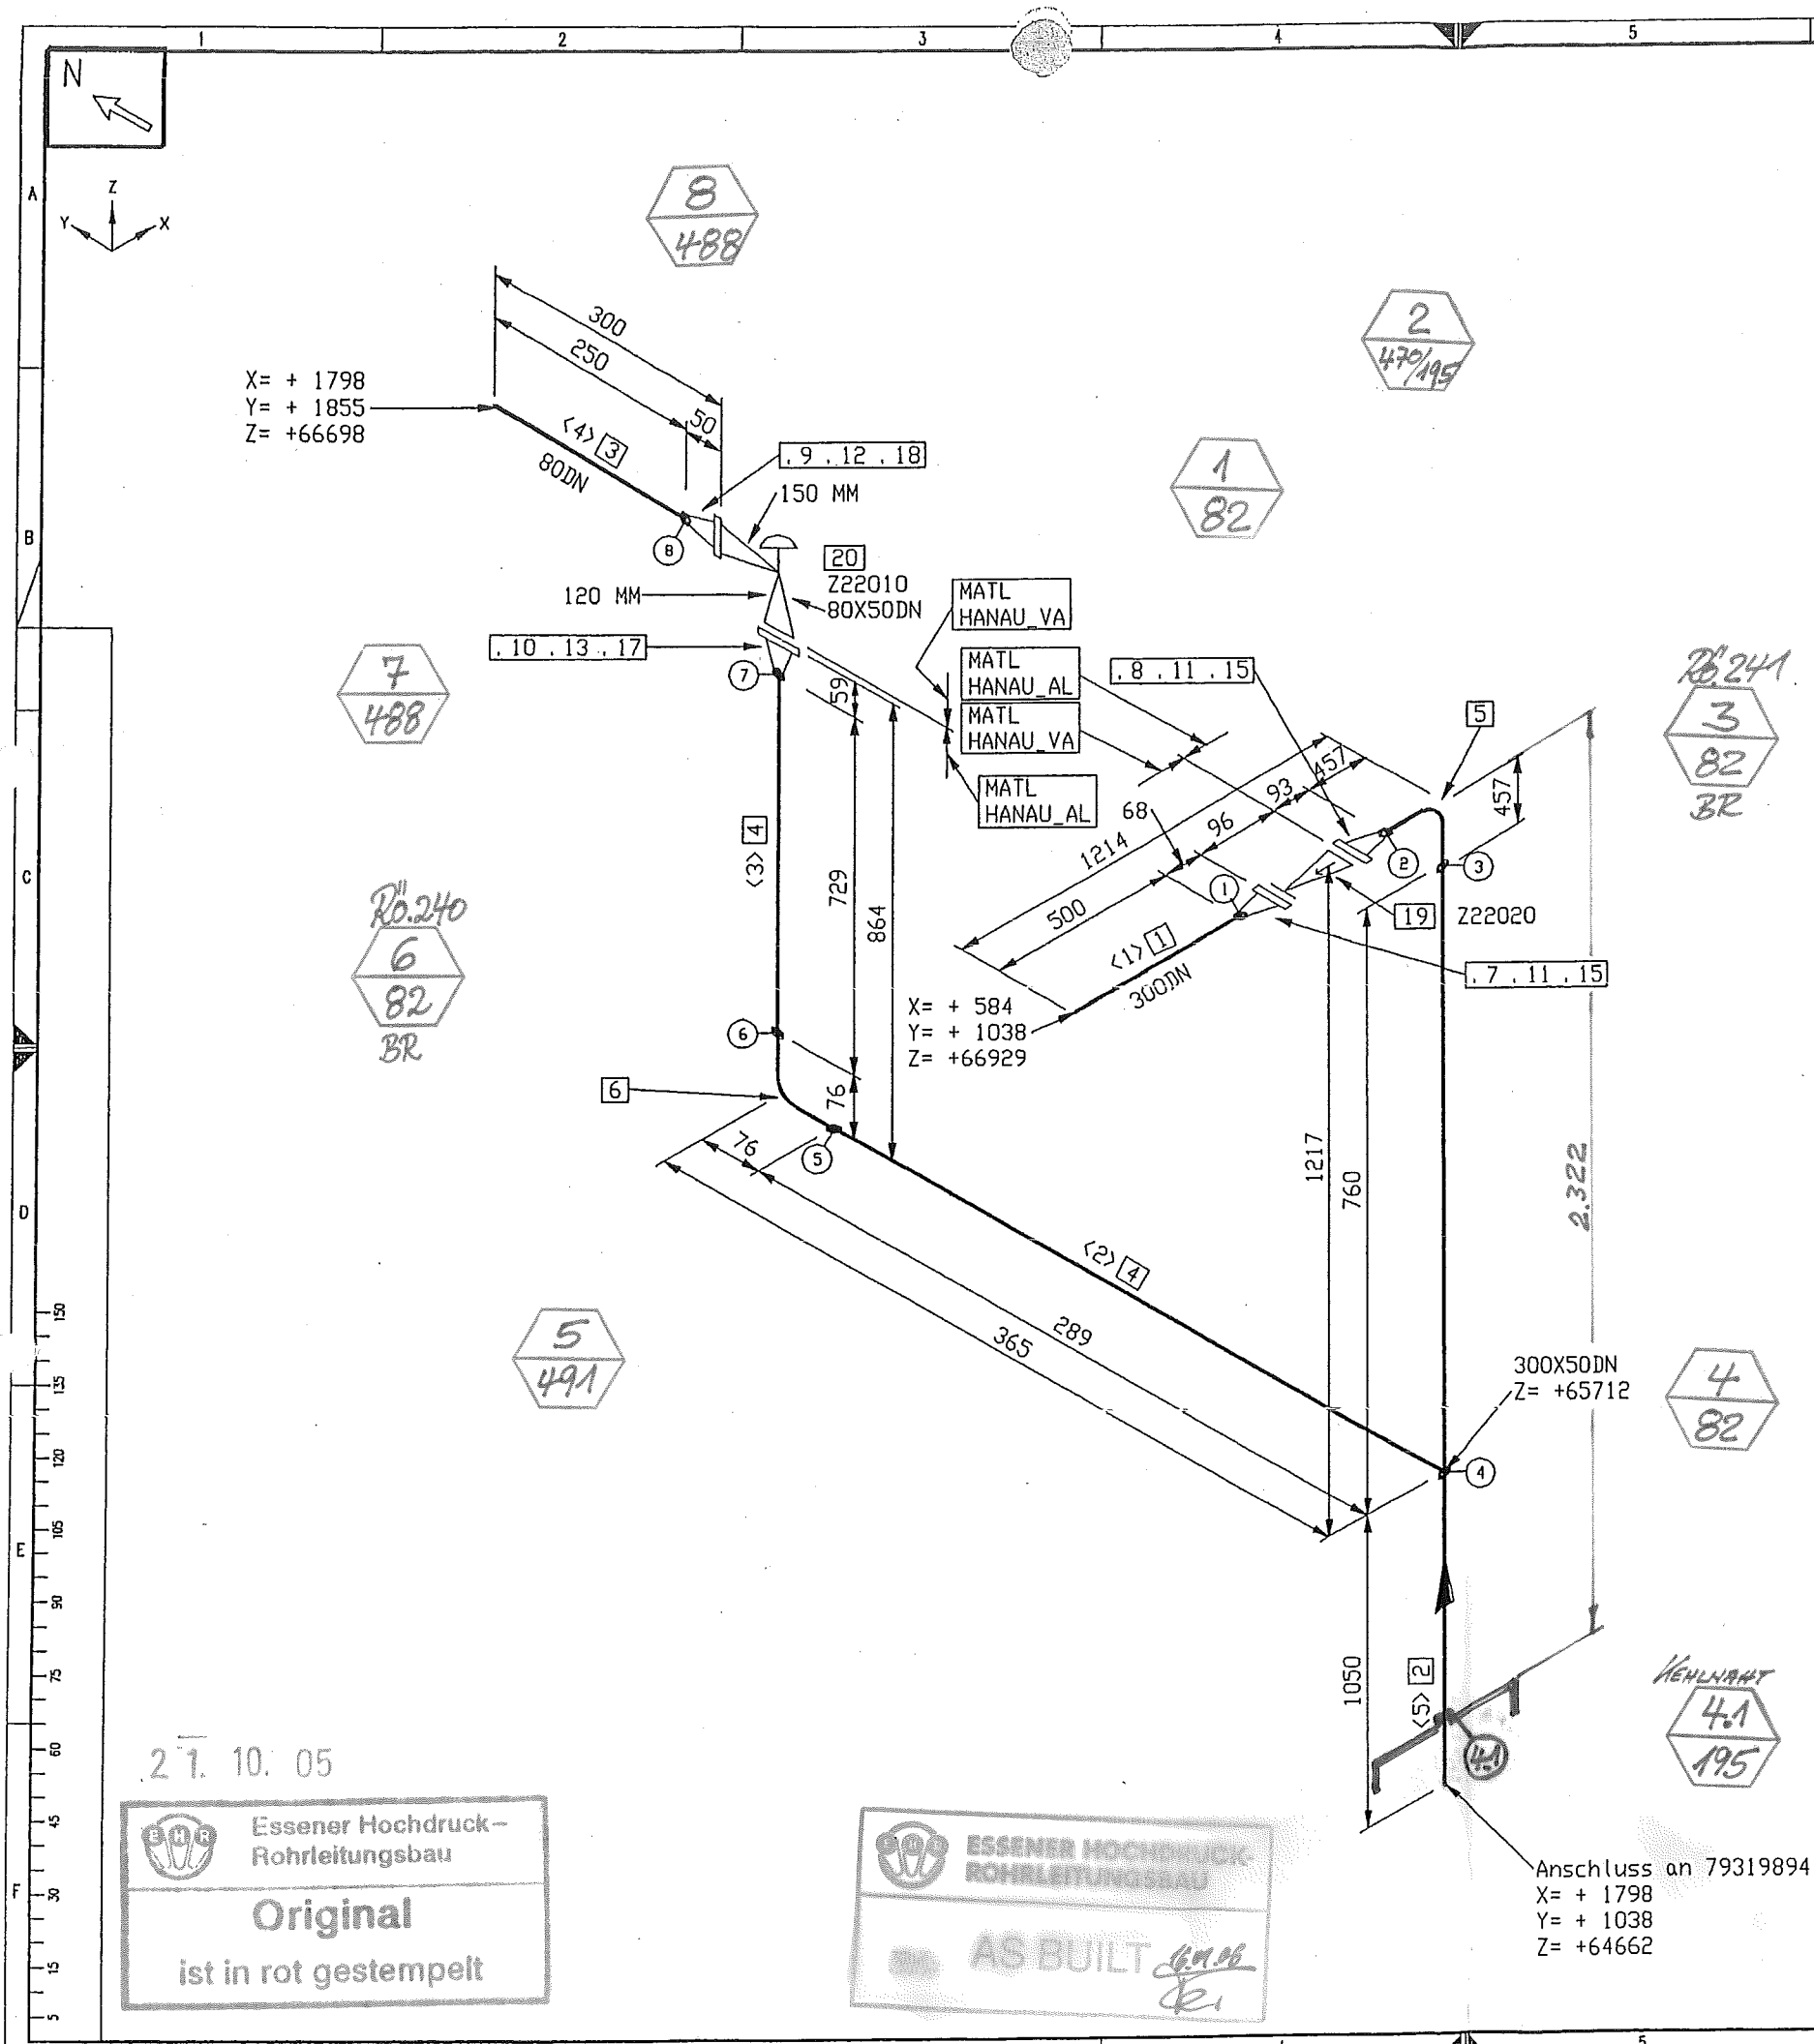

| Stückliste        |                                            |         |            |         |              |
|-------------------|--------------------------------------------|---------|------------|---------|--------------|
| Lfd Nr.           | Benennung                                  | DN (MM) | Sachnummer | Menge   | Gewicht (kg) |
| Rohr              |                                            |         |            |         |              |
| 1                 | ROHR 324,0 x 3,2 1.4541                    | 300     | 77039008   | 500 MM  | 12.5         |
| 2                 | ROHR 324,0 x 5 ALMG4,5MN W27               | 300     | 77038153   | 1810 MM | 24.5         |
| 3                 | ROHR 88,9 x 2,3 1.4541                     | 80      | 77038975   | 250 MM  | 1.2          |
| 4                 | ROHR 60,3 x 3,9 ALMG4,5MN W27              | 50      | 77038146   | 858 MM  | 1.6          |
| Fitting           |                                            |         |            |         |              |
| 5                 | BOGEN 324 x4,6 DIN2605-2-90-3 ALMG4,5MN    | 300     | 77038161   | 1       | 9.0          |
| 6                 | BOGEN 60,3x3,9 DIN2605-2-90-3 ALMG4,5MN    | 50      | 77038155   | 1       | 0.2          |
| Flansch           |                                            |         |            |         |              |
| 7                 | FLANSCH EN1092-1/11 B1/DN300/PN10/1.4541   | 300     | 77039934   | 1       | 17.6         |
| 8                 | VORSCHWEISSFLANSCH C 300 ND10 DIN 2632     | 300     | 77039932   | 1       | 9.7          |
| 9                 | gez. auf 79314715                          |         |            |         |              |
| 9                 | FLANSCH C80 x 88,9 DIN2633 1.4541          | 80      | 0364111    | 1       | 3.7          |
| 10                | VORSCHWEISSFLANSCH C 50 ND40               | 50      | 77039645   | 1       | 1.7          |
|                   | gez. auf 79314718                          |         |            |         |              |
| Dichtung          |                                            |         |            |         |              |
| 11                | DICHTUNG DN300 PN10 DIN 2690               | 300     | 77039936   | 2       | 0.3          |
| 12                | DICHTUNG DN80 PN16/40 DIN 2690             | 80      | 0320039    | 1       | 0.1          |
| 13                | DICHTUNG DN 50 PN63 DIN 2691               | 50      | 77039144   | 1       | 0.0          |
| Schraube / Mutter |                                            |         |            |         |              |
| 14                | SECHSKANTMUTTER ISO 4032 M20 A4-70         | 20      | 77038529   | 24      | 1.8          |
| 15                | SKT.-SCHRAUBE ISO 4014 M20 x 180 A2-70     | 20      | 77039778   | 24      | 12.0         |
| 16                | SECHSKANTMUTTER ISO 4032 M16 A4-70         | 16      | 0281227    | 12      | 0.4          |
| 17                | SKT.-SCHRAUBE ISO 4014 M16 x 75 A2-70      | 16      | 0221332    | 4       | 0.6          |
| 18                | SECHSKANTSCHRAUBE ISO 4014 M 16 x 75 A2-70 | 16      | 0221332_1  | 8       | 1.1          |
| Ventil            |                                            |         |            |         |              |
| 19                | Berstscheibe DN300 PN10                    | 300     | 77039935   | 1       | 27.1         |
| 20                | SICHERHEITSVENTIL DN 50/80 1,5bar          | 80X50   | 77039937   | 1       | 22.0         |
| Summe Masse       |                                            |         |            |         | 147.0        |

| Rohrzuschnitt |            |         |           |             |             |            |
|---------------|------------|---------|-----------|-------------|-------------|------------|
| Rohr Stk.     | Länge (MM) | DN (MM) | Bemerkung | Rohr Ende 1 | Rohr Ende 2 | Sachnummer |
| <1>           | 500        | 300     |           |             |             | 0          |
| <2>           | 129        | 50      |           |             |             | 77038146   |
| <3>           | 729        | 50      |           |             |             | 77038146   |
| <4>           | 250        | 80      |           |             |             | 770.38975  |
| <5>           | 1810       | 300     |           |             |             | 77038997   |

View from top