
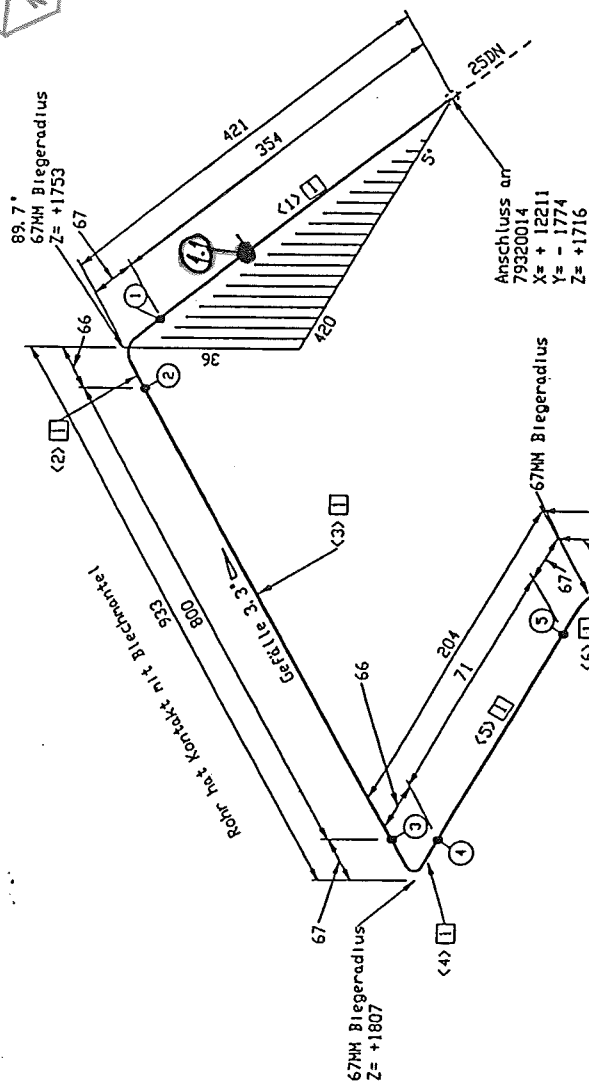


Rohrhalterungen und Rohrführungen
Ansicht von oben

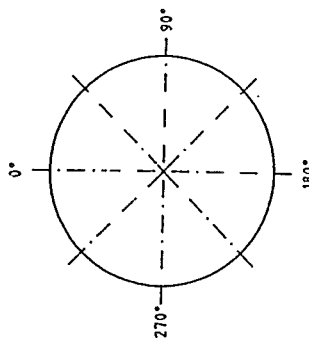

LFZ Nr.	Probe	Benennung	DN (NH)	Sachnummer	Menge	Gewicht (kg)
1	ROHR	33,4 X 3,4 ALMG4, SIN 027	25	7700144	1804 MM	1,7
<u>FLEISCH</u>						
2	AUSSCHEIDELDURCHFÜHRUNG	DN 25	25	793.11315	1	2,0
					<u>Summe Masse</u>	<u>3,7</u>

Sehr Stk	Länge (mm)	DN (mm)	Bemerkung	Rohr Ende 1	Rohr Ende 2	Suchnummer
1	354	25				77038144
2	105	25	PLD EDKX (1)			77038144
3	105	25				77038144
4	800	25				77038144
5	104	25	PLD EDKX (1)			77038144
6	71	25				77038144
7	105	25	PLD EDKX (1)			77038144
8	128	25				77038144
9	104	25	PLD EDKX (1)			77038144
10	113	25				77038144
11	59	25				77038144

[illegible]