


**US STEEL KOSICE / SLOVAKIA**  
**50.3023.01**

**Protection and Control System 110 kV – S/S T01/T02**

**Protection and Digital Control Schemes**

**025.011551-4005 (4) 02**  
**50.3023.01.000.701.XXX**

**DIGITAL CONTROL SYSTEM  
US STEEL KOSICE  
S/S T01**

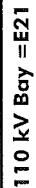

## Transformer Bay

## Binary / Analogue Signals / Control Commands

[illegible]

**DIGITAL CONTROL SYSTEM  
US STEEL KOSICE  
S/S T80**




### Binary / Analogue Signals / Control Commands according to Signal List

[illegible]

Scope of Supply

LINE DIFFERENTIAL PROTECTION SYSTEM  
US STEEL KOSICE  
S/S T01/T02/T80

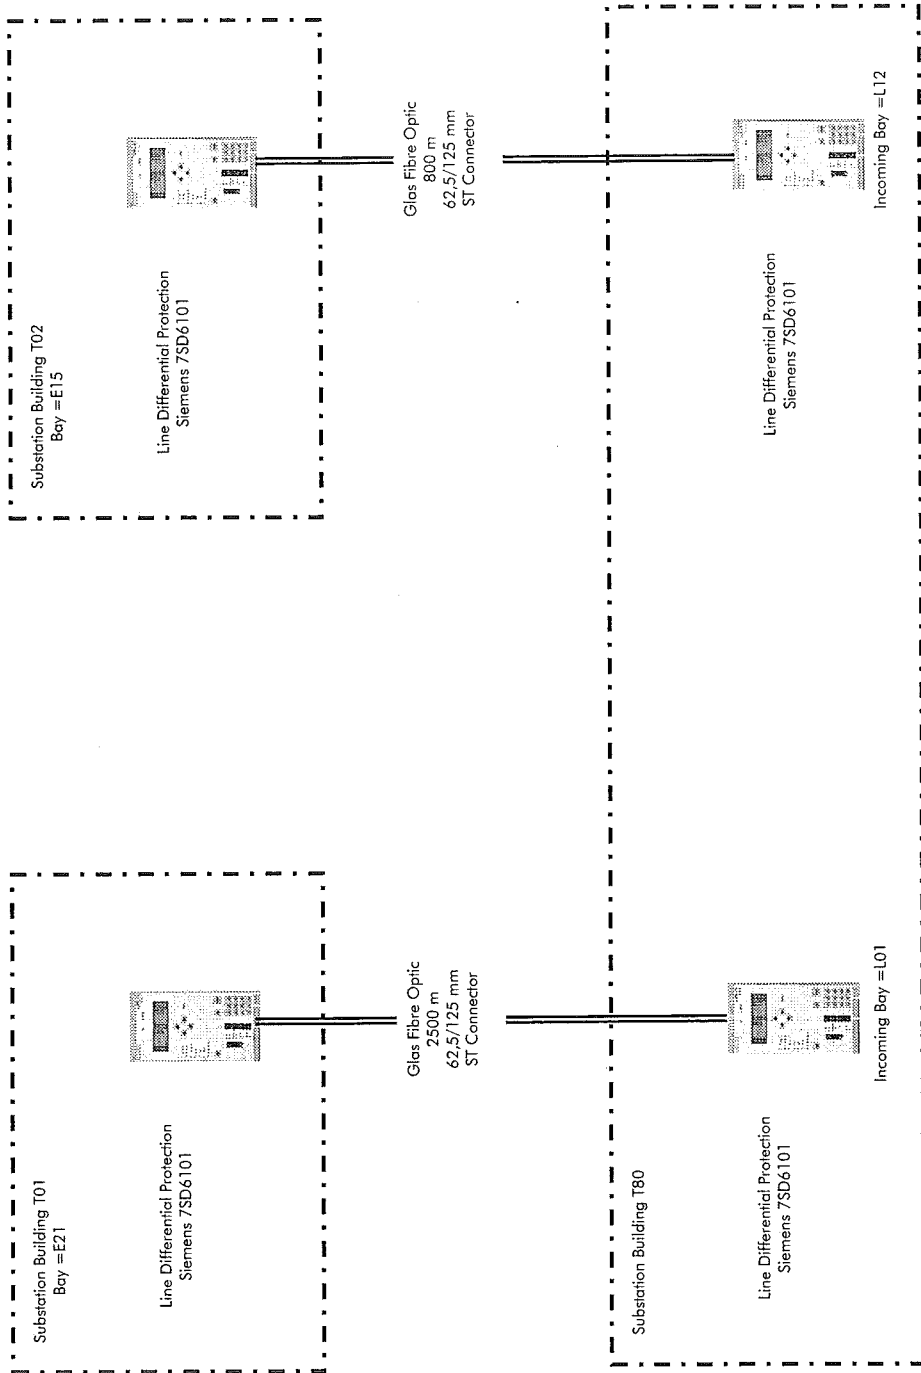


				21.04.2005		US STEEL KOSICE / SLOVAKIA 50.3023.01		A		DIGITAL CONTROL AND PROTECTION SCHEME		50.3023.01.000.701 .xxx			
02		AS BUILT		01.12.06		Kluge		Drawn						Sheet 4	
01		Modification		10.08.05		Kluge		Checked						12 Sh.	
State		Revision		Date		Name		Norm		Subj.:		Origin:		Δ 3 4 Δ 5 6 7 8	
		1						2							
												025.011551-4005 (4) 02			

# Scope of Supply

## PROTECTION SYSTEM OF TRANSFORMER BAY S/S T01 110 kV

110kV  
SUBSTATION T01  
=E21

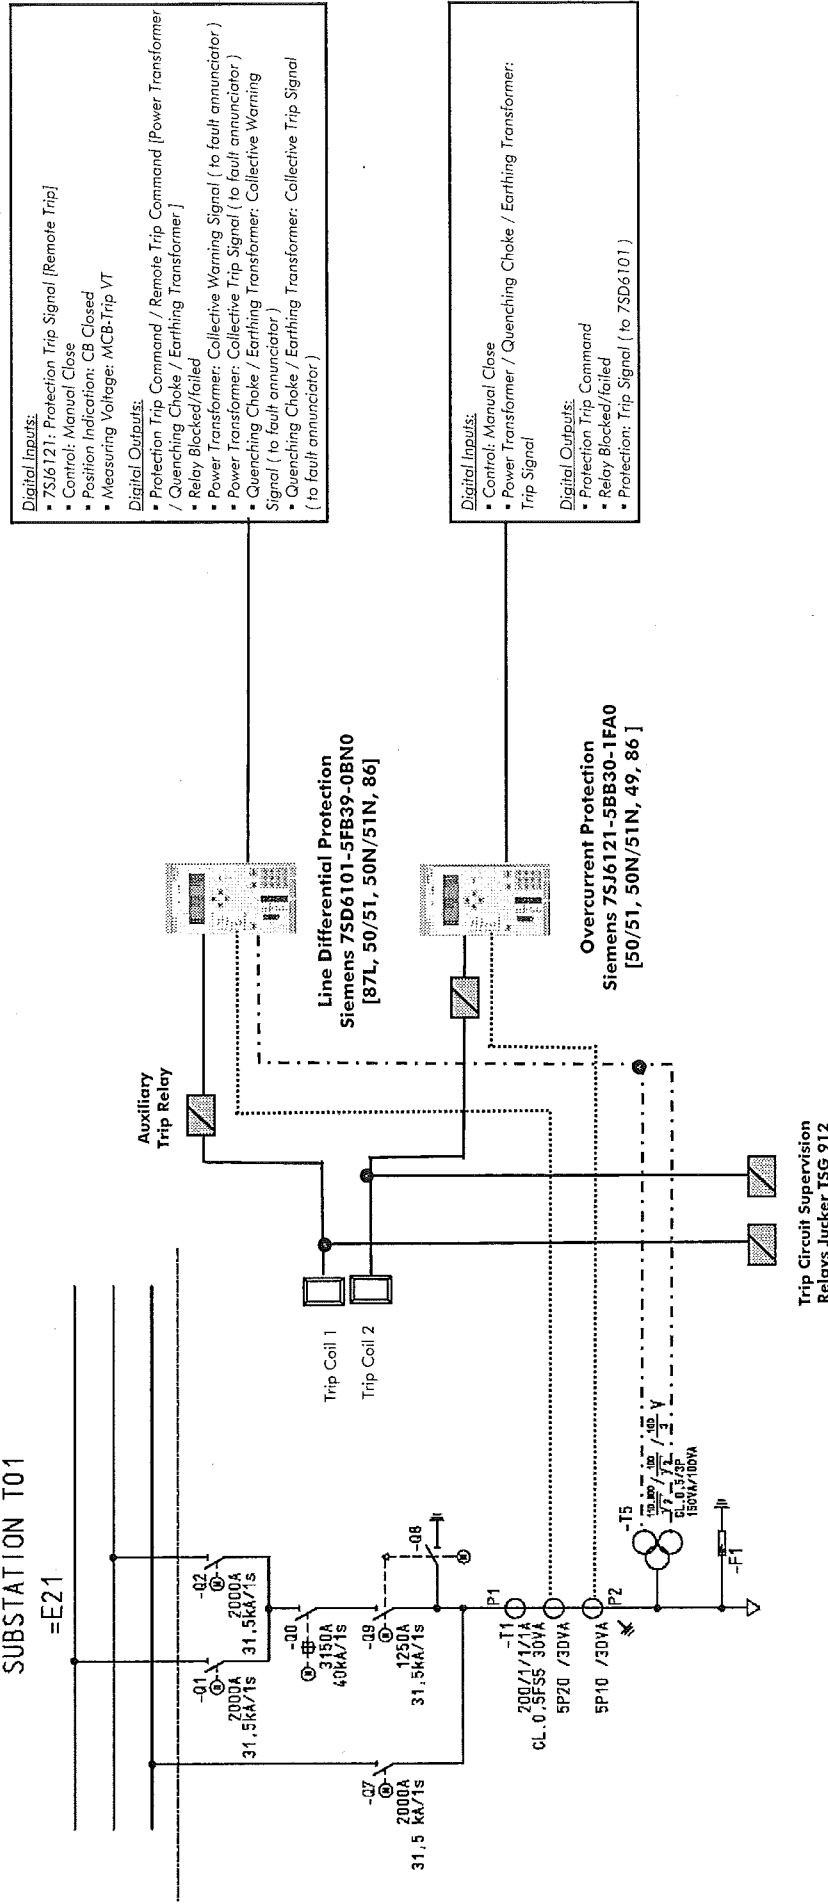


Please note: The trip commands initiated by the power transformer protection or earthing transformer / quenching choke will be transmitted from the 6,3 kV side to the 110 kV side via the communication link of protection relays Siemens 7SD6101 using the internal intertripping resp. Remote trip function.

US STEEL KOSICE / SLOVAKIA		DIGITAL CONTROL AND PROTECTION SCHEME		50.3023.01.000.701.xxx		025.011551-4005 (4) 02		Sheet 5		12 St.	
50.3023.01		AREVA		21.04.2005		Date		2		8	
AS BUILT		01.12.06		Kluge		Drawn		Kluge		1	
Modification		10.08.05		Kluge		Checked		Kluge		1	
Revision		Date		Name		Norm		Subf.		1	
State		Origin		Delta		3		4		5	

Scope of Supply

# CONTROL SYSTEM OF TRANSFORMER BAY S/S T01 110 kV

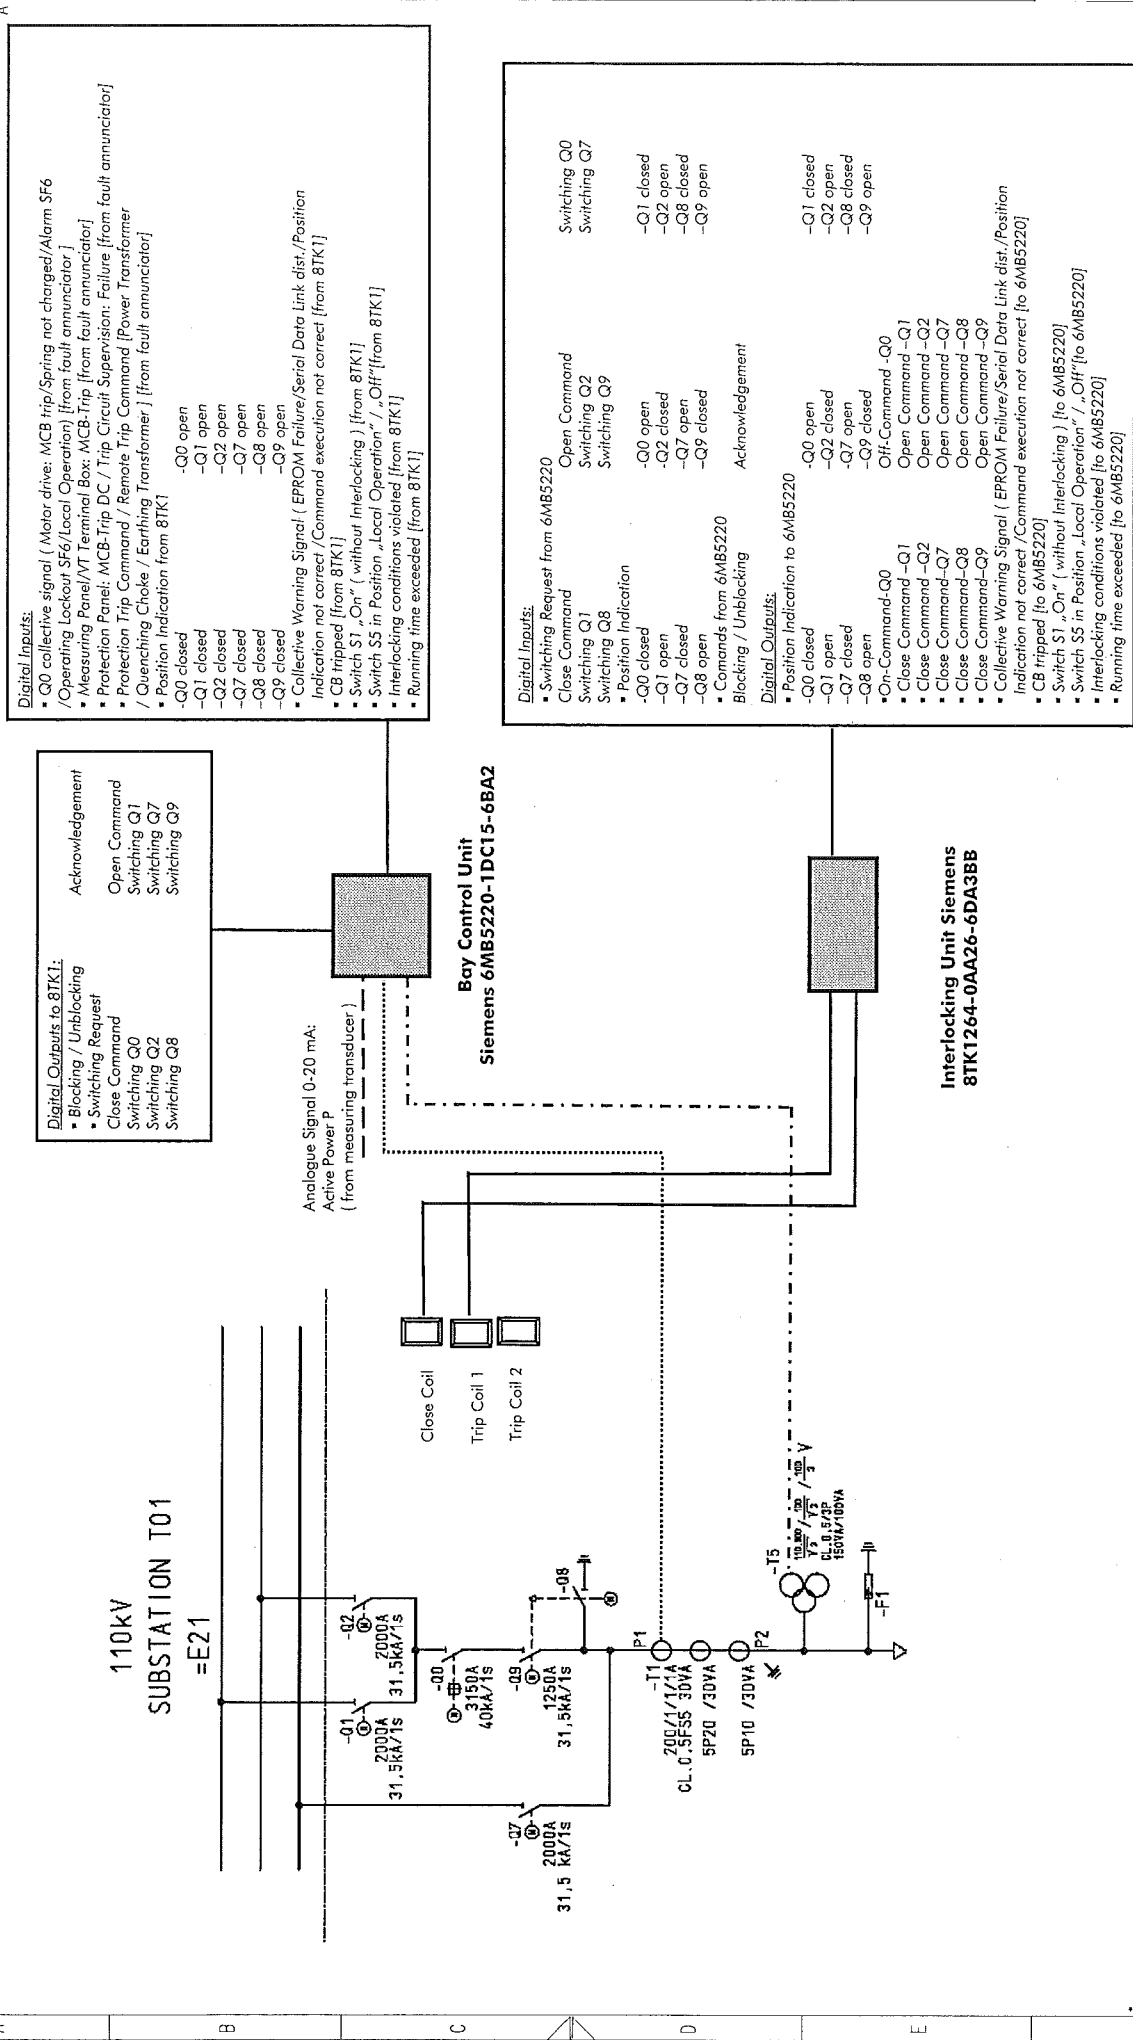

US STEEL KOSICE / SLOVAKIA		50.3023.01		50.3023.01.000.701.xxx		DIGITAL CONTROL AND PROTECTION SCHEME		025.011551-4005 (4) 02		Sheet 6	
Date		21.04.2005		Drawn		Kluge		12 Sh.			
AS BUILT		01.12.04		Kluge		Checked					
Modification		10.08.05		Kluge		Checked					
Revision				Name		Norm					
State				Origin		Sub.f.					

Scope of Supply

FAULT ANNUNCIATION SYSTEM OF TRANSFORMER BAY  
S/S T01 110 kV



Fault Annunciator  
2 x EES SSM 16-R

Digital Inputs:

- Q0: Operating Lockout SF6
- Q0: Spring not charged
- Q0: Alarm SF6
- Q0: Motor drive: MCB trip
- Q0: Local Operation
- Q1/Q2/Q7/Q9: Motor drive: MCB-Trip
- Q1/Q2/Q7/Q9: Local Operation
- Control Panel: MCB-Trip DC supply
- Voltage Transformer Terminal Box: Measuring Voltage MCB-Trip
- Voltage Transformer Terminal Box: MCB-Trip AC supply
- Metering panel: Measuring Voltage MCB-Trip, Metering/Measuring winding
- Metering panel: Measuring Voltage MCB-Trip, Metering winding
- Metering Panel: MCB-Trip AC supply
- Protection Panel: MCB-Trip AC supply
- Control Panel: MCB-Trip AC supply
- Protection Panel: MCB-Trip DC supply 1.11
- Protection Panel: MCB-Trip DC supply 1.21
- Protection Panel: MCB-Trip DC supply 1.31
- Protection Panel: MCB-Trip DC supply 1.12
- Protection Panel: MCB-Trip DC supply 1.32
- Protection Panel: Trip Circuit Supervision: Failure
- Power Transformer: Collective Trip Signal
- Power Transformer: Collective Warning Signal
- Quenching Choke / Earthing Transformer: Collective Warning Signal
- Quenching Choke / Earthing Transformer: Collective Trip Signal

Digital Outputs to 6MB5220

- Q0 collective signal (Motor drive: MCB trip/Spring not charged/Alarm SF6 /Operating Lockout SF6/Local Operation) [from fault annunciator]
- Measuring Panel/VT Terminal Box: MCB-Trip [from fault annunciator]
- Protection Panel: MCB-Trip DC / Trip Circuit Supervision: Failure [from fault annunciator]
- Protection Trip Command / Remote Trip Command [Power Transformer / Quenching Choke / Earthing Transformer] [from fault annunciator]

02		AS BUILT	01.12.06	Kluge	Drawn	21.04.2005	US STEEL KOSICE / SLOVAKIA		A		DIGITAL CONTROL AND PROTECTION SCHEME		50.3023.01.000.701.xxx		Sheet 7	
01		Modification	10.08.05	Kluge	Checked		50.3023.01		AREVA				025.011551-4005 (4) 02		12 Sh.	
State		Revision	Date	Name	Norm	2	Origin:		Sub.f:		4		5		6	
							3				4		5		6	
							2						7		8	

**PROTECTION SYSTEM OF TRANSFORMER BAY**  
**S/S T02      110 kV**

515



Trip Coil 1

### Trip Coil 2

**Trip Circuit Supervision  
Relays Jucker TSG 912**

Line Differential Protection  
Siemens 7SD6101-5FB09-0BN0  
[87L, 50/51, 50N/51N, 86]

**Overcurrent Protection**  
Siemens 7SJ6121-5BB30-1FA0  
[50/51, 50N/51N, 49, 86]

Digital Inputs:

- 736121: Protection Trip Signal [Remote Trip]
  - Control: Manual Close
  - Position Indication: CB Closed
  - Measuring Voltage: MCB-Trip VT
- Digital Outputs:**
- Protection Trip Command / Remote Trip Command [Power Transformer / Quenching Choke / Earthing Transformer]

Digital Outputs:

- Protection Trip Command / Remote Trip Command [Power Transformer / Quenching Choke / Earthing Transformer]
- Relay Blocked/tailed
- Power Transformer: Collective Warning Signal
- Power Transformer: Collective Trip Signal
- Quenching Choke / Earthing Transformer: Collective Warning Signal
- Quenching Choke / Earthing Transformer: Collective Trip Signal

Digital Insights:

- Control: Manual Close**  
**Power Transformer / Quenching Choke / Earthing Transformer:**  
**Trip Signal**

**Digital Outputs:**

- Protection Trip Command
- Relay Blocked/failed
- Protection: Trip Signal ( to 7SD6101 )

Test Switch 7XV72 for  
Line Diff. Prot. 7SD6101  
Overc. Prot. 7SJ6121


Please note: The trip commands initiated by the power transformer protection or earthing transformer / quenching cheke will be transmitted from the 6.3 kV side to the 110 kV side via the communication link of protection relays Siemens 7SD6101 using the internal intertripping resp. Remote trip function.

[illegible]



Scope of Supply

# METERING SYSTEM OF TRANSFORMER BAY S/S T01 110 kV

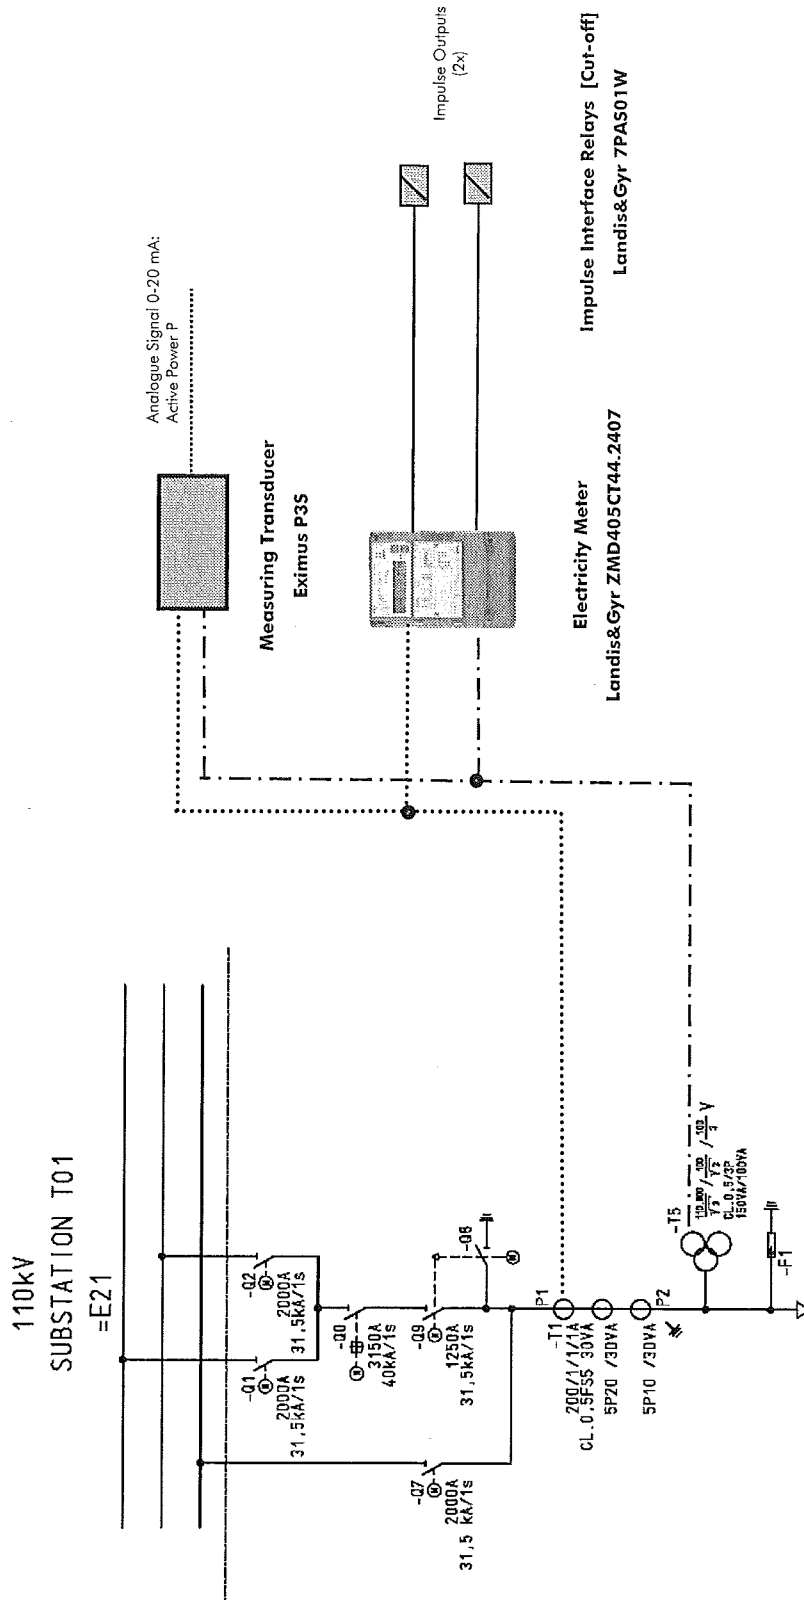

US STEEL KOSICE / SLOVAKIA  
50.3023.01

DIGITAL CONTROL AND  
PROTECTION SCHEME


AREVA

50.3023.01.000.701.xxx

02	AS BUILT	01.12.06	Kluge	Drawn	Kluge	21.04.2005	Date
01	Modification	10.08.09	Kluge	Checked			
State	Revision	Date	Name	Norm	Origin	Sub.f.	
1							
9	Sheet						
12	Sh.						


**METERING SYSTEM OF TRANSFORMER BAY**  
**S/S T02 110 kV**



02	AS BUILT	01.12.06	Kluge	Drawn	21.04.2005	US STEEL KOSICE / SLOVAKIA 50.3023.01	 AREVA	DIGITAL CONTROL AND PROTECTION SCHEME	50.3023.01.000.701.xxx	Sheet 10 12 Stl.
01	Modification	10.08.05	Kluge	Checked						
State	Revision	Date	Name	Norm	Origin	Subj.:			025.011551-4005 (4) 02	
	1			2	3	4	5	6	7	8

# Scope of Supply

## PROTECTION SYSTEM OF INCOMING BAYS =L01/=L12 S/S T80 6,3 kV

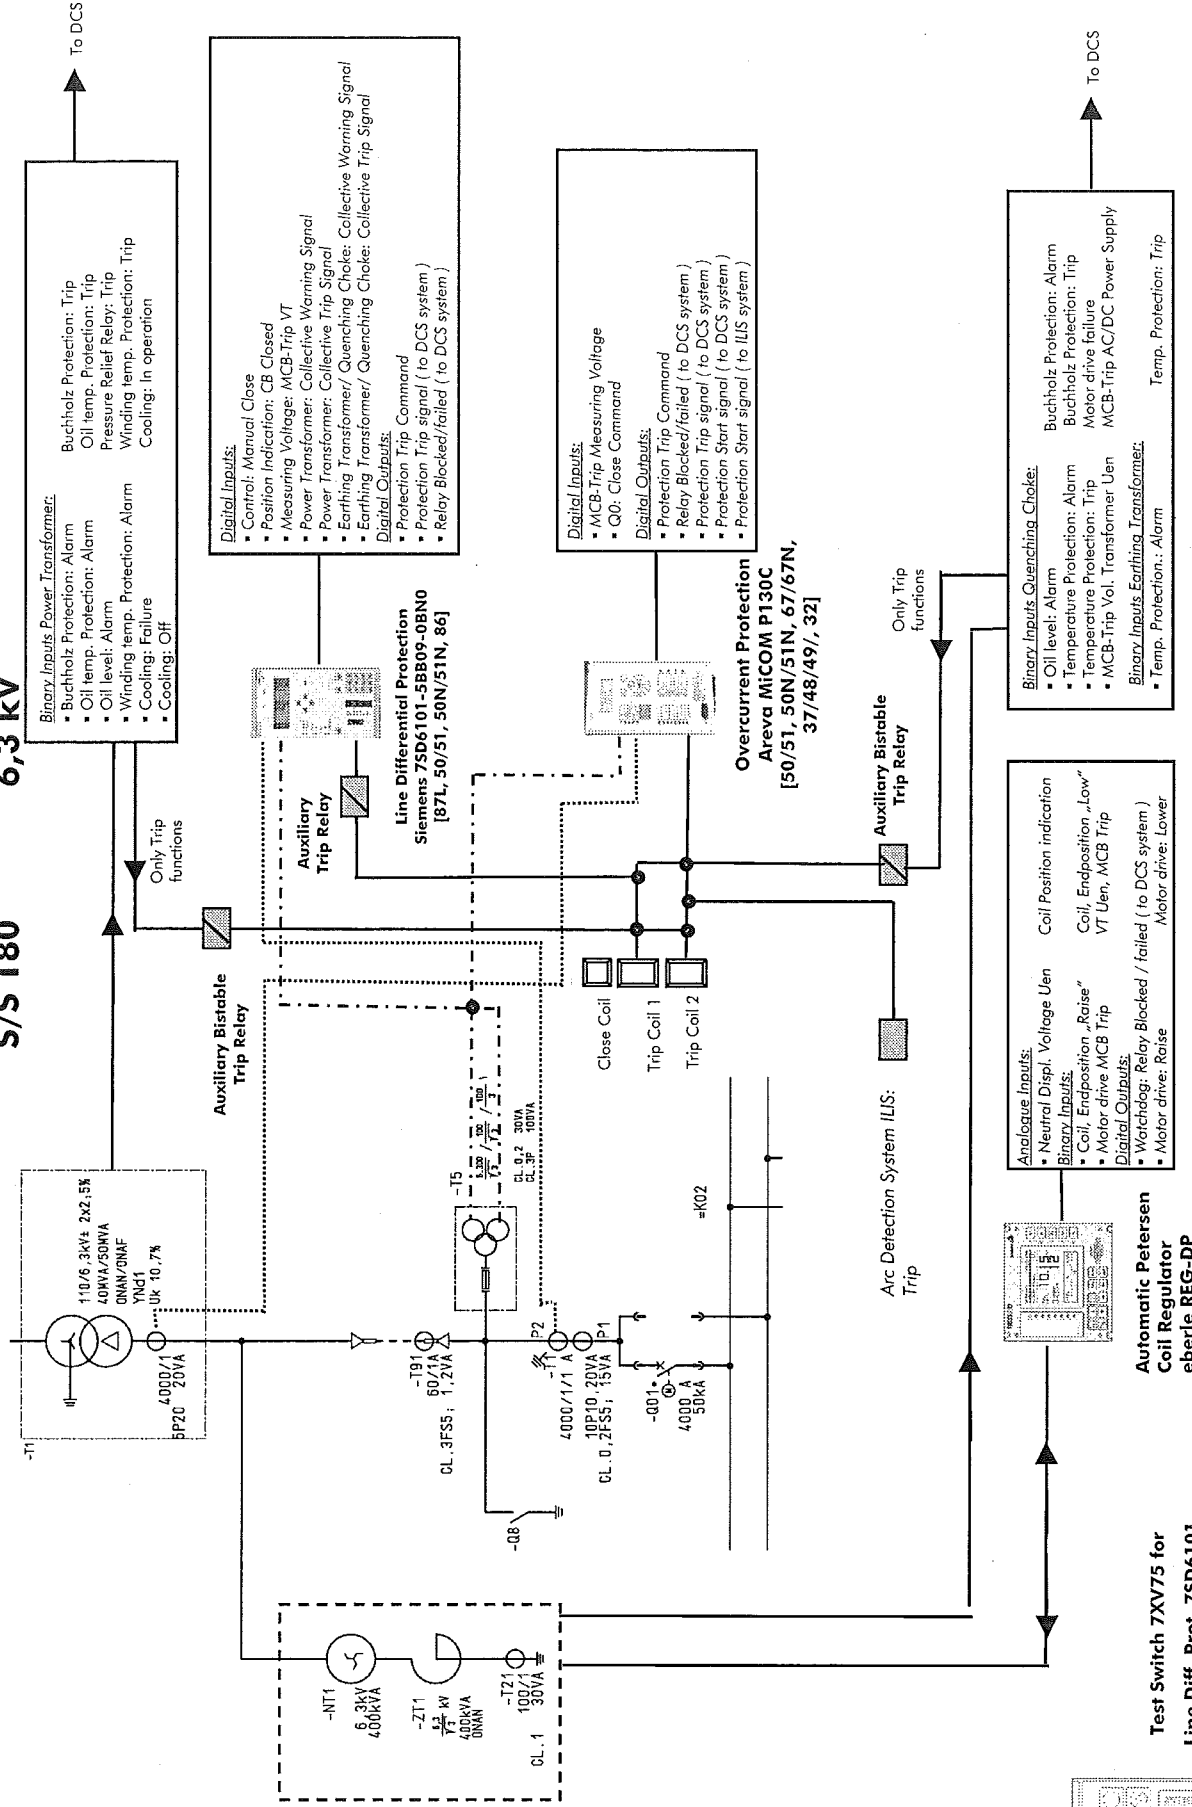

02	AS BUILT	01.12.04	Kluge	Drawn	Kluge	50.3023.01	US STEEL KOSICE / SLOVAKIA	AREVA	DIGITAL CONTROL AND PROTECTION SCHEME	50.3023.01.000.701.xxx	025.011551-4005 (4) 02	Sheet 11
01	Modification	10.08.05	Kluge	Checked								12 Sh.
State	Revision	Date	Name	Norm	Origin	Sub.f.						

# A AREVA