
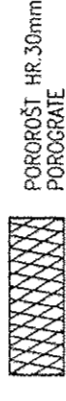


LEGENDA MIESTNOSTÍ/LEGENDE OF ROOM


Č. M. NO	NÁZOV MIESTNOSTI PURPOSE OF ROOMS	PLOCHA AREA m ²	POVRCHOVÁ ÚPRAVA SURFACE FINISH		STĚNY SURFACES	STROPY CEILINGS	POZNÁMKA NOTES
			PODLAŽNÉ FLOORS				
01	KOMPENZAČNÁ KOMPENSACTION	28,25m ²	UJATA PODLAHA - MASTER TOP 472 CAST FLOOR	UJATA CEM. OMIEŤKA VAP CEM. OMIEŤKA PLASTER CALCIC-CEM.PLASTER CALCIC-CEM.			
02	NÍZKOPOTLAČOVÁ ROZVODNICA LOW VOLTAGE ROOM	28,25m ²	UJATA PODLAHA - MASTER TOP 472 CAST FLOOR	UJATA CEM. OMIEŤKA VAP CEM. OMIEŤKA PLASTER CALCIC-CEM.PLASTER CALCIC-CEM.			
03	ELEKTROROZVODNÁ ELECTRICAL ROOM	88,16m ²	UJATA PODLAHA - MASTER TOP 472 CAST FLOOR	UJATA CEM. OMIEŤKA VAP CEM. OMIEŤKA PLASTER CALCIC-CEM.PLASTER CALCIC-CEM.			
04	BATERIA BATTERY ROOM	7,16m ²	KYSELINOVÝZDORNNÝ WATER-CORROFLAKE C				
05	REZERVA RESERVE	12,60m ²	UJATA PODLAHA - MASTER TOP 472 CAST FLOOR	UJATA CEM. OMIEŤKA VAP CEM. OMIEŤKA PLASTER CALCIC-CEM.PLASTER CALCIC-CEM.			
06	TRANSFORMÁTOROVÁ AUTO-TRANSFORMER	12,60m ²	UJATA PODLAHA - MASTER TOP 472 CAST FLOOR	UJATA CEM. OMIEŤKA VAP CEM. OMIEŤKA PLASTER CALCIC-CEM.PLASTER CALCIC-CEM.			
07	BEKOVÝ CURRENT-LIMITING REACTOR I	11,00m ²	UJATA PODLAHA - MASTER TOP 472 CAST FLOOR	UJATA CEM. OMIEŤKA VAP CEM. OMIEŤKA PLASTER CALCIC-CEM.PLASTER CALCIC-CEM.			
08	BEKOVÝ CURRENT-LIMITING REACTOR II	10,60m ²	UJATA PODLAHA - MASTER TOP 472 CAST FLOOR	UJATA CEM. OMIEŤKA VAP CEM. OMIEŤKA PLASTER CALCIC-CEM.PLASTER CALCIC-CEM.			
09	TRAFÓ I TRAFIO I	12,60m ²	UJATA PODLAHA - MASTER TOP 1110 CAST FLOOR	UJATA CEM. OMIEŤKA VAP CEM. OMIEŤKA PLASTER CALCIC-CEM.PLASTER CALCIC-CEM.			
10	ZHŤVACOVÁ QUENCHING CHOKER I	12,60m ²	UJATA PODLAHA - MASTER TOP 472 CAST FLOOR	UJATA CEM. OMIEŤKA VAP CEM. OMIEŤKA PLASTER CALCIC-CEM.PLASTER CALCIC-CEM.			
11	TRAFÓ II TRAFIO II	12,60m ²	UJATA PODLAHA - MASTER TOP 1110 CAST FLOOR	UJATA CEM. OMIEŤKA VAP CEM. OMIEŤKA PLASTER CALCIC-CEM.PLASTER CALCIC-CEM.			

(P) PRESTUPY POŽIARNE ÚZATVORIŤ POŽIARNOU HILTI MALTOU CP 636
POD MALTU PRIPEVNIT OCELOVÚ SIET'

LEGENDA HŨMŢ/LEGENDE SUBSTANCES

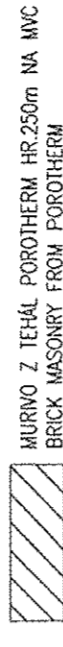

TECHNICKÁ INSPEKČIA SR
Pracovisko Košice
20.10.05 04520
CONTINENTAL - BELGIUM

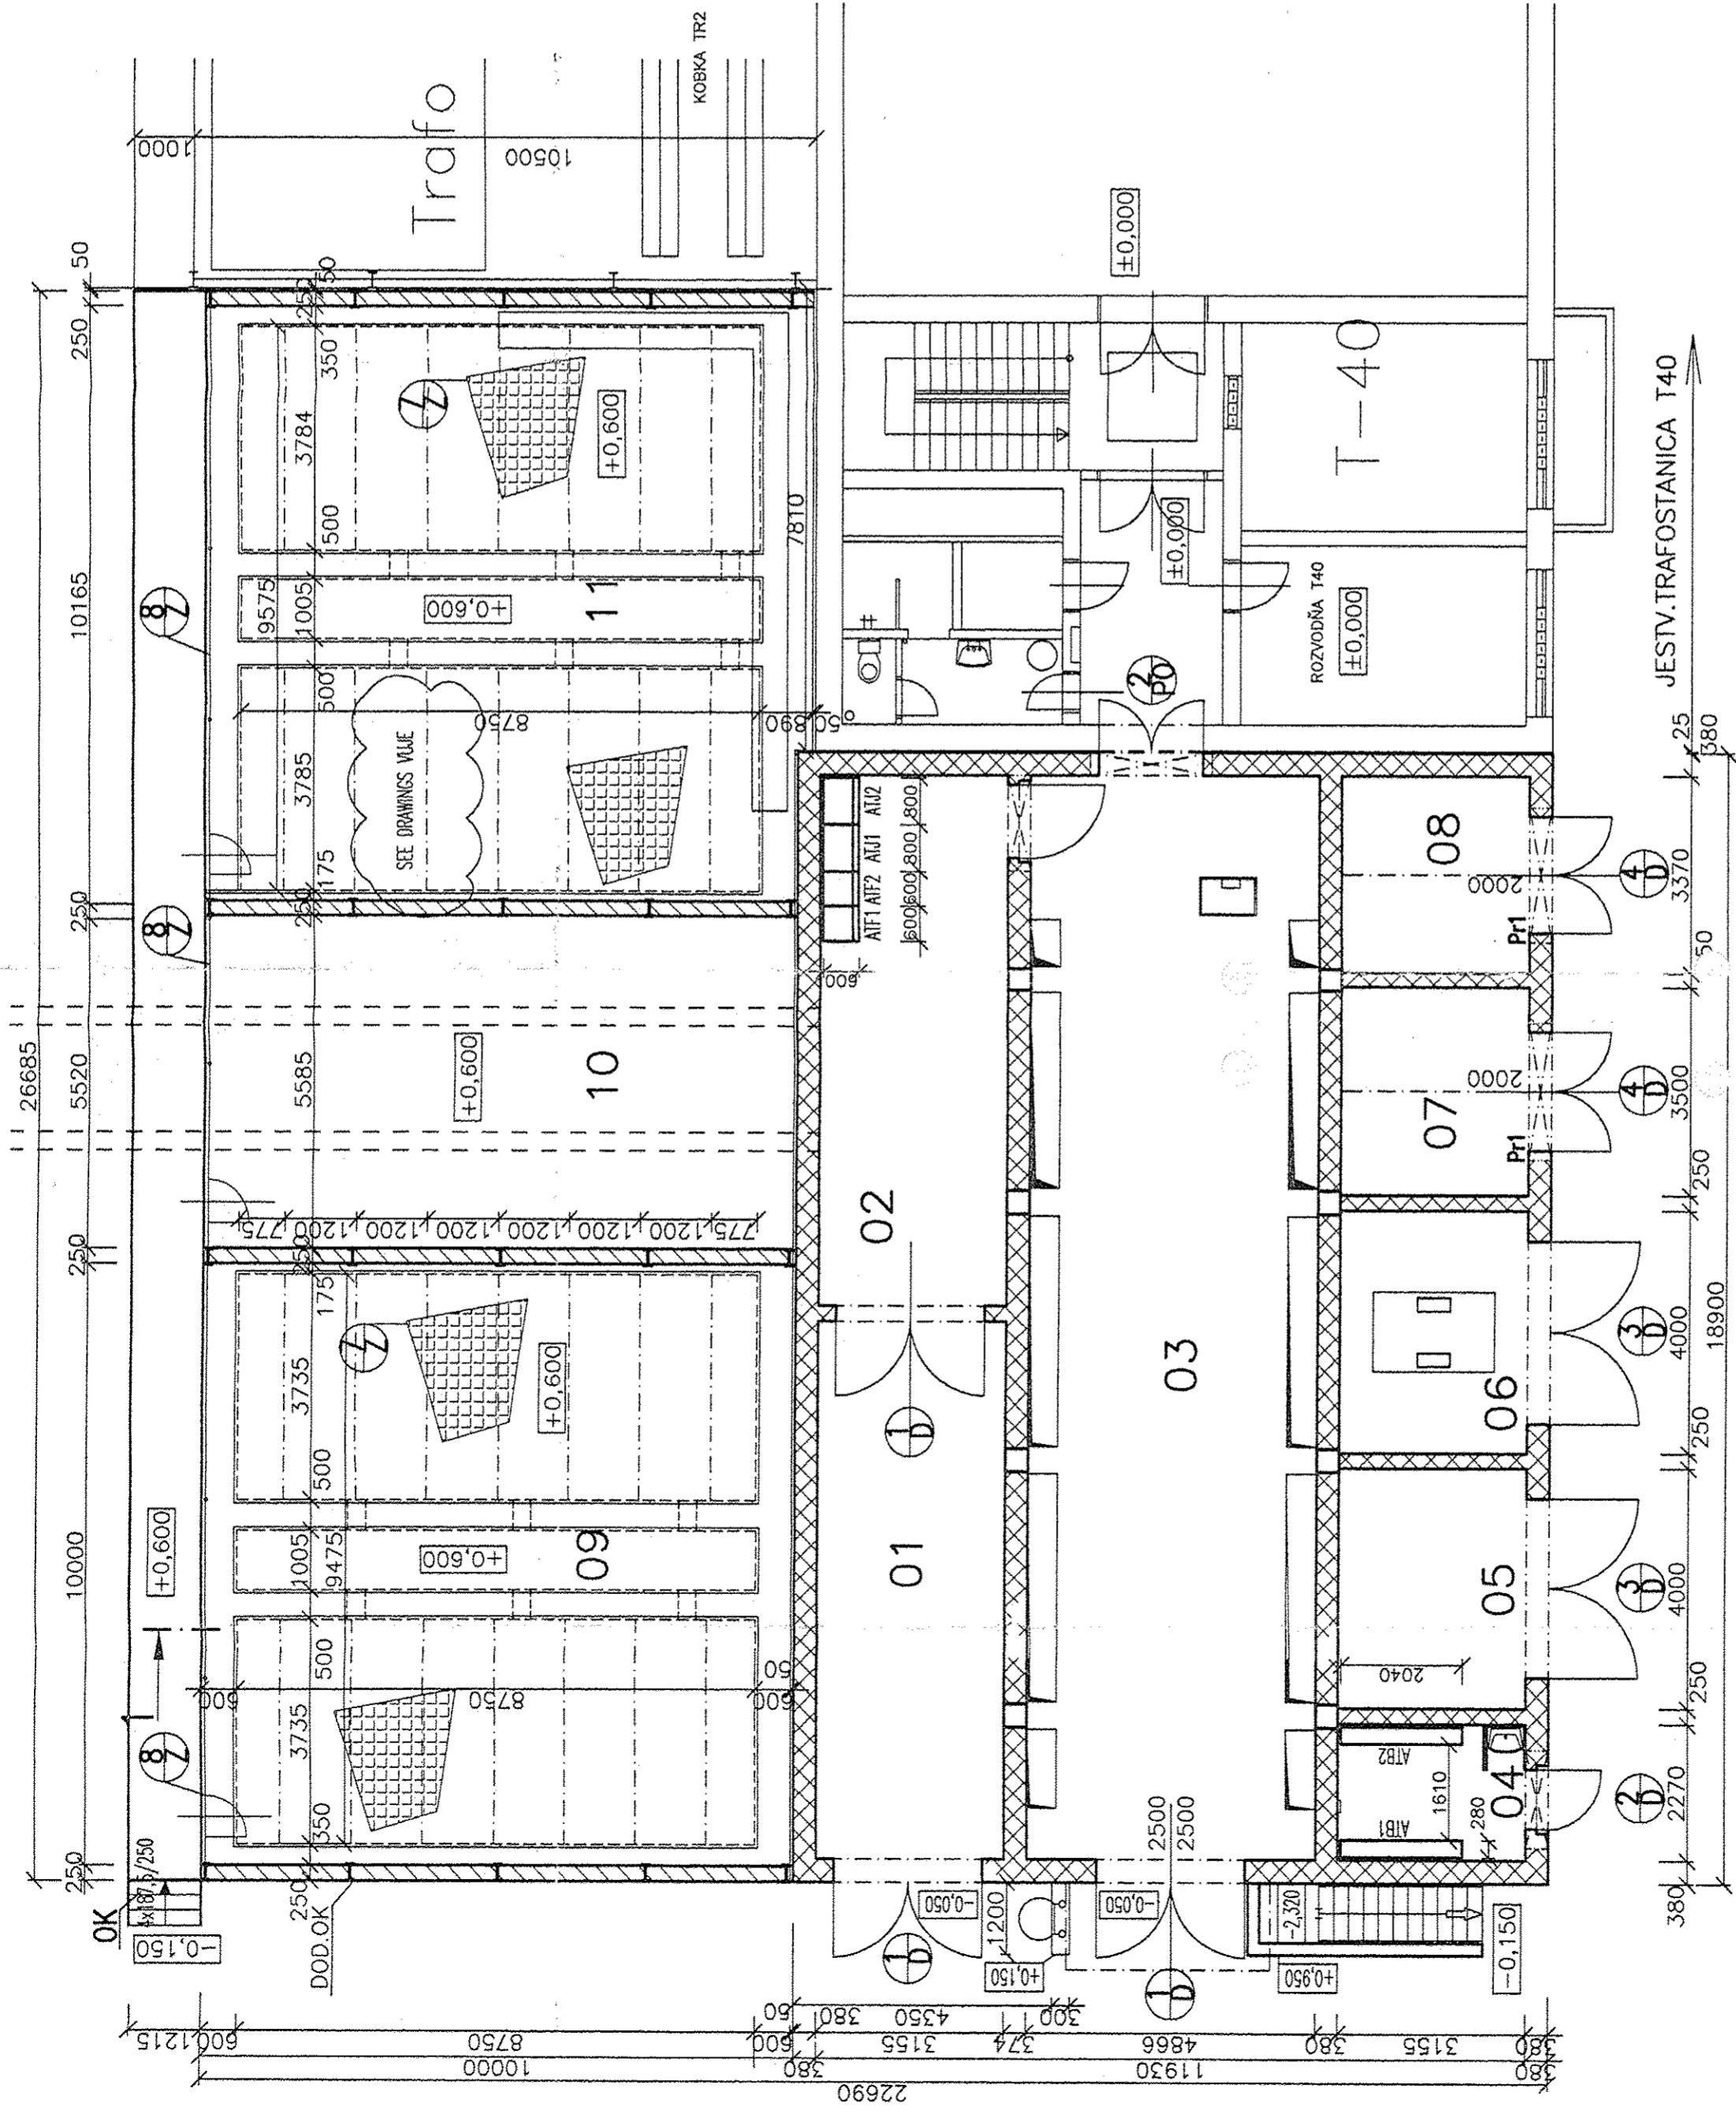[illegible]