



CESTA (betón)

CESTA (betón)

EXISTING MANHOLE 5.24

MANHOLE

CONNECTION

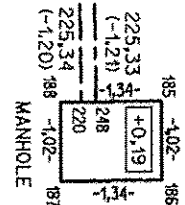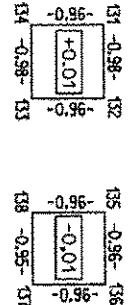

HOUSING TYP 2'

HOUSING TYP 4'

y=1128.020

41

40

-1

-2

-29