


Plant North

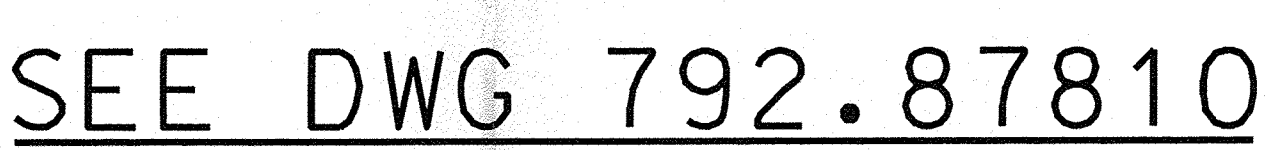

TOP OF INTERNAL ROADS:	225.00m	N. M.
TOP OF FOUNDATION:	225.10m	
BOTTOM OF STEEL STRUCTURE:	225.15	= ±0.00

7 AIR LIQUIDETM

7

Air Liquide AOS GmbH			
DATE	NAME	CREATED	ISORTITE
2005/06/20	AR	1. JUL 2005	7
JOB CODE	SCALE		
K7000 ASUNo 8 Koscice	150		
REFERENCE	ORIGINAL FORMAT		
INSTALLATION DRAWING	DWA		
TITLE	OF 19 SHEETS		
TOP VIEW 01		SHEET	2
792.87808		DRAWING NO.	
REV		00	