


3

12

SEE DWG 792.87809

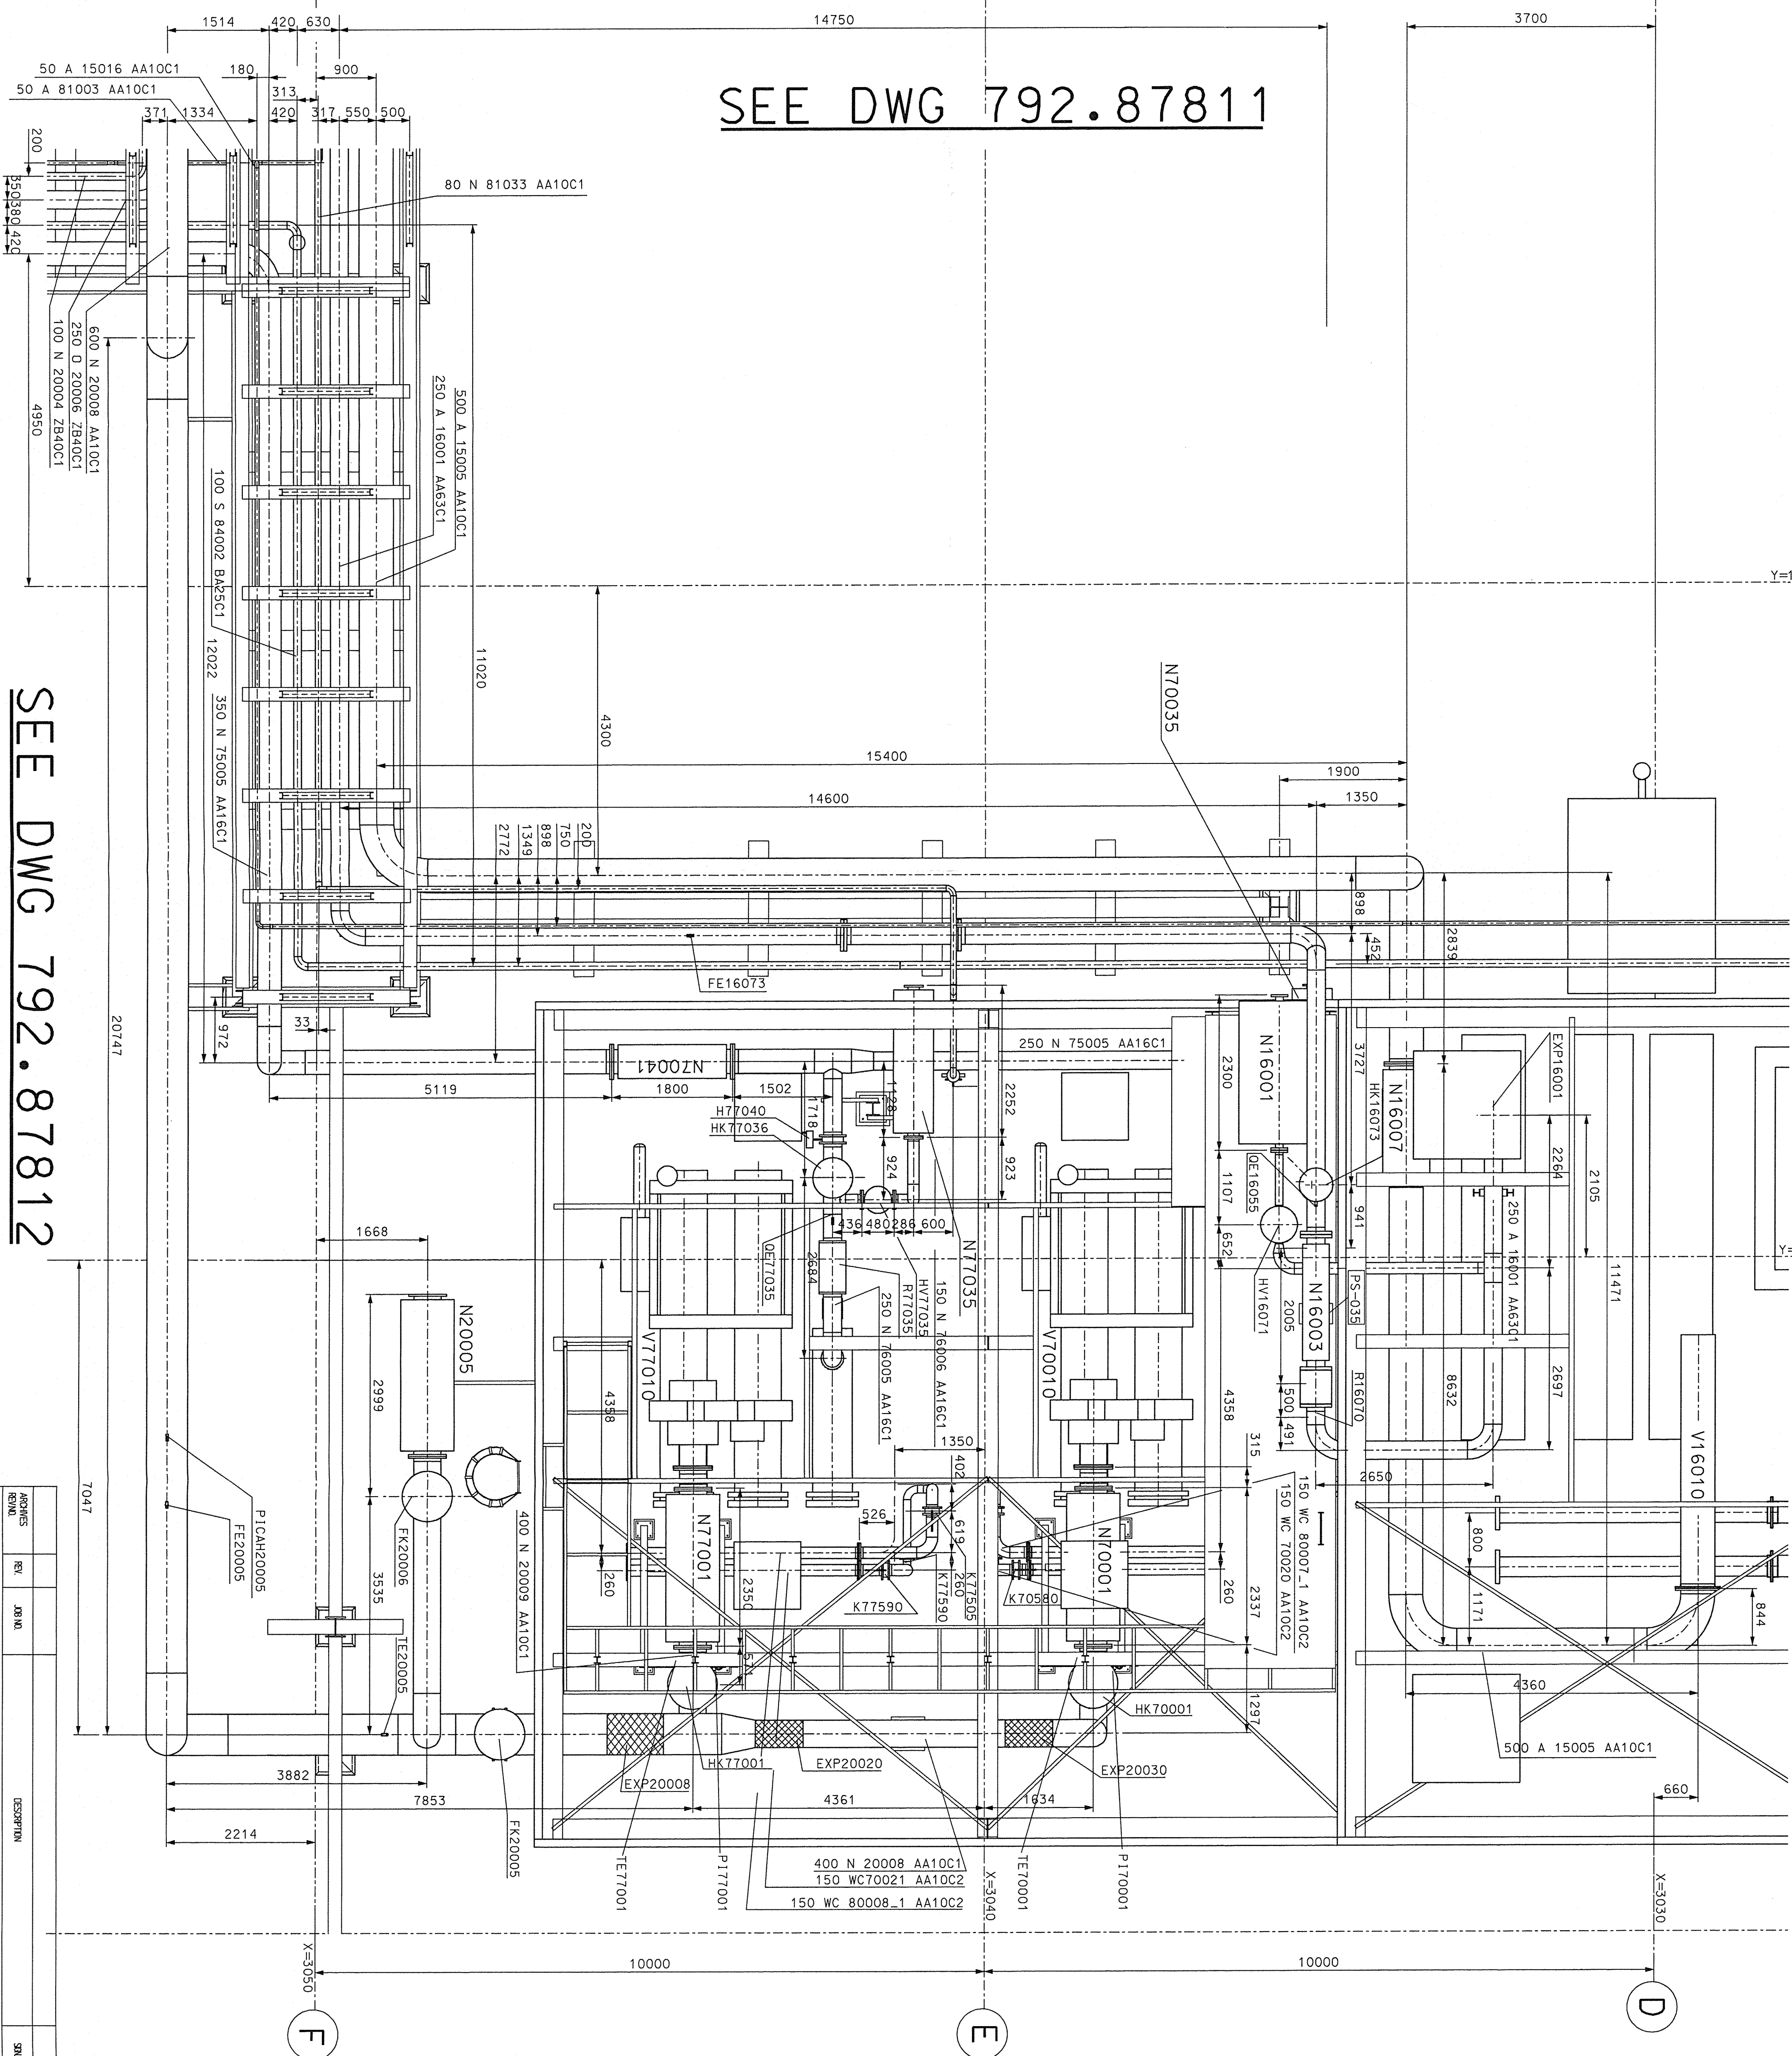

Plant North

LEVELS

TOP OF INTERNAL ROADS:


225,00m n. m.


TOP OF FOUNDATION:

225, 10m

BOTTOM OF STEEL STRUCTURE:

$$225,15 = \pm 0,00$$


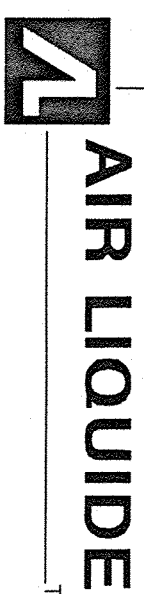

AIR LIQUIDE AOS GmbH	
DATE	2005/06/20
NAME	AR
CHECKED	17. JULI 2005
JOB CODE	K2000 ASU No. 9 Kofice
REFERENCE	INSTALLATION DRAWING
DESIGNS	
REVISIONS	
TITLE	TOP VIEW 03
DRAWING NO.	79287810
REV	00