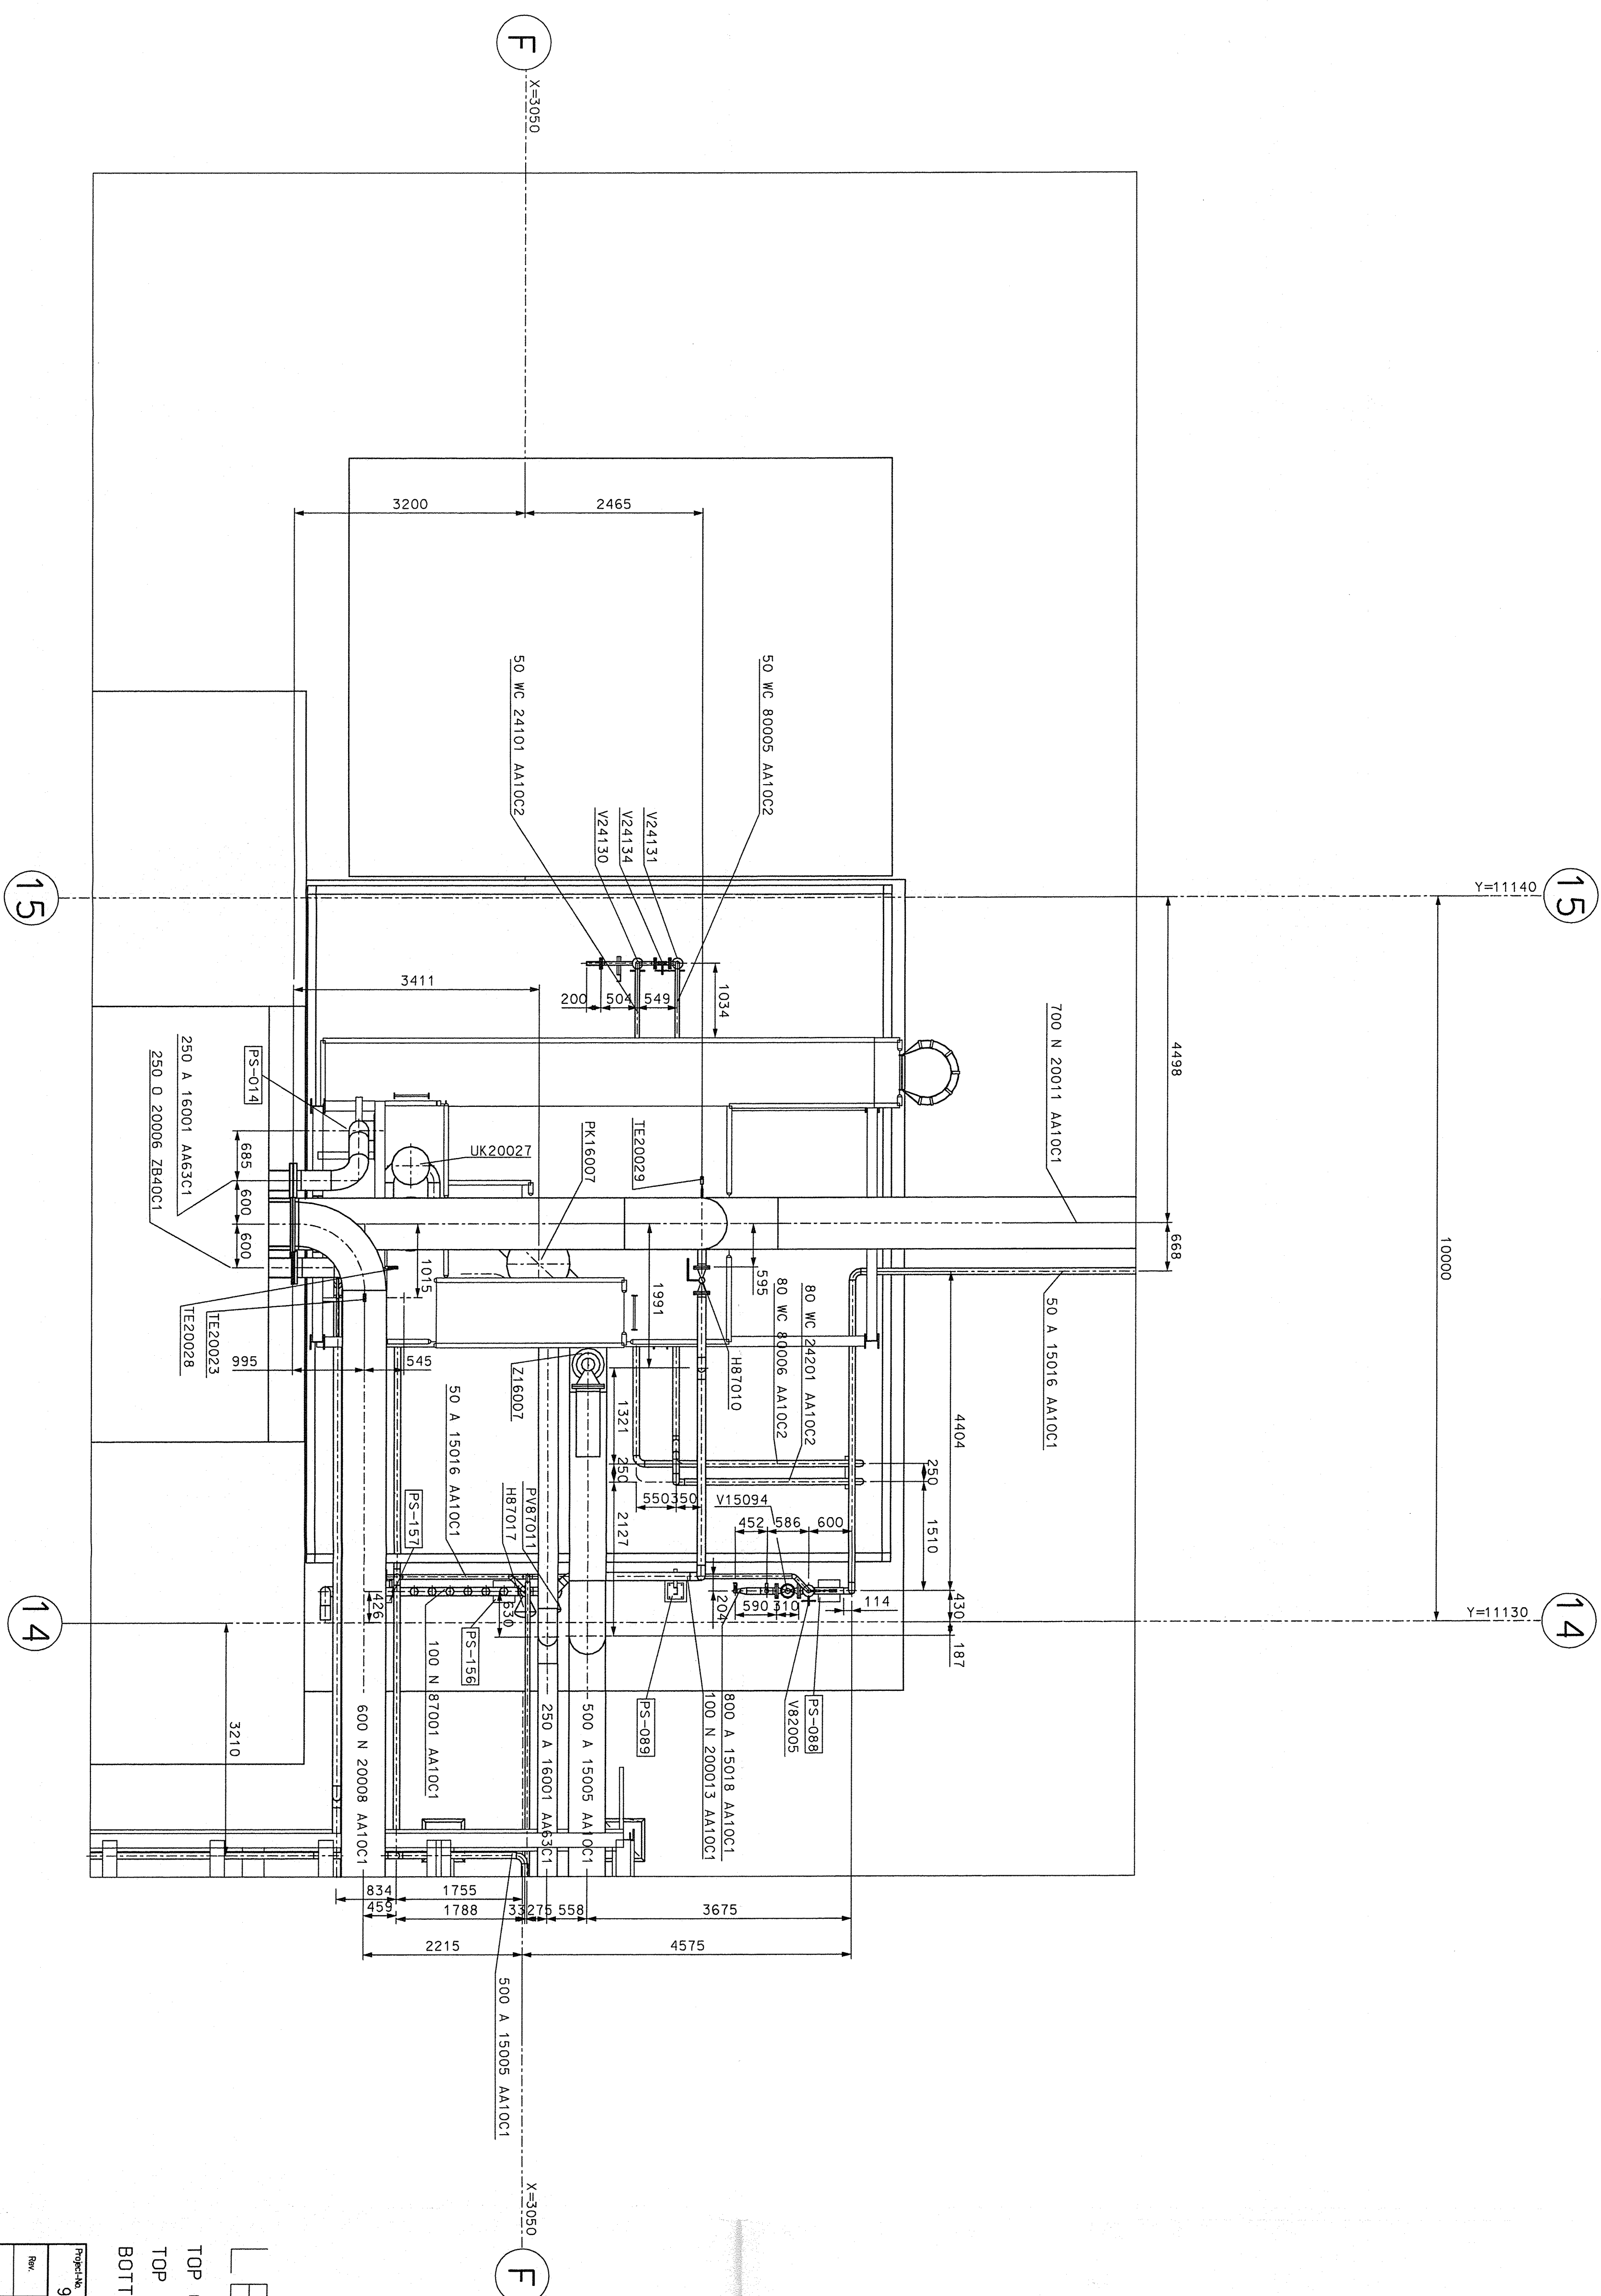



SEE DWG 792.87808


Plant
North

SEE DWG 792.87810

LEVELS

TOP OF INTERNAL ROADS:	225,00m	n. m.
TOP OF FOUNDATION:	225,10m	
BOTTOM OF STEEL STRUCTURE:	225,15	= ±0,00

Projektsch.	99503300	GrF-Code	RP60402	Darstellungs-Nr.	90503300-604-1	Revu	00
Revu	drawn	checked	input	Proj.-Nr.	2039	Customer Air Liquide AOS	Kosten ASU Nr. 09
	Date	Date	from	Date	2004/05		
					1205		
					04/07/05		
						Lagerungsposition für den Abgleich	

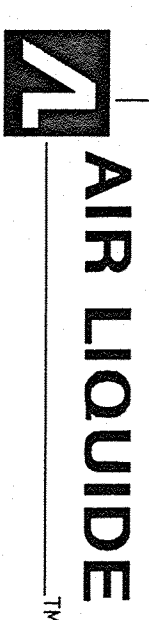

Air Liquide AGS GmbH

DATE:	2016/06/20	NAME:	AR	CHECKED:	2016/06/20	REVIEWER:	
JOB CODE:	K201 ASU No. 9 Kosec	SCALE:	1:50	SHEET:	5	OF SHEETS:	10
REFERENCE:	NSI ALLOCATION DRAWING	DRAWING No.	792.87811	REV	000		
REV DES:							
REV DATE:							