



Section C-C

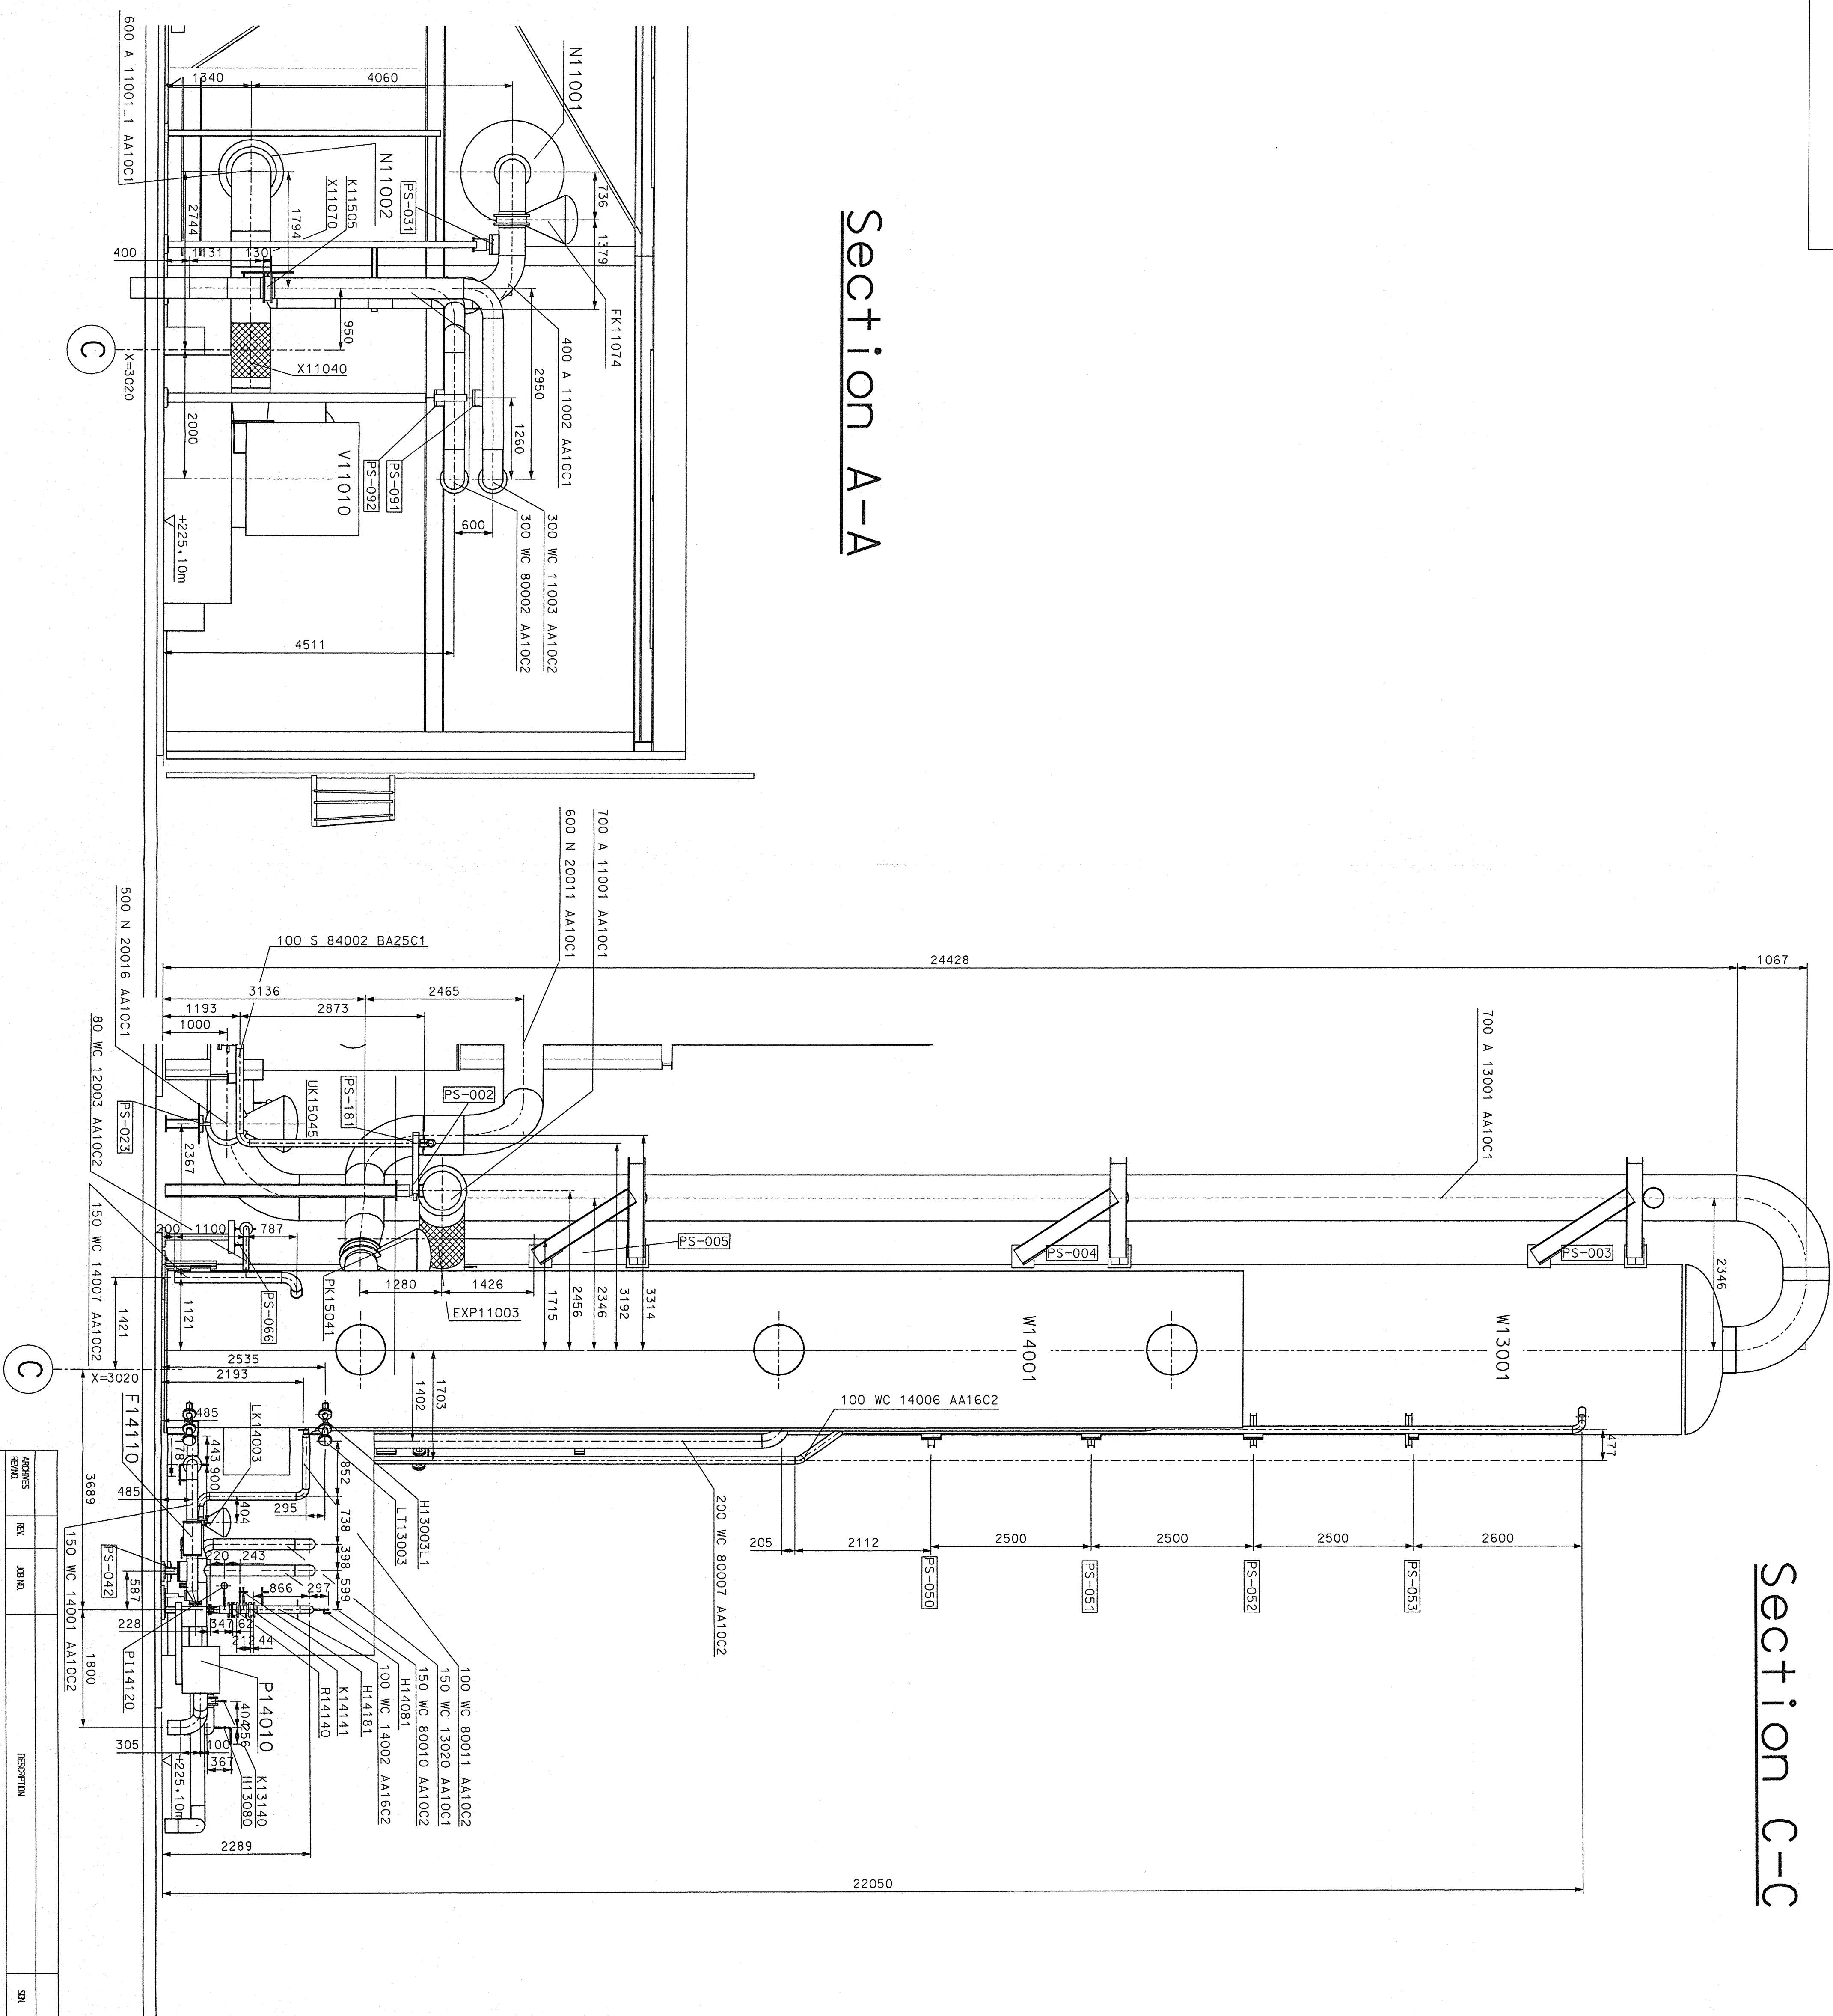

LEVELS

TOP OF INTERNAL ROADS:	225,00m	n. m.
TOP OF FOUNDATION:	225,10m	
BOTTOM OF STEEL STRUCTURE:	225,15	= ±0,00

Projekt-Nr.		USt-Zoab		Downtag-Nr.		Rev.																			
99503300		RP6102		99503300-611-1		00																			
<table><tr><td>drawn</td><td>checked</td><td>invd</td><td>Proc.-Mo.</td><td>2039</td><td></td><td></td><td></td></tr><tr><td>Date</td><td>Date</td><td>Item</td><td>Date</td><td>200405</td><td></td><td></td><td></td></tr></table>		drawn	checked	invd	Proc.-Mo.	2039				Date	Date	Item	Date	200405				Customer		ASU No 09		<table><tr><td>ASU No 09</td><td>ASU No 09</td></tr></table>		ASU No 09	ASU No 09
drawn	checked	invd	Proc.-Mo.	2039																					
Date	Date	Item	Date	200405																					
ASU No 09	ASU No 09																								
<table><tr><td>Rev.</td><td></td><td></td><td></td><td></td><td></td><td></td><td></td></tr><tr><td>Date</td><td>Date</td><td>Date</td><td>Date</td><td>Date</td><td>Date</td><td>Date</td><td>Date</td></tr></table>		Rev.								Date	Date	Date	Date	Date	Date	Date	Date	Immission		Kategorie		<table><tr><td>ASU No 09</td><td>ASU No 09</td></tr></table>		ASU No 09	ASU No 09
Rev.																									
Date	Date	Date	Date	Date	Date	Date	Date																		
ASU No 09	ASU No 09																								

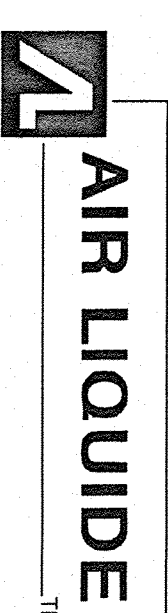

Air Liquide AGS GmbH		DATE		INVOICE		ORDERED		24		INSTITUTE	
		2005/06/20		AR		1. JUL		2005			
		JOB CODE		K7001/AS/IN. 9 Koscice		SCALE		1:50		ORIGINAL FORMAT	
		REFERENCE		INSTALLATION DRAWING		SHEET		12		OF 10 SHEETS	
REV. 0033		TITLE		SECTION A-A / C-C		DRAWING NO.		792.87.818		REV. 00	
REV. 0030/06											