




Section G-G

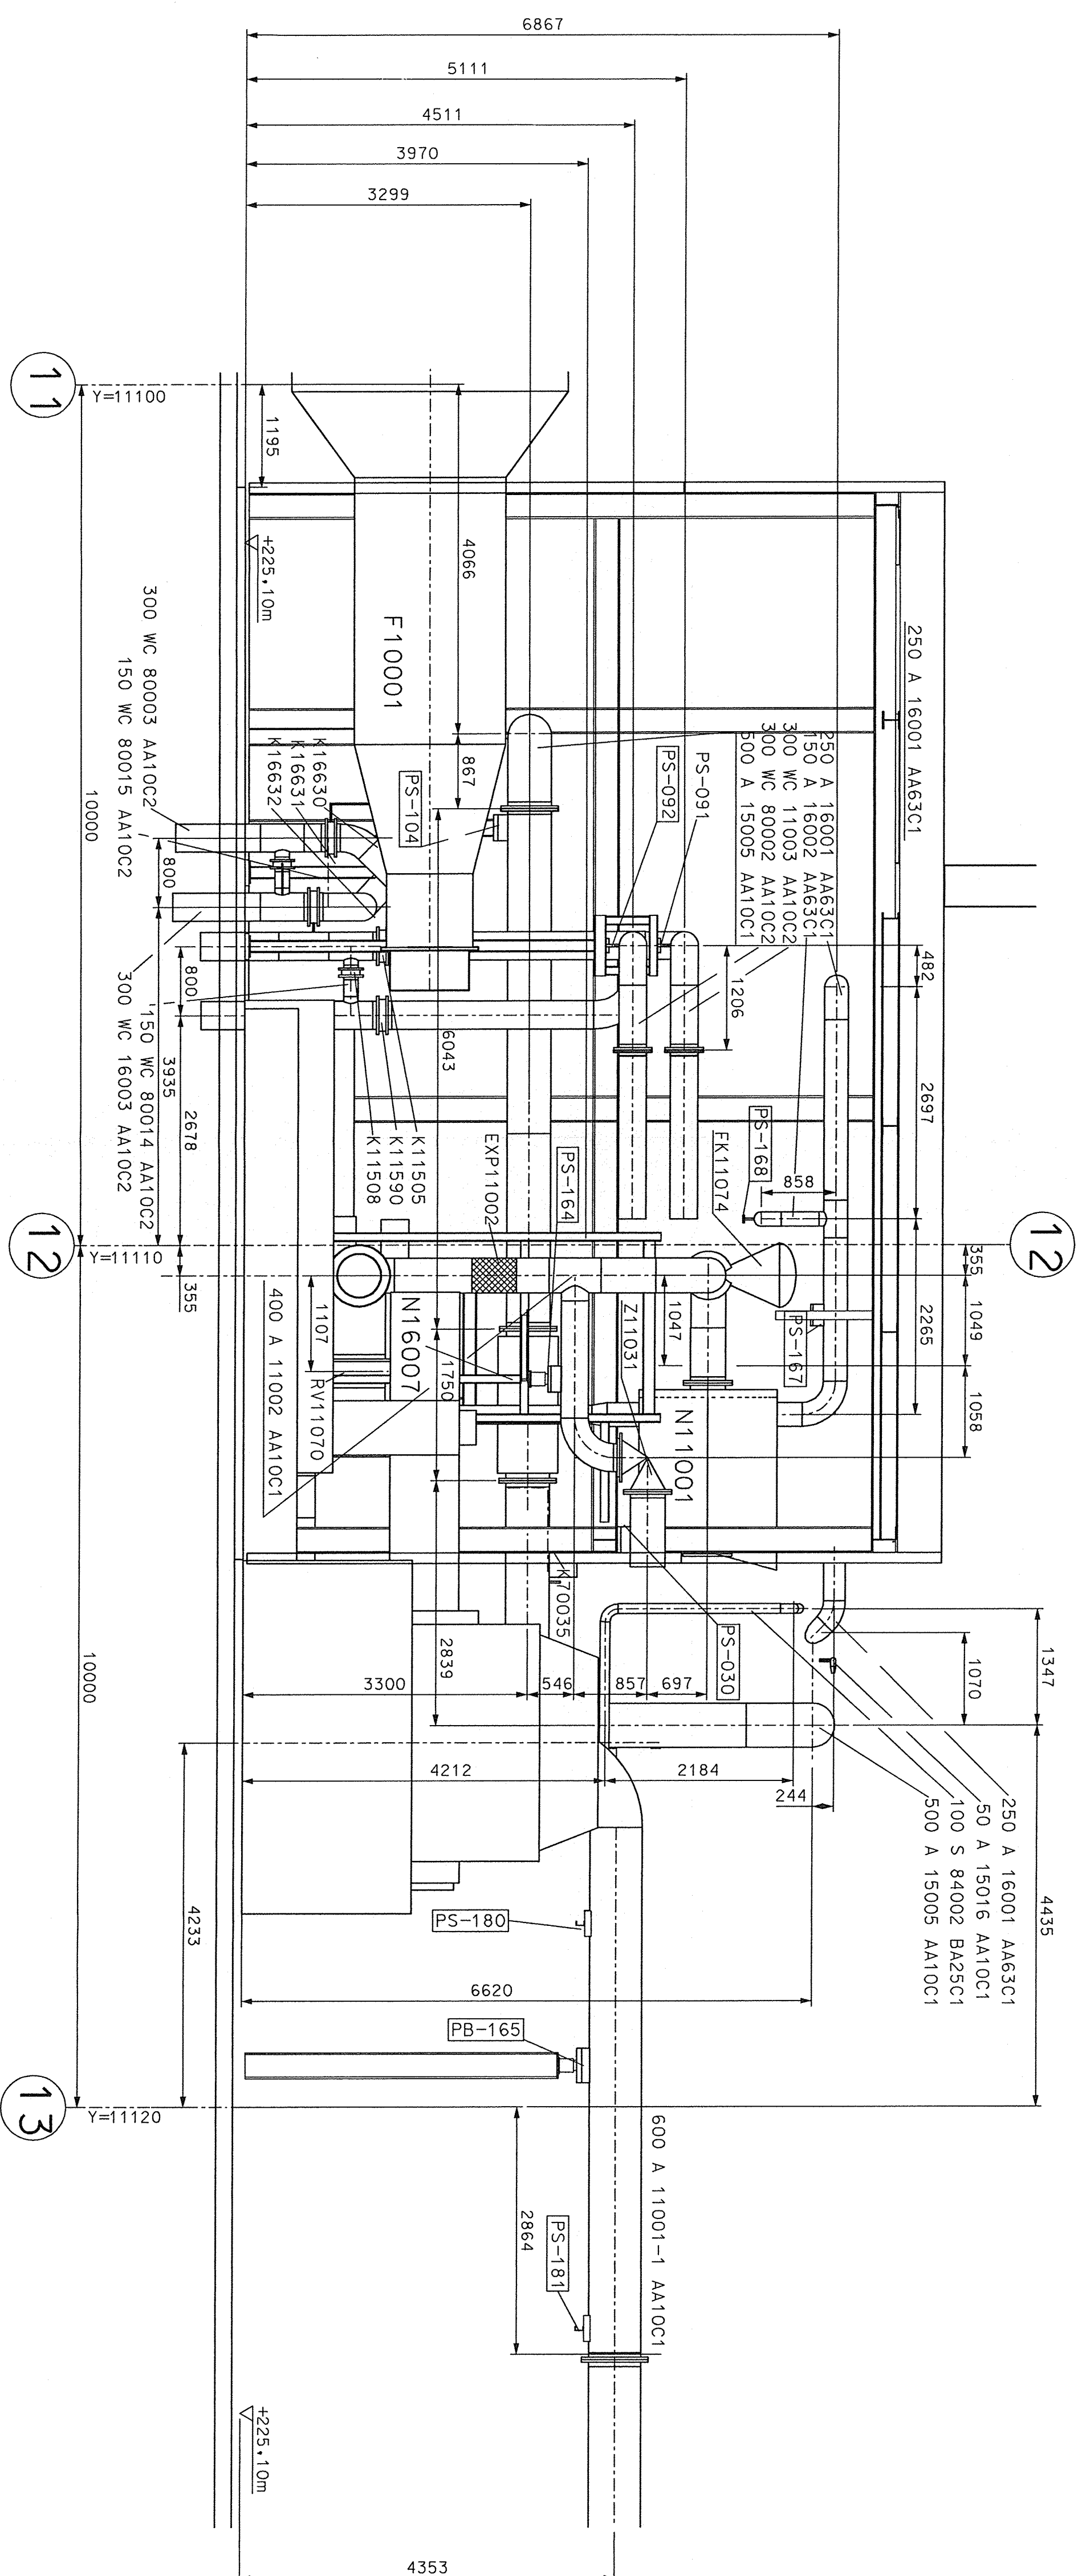

Section H-H

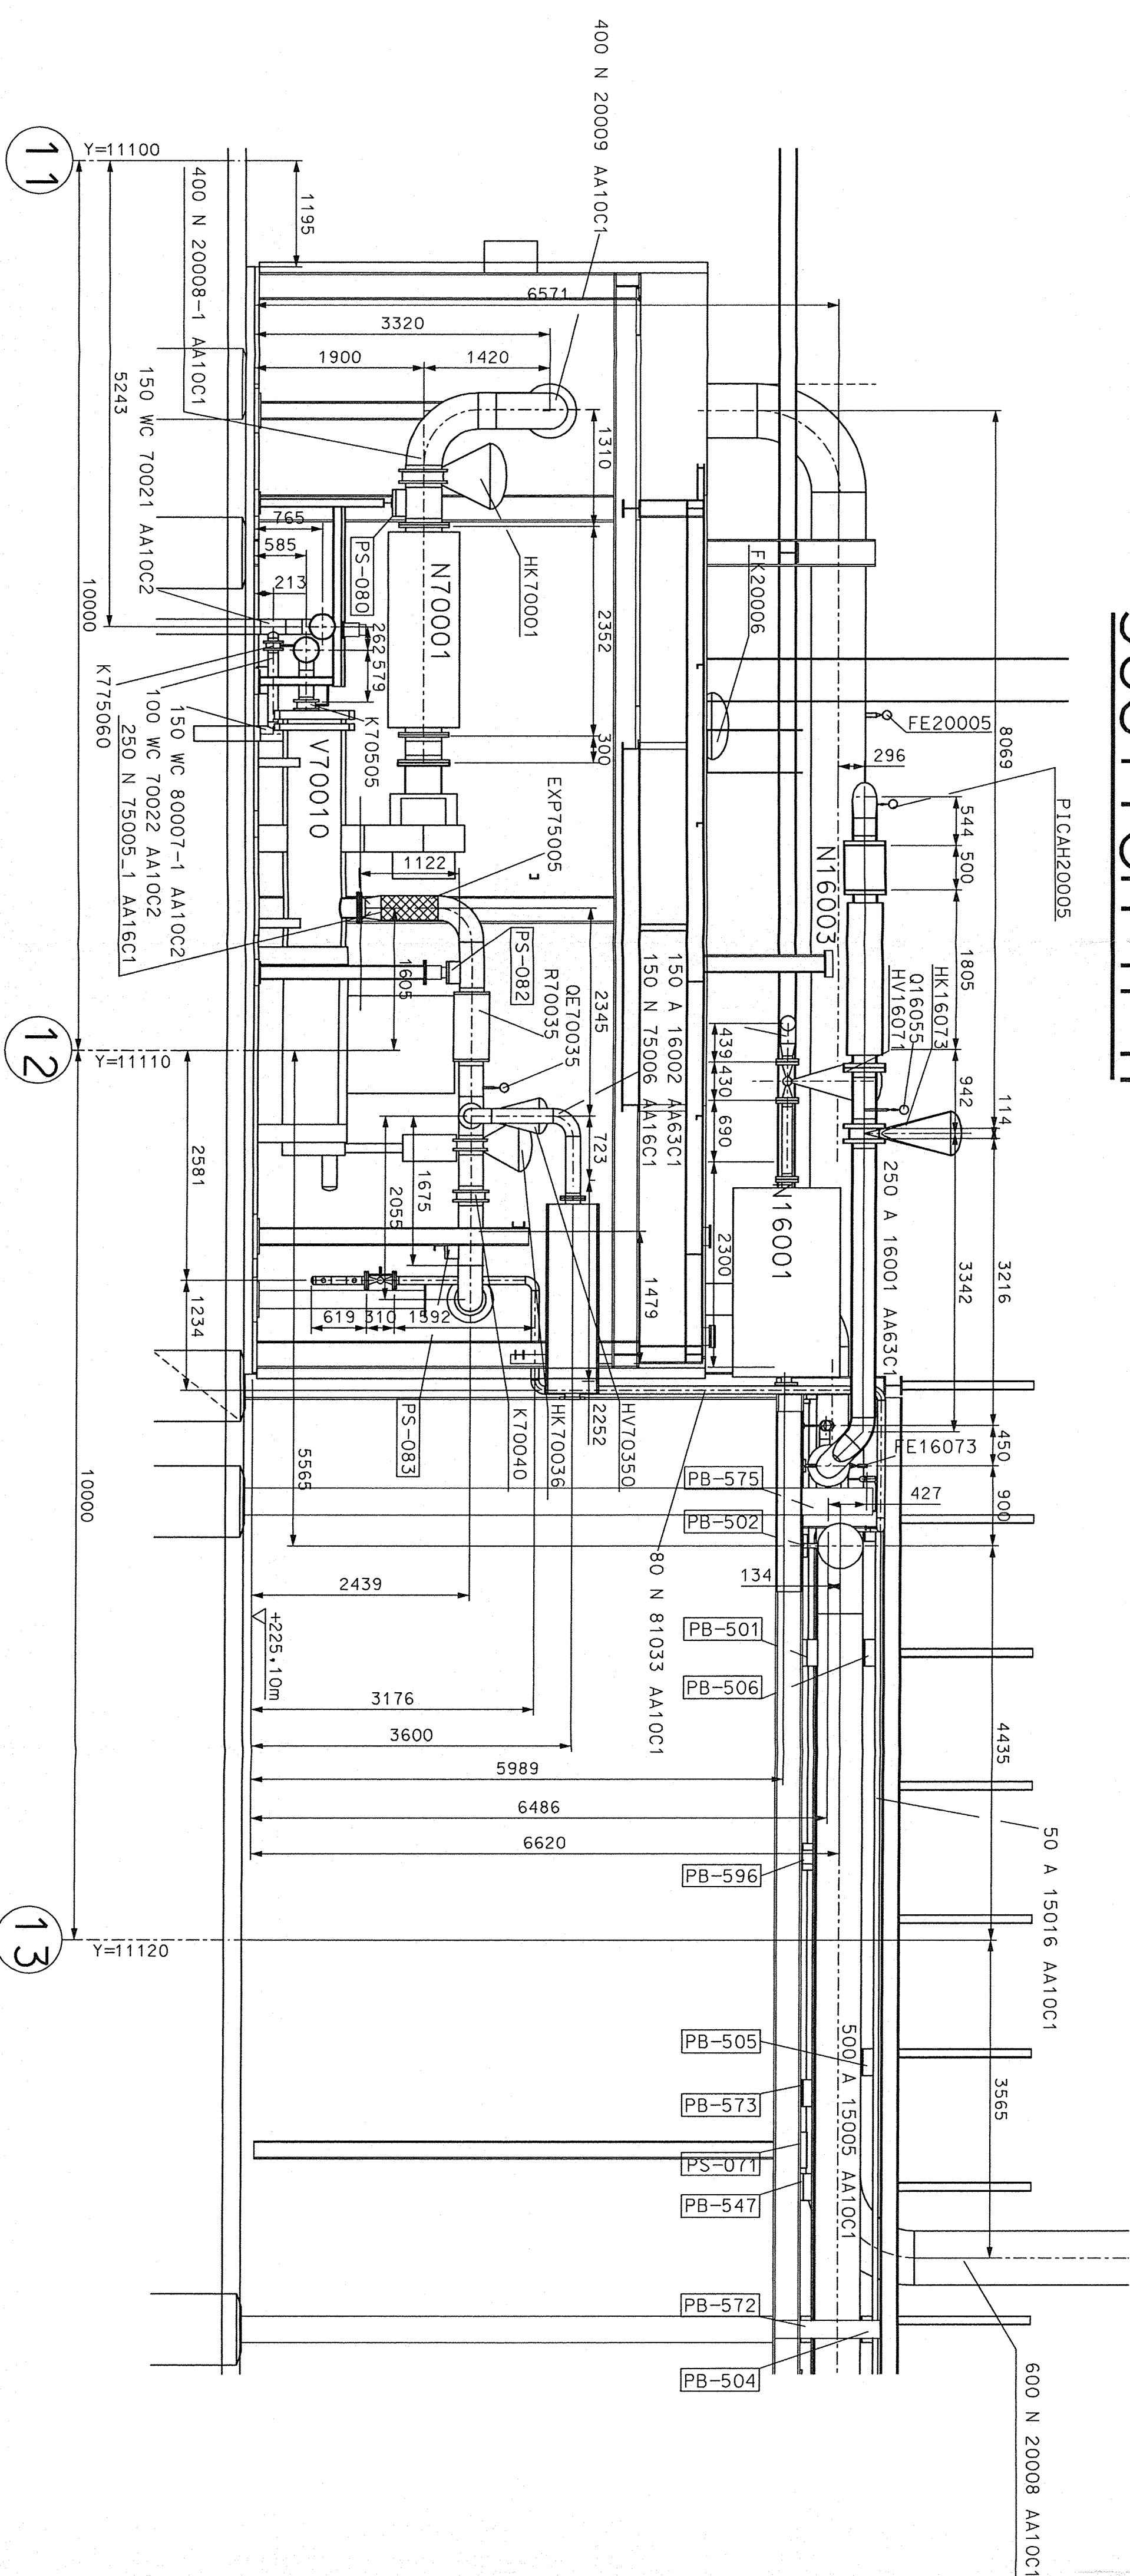

ARCHIVES REFNO	REL	JOB NO.	DESCRIPTION	SNA	DATE
-------------------	-----	---------	-------------	-----	------

[illegible]

AIR LIQUIDETM

Air Liquide AGS GmbH

DATE	20/05/06/20	NAME	AR	CHECKED	11 JUL. 2005	HOIST FILE
JOB CODE	K7000 ASU No 9 Kscope	SCALE	1:50	ORIGINAL DRAWN	DATE	
REFERENCE	INSTALLATION DRAWING	SHEET	16	OF 19 SHEETS		

SECTION G-G H-H

792.87822 | 00

LEVELS

TOP OF INTERNAL ROADS: 225.00m n. m.

TOP OF FOUNDATION: 225.10m

BOTTOM OF STEEL STRUCTURE: 225,15 = +0,00