



Section I-I

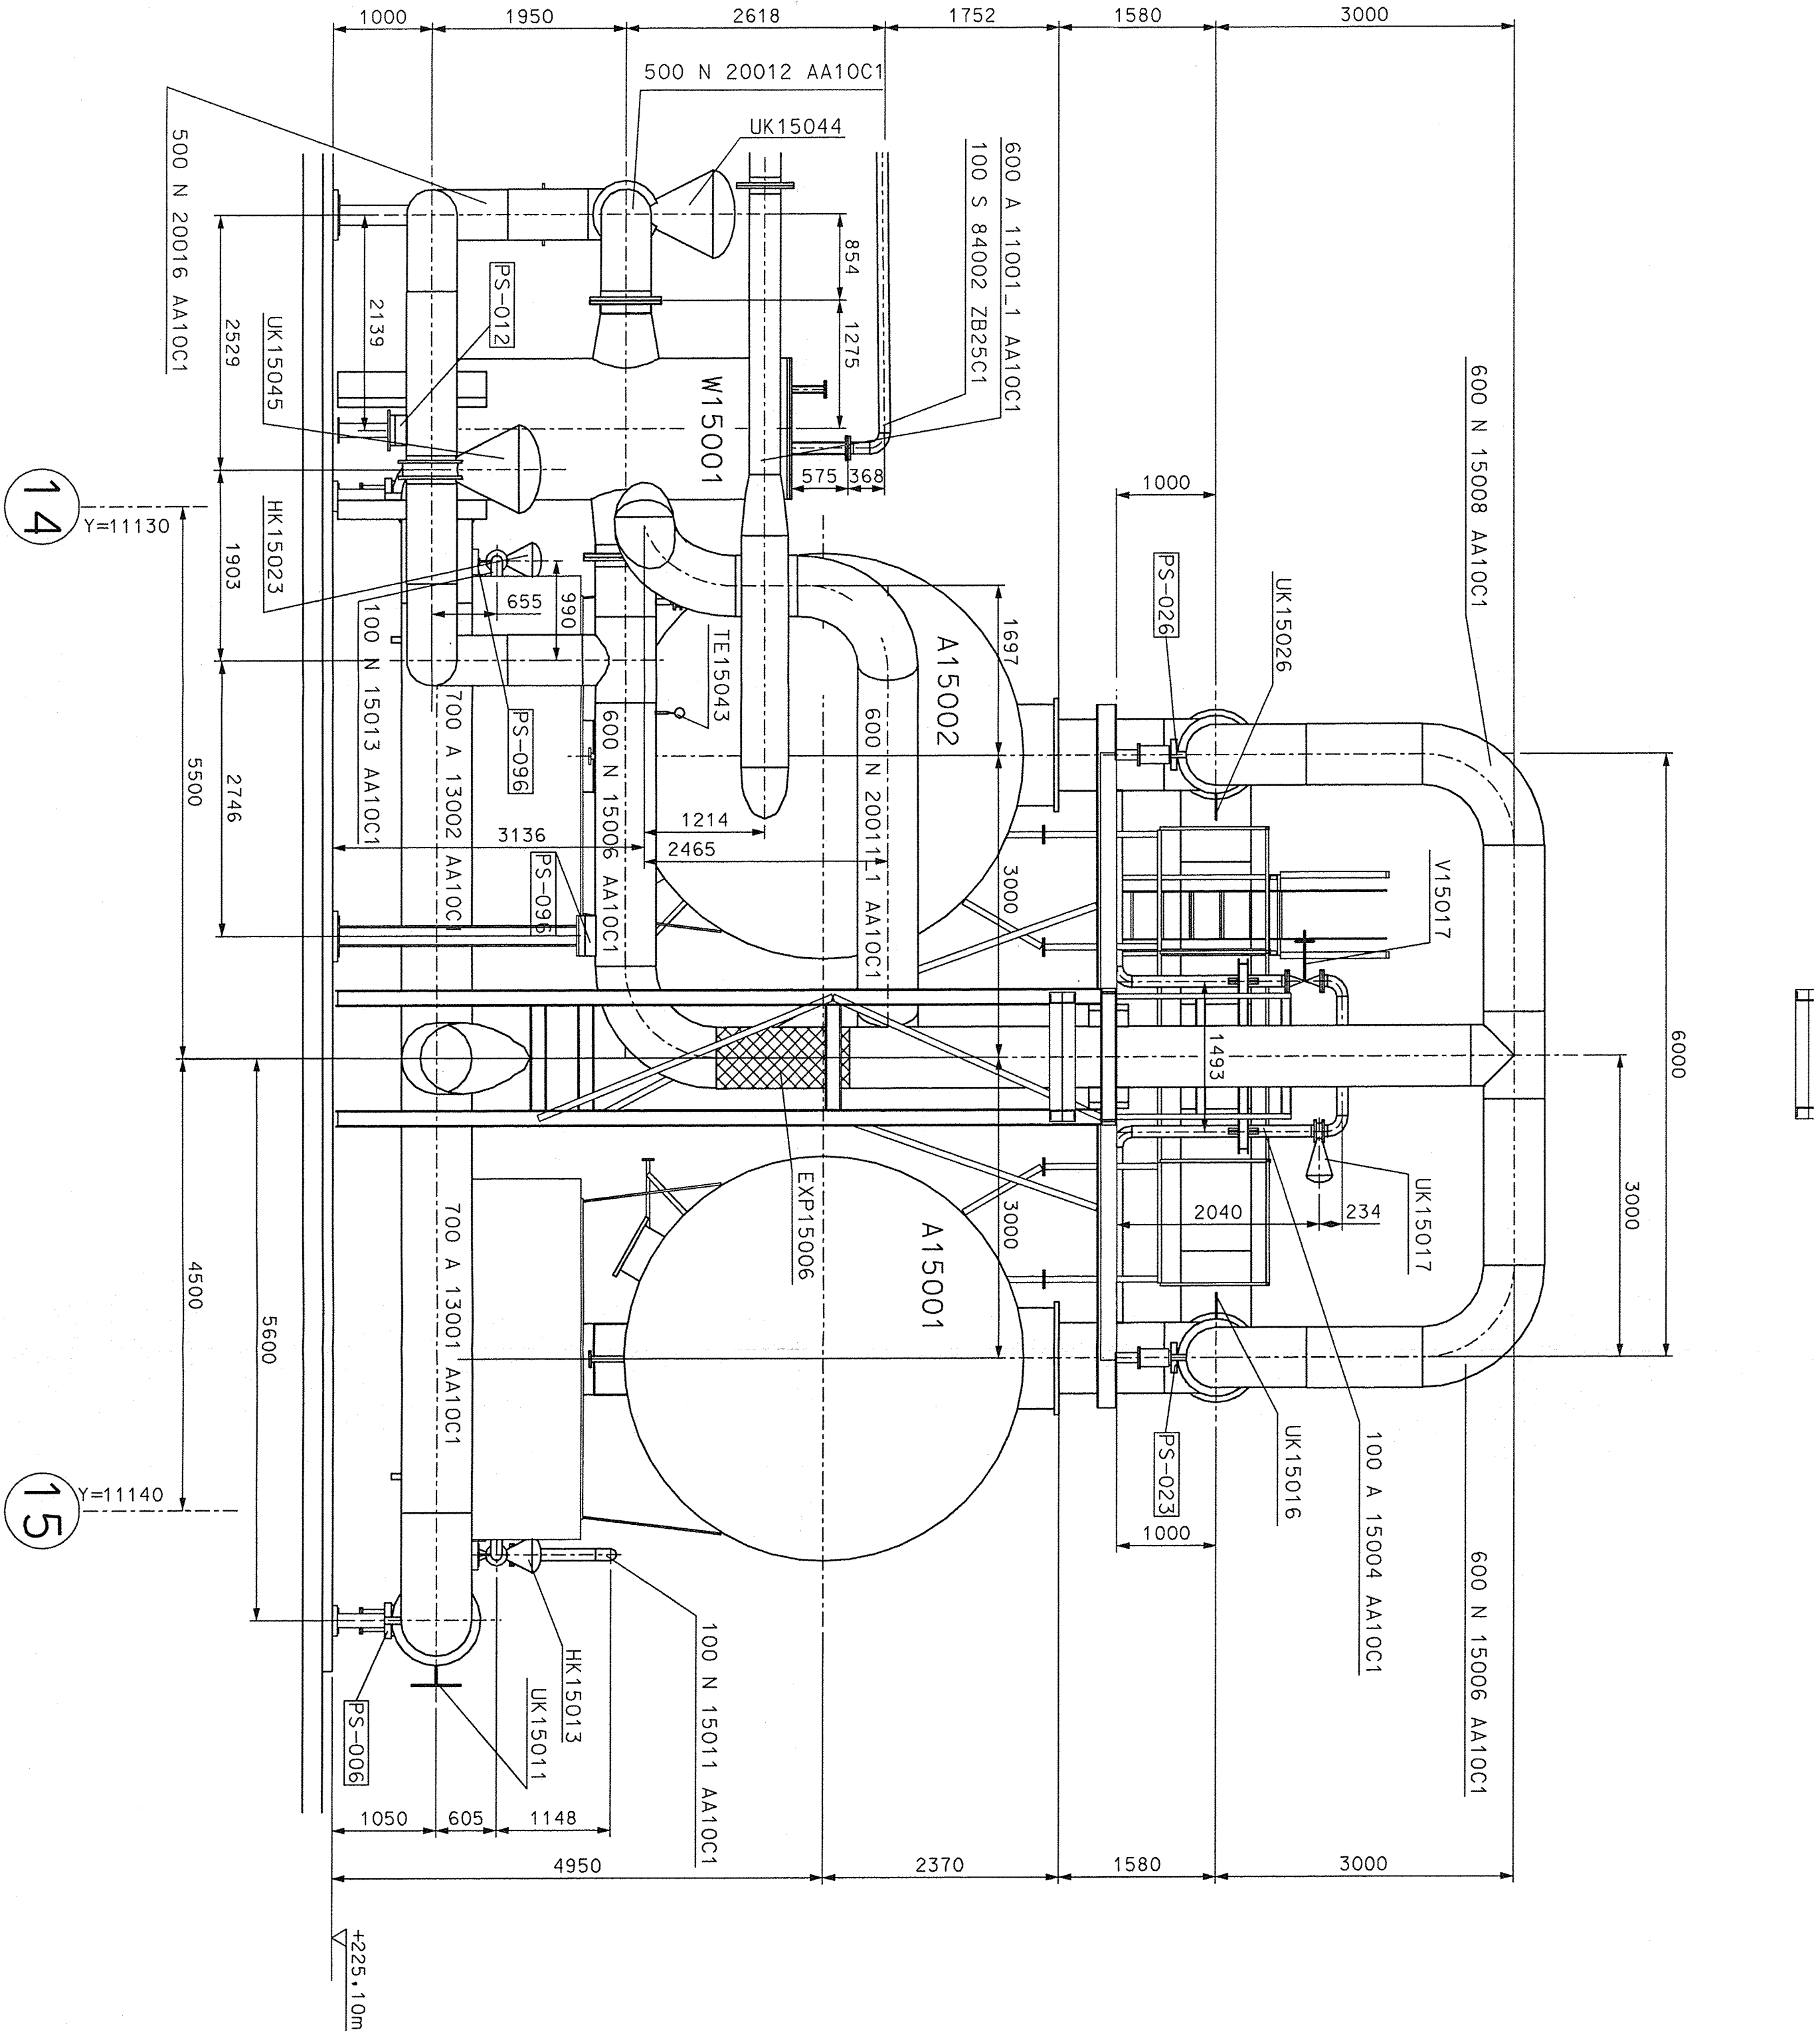


Section J-J

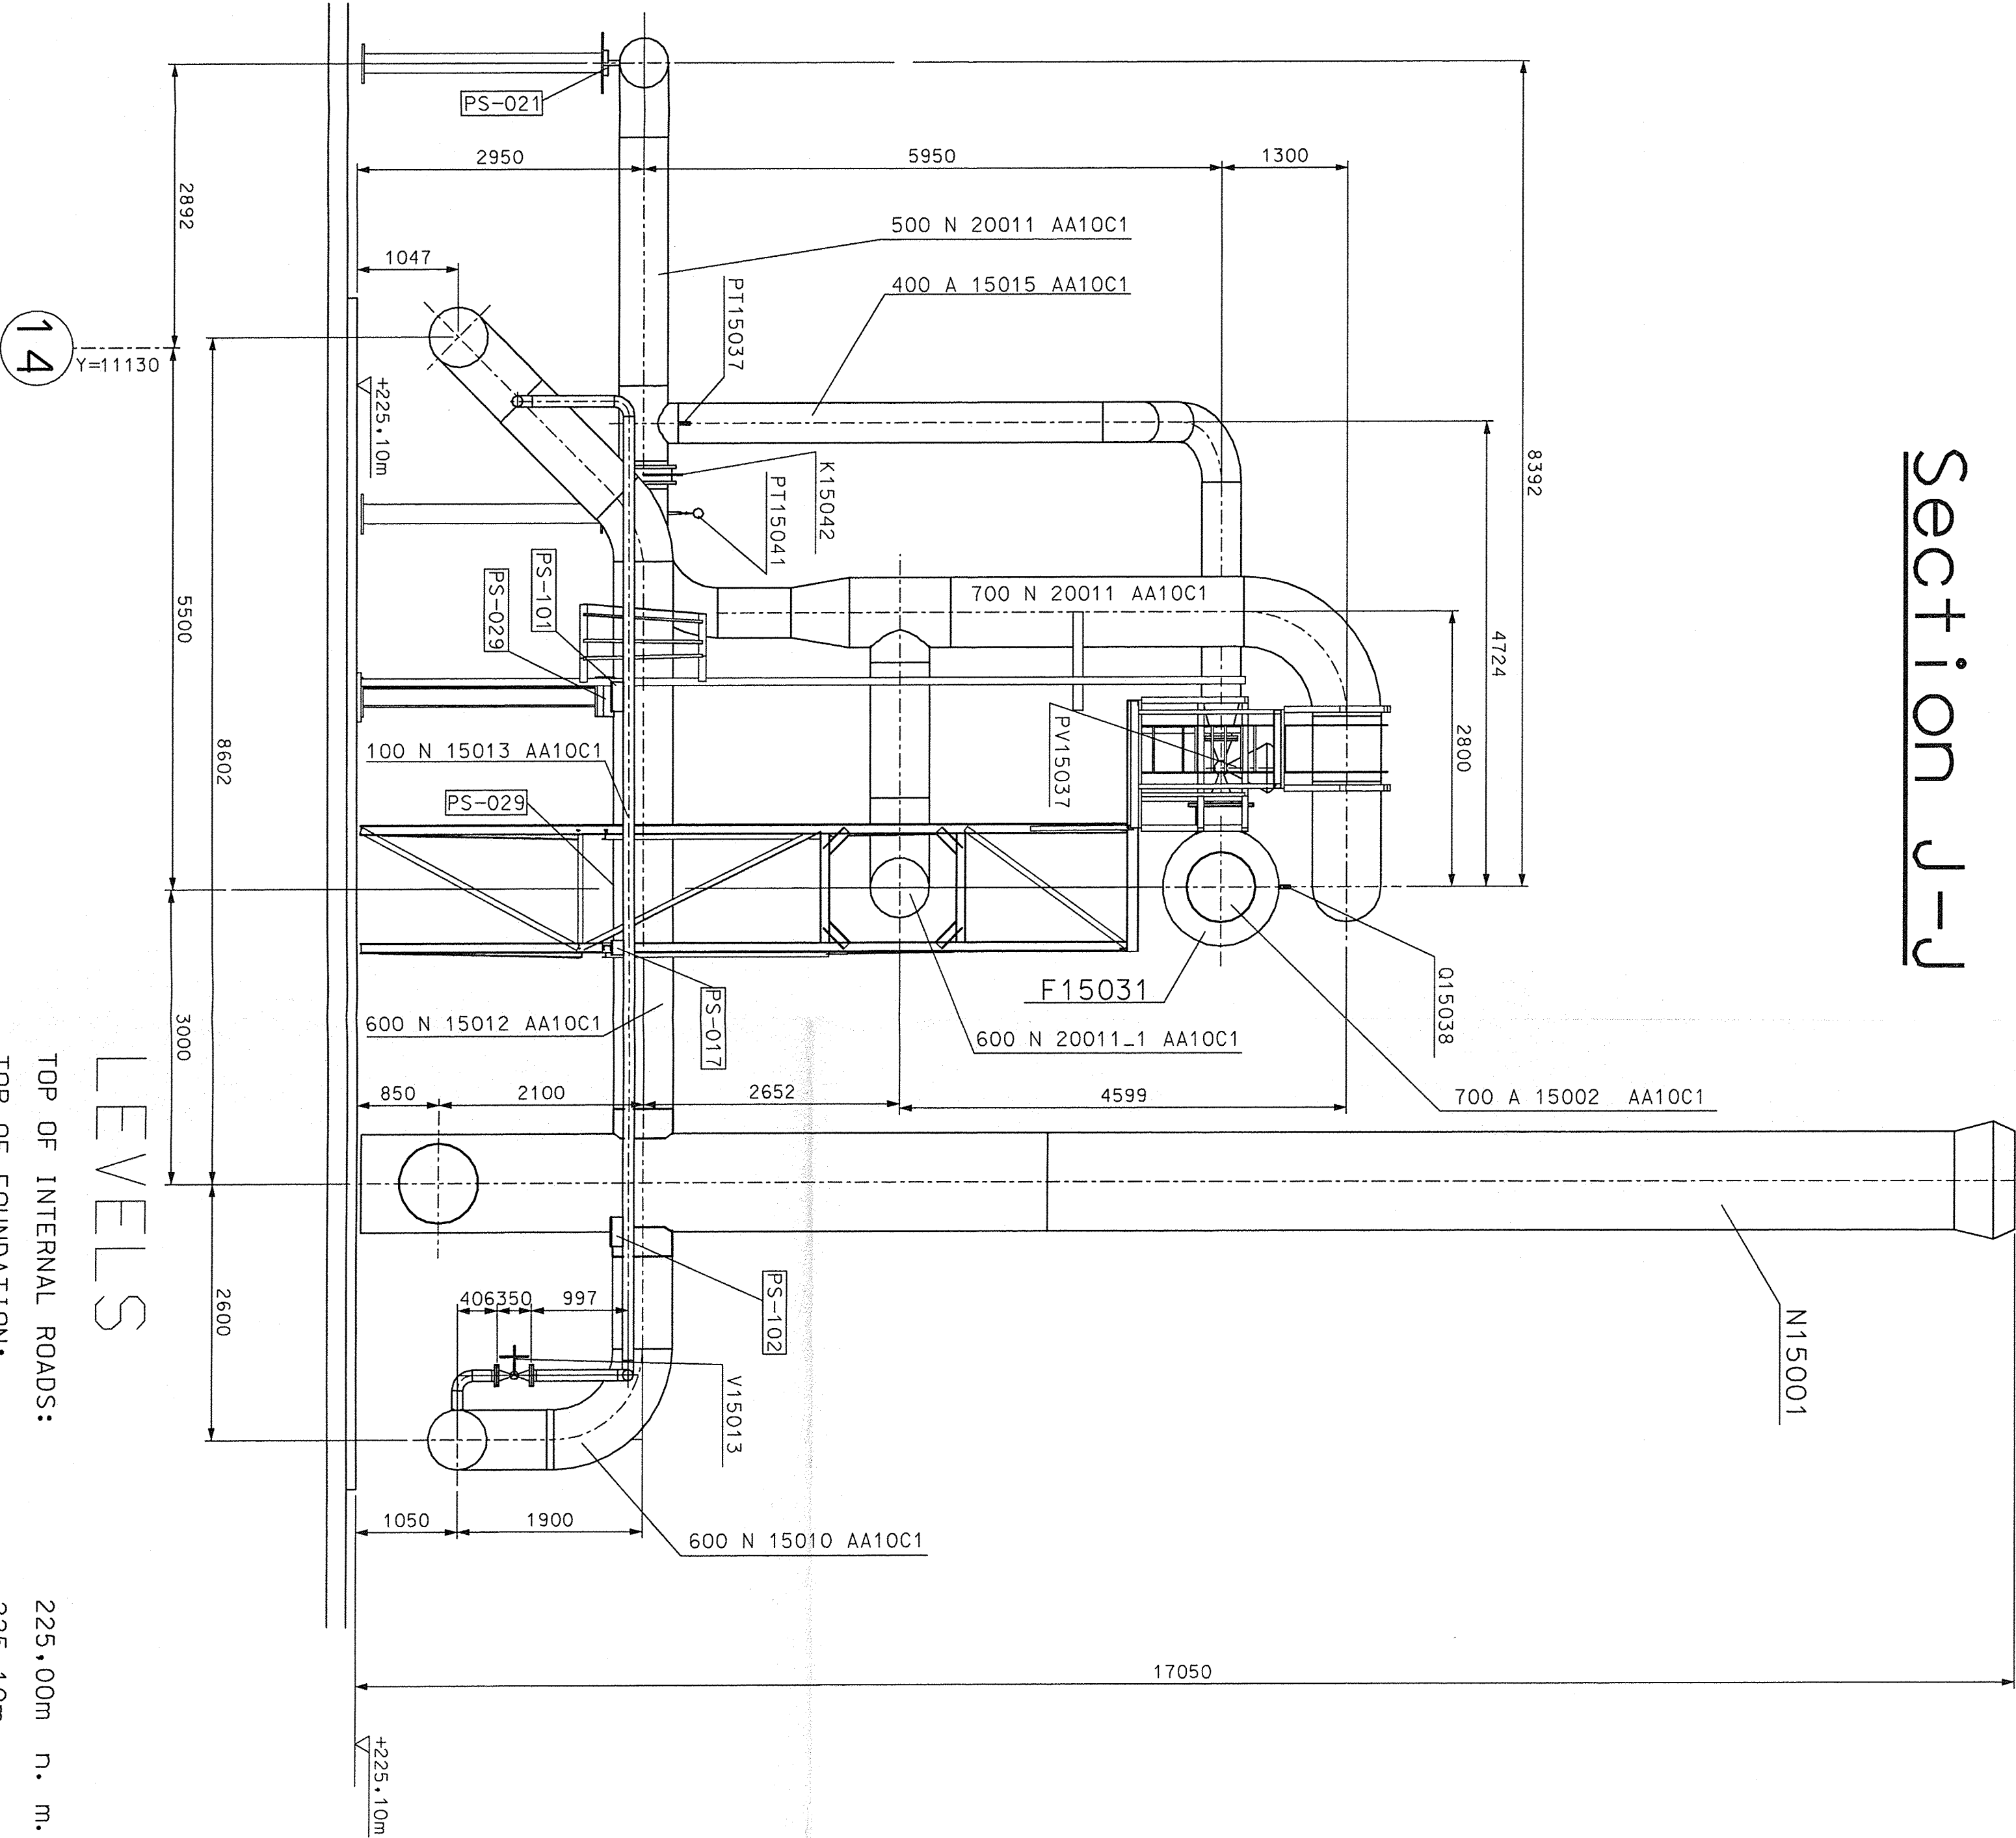

LEVELS

TOP OF INTERNAL ROADS: 225.00m n. m.  
TOP OF FOUNDATION: 225.10m  
BOTTOM OF STEEL STRUCTURE: 225.15 = ±0.00

Project No	9050300	Rev	00
Drawn	2005/06/20	Checked	2005/06/20
Scale	1:50	Scale	1:50
Reference	INSTALLATION DRAWING	Reference	INSTALLATION DRAWING
Sheet	17	Sheet	17
Drawn	79287823	Drawn	79287823
Rev	00	Rev	00

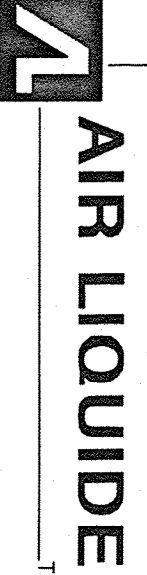

