
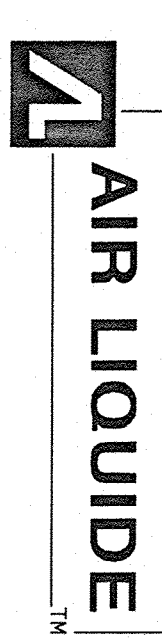


LEVELS

TOP OF INTERNAL ROADS:	225,00m	n. m.
TOP OF FOUNDATION:	225,10m	
BOTTOM OF STEEL STRUCTURE:	225,15	= +0,00

Project-No.	9050300	Due-Date	RP61802	Drawing-No.	9050300-618-1	Rev.	00
Rev.	drawn	checked	total	Part-No.	2039	Customer	Air Liquide AGS
	Date	Date	Ton	Date	2004/05	Version	Klasse
					1225		
					06/07/05		ASU No 03
						Building-No.	
							Hyperregional T. 70.14.00.00.00
							



Air Liquide AGS GmbH

DATE	NAME	CHECKED	HISTORY FILE
05/05/06/20	AR	1. JUL. 2005	79287825
JOB CODE	K2001 ASJUNo.9 Kosiye		
REFERENCE	INSTALLATION DRAWING		
TITLE	SECTION L-L		
SCALE	150	ORIGIN. FORMAT	
SHEET: 19	OF 19 SHEETS		
DRAWING No.	79287825		
REV	0		
REV. NUMBER			