


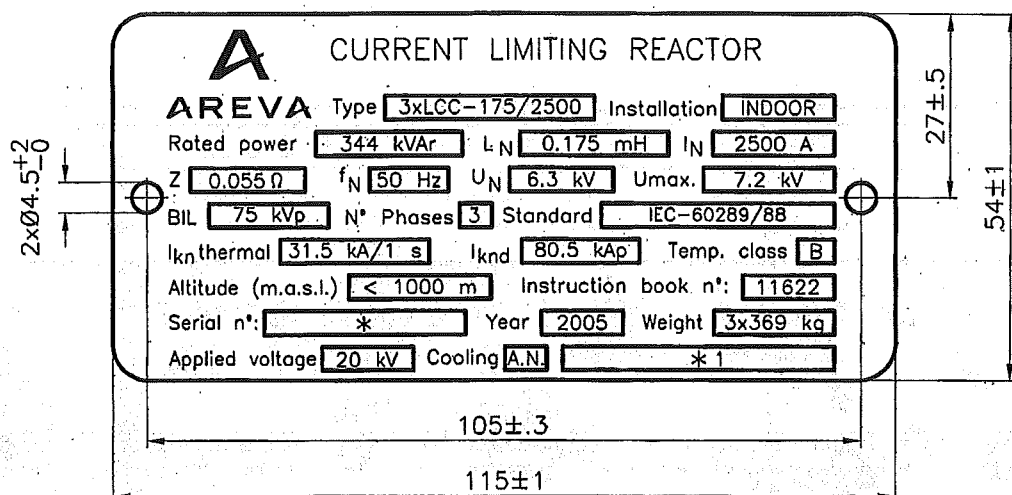

CAD



\* 05.9041-01

\*1

LOWER COIL  
MIDDLE COIL  
UPPER COIL

\* 05.9041-02

\*1

LOWER COIL  
MIDDLE COIL  
UPPER COIL

Material: Aluminum  
Light grey background  
Printings in bolt  
Thickness: 0.3mm

DATE	REV	E	V
21-Feb-05	0	CPD	AJF
13-Apr-05	1	CPD	AJF
06-May-05	2	CPD	AJF

REV.	REQUESTED BY	DATE	ALTERATIONS	CHECKED BY
2	AJF	06-May-05	As built	AJF
1	AJF	13-Apr-05	The serial number identification	AJF

TOLERANCES UNLESS OTHERWISE SPECIFIED									
> 0 - ≤ 51	±0.5	> 51 - ≤ 152	±1.5	> 152 - ≤ 305	±3.0				
> 305 - ≤ 915	±6.0	> 915 - ≤ 2032	±13.0	> 2032 -	±19.0				

CHECKED BY:	DRAWER:	DATE:	ISO SYMBOL	UNIT	WEIGHT	SCALE
AJF	CRISTIANO	13-July-04		mm	- kg	1:1

AREVA			AREVA ENERGIE&TECHNIK			CONTROL N° : 4 7 2 2 4 8 8 / 0 0 2		
CURRENT LIMITING REACTOR NAMEPLATE						DRAWING N° : D 0 5 9 0 4 1 / 0 0 2		