


NAPÁŤOVÁ SÚSTAVA/VOLTAGE SYSTEM:
3PEN~50Hz, 400V/TN-C-S
OCHRANA/PROTECTION:
SAMOČINNÝM ODPOJENÍM NAPÁJANIA
AUTOMATIC DISCONNECT FROM MAINS
PROSTREDIE/SURROUNDING:
3.1.1-ZÁKLADNÉ/BASIC (V OBJEKTOCH/IN OBJECTS)
4.1.1-VONKAŠIE/OUTDOOR

POZNÁMKA:
⊕ KABEL ULOŽENÝ V RAMCI PROJEKTU 03.EE-B (TANK FARM)

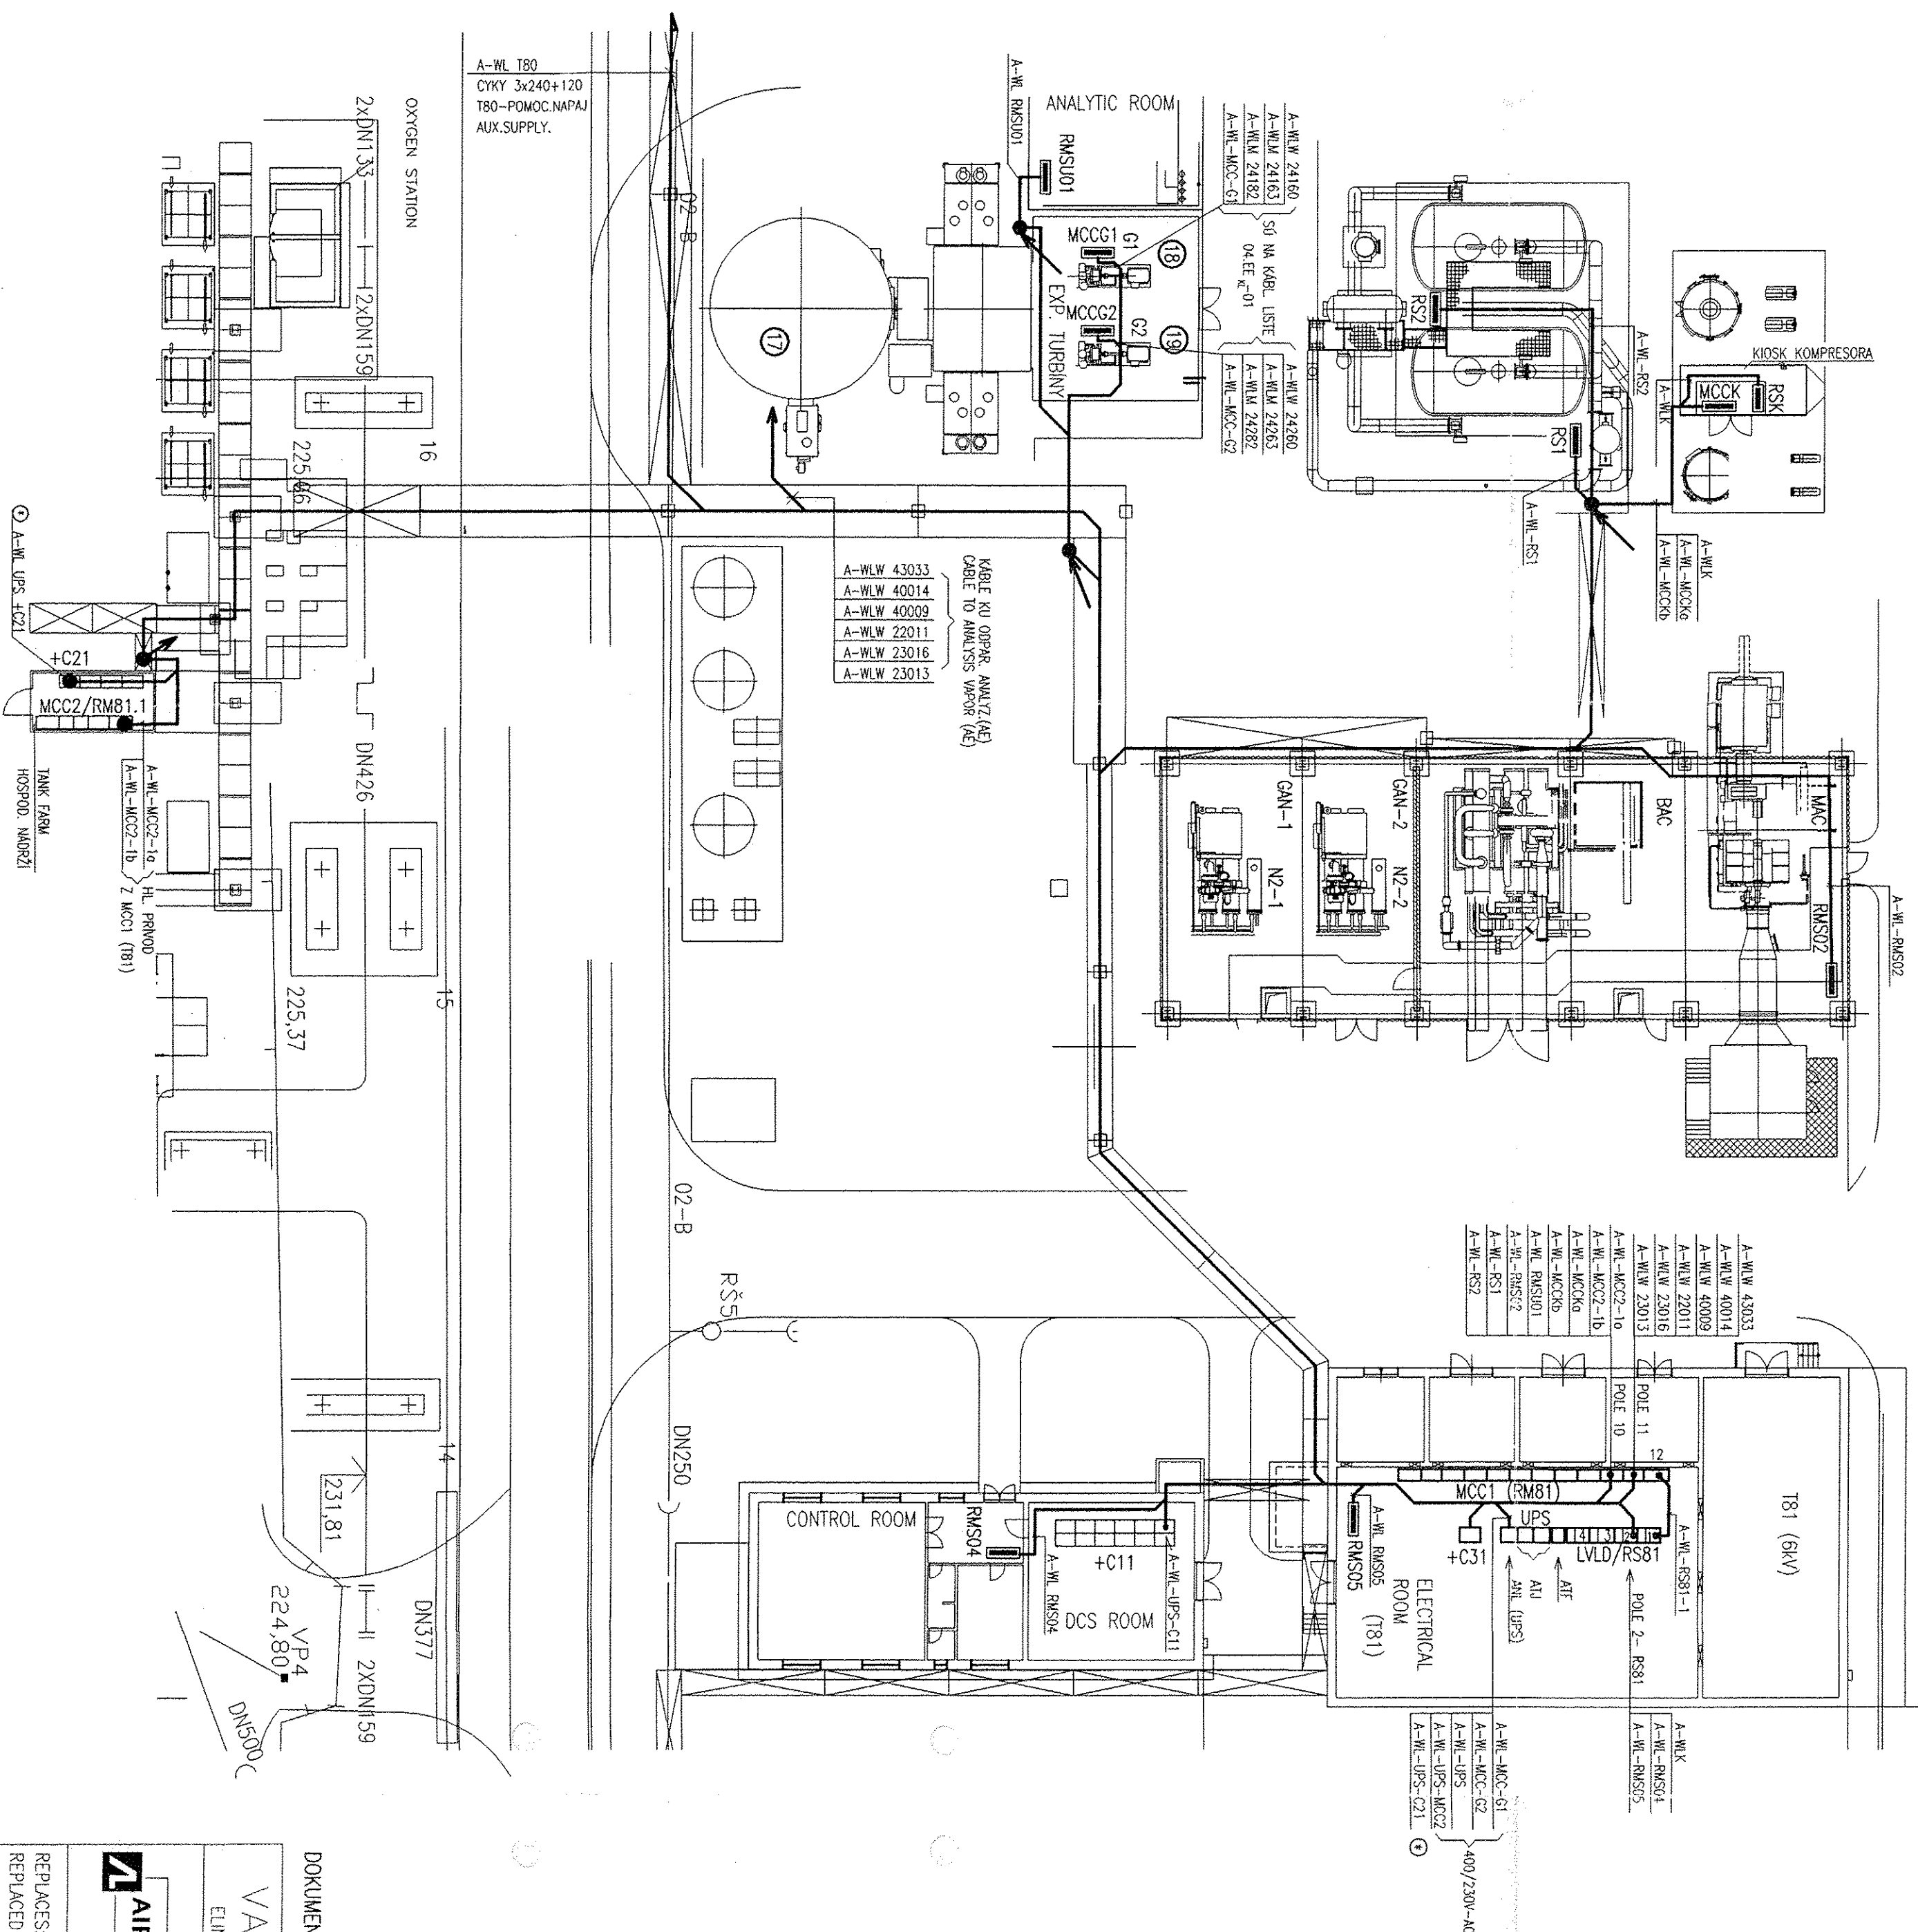

DOKUMENTÁCIA SKUTKOVÉHO STAVU- REVIZIA A

VATECH		AIR LIQUIDE	
EJIN EBG SR		TITLE:	
REV. DATE		JOB CODE: K70101	
NAME		REFERENCE: ASU No. 9 KOŠICE	
CHECKED		HLAVNÁ TECHNOLOGIA / MAIN TECHNOLOGY	
HISTORY FILE		SHEET: 003 OF 005 SHEETS	
SCALE 1:250		ORIGINAL FORMAT A2	
DR.NG: 04.EE-03-A -VATECH		DRAWING NO: 792.87794	
REV.		REPLACES: 79	
REPLACED BY: 79		Power supply to pannels and e. boxes- layout	