




ELCAD (R)		ASU Kosice		Circuit diagram LOX Pumps HS 61110, P&I 12		K.70101		= +C13	
c		date	21.07.2005						
b		made	Meis						
a	5.10.03	Kauwen	check						page 201
revision	date	name	stand.	replaced:		replaced:		C9792705-1	sh.

1	2	3	4	5	6	7	8
<div> <div>-DPS2_2_6</div> <div> <div>T 61140_1</div> <div>Bearing temp.</div> <div>P61100</div> </div> </div> <div> <div>AI 830</div> <div>PCS 2 Slave 2 Slot 6</div> <div>Input Ch2</div> </div> <div> <div>/25.6</div> <div>2P</div> <div>C2</div> <div>B2</div> <div>AZ</div> </div>							
<div> <div>Control cabinet</div> <div> <div> <div>-61101X1</div> <div>3c</div> <div>3d</div> <div>3e</div> <div>3f</div> <div>+C13</div> <div>3GV</div> <div>3BN</div> <div>E-C13-JB61101-1</div> <div>2x2x0.5mm²</div> </div> <div> <div>-X1</div> <div>19</div> <div>20</div> <div>21</div> <div>22</div> <div>S</div> </div> <div> <div>E-JB61101-TE61140</div> <div>2x2x0.5mm²</div> <div>BU</div> <div>RD</div> <div>GY</div> <div>YE</div> <div>S</div> </div> </div> <div> <div>Field</div> <div> <div>TE 61140</div> <div>Bearing temp.</div> <div>P61100</div> </div> <div> <div>PI100 DIN</div> <div>4</div> </div> </div> </div>							
<div> <div>ELCAD (R)</div> <div> <div>c</div> <div>date</div> <div>21.07.2005</div> </div> <div> <div>b</div> <div>made</div> <div>Mois</div> </div> <div> <div>a</div> <div>revision</div> <div>5.10.05</div> </div> <div> <div>date</div> <div>Kauwen</div> </div> <div> <div>name</div> <div>check</div> </div> <div> <div>date</div> <div>slind.</div> </div> <div> <div>replaced:</div> </div> <div> <div>replaced:</div> </div> <div> <div>ASU Kosice</div> </div> <div> <div> <div><input checked="" type="checkbox"/></div> <div>AIR LIQUIDE</div> <div>Air Liquide AGS GmbH</div> </div> <div>based:</div> </div> <div> <div>Circuit diagram</div> <div>LOX Pumps</div> <div>T 61140, P&I 12</div> </div> <div> <div>K.70101</div> <div>=</div> <div>-C13</div> </div> <div> <div>Page 203</div> <div>C9792705-1</div> <div>sh.</div> </div> </div>							

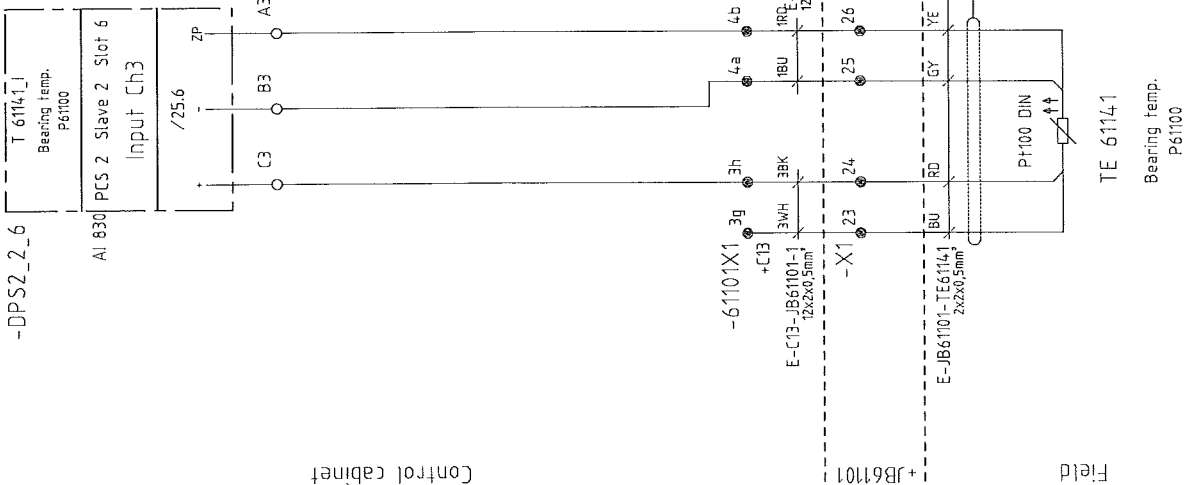

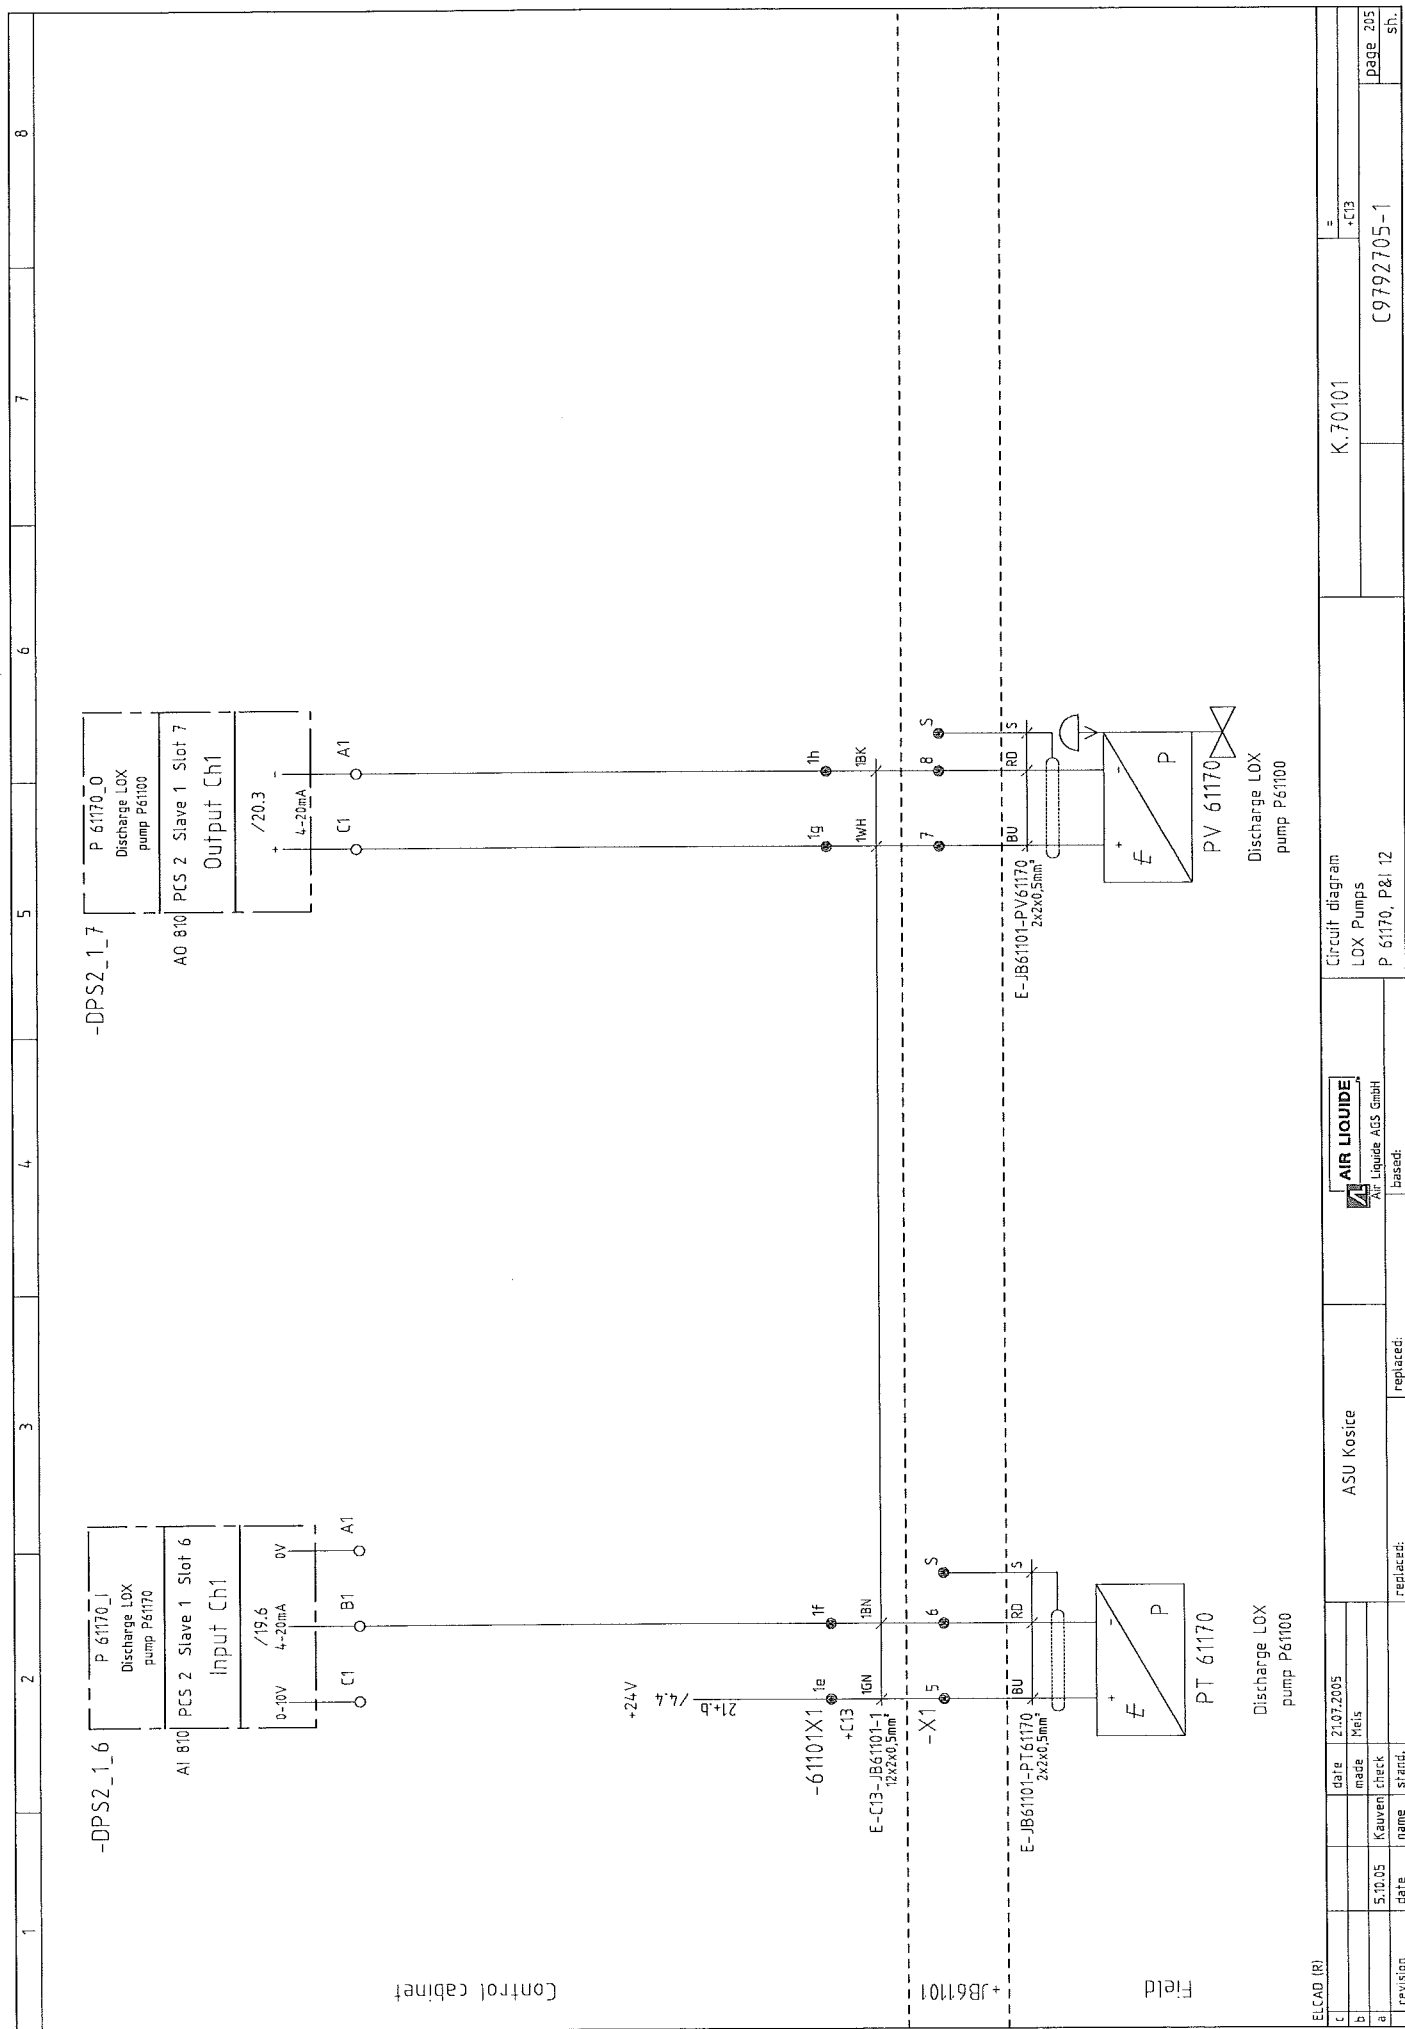

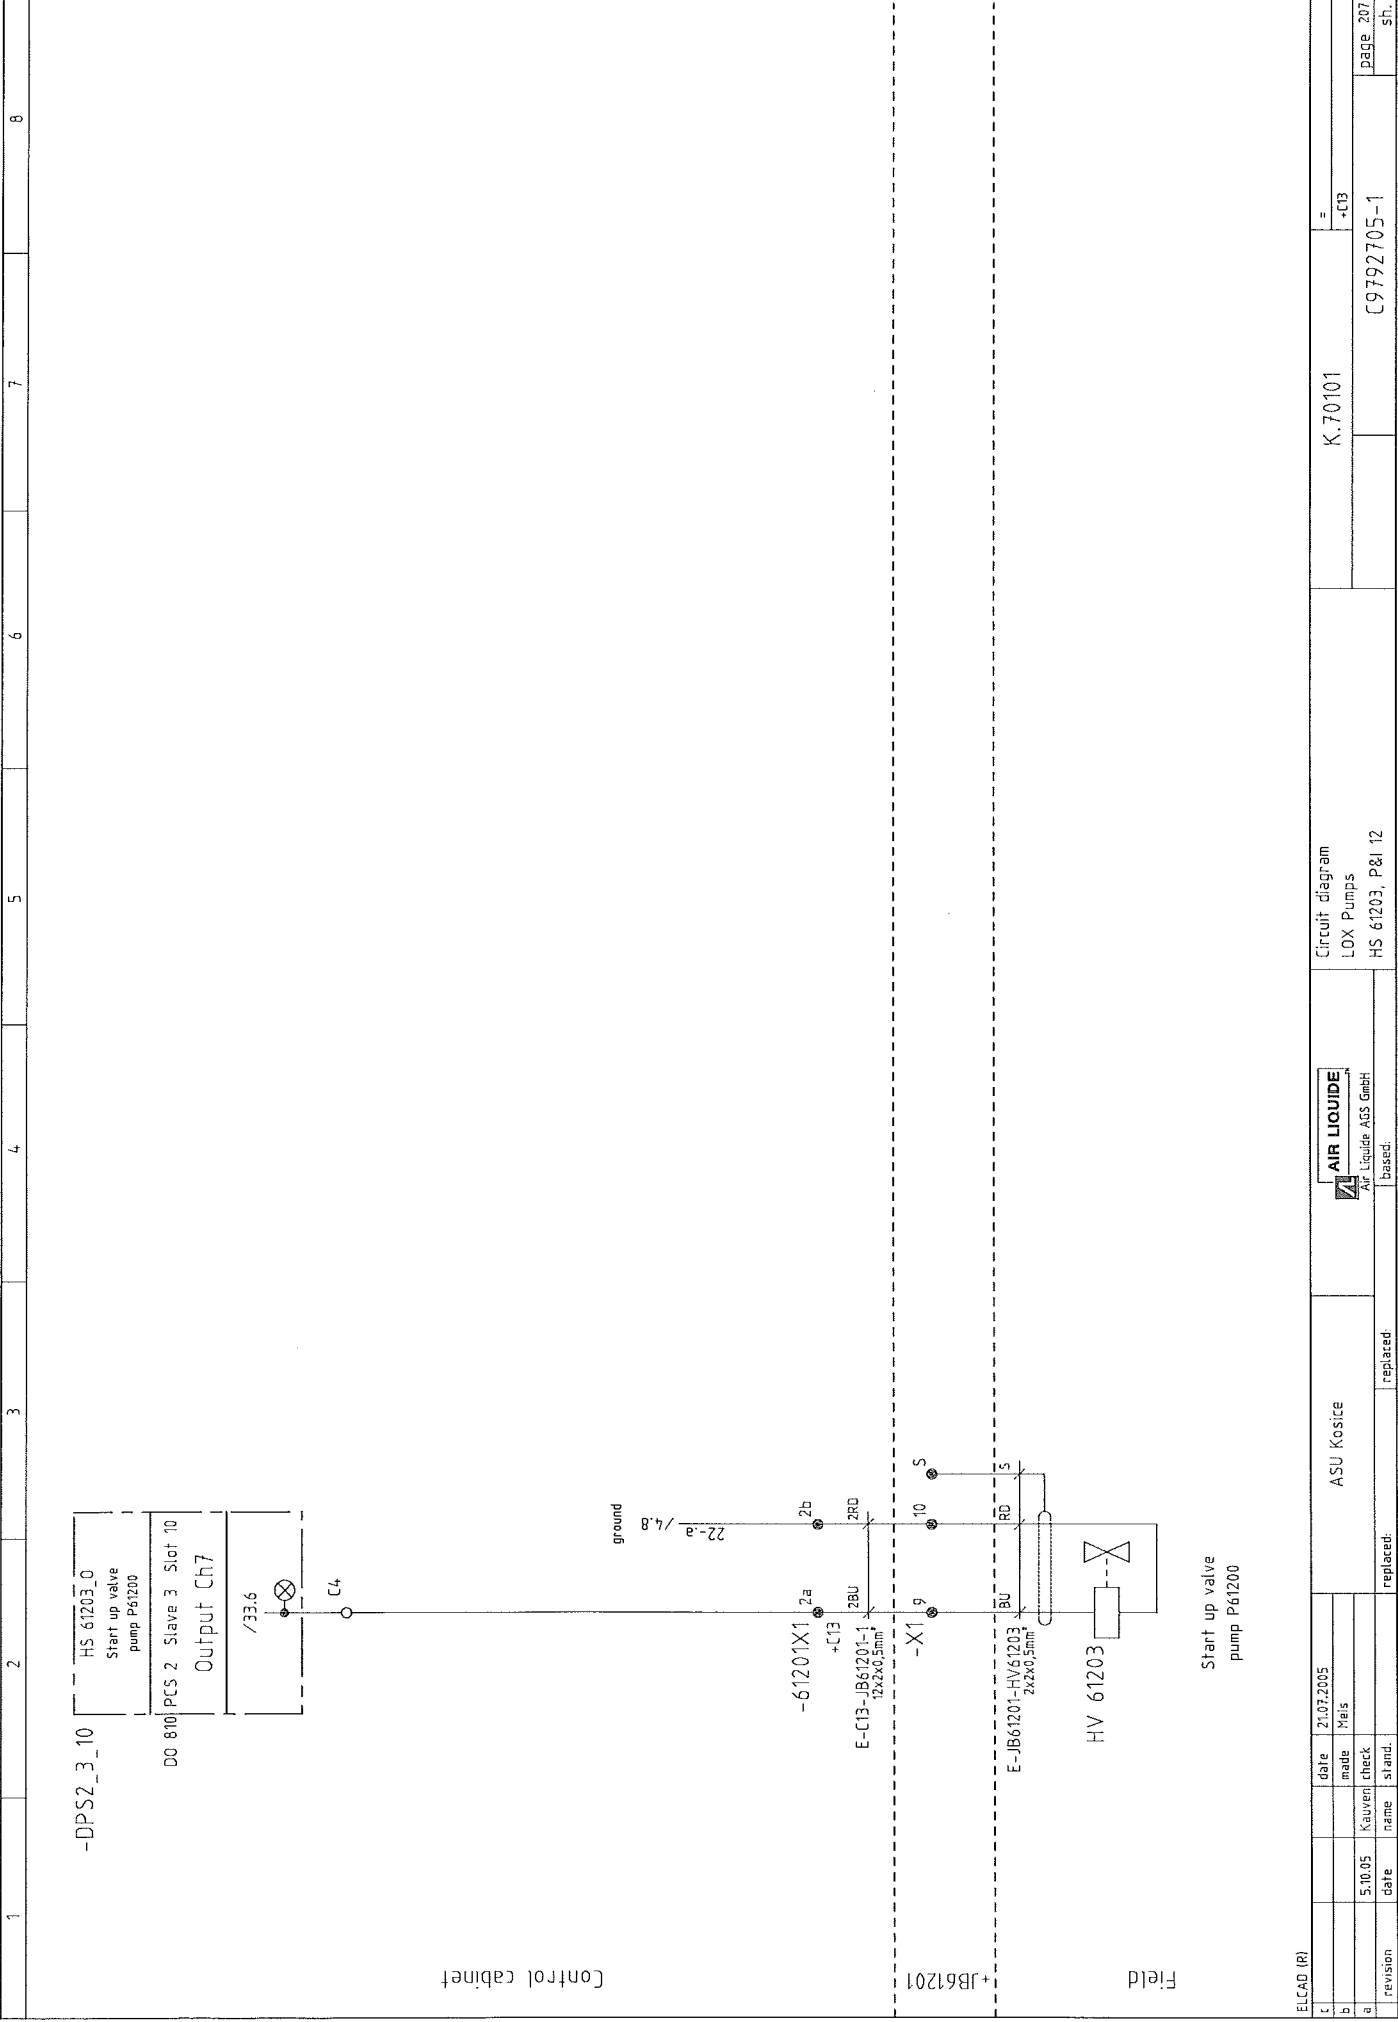

E/CAD (R)		ASU Kosice		Circuit diagram		K.70101		=	
c		date	21.07.2005		LOX Pumps			+C13	
b		made	Meis		HS 61203, P&I 12				
a	5.10.05	Kauveni	check						
revision	date	name	stand.	replaced:					
				replaced:					
C9792705-1								page 207	
								sh.	

-DPS2_2_6

T 61230_I

Cooling down temp.

P61200

AI 830

PCS 2 Slave 2 Slot 6

Input Ch4

/25.6

ZP

C4

B4

A4

-61201X1

2g

2h

3a

3b

3BU

3BD

+C13

2NH

2BK

E-C13-JB61201-1

12x2x0.5mm

-X1

15

16

17

18

5

E-JB61201-TE61230

2x2x0.5mm

BU

RD

GY

YE

IS

PT100 DIN

TE 61230

Cooling down temp.

P61200

Control cabinet

Field

+JB61201

ELCAD (R)

c

b

a

revision

date

5:10.05

name

stand.

Kauern check

date

21.07.2005

Neis

ASU Kosice

replaced:

replaced:

AIR LIQUIDE

Air Liquide ACS GmbH

based:

Circuit diagram
LOX Pumps
T 61230, P&I 12

K.70101


=

-C13

C9792705-1

page 209

sh.

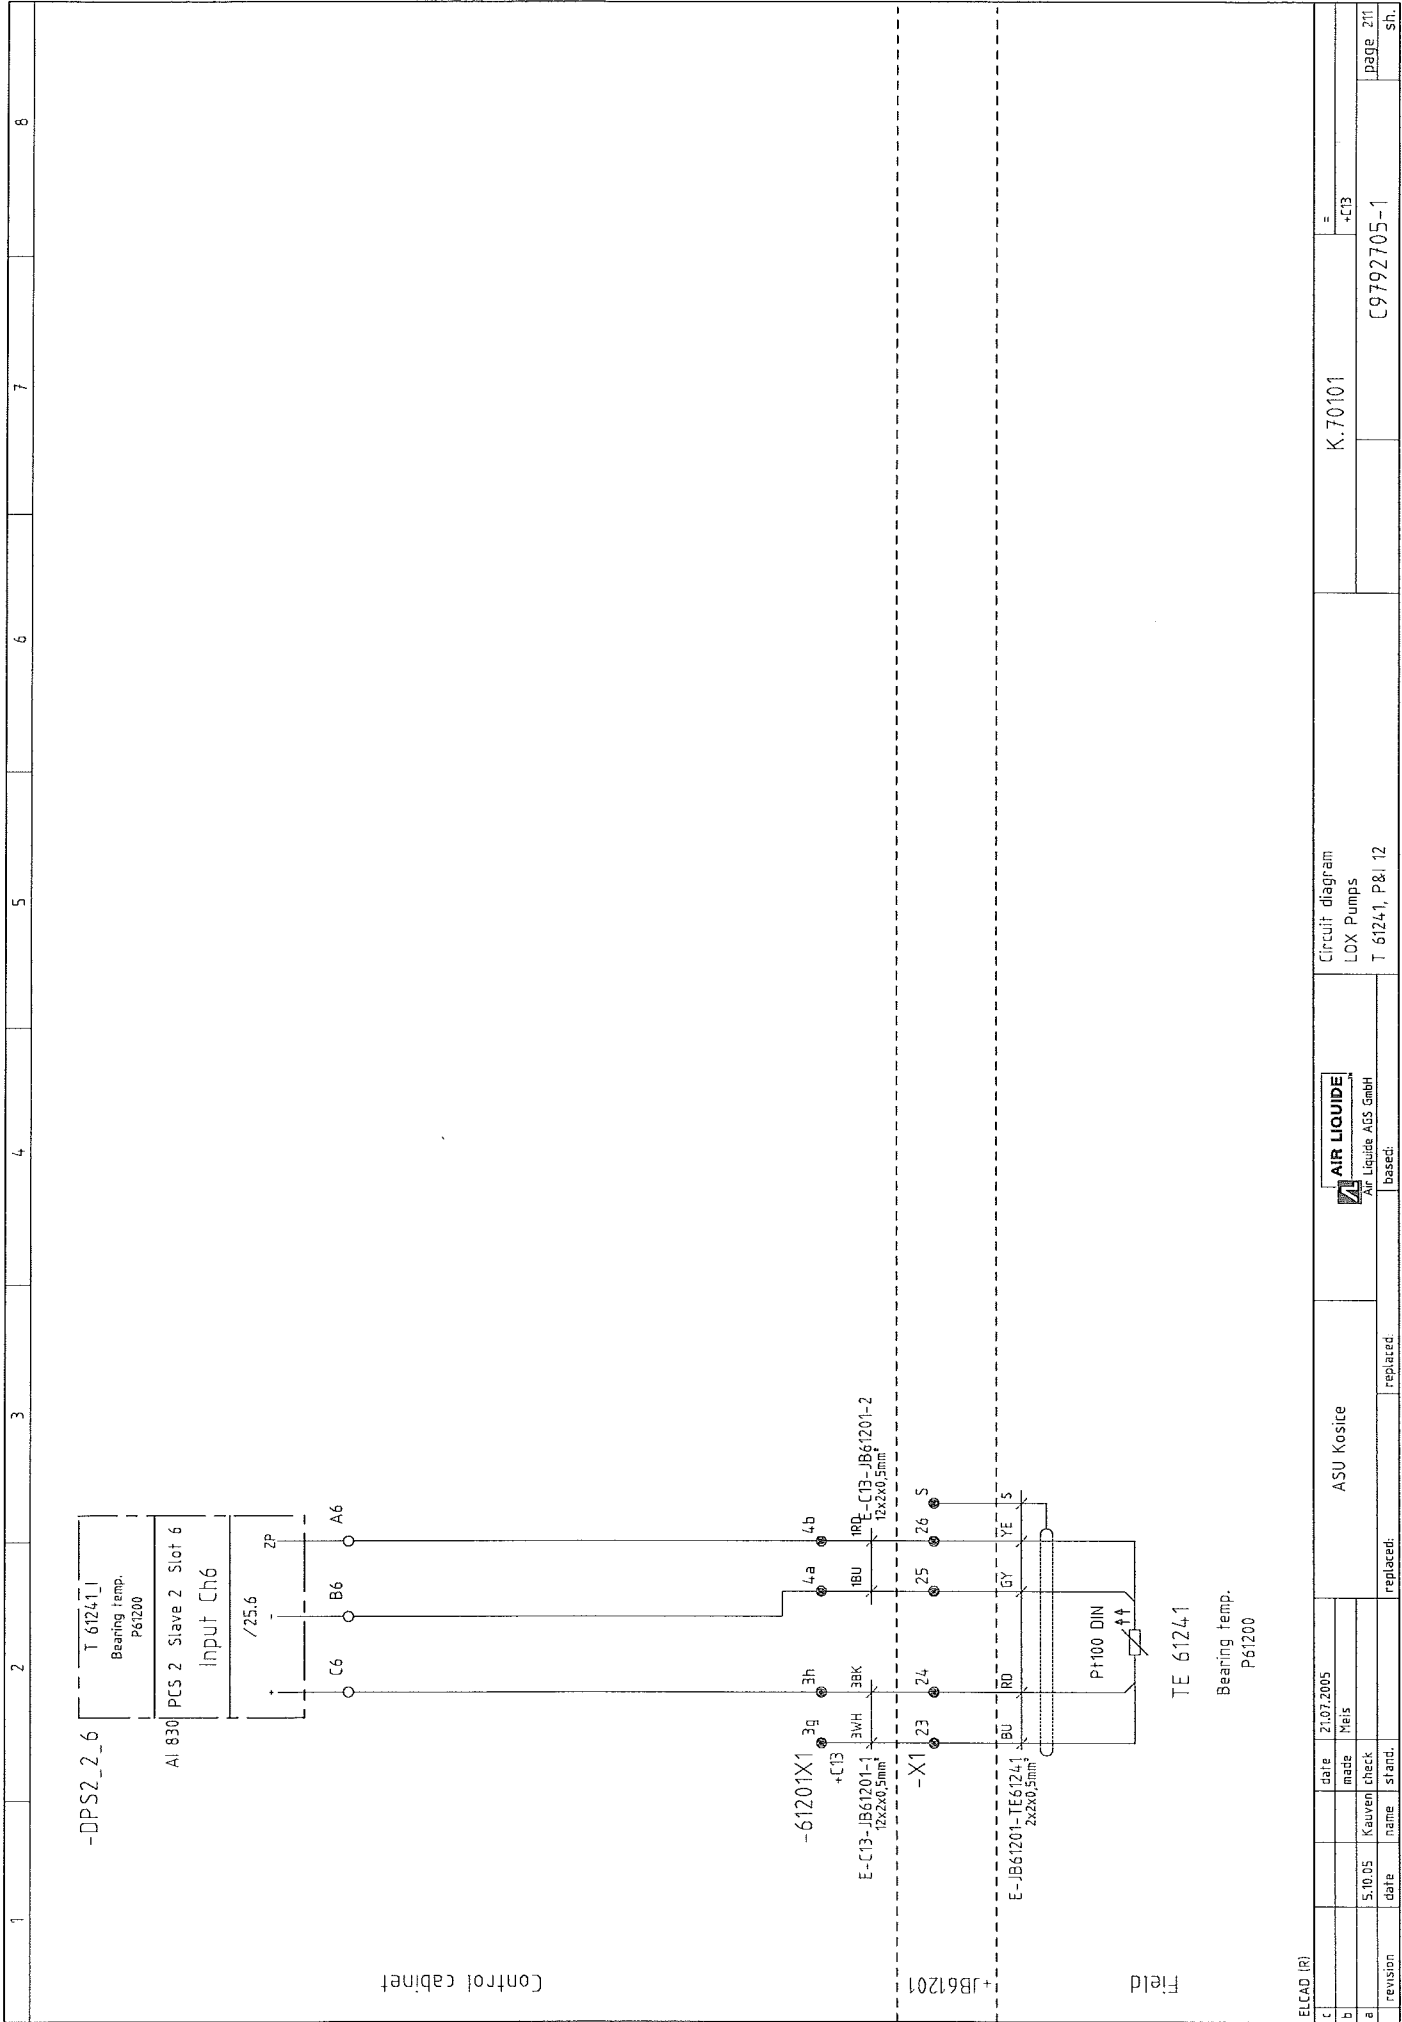


revision	date	name	stand.	replaced.
a	5.10.05	Kauven	check	
b		made	Yes	
c	21.07.2005	date		

ASU Kostice	replaced.
AIR LIQUIDE	
Air Liquide AGS GmbH	
based:	


Circuit diagram	LOX Pumps	T 61270, P&I 12
K.70101		


page 212	sh
C9792705-1	



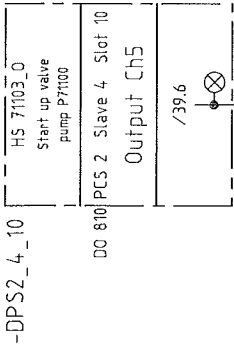


Control cabinet

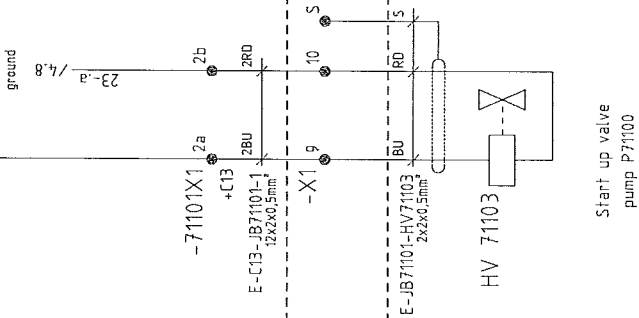


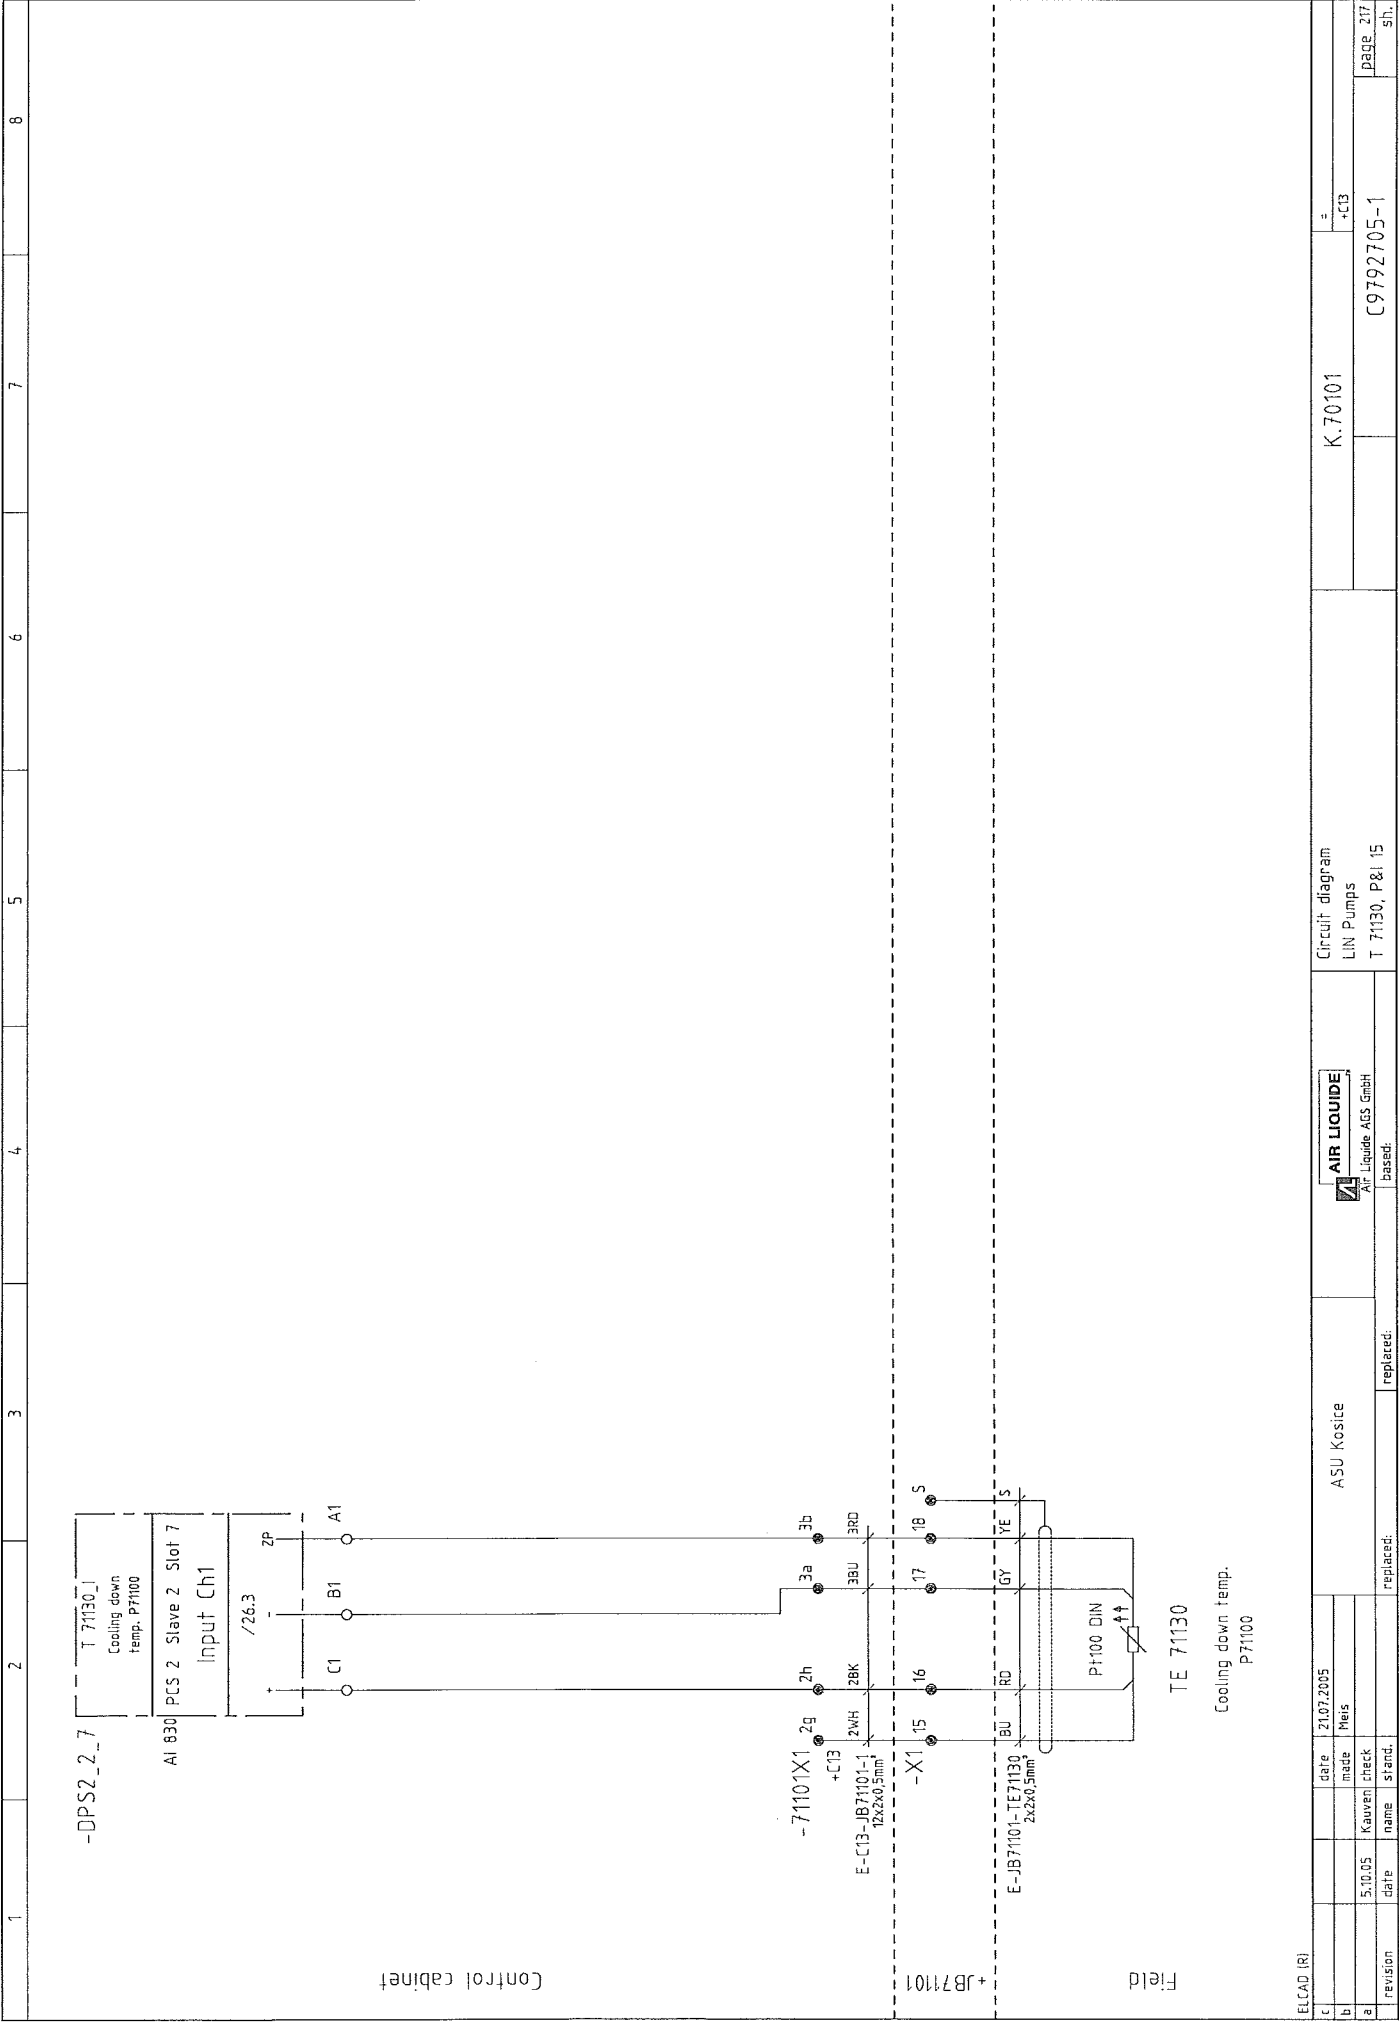


ELCAD (R)		ASU Kosice		Circuit diagram LIN Pumps T 71130, P&I 15		K.70101		C9792705-1		page 217 sh.		
c		date	21.07.2005									
b		made	Meis									
a	5.10.05	date	Kauwen	check								
	revision	name	stand.	replaced:								
				replaced:								
				based:								

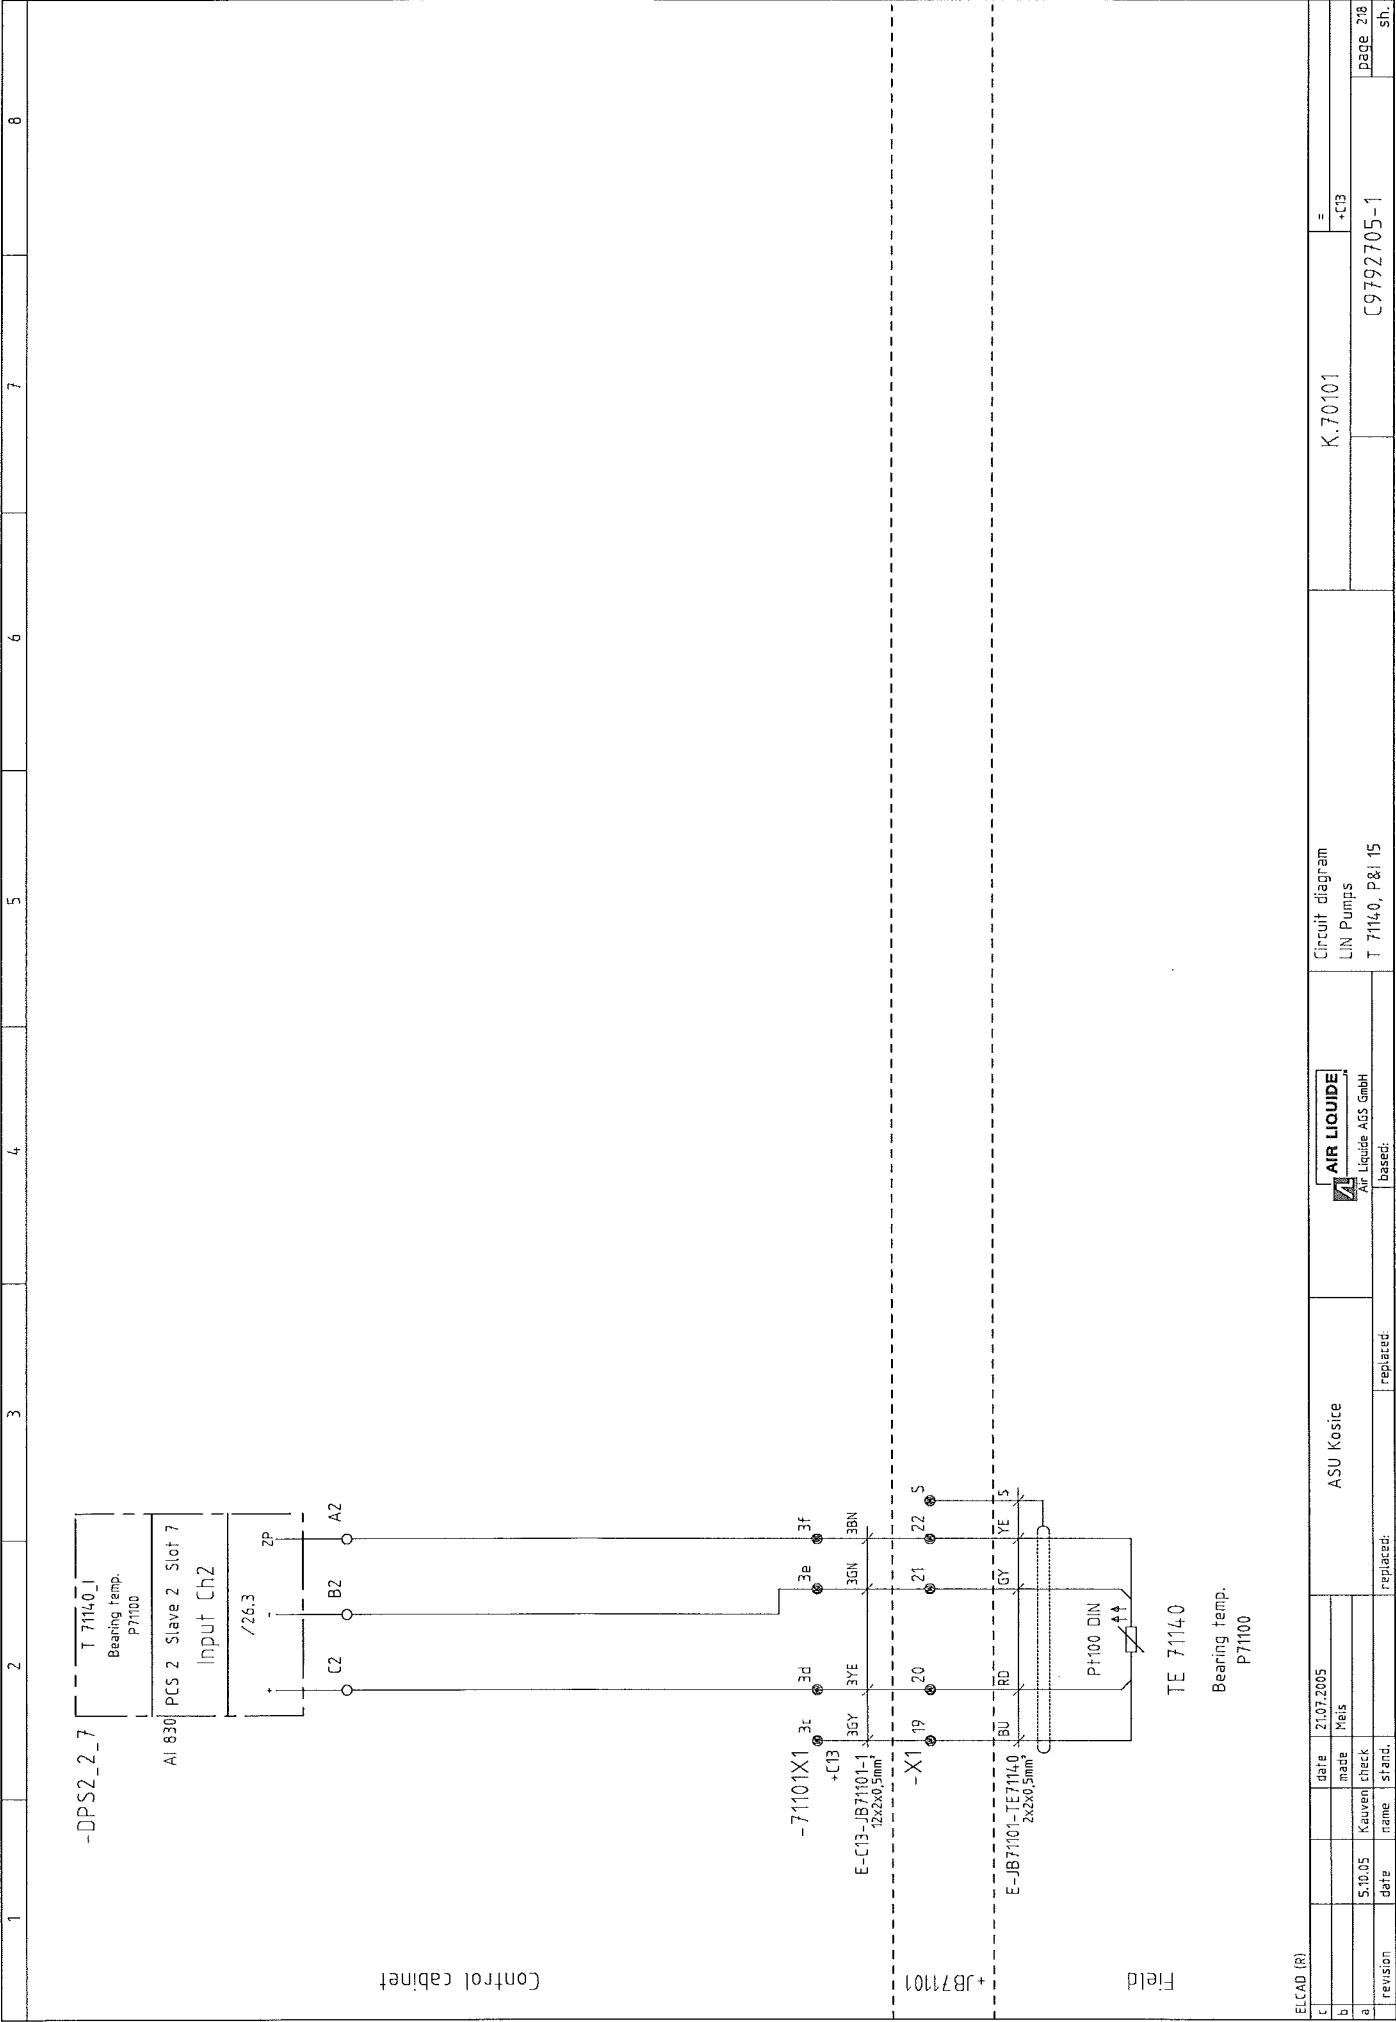

ELCAD (R)		ASU Kosice		Circuit diagram LIN Pumps T 7114.0, P&I 15		K.70101		=		+C13	
c		date	21.07.2005								
b		made	Mels								
a	5.10.05	Kauwen	check								
revision		date		replaced:		replaced:		C9792705-1		Page 218	
		name	stand.							sh.	

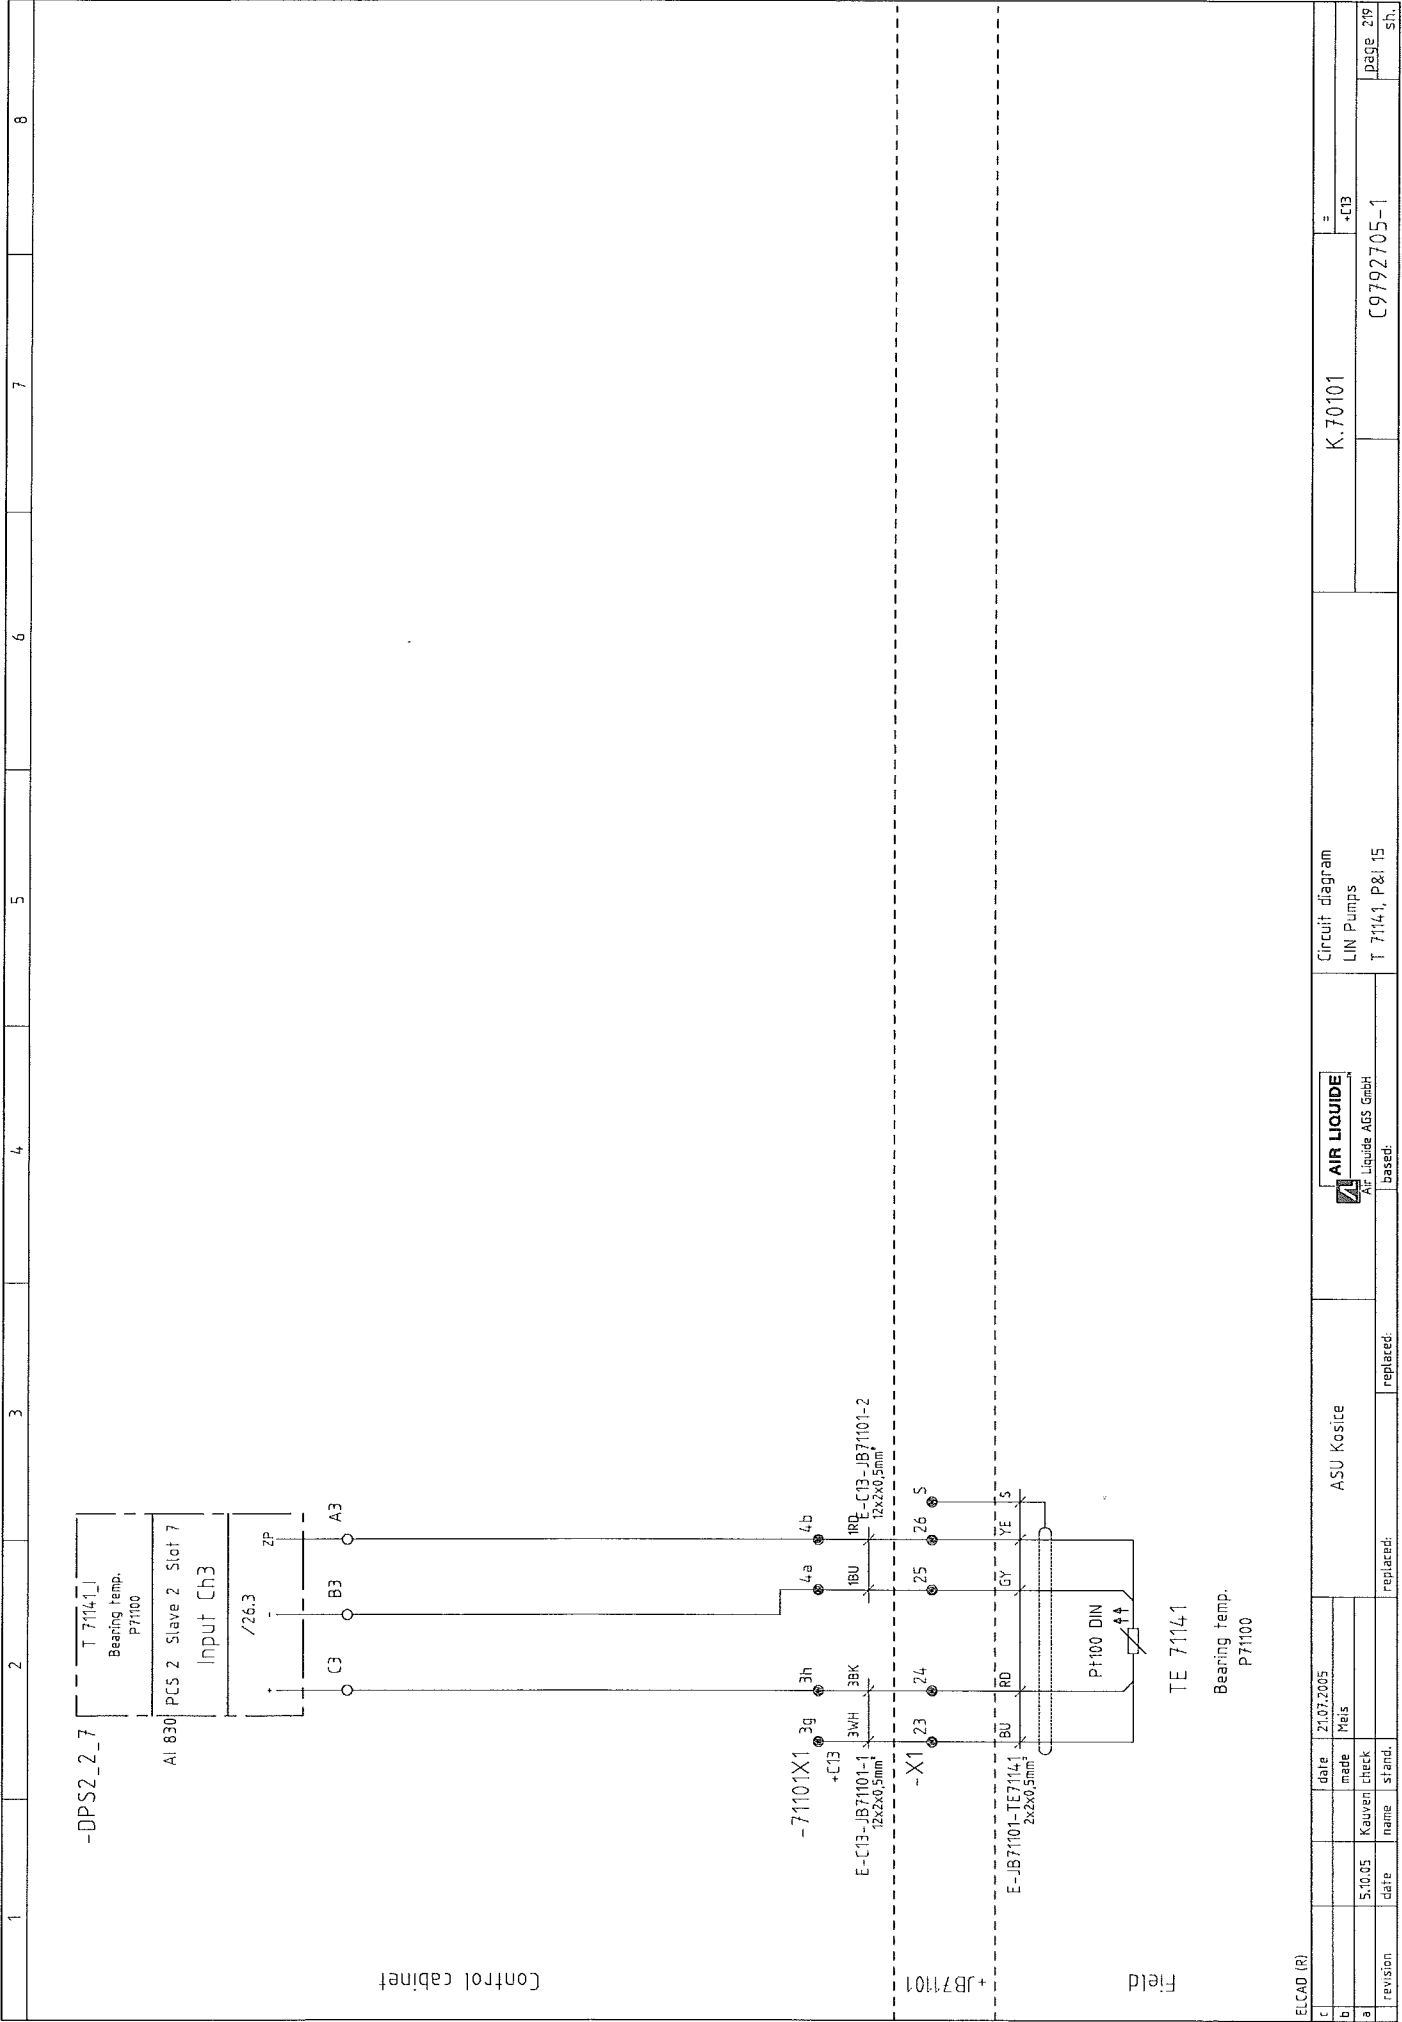

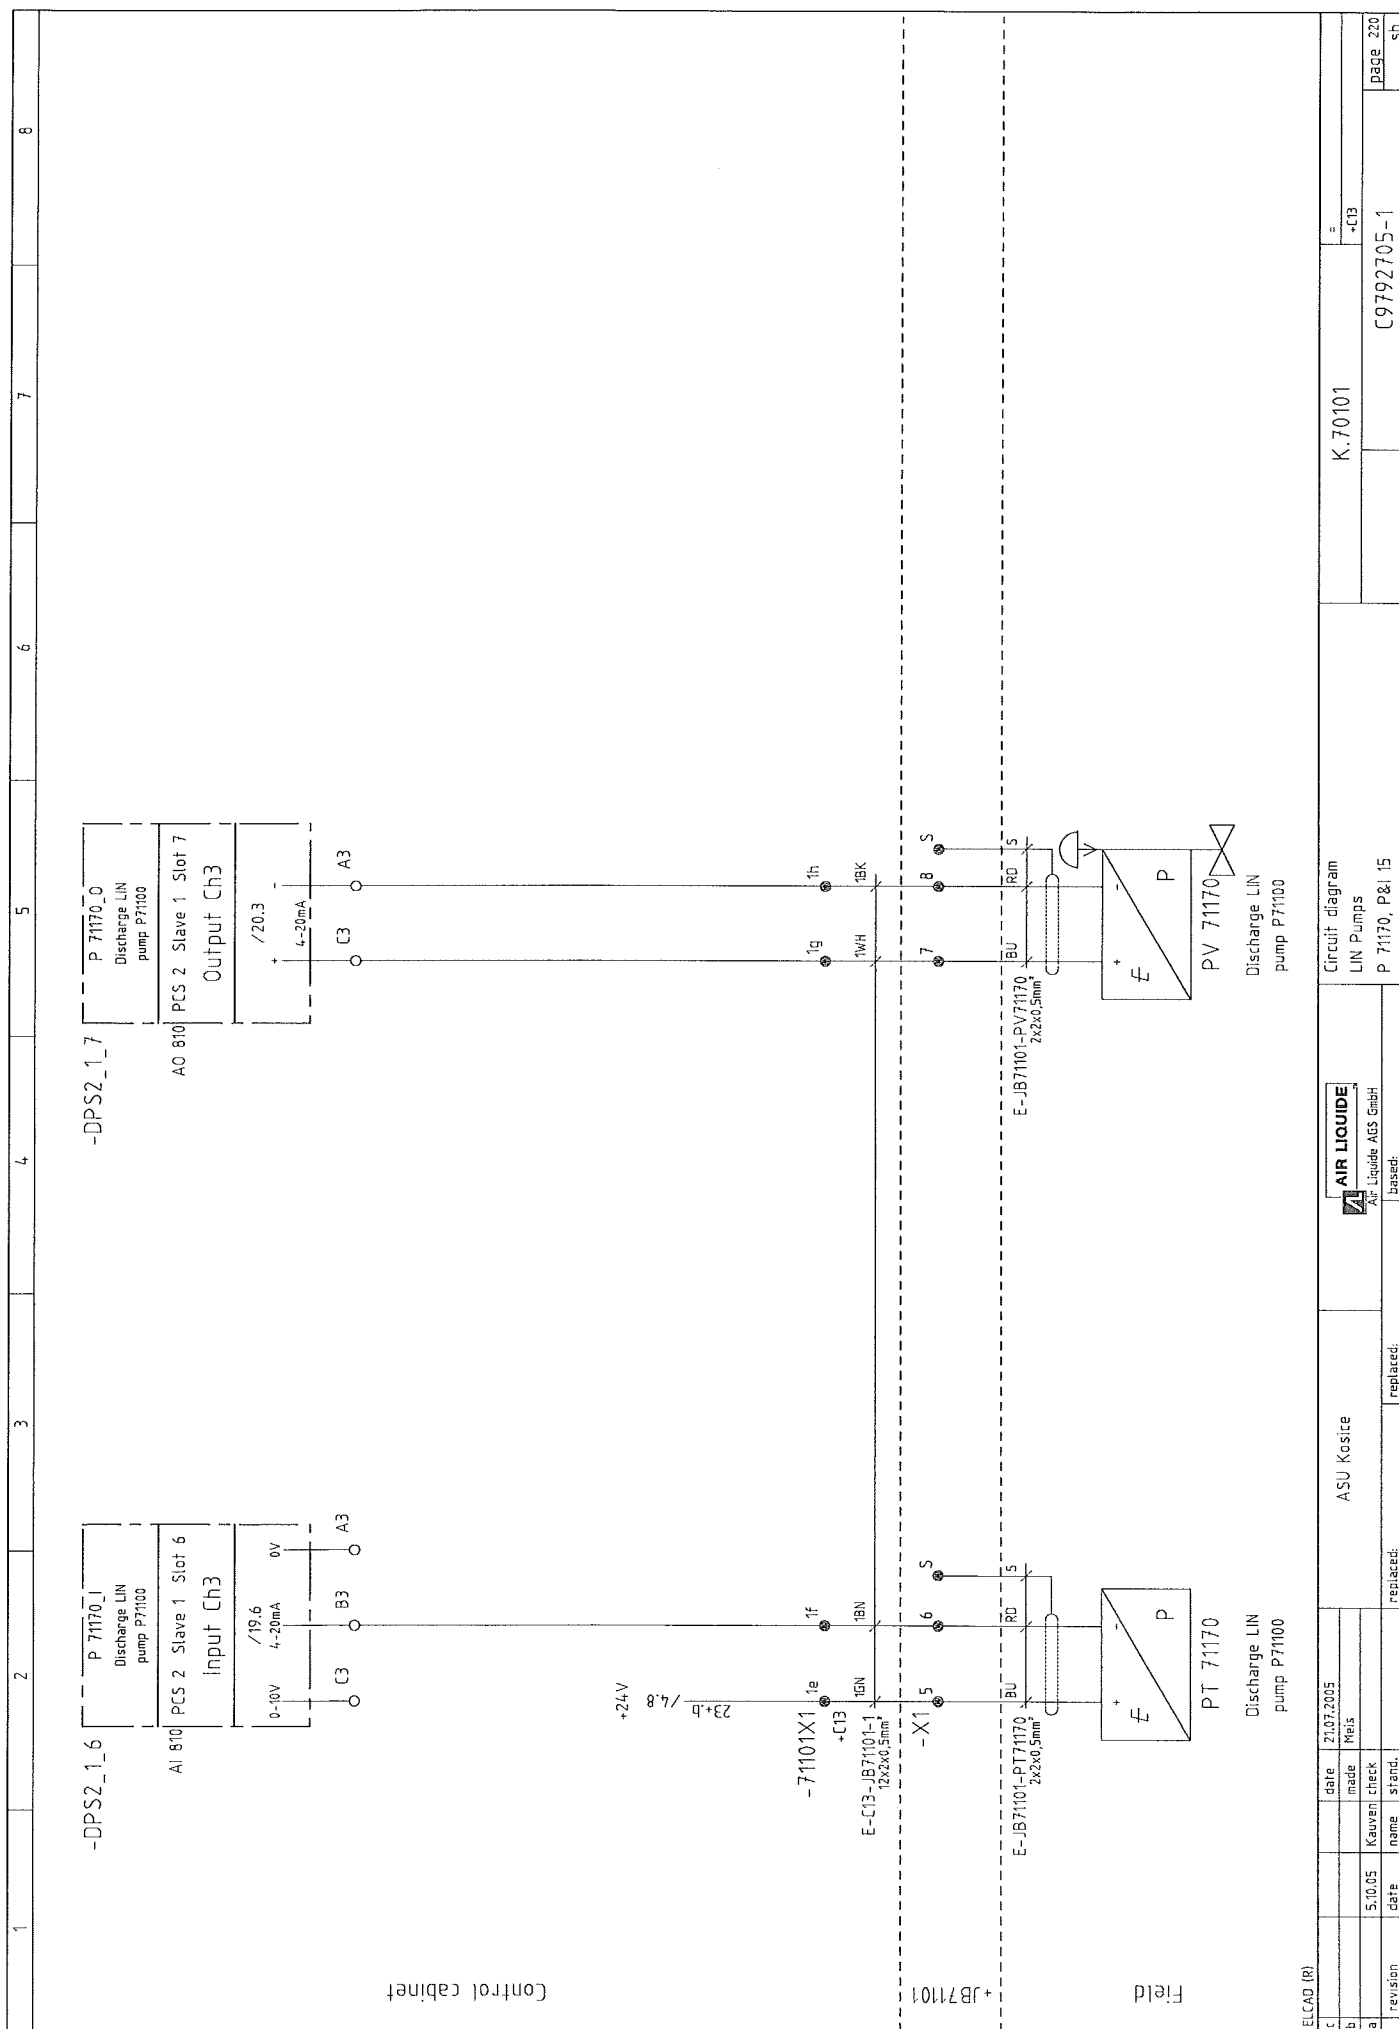

The diagram illustrates the electrical connections for a LIN Pump assembly. It is divided into two main sections: the Control cabinet and the Field.












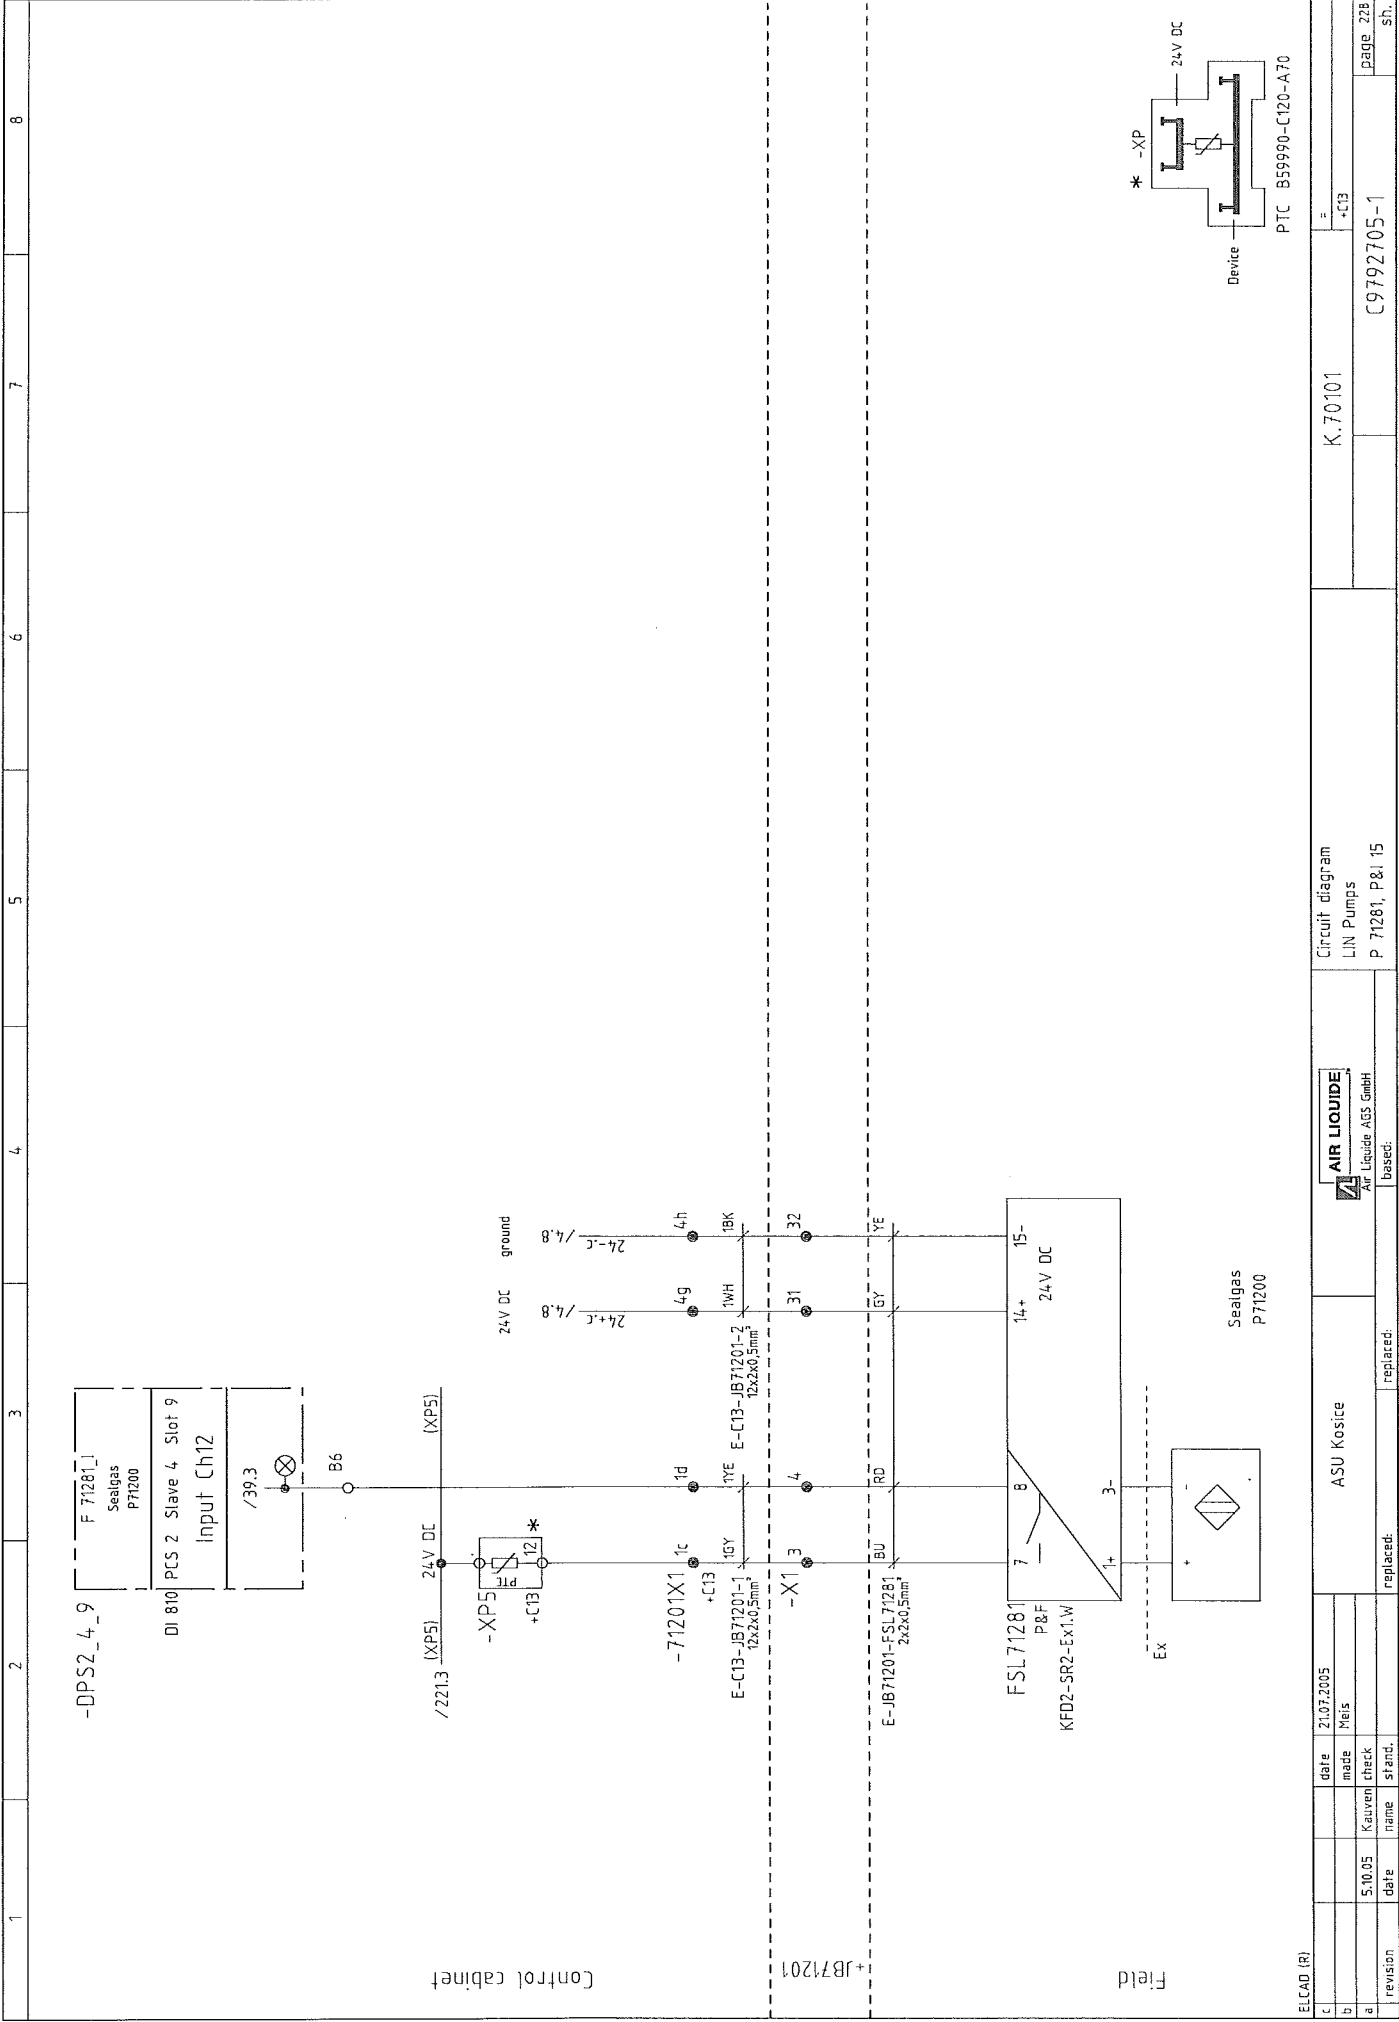

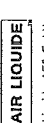1	2	3	4	5	6	7	8																								
<div style="display: flex; justify-content: space-between;"> <div> <div>ELCAD (R)</div> <table border="1"> <tr> <td>c</td> <td></td> <td></td> <td>date</td> <td>21.07.2005</td> <td></td> <td></td> <td></td> </tr> <tr> <td>b</td> <td></td> <td></td> <td>made</td> <td>Yes</td> <td></td> <td></td> <td></td> </tr> <tr> <td>a</td> <td>revision</td> <td>date</td> <td>name</td> <td>check</td> <td>replaced:</td> <td>replaced:</td> <td></td> </tr> </table> </div> <div> <div>ASU Kosite</div> <div> <div>  <div> <div>AIR LIQUIDE</div> <div>Air Liquide ABS GmbH</div> </div> </div> <div>based:</div> </div> </div> <div> <div>Circuit diagram</div> <div>Spare</div> </div> <div> <div>K.70101</div> <div> <div>=</div> <div>+C13</div> </div> </div> </div> <div> <div>C9792705-1</div> <div>sh.</div> </div> <div> <div>page 232</div> </div>								c			date	21.07.2005				b			made	Yes				a	revision	date	name	check	replaced:	replaced:	
c			date	21.07.2005																											
b			made	Yes																											
a	revision	date	name	check	replaced:	replaced:																									

ELCAD (R)		date	21.07.2005	ASU Kosice	Circuit diagram		K.70101		page 235
c	made	made	Mels		Emergency stop				sh.
b	5.10.05	Kauren check			H 92002				C9792705-1
a	revision	date	name	replaced:	replaced:	based:			

[illegible]

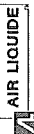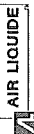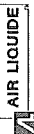
1	2	3	4	5	6	7	8	
<div style="display: flex; justify-content: space-between;"> <div> <div>ELCAD (R)</div> <table border="1"> <tr> <td>c</td><td></td><td></td><td></td><td></td><td></td><td></td><td></td></tr> <tr> <td>b</td><td></td><td></td><td></td><td></td><td></td><td></td><td></td></tr> <tr> <td>a</td><td>revision</td><td>date</td><td>name</td><td></td><td></td><td></td><td></td></tr> </table> </div> <div> <table border="1"> <tr> <td>date</td><td>21.07.2005</td></tr> <tr> <td>made</td><td>Meis</td></tr> <tr> <td>check</td><td></td></tr> <tr> <td>stand.</td><td></td></tr> </table> </div> <div> <table border="1"> <tr> <td colspan="2">ASU Kosice</td> </tr> </table> </div> <div> <table border="1"> <tr> <td colspan="2">  <div> <div>AIR LIQUIDE</div> <div>Air Liquide AGS GmbH</div> </div> </td> </tr> </table> </div> <div> <table border="1"> <tr> <td colspan="2">Circuit diagram</td> </tr> <tr> <td>Spare</td><td></td></tr> </table> </div> <div> <table border="1"> <tr> <td>K.70101</td><td>=</td></tr> <tr> <td></td><td>*C3</td></tr> </table> </div> <div> <table border="1"> <tr> <td>C9792705-1</td><td>page 237</td></tr> <tr> <td></td><td>sh.</td></tr> </table> </div> </div>								c								b								a	revision	date	name					date	21.07.2005	made	Meis	check		stand.		ASU Kosice		 <div> <div>AIR LIQUIDE</div> <div>Air Liquide AGS GmbH</div> </div>		Circuit diagram		Spare		K.70101	=		*C3	C9792705-1	page 237		sh.
c	
b	
a	revision	date	name	
date	21.07.2005	
made	Meis	
check	
stand.	
ASU Kosice	
 <div> <div>AIR LIQUIDE</div> <div>Air Liquide AGS GmbH</div> </div>	
Circuit diagram	
Spare	
K.70101	=	
	*C3	
C9792705-1	page 237	
	sh.	

1	2	3	4	5	6	7	8
---	---	---	---	---	---	---	---

ELCAD (R)		date		21.07.2005		ASU Kosice		Circuit diagram		K.70101		=		-C13		page 238	
c			date	made	Heis												
b			check														
a			name	date	replaced:												
revision																	sh.



[illegible]

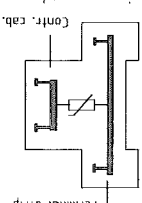ELCAD (R)		Date	21.07.2005	ASU Kosice		AIR LIQUIDE Air Liquide AES GmbH based:		Terminal connecting plan		K.70101	=	-CTB	page 245 sch
a	As built revision	24.11.06 date	Kauven name	check stand.	replaced:	replaced:							C9792705-1
 <p>PTC B59990-C120-A70</p> <p>Gerätekommentar device comments</p>		<p>Gerätekommentar device comments</p>											
<p>Anschriftbezeichnung terminal marking</p> <p>Gerätebezeichnung device marking</p>		<p>Anschriftbezeichnung terminal marking</p> <p>Gerätebezeichnung device marking</p>											
<p>Darstellungsort refer</p>		<p>Darstellungsort refer</p>											
<p>Drahtverbindung wiring</p>		<p>Drahtverbindung wiring</p>											
<p>Klemmenkommentar terminal comment</p> <p>Laschenverbindung fishing</p> <p>Klemmennummer terminal number</p>		<p>Klemmenkommentar terminal comment</p> <p>Laschenverbindung fishing</p> <p>Klemmennummer terminal number</p>											
<p>Anschriftbezeichnung terminal marking</p> <p>Gerätebezeichnung device marking</p>		<p>Anschriftbezeichnung terminal marking</p> <p>Gerätebezeichnung device marking</p>											
<p>Kabelbezeichnung / wiring marking</p>		<p>Kabelbezeichnung / wiring marking</p>											
<p>1</p>		<p>1</p>											
<p>2</p>		<p>2</p>											
<p>3</p>		<p>3</p>											
<p>4</p>		<p>4</p>											
<p>5</p>		<p>5</p>											
<p>6</p>		<p>6</p>											
<p>7</p>		<p>7</p>											
<p>8</p>		<p>8</p>											
<p>9</p>		<p>9</p>											
<p>10</p>		<p>10</p>											
<p>11</p>		<p>11</p>											
<p>12</p>		<p>12</p>											
<p>13</p>		<p>13</p>											
<p>14</p>		<p>14</p>											
<p>15</p>		<p>15</p>											
<p>16</p>		<p>16</p>											
<p>total 16 Terminals</p>		<p>total 16 Terminals</p>											
<p>Strip: -XP4</p>		<p>Strip: -XP4</p>											
<p>105.4</p>		<p>105.4</p>											
<p>14F2</p>		<p>14F2</p>											
<p>2</p>		<p>2</p>											
<p>C11</p>		<p>C11</p>											

ELCAD (R)					
c	Date made	21.07.2005			
b	Kauvert name	Melis			
a	revision date	5.10.05			
replaced:			replaced:		
ASU Kosice			AIR LIQUIDE Air Liquide AGS GmbH based:		
Terminal connecting plan			-20002X1		
K.70101			= +C13		
			page 248 sh.		
			C9792705-1		

