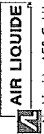


1	2	3	4	5	6	7	8
<div> <div> <div>ELCAD (R)</div> <div> <div> <div>c</div> <div>b</div> <div>a</div> </div> <div> <div>date</div> <div>made</div> <div>check</div> </div> <div> <div>name</div> <div>date</div> <div>revision</div> </div> </div> <div> <div>21.07.2005</div> <div>Meis</div> <div></div> </div> <div> <div>ASU Kosice</div> <div></div> <div></div> </div> <div> <div> <div> <div>AIR LIQUIDE</div> <div> <div></div> <div>Air Liquide AGS GmbH</div> </div> </div> <div>based:</div> </div> </div> <div> <div>Circuit diagram</div> <div>Spare</div> </div> <div> <div>K.70101</div> <div> <div>=</div> <div>+C16</div> </div> </div> <div> <div>D9792705-1</div> <div> <div>page 42</div> <div>sh.</div> </div> </div> </div> </div>							

[illegible]

1	2	3	4	5	6	7	8	
<div>ELCAD (R)</div> <table border="1"> <tr> <td>c</td> <td>date</td> <td>21.07.2005</td> <td colspan="2">ASU Kosite</td> <td colspan="2">Circuit diagram</td> <td>K.70101</td> <td>=</td> </tr> <tr> <td>b</td> <td>made</td> <td>Heis</td> <td colspan="2"></td> <td colspan="2"></td> <td></td> <td>+CIV</td> </tr> <tr> <td>a</td> <td>revision</td> <td></td> <td>name</td> <td>replaced:</td> <td>replaced:</td> <td>replaced:</td> <td></td> <td></td> </tr> <tr> <td></td> <td>date</td> <td></td> <td></td> <td></td> <td></td> <td></td> <td></td> <td></td> </tr> <tr> <td></td> <td></td> <td></td> <td></td> <td></td> <td></td> <td></td> <td></td> <td></td> </tr> </table> <div> <div>  AIR LIQUIDE <small>Air Liquide AGS GmbH</small> </div> <div> based: Spare </div> </div> <div>D9792705-1</div> <div> page 44 sh. </div>								c	date	21.07.2005	ASU Kosite		Circuit diagram		K.70101	=	b	made	Heis						+CIV	a	revision		name	replaced:	replaced:	replaced:				date																
c	date	21.07.2005	ASU Kosite		Circuit diagram		K.70101	=	
b	made	Heis						+CIV	
a	revision		name	replaced:	replaced:	replaced:	
	date	

The diagram illustrates the electrical connection between a control cabinet and a field. The control cabinet section includes a power supply unit (-DPS3_1_6), a temperature sensor (T 11007_I), a pressure sensor (AI 830), and a relay (E-C14). The field section includes a temperature sensor (TE 11007) and a pressure sensor (PT100 DIN). The wiring for the temperature sensor (3e, 3f, 3g, 3h) and the pressure sensor (1, 2, 3, S) is shown, including the connection to the relay (E-C14) and the power supply.













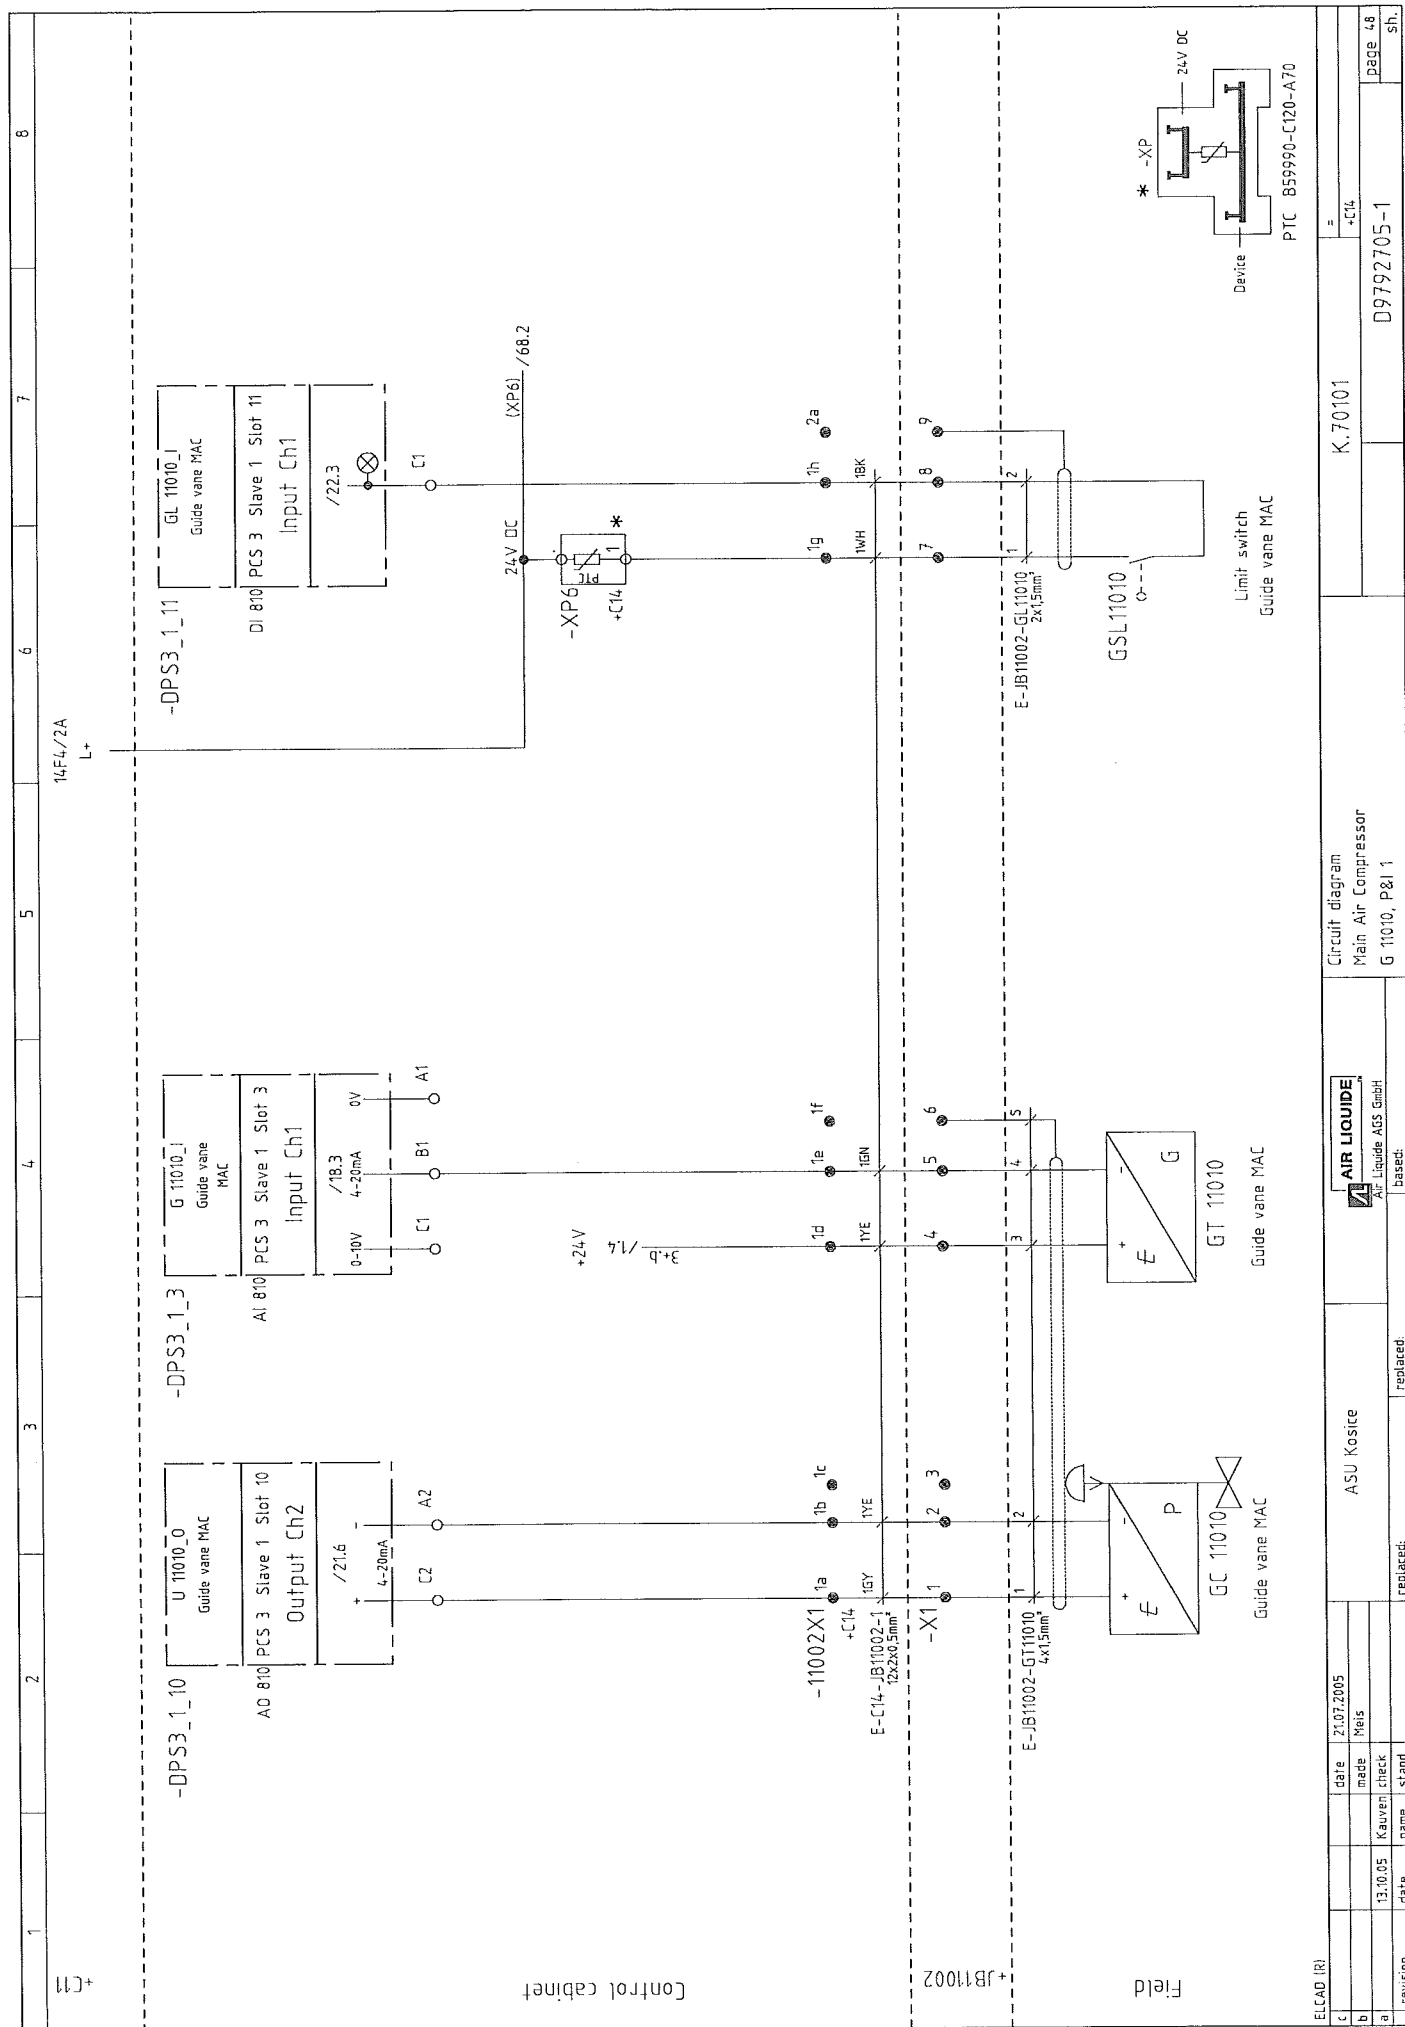


ELCAD (R)		date	21.07.2005	ASU Kosice	AIR LIQUIDE		Circuit diagram		K.70101		=	
c	made	13.10.05	Kauven check	replaced:	Air Liquide AGS GmbH		Main Air Compressor		D9792705-1		+C14	
b	name	13.10.05	Kauven check	replaced:	Air Liquide AGS GmbH		T 11011, P&I 1		D9792705-1		+C14	
a	stand.	13.10.05	Kauven check	replaced:	Air Liquide AGS GmbH		T 11011, P&I 1		D9792705-1		+C14	
revisio		date	name	stand.	based:		page 49		sh.		page 49	

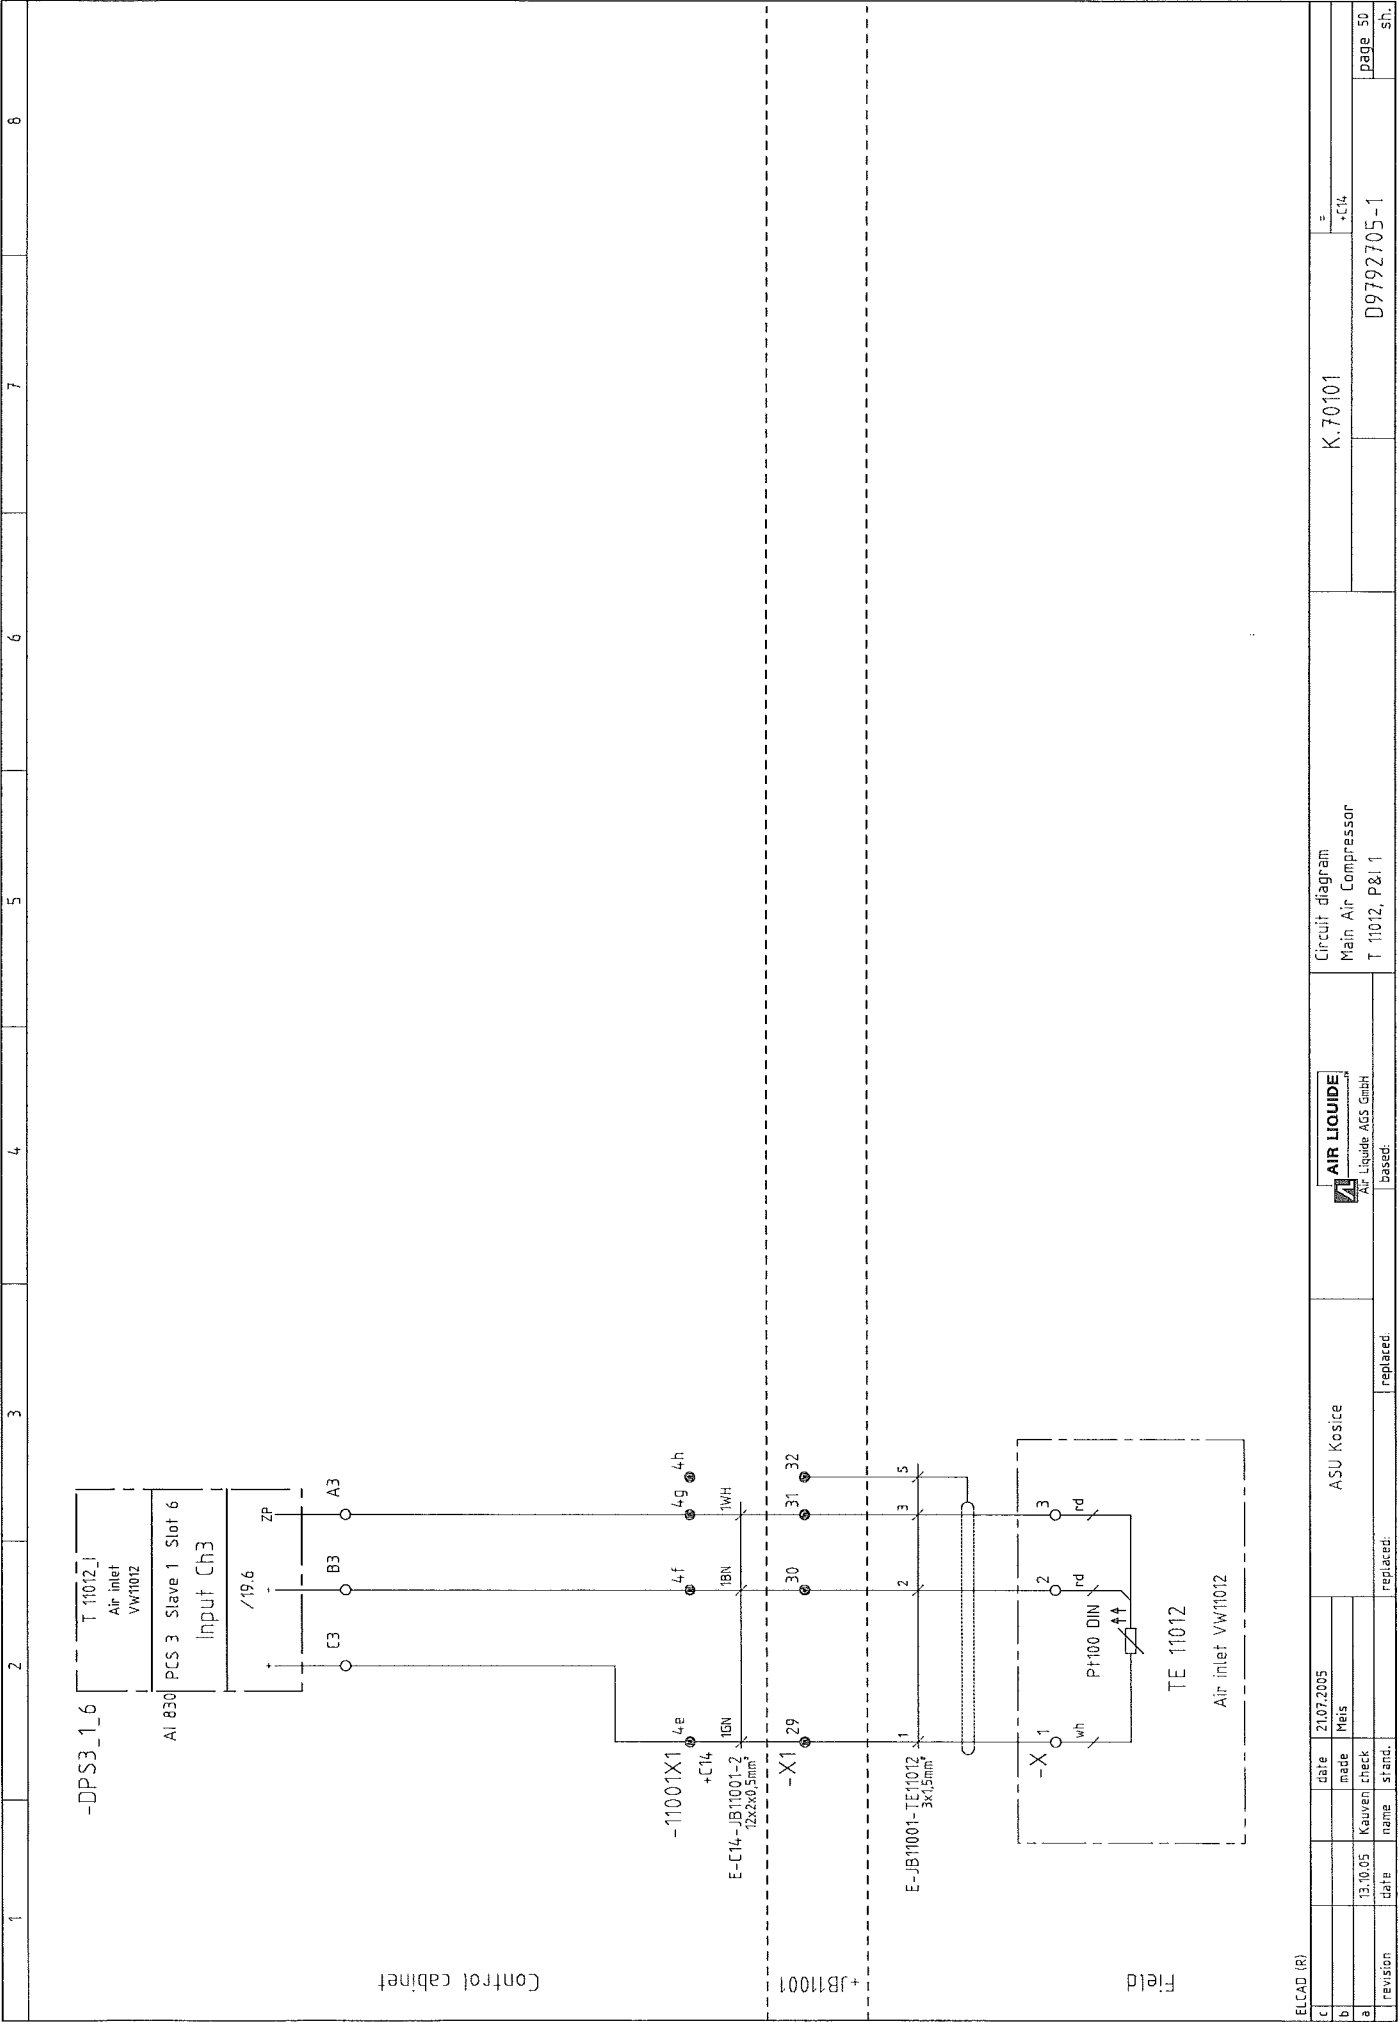

[illegible]

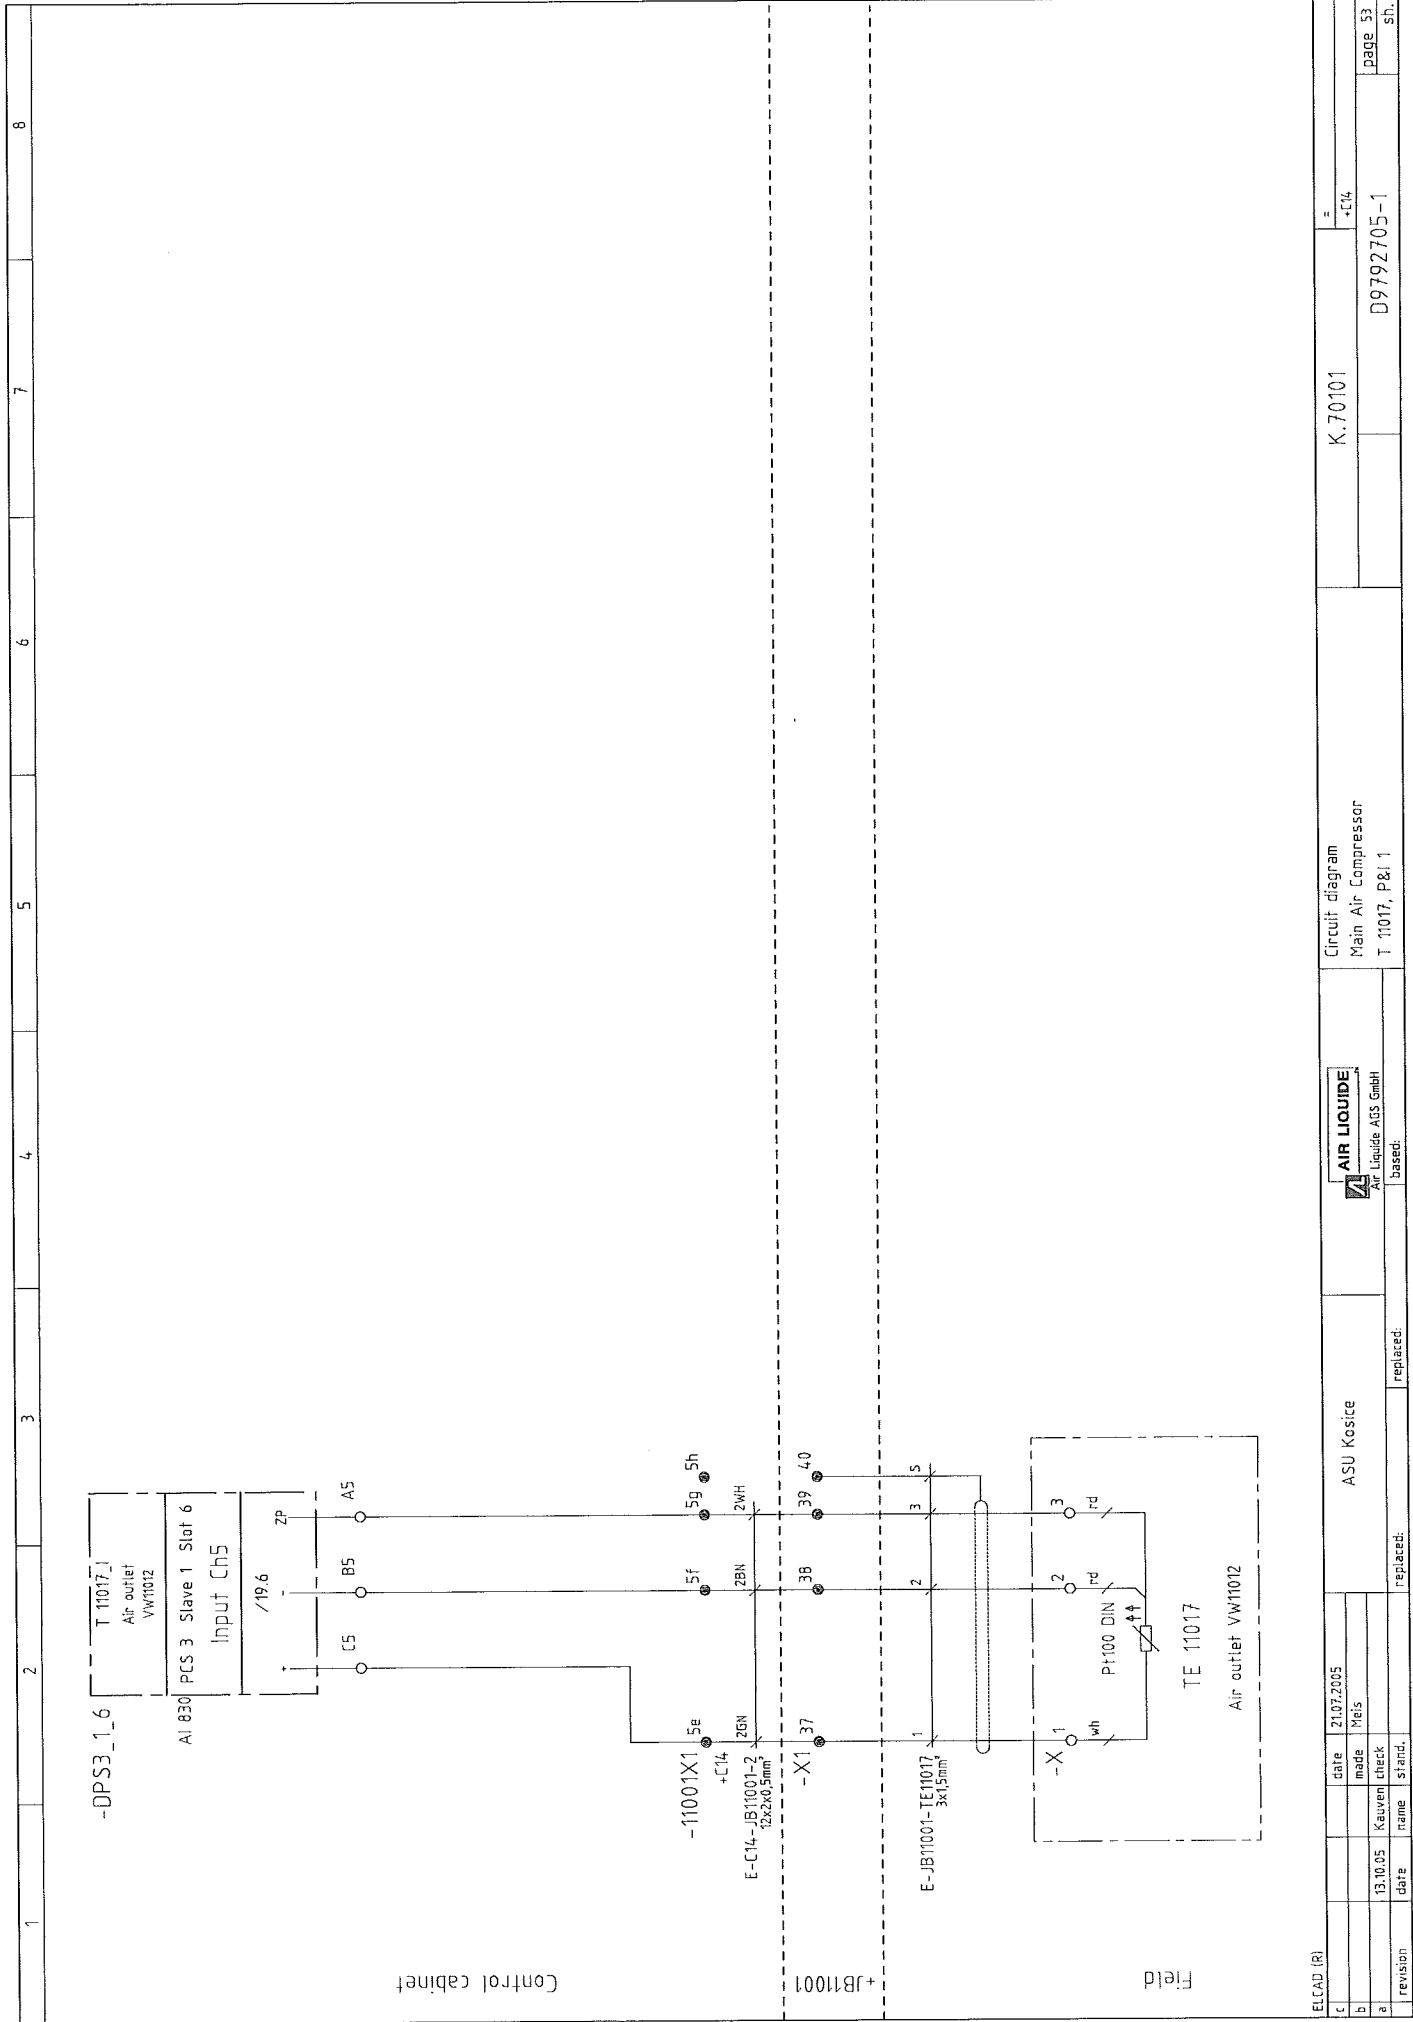

ELCAD (R)		ASU Kosice		Circuit diagram Main Air Compressor T 11017, P&I 1		K.70101	= +C14	page 53 sh.
c	date	21.07.2005		AIR LIQUIDE Air Liquide AGS GmbH based:				
b	made	M&S						
a	13.10.05	Kauwen	check					
revision	date	name	stand.	replaced:	replaced:			

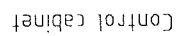


Field

TE 11021


Air inlet VW11021

ELCAD (R)


[illegible]

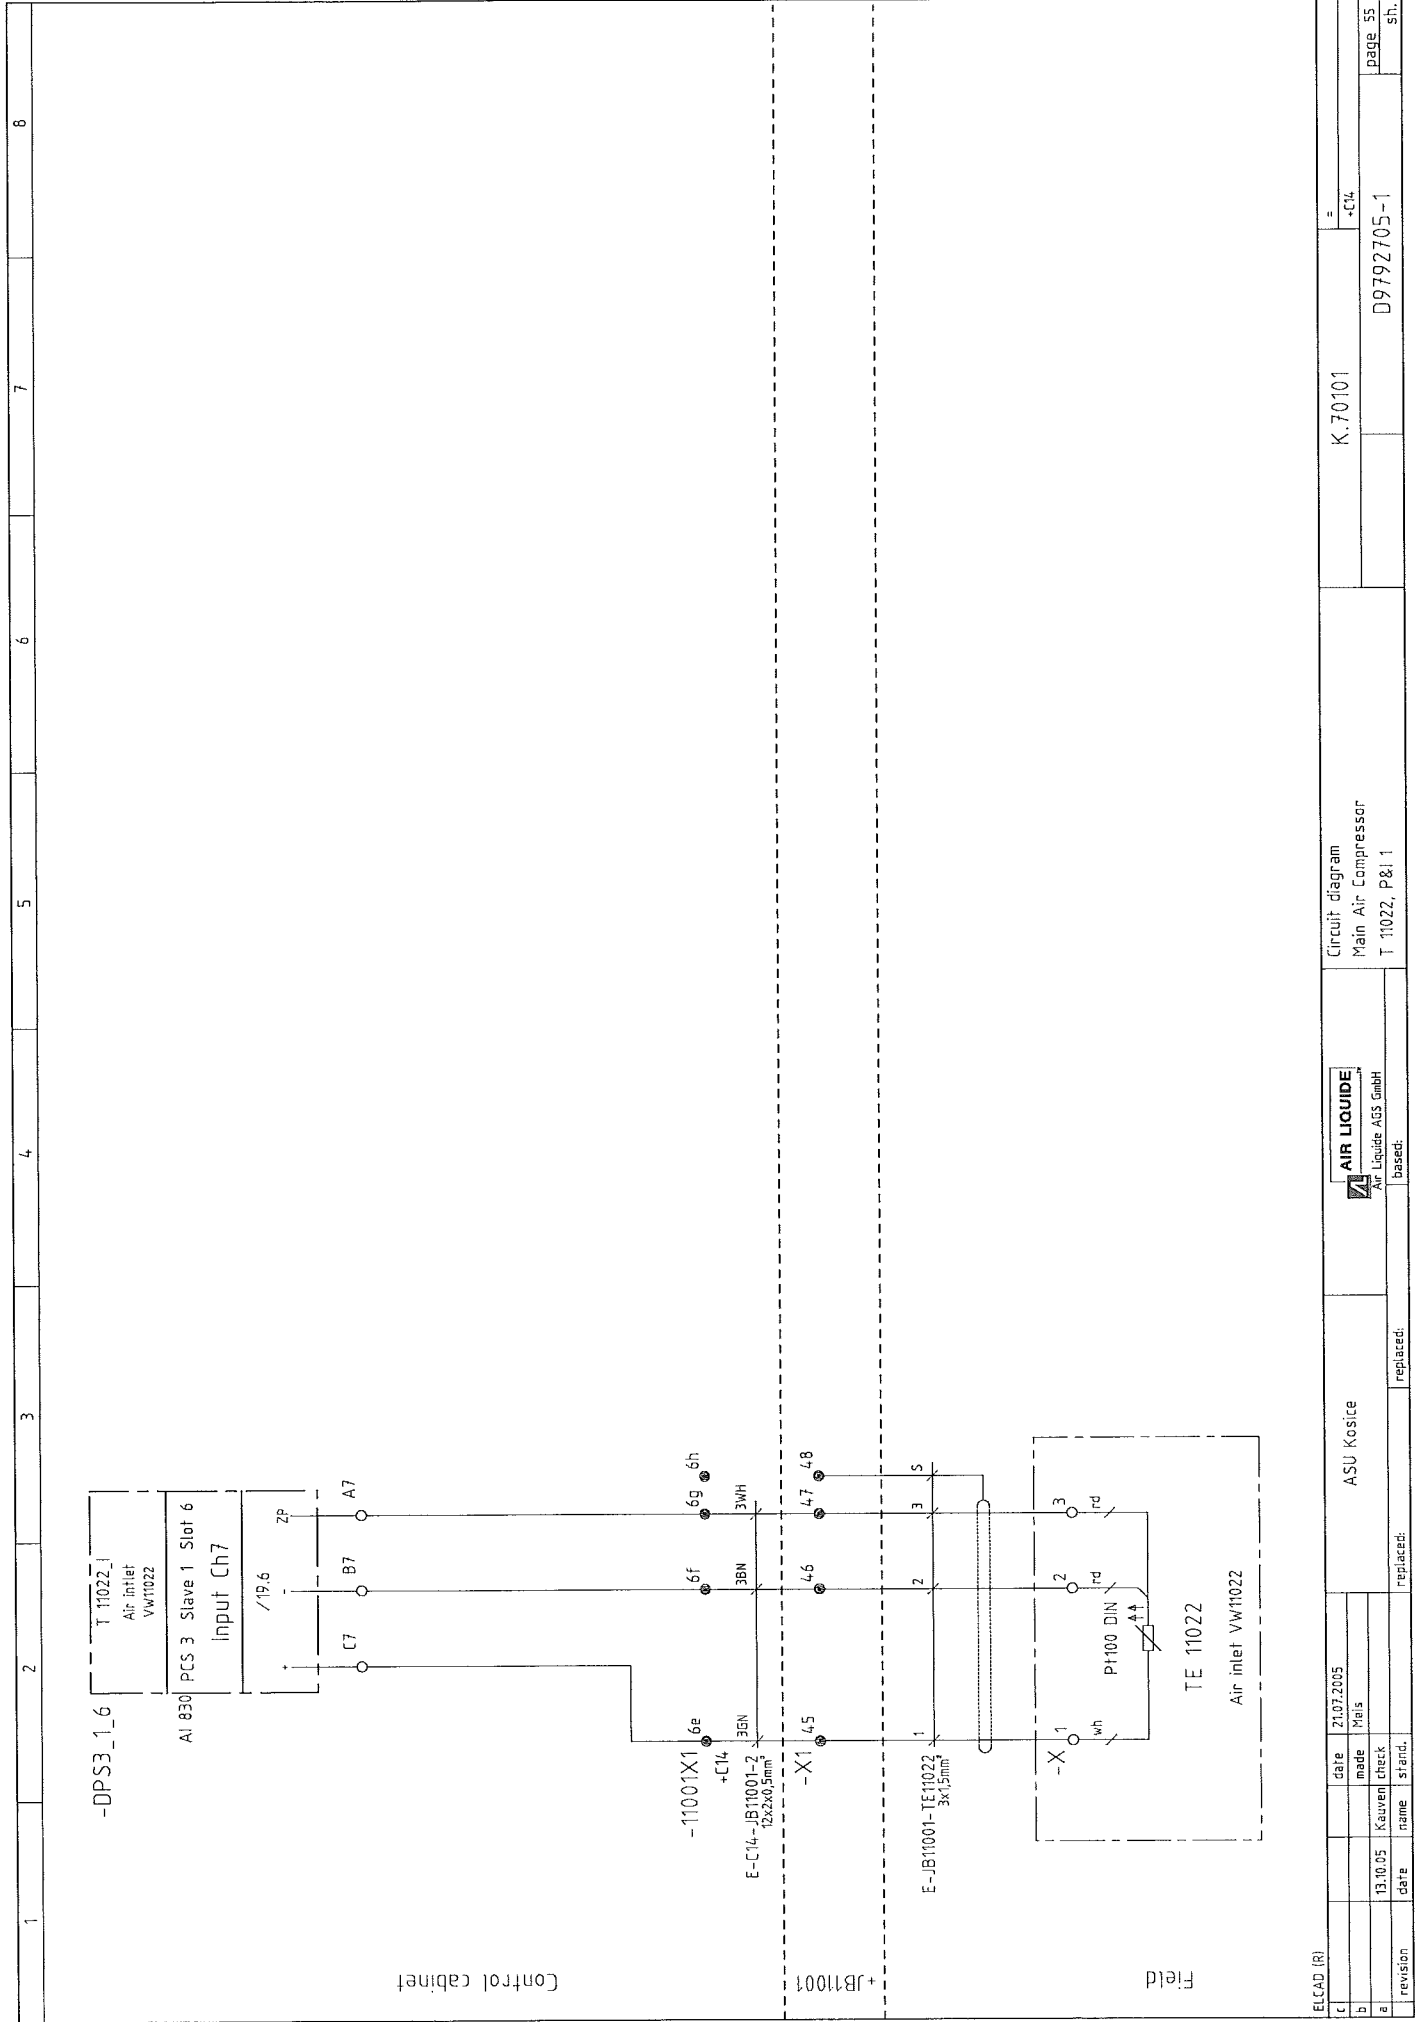

ELCAD (R)		ASU Kosice		K.70101		=	
c	date	21.07.2005		Main Air Compressor		-C14	
b	made	Milis		T 11022, P&I 1		D9792705-1	
a	check					page 55	
revision	name	stand.	replaced:			sh.	

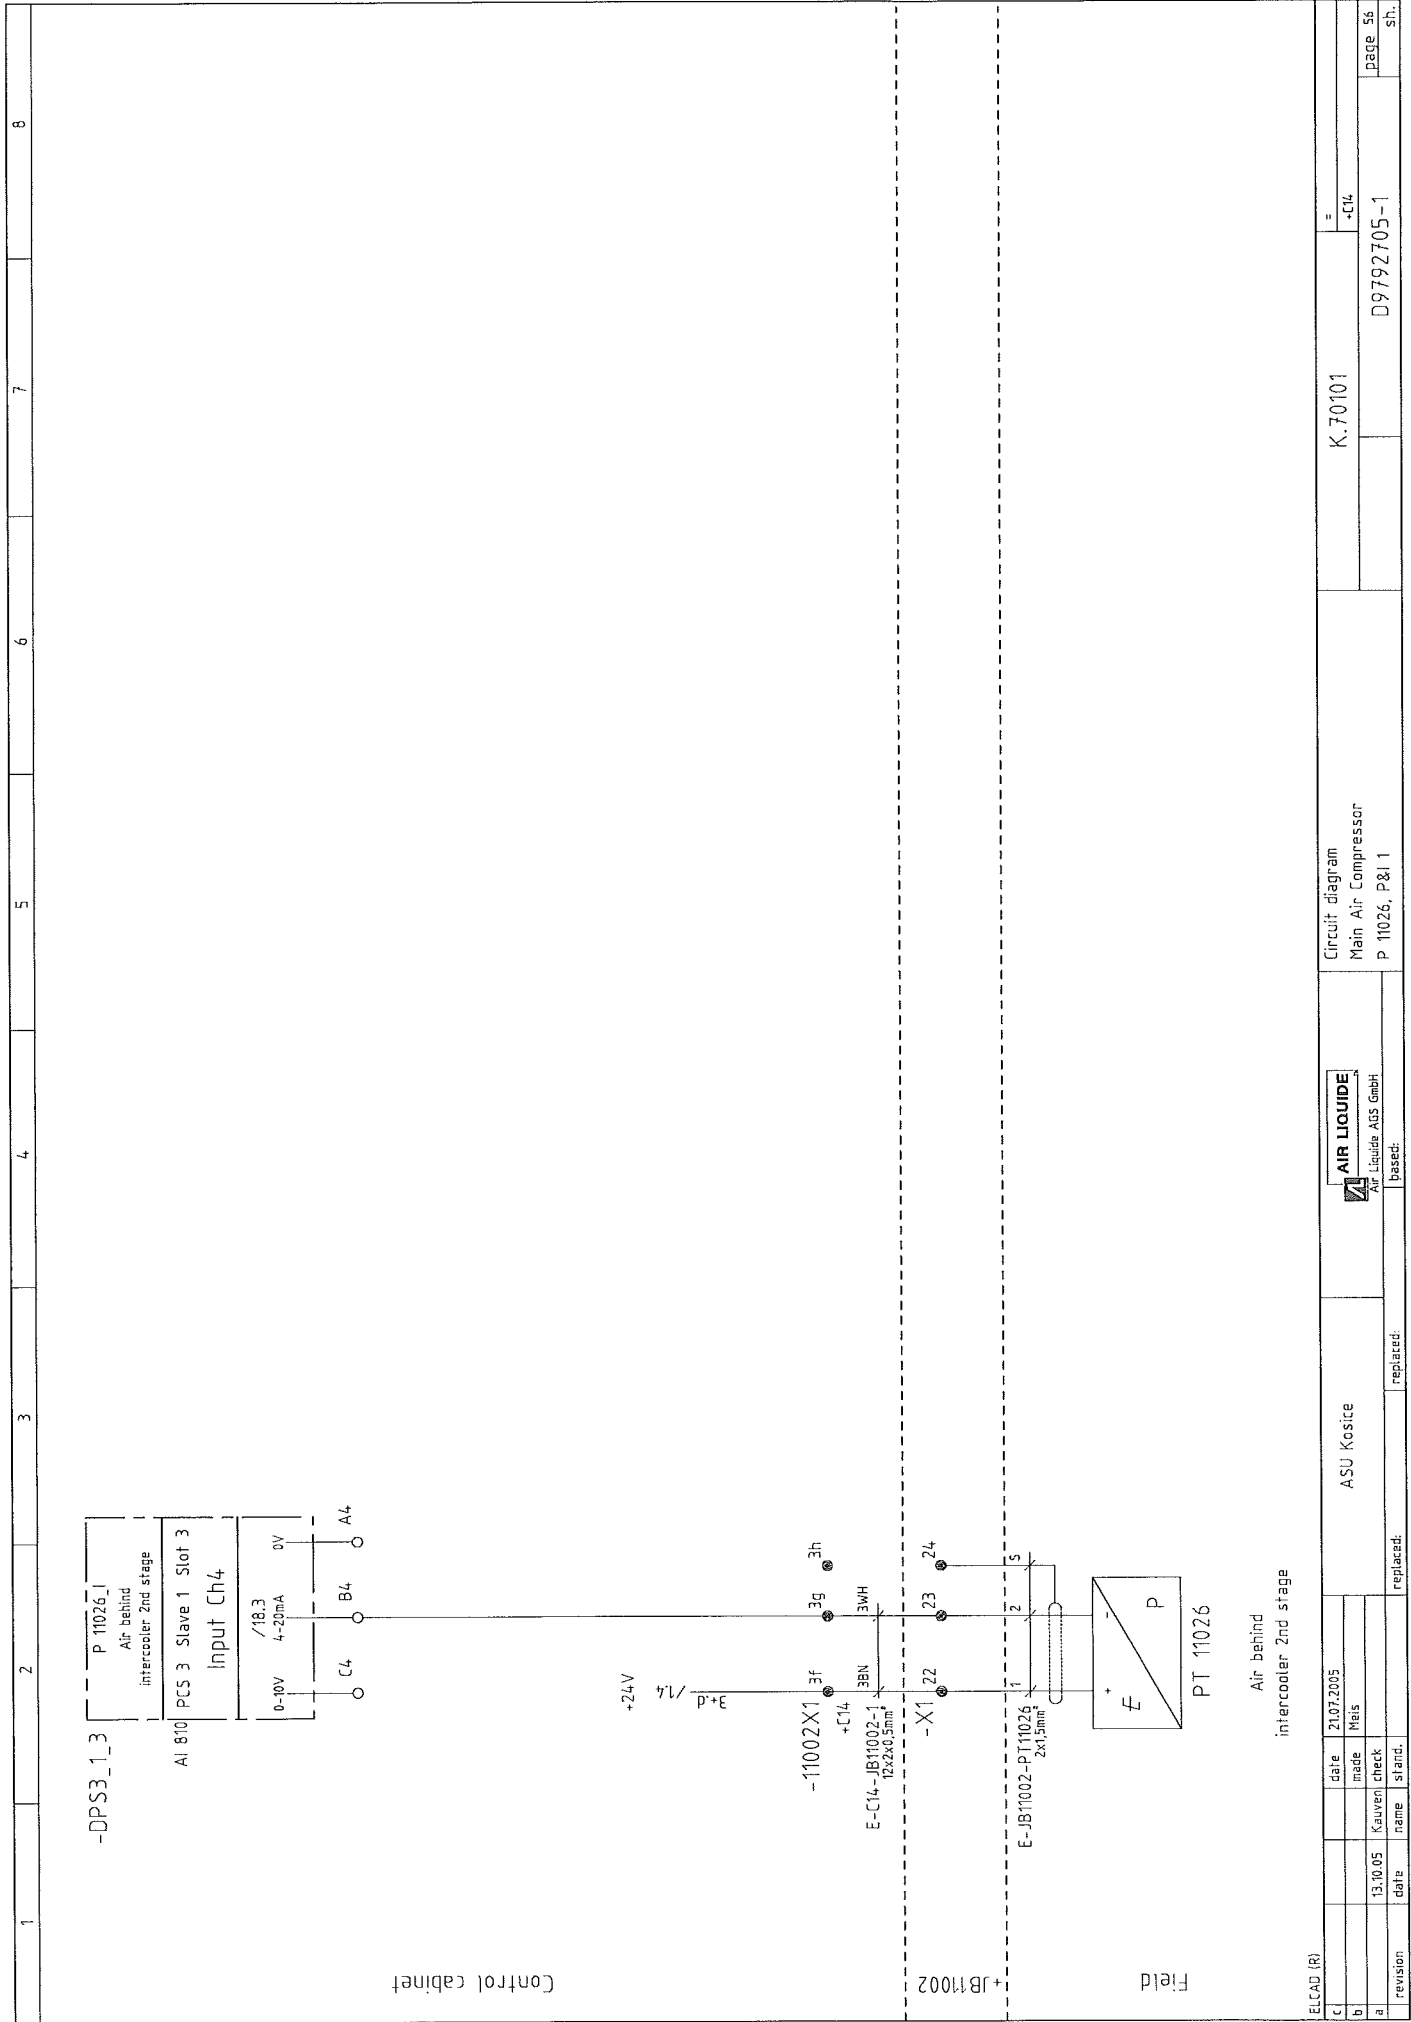

ELCAD (R)		Air behind intercooler 2nd stage		Circuit diagram Main Air Compressor P 11026, P&I 1		K.70101		= +C14	
c	date	21.07.2005	ASU Kosice	AIR LIQUIDE					
b	made	Preis		Air Liquide AGS GmbH					
a	13.10.05	Kauwen		Air Liquide AGS GmbH					
revision	date	name	stand.	replaced:	replaced:	D9792705-1		page 56	
								sh.	

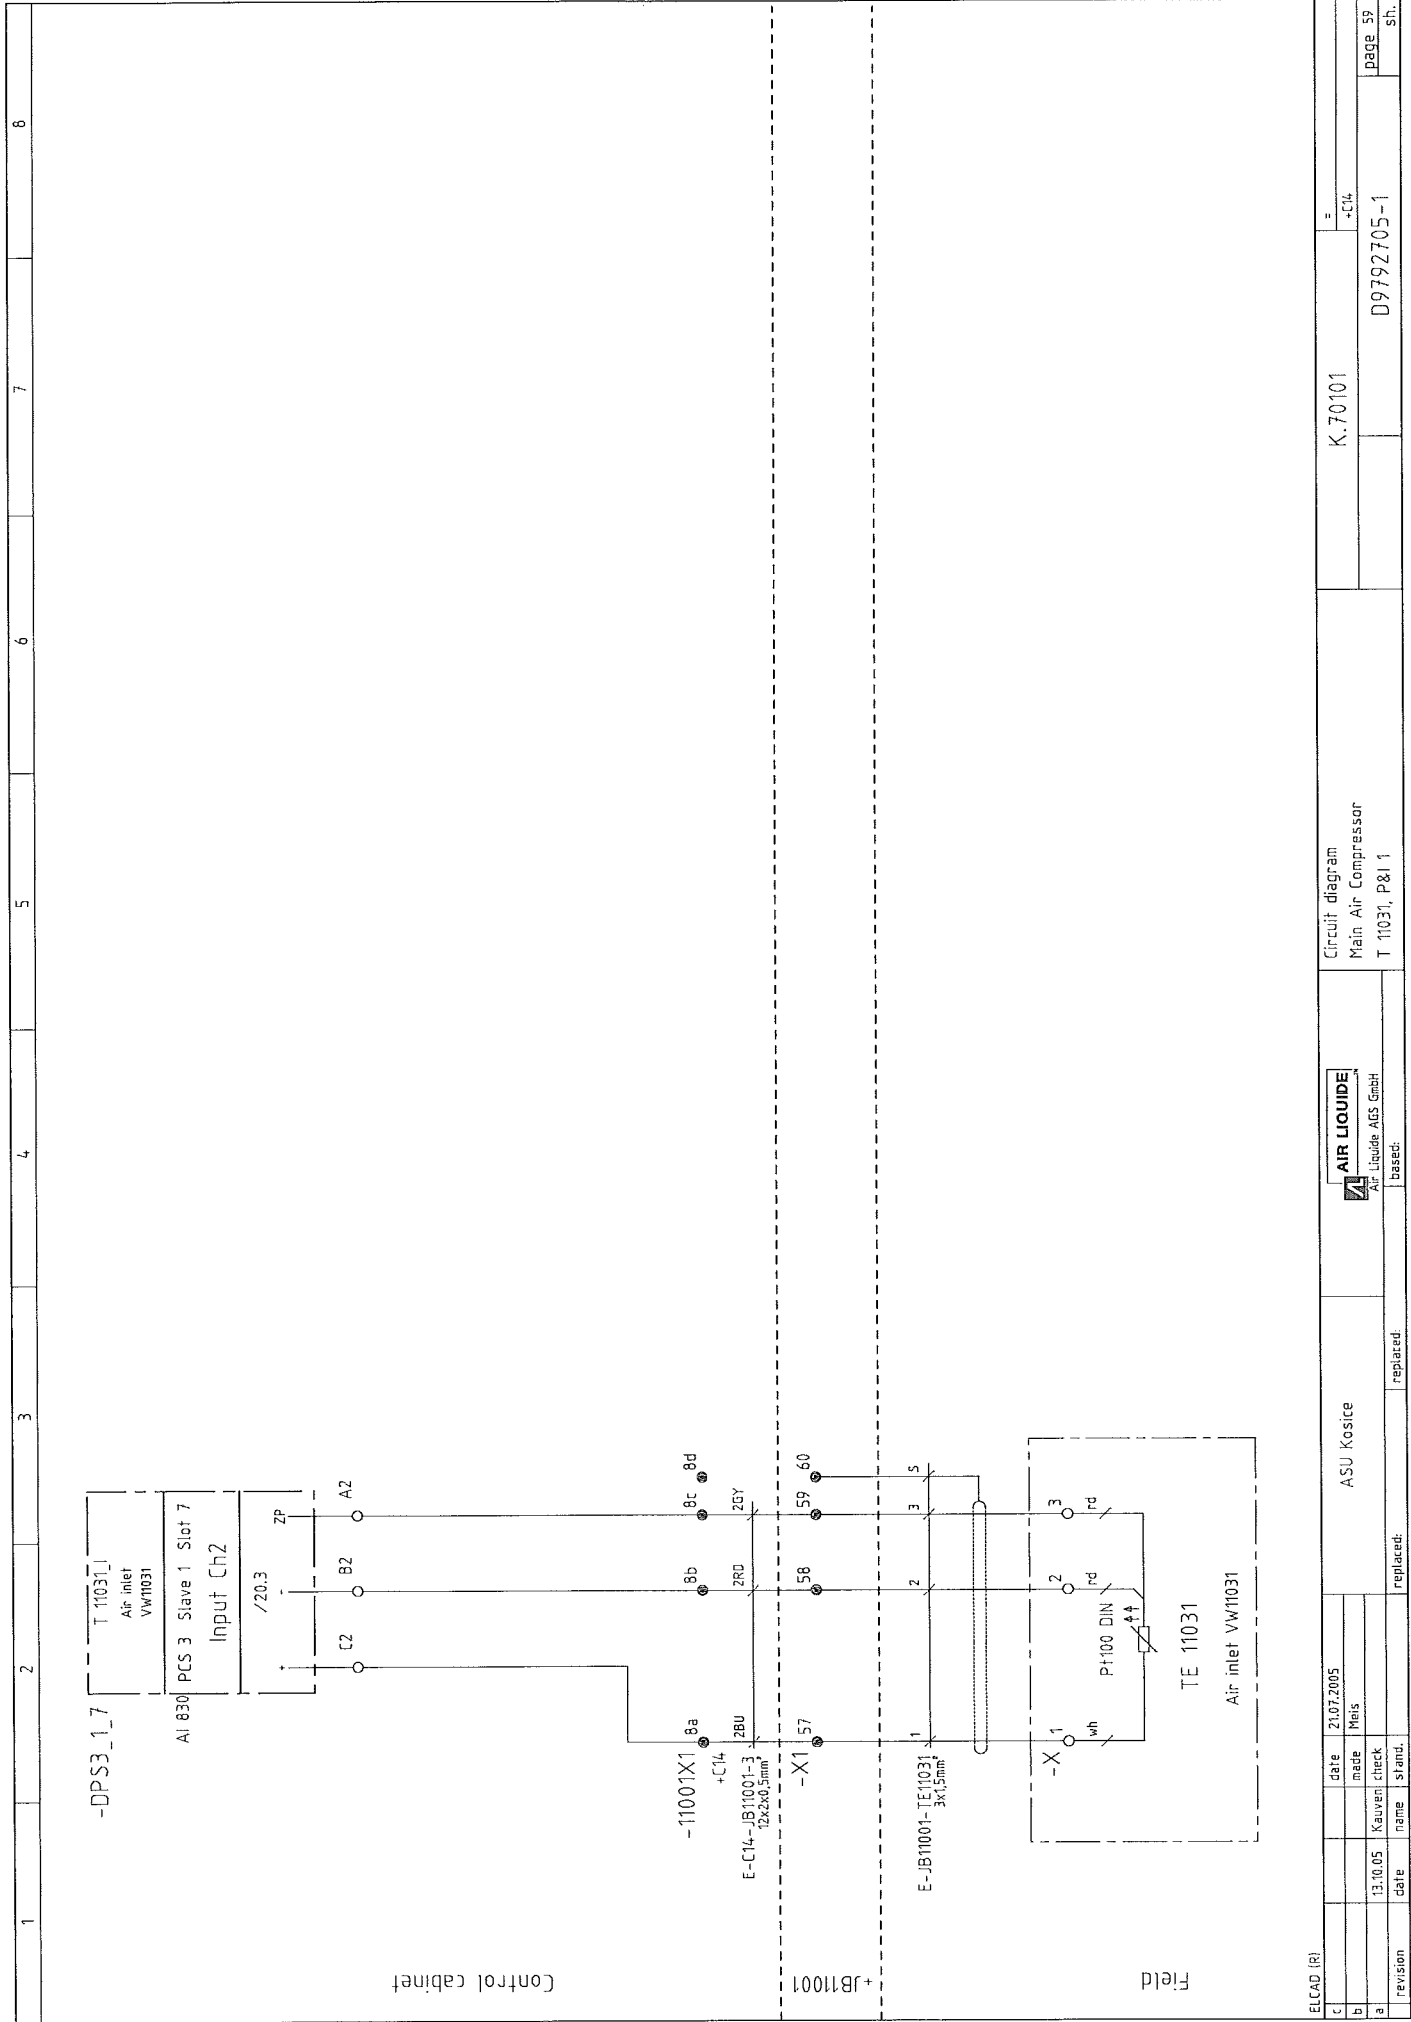

ELCAD (R)		date		21.07.2005	ASU Kosice		Circuit diagram		K.70101		=	
c				made			Main Air Compressor		+C14			
b				check			T 11031, P&I 1				page 59	
a	13.10.05	Kauven									D9792705-1	
revision	date	name	stand.	replaced:	replaced:						sh.	










ELCAD (R)

-DPS3_1.3

P 11036.1
Air behind intercooler 3rd stage

AI 810 PCS 3 Slave 1 Slot 3 Input Ch5

/18.3
0-10V 4-20mA 0V

C5 B5 A5

+24V /14

3+e

-11002X1

4a 4b 4c

E-C14-JB11002-2 1BU 1BD

12x2x0.5mm²

-X1

25 26 27

E-JB11002-PT11036 2x15mm²

1 2 3 5

PT 11036

Field

Air behind intercooler 3rd stage


c	date	made	Yefis	ASU Kosice	AIR LIQUIDE	Circuit diagram	K.70101	=
b	13.10.05	Kauven	check		Air Liquide AGS GmbH <td>Main Air Compressor <td></td> <td>-C14</td> </td>	Main Air Compressor <td></td> <td>-C14</td>		-C14
a						P 11036, P&I 1 <td>D9792705-1 <td></td> </td>	D9792705-1 <td></td>	
revisio	date	name	stand.	replaced:	based:		sh.	st.


ELCAD (R)


Control cabinet

Page 61

8

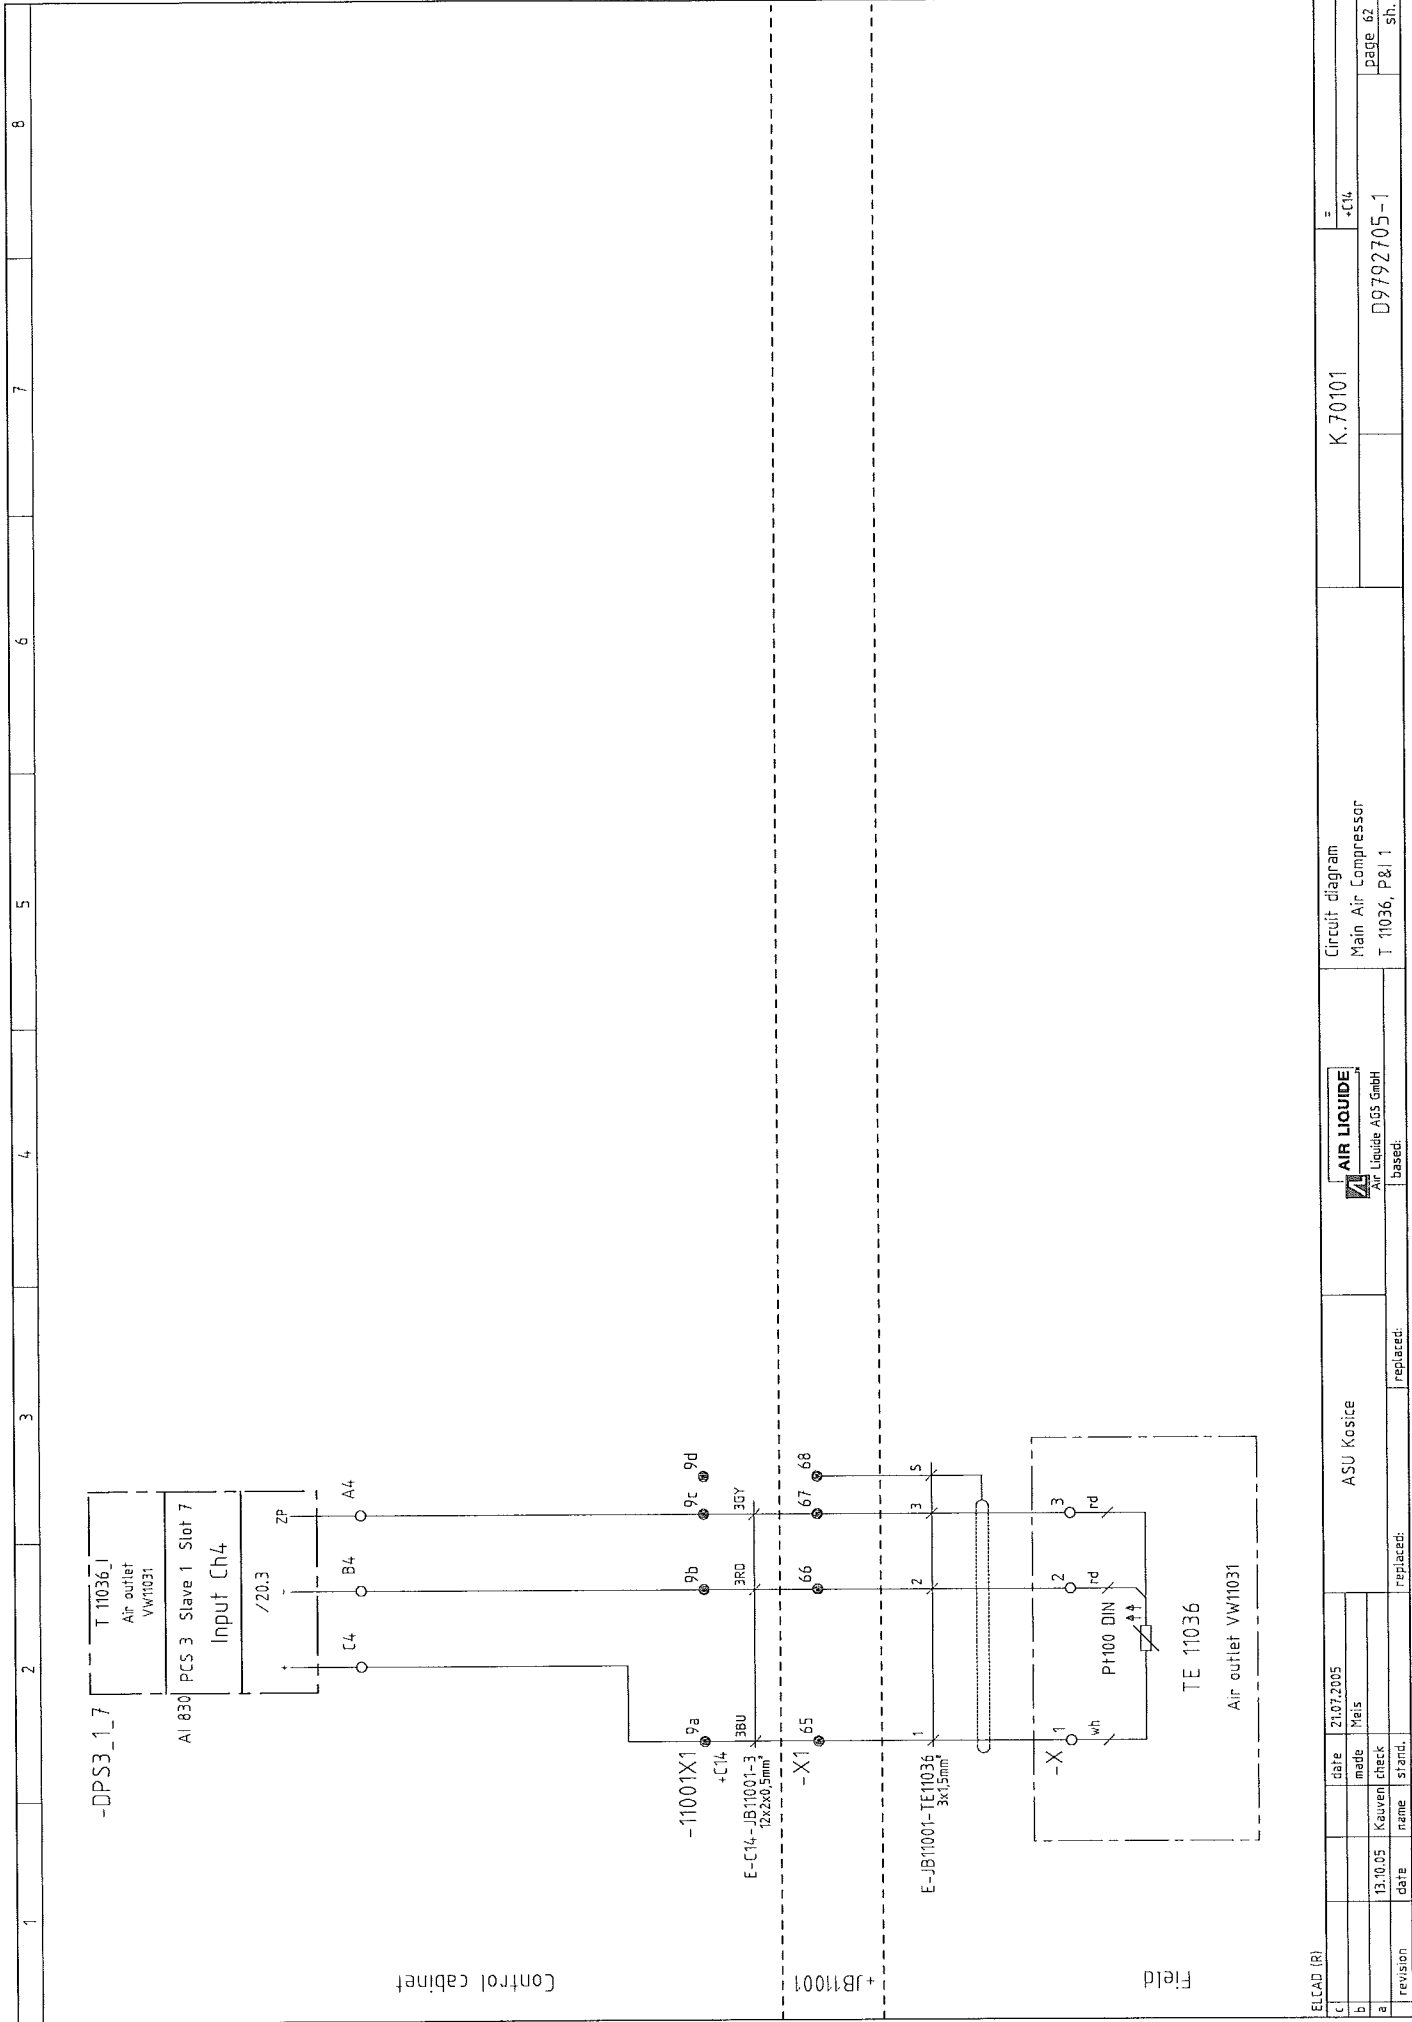

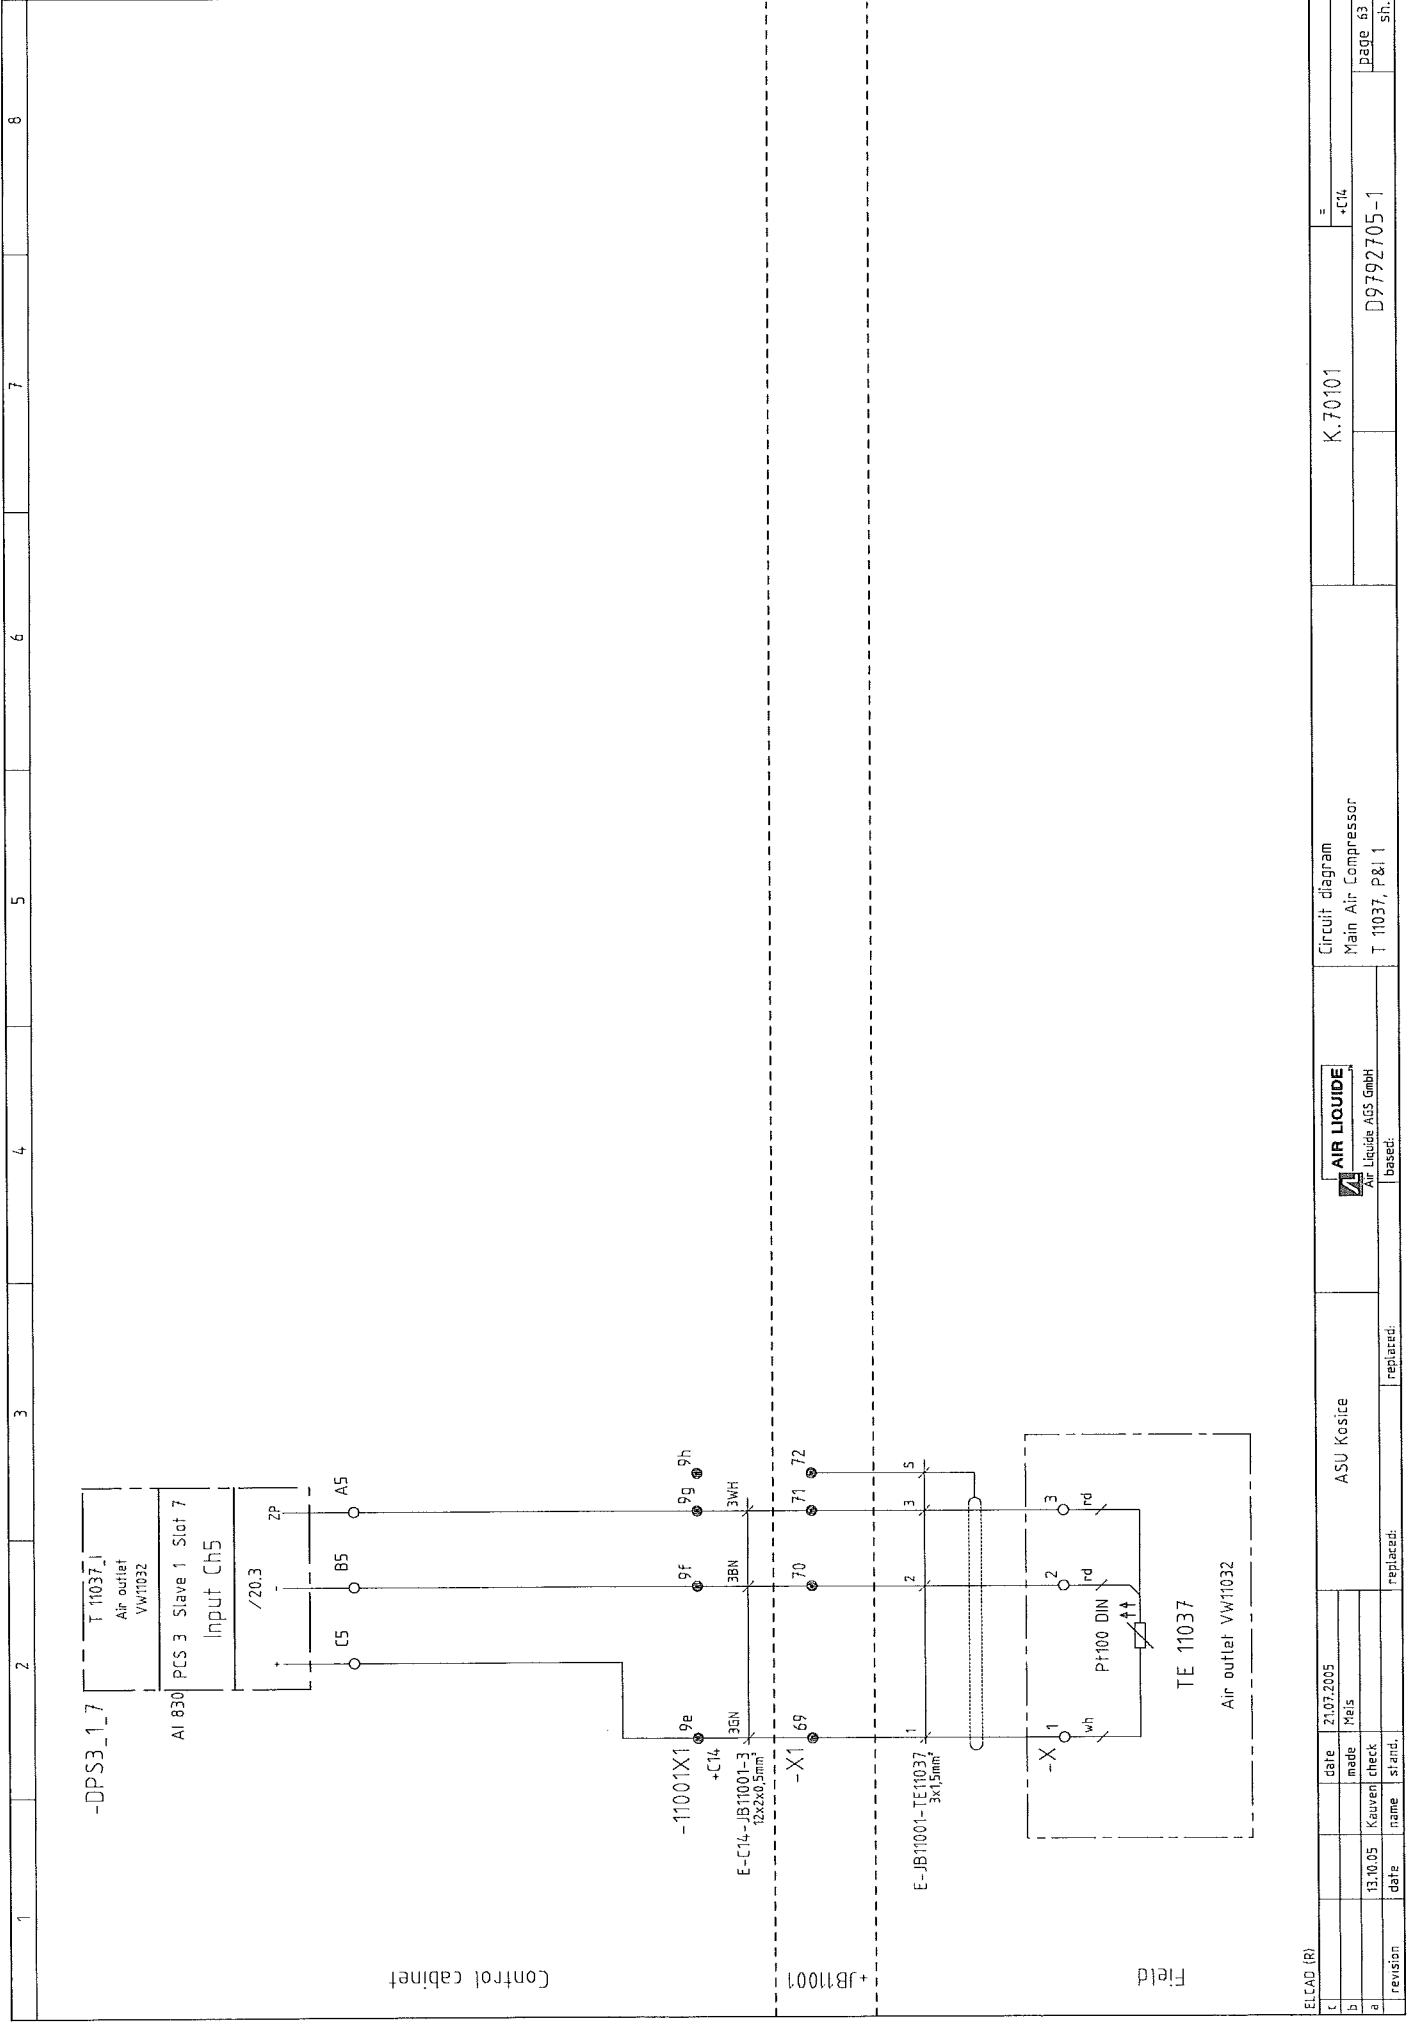

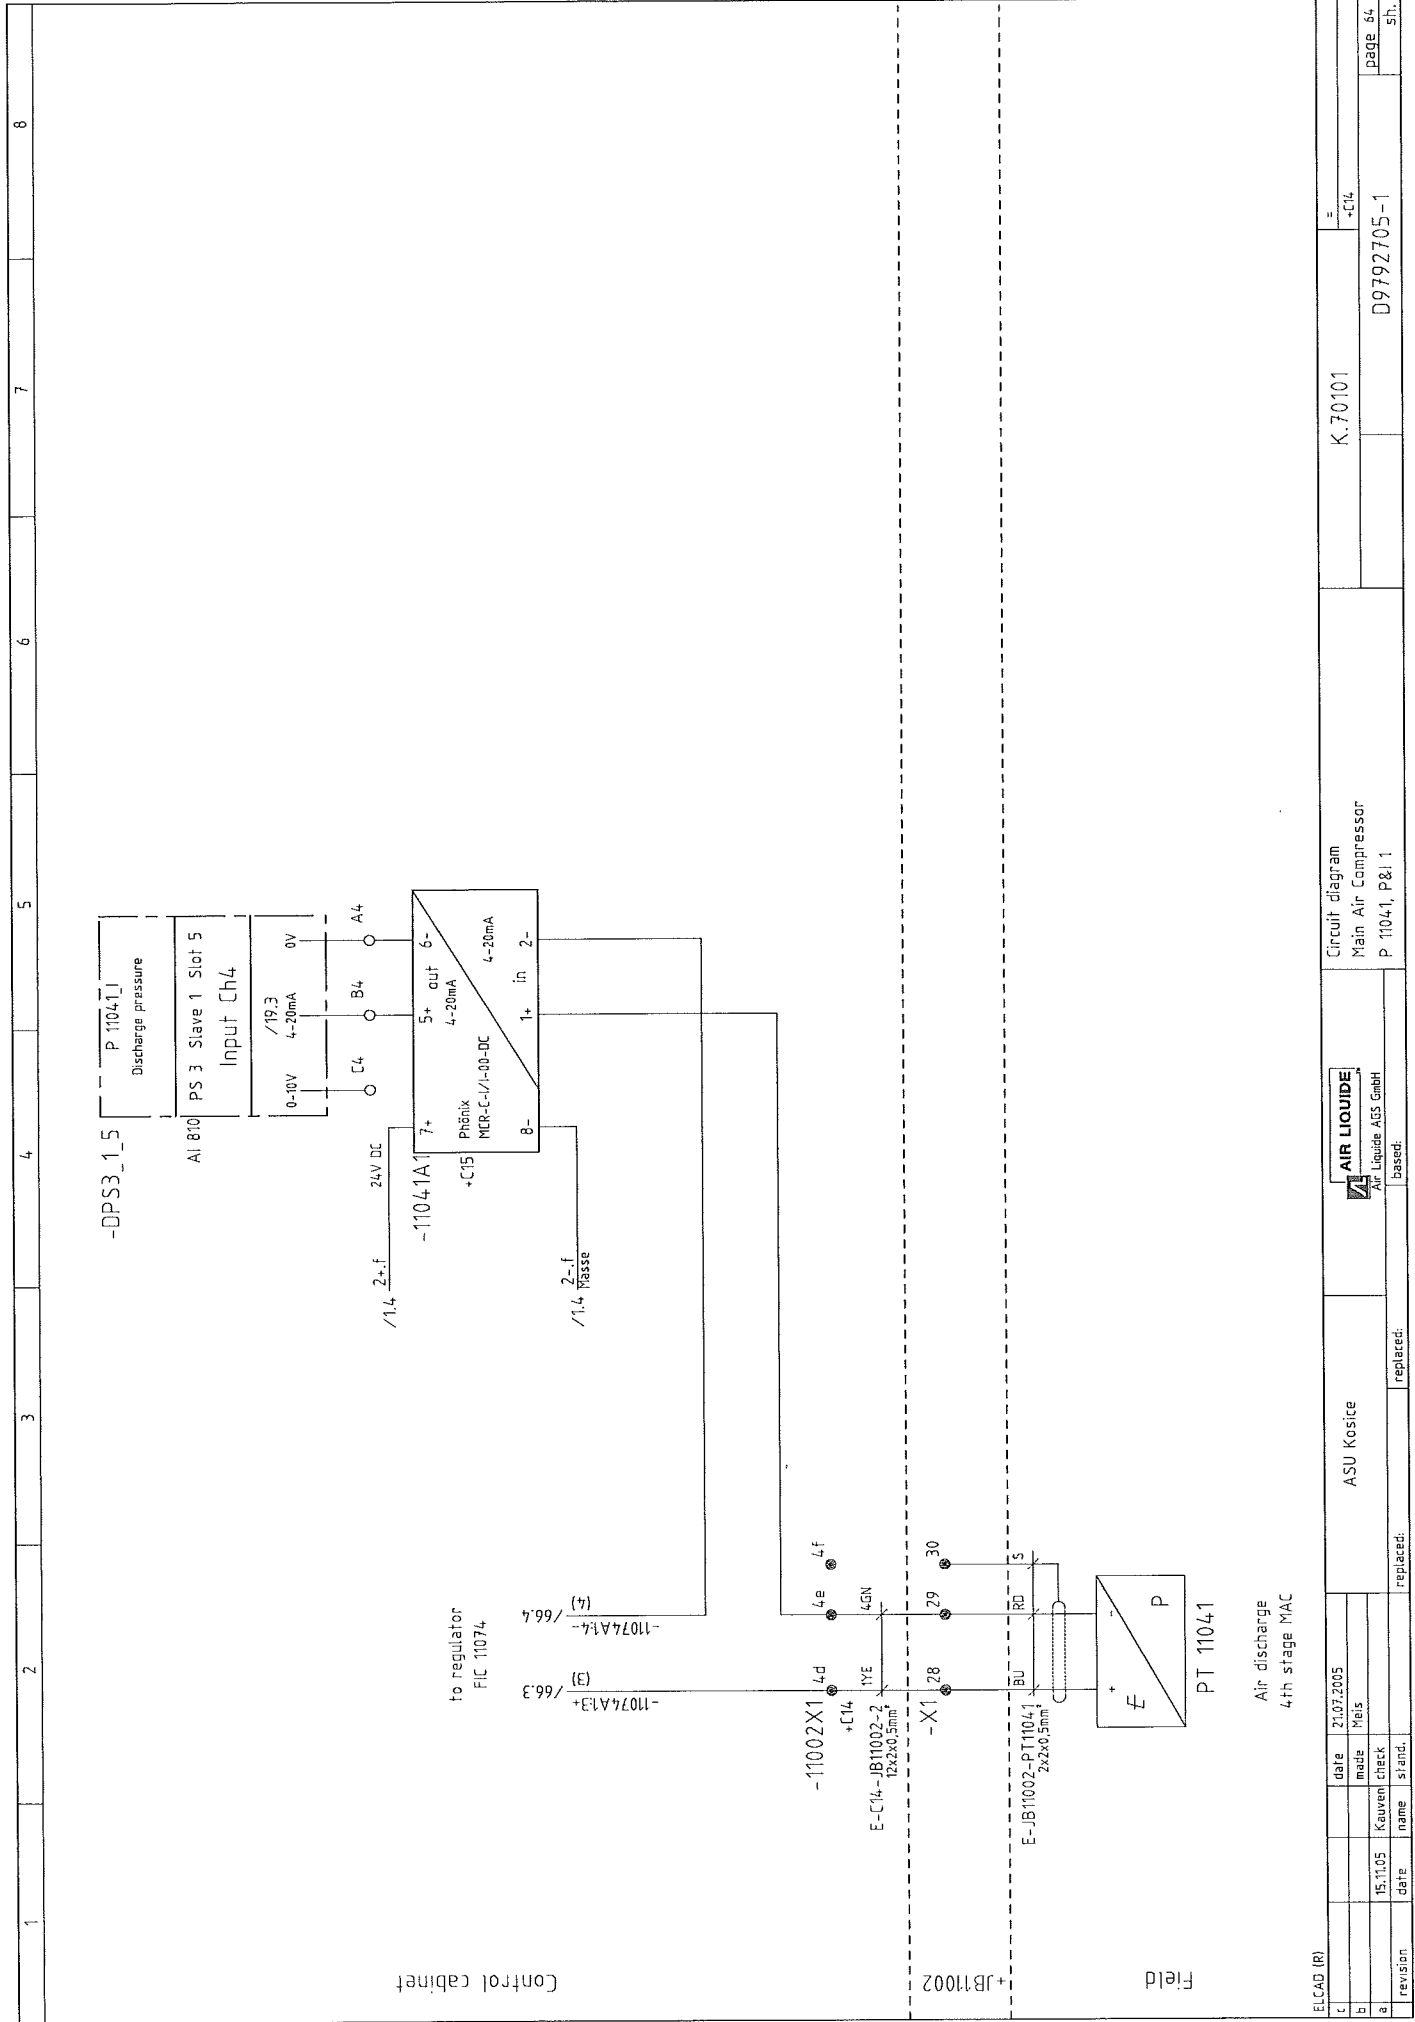

ELCAD (R)		ASU Kosice		AIR LIQUIDE		Circuit diagram		K.70101		=	
c	date	21.07.2005		made	Mis	Main Air Compressor		-C14		-C14	
b	date	15.11.05		check	Mis	P 11041, P81 1		D9792705-1		page 64	
a	revision			name	stand.	replaced:		replaced:		sh.	

Control cabinet

Field

-DPS3_1.7

T 11041.1
Air discharge
4th stage MAC

AI 830 PCS 3 Slave 1 Slot 7
Input Ch6

/20.3

ZP

A6

B6

C6

10a

10b

10c

10d

+C14

E-C14-JB11001-4
12x2x0.5mm

1BU

1RD

1GY

-X1

73

74

75

76

1

2

3

S

E-JB11001-TE11041
3x15mm

-X

1

2

3

wh

rd

rd

PT100 DIN

TE 11041
Air discharge
4th stage MAC

ELCAD (R)

date	21.07.2005
made	Mis
revision	13.10.05
name	Kauven
check	check
stand.	stand.

date	21.07.2005
made	Mis
revision	13.10.05
name	Kauven
check	check
stand.	stand.

ASU Kosice

AIR LIQUIDE
Air Liquide AGS GmbH

replaced:

replaced:

Circuit diagram
Main Air Compressor
T 11041, P&I 1

K.70101


-C14


z

D9792705-1

page 65

sn.

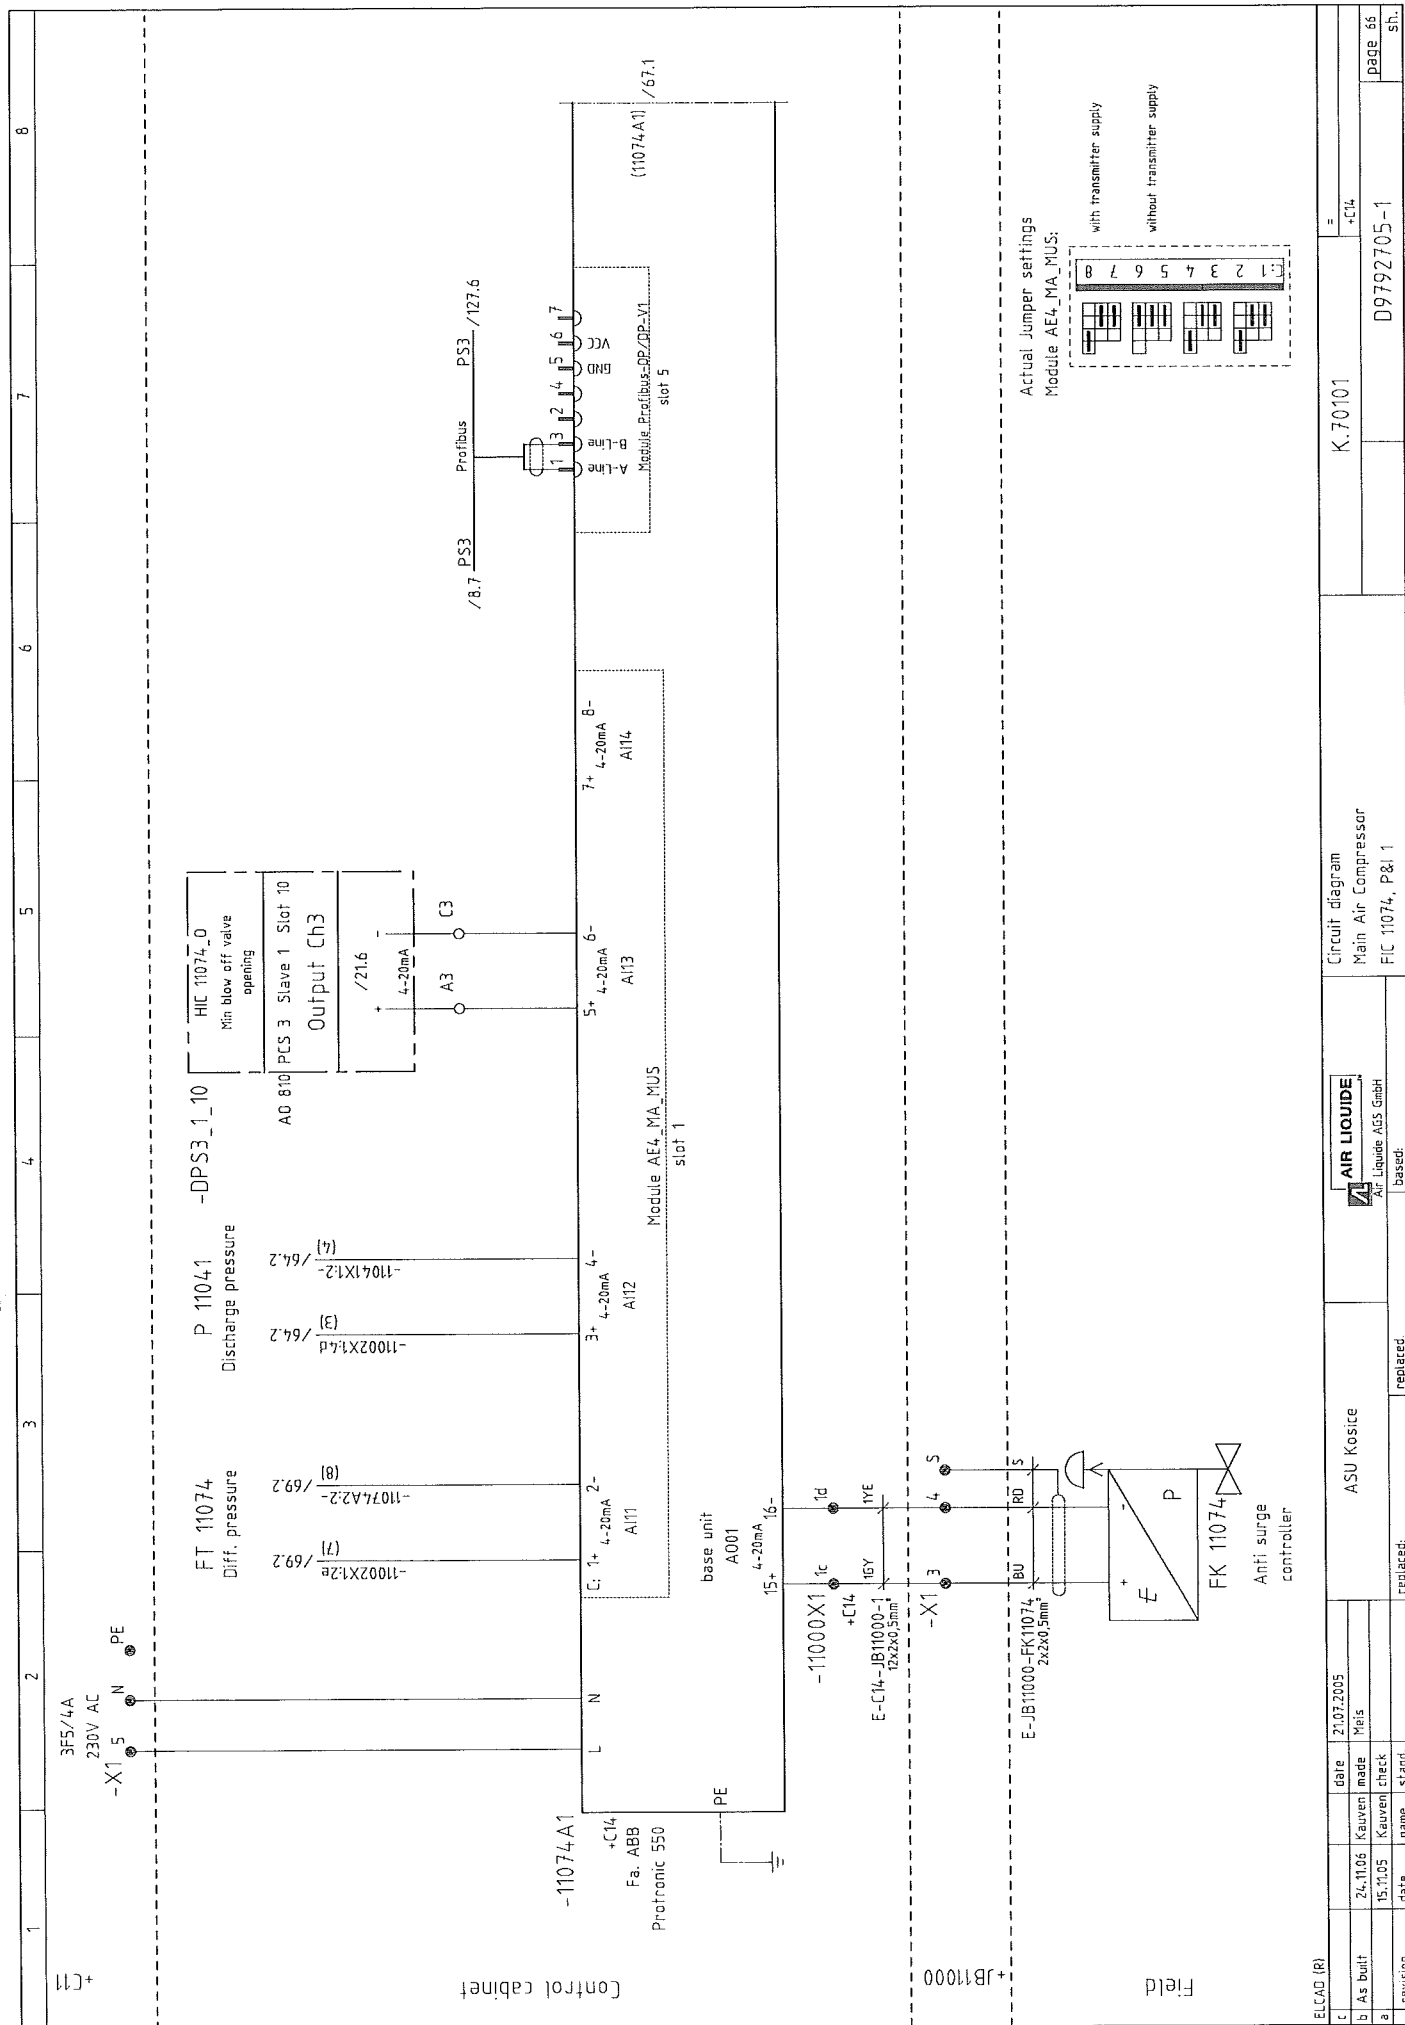

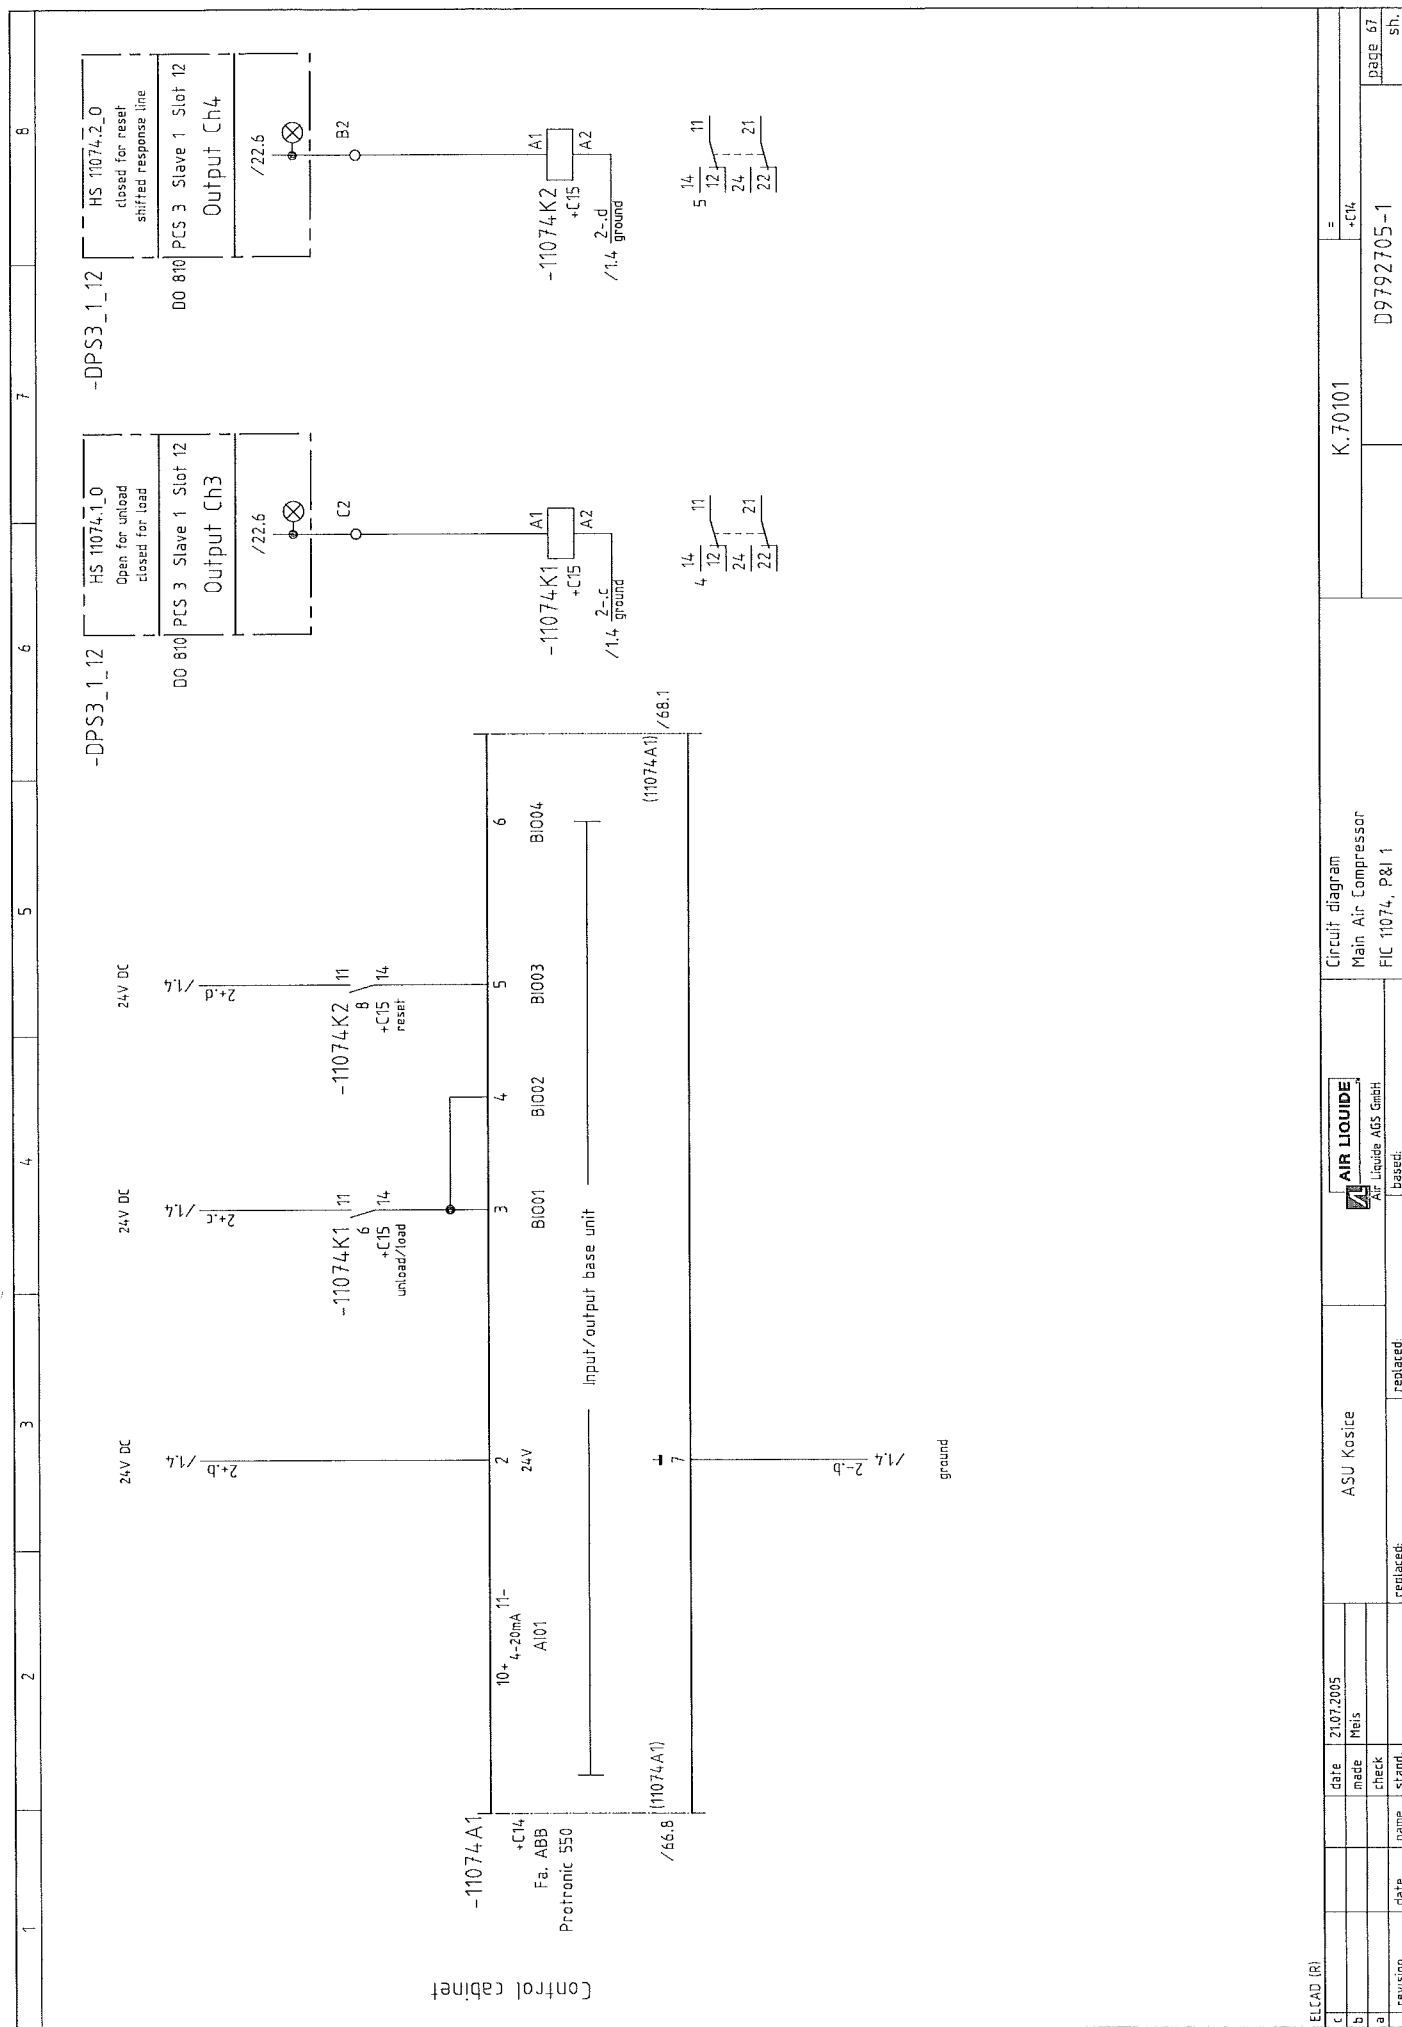


The diagram illustrates the wiring for three alarm input modules in a control cabinet. The modules are YL 11074.2 (Alarm I/O-failure), YL 11074.3 (Alarm Controller failure), and YL 11074.1 (Alarm response line shifted). Each module has a PCS 3 Slave 1 Slot 11 Input Ch9, Ch10, and Ch11. The modules are connected to a 24V DC supply via relays (XP6) and capacitors (C14). The diagram includes terminal block connections (C5, B5, C6), a 24V DC supply, and a 24V DC relay (XP6).

revision	date	name	check	stand.
a				
b				
c				

ELCAD (R)	21.07.2005	ASU Kosice	AIR LIQUIDE	Circuit diagram	K.70101	PTC B59990-C120-A70
				Main Air Compressor		
				FIC 11074, P&I 1		

Control cabinet

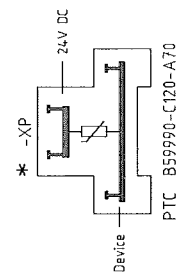

[illegible]



ELCAD (R)

c	
b	As built
a	
	revision

ASU Kosice


AIR LIQUIDE
Air Liquide AGS GmbH
based:

Circuit diagram
Main Air Compressor
US 11074, P&I 1


K.70101


476


09792705-1

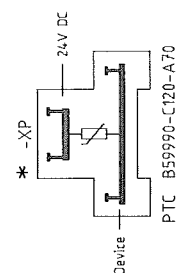


Condensate trap stage 1


ELCAD (R)									
c			date	21.07.2005		ASU Kosice			
b	As built	24.11.06	Kauven made	Mars					
a		13.10.05	Kauven check						
	revision	date	name	replaced:		replaced:		based:	
						 AIR LIQUIDE Air Liquide AGS GmbH		Circuit diagram Main Air Compressor LH 11080, P&I 1	
								K.70101	
								=	
								-C14	
								page 72	
								sh.	
								D9792705-1	

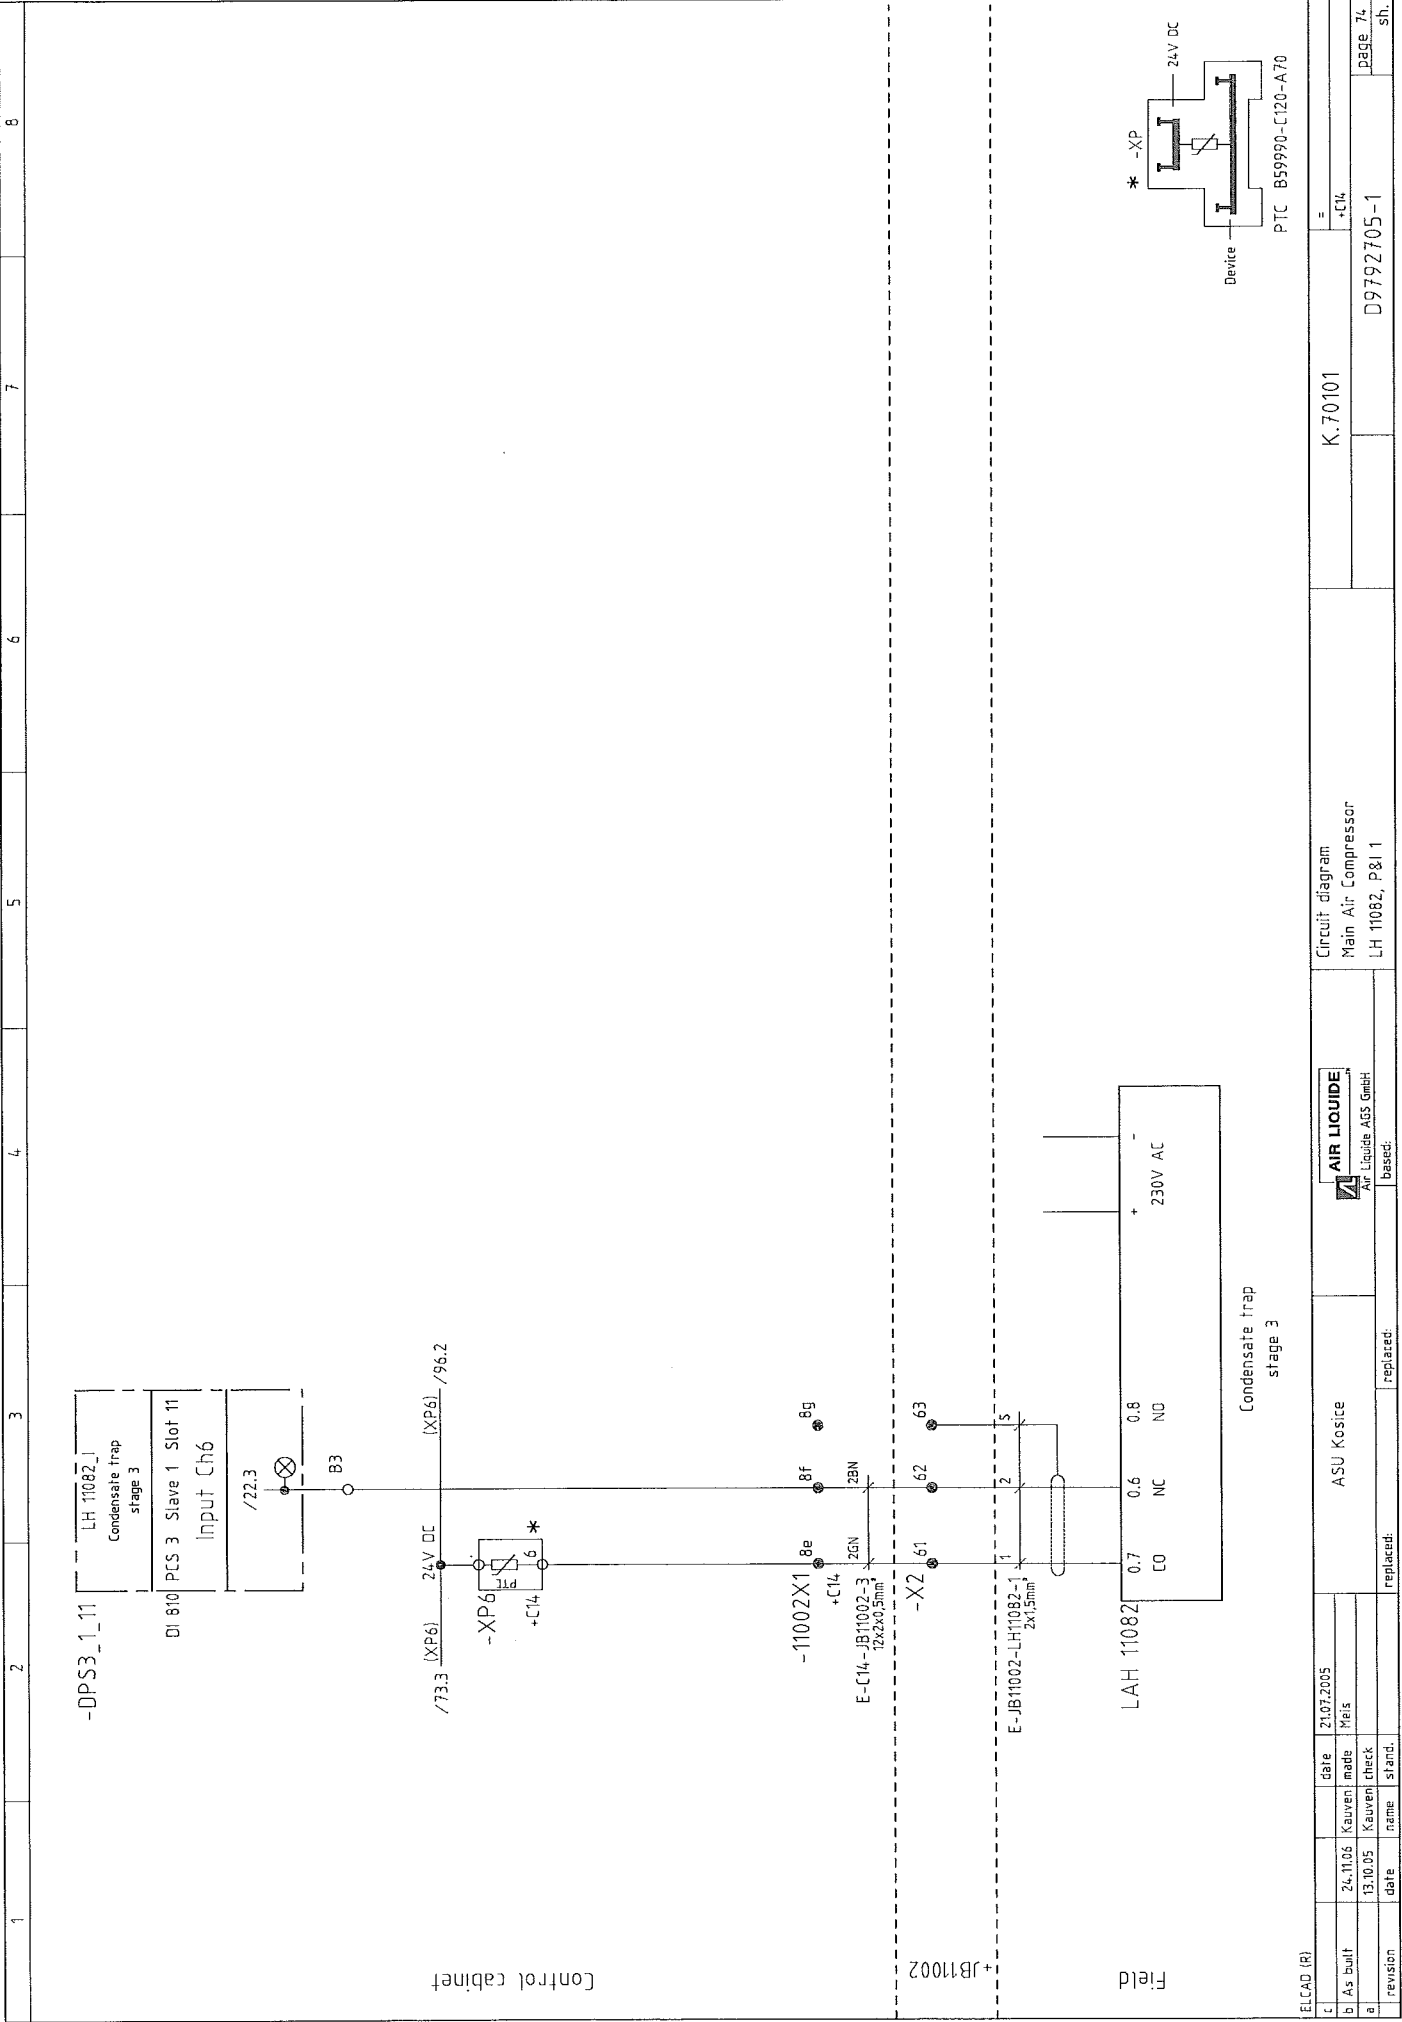


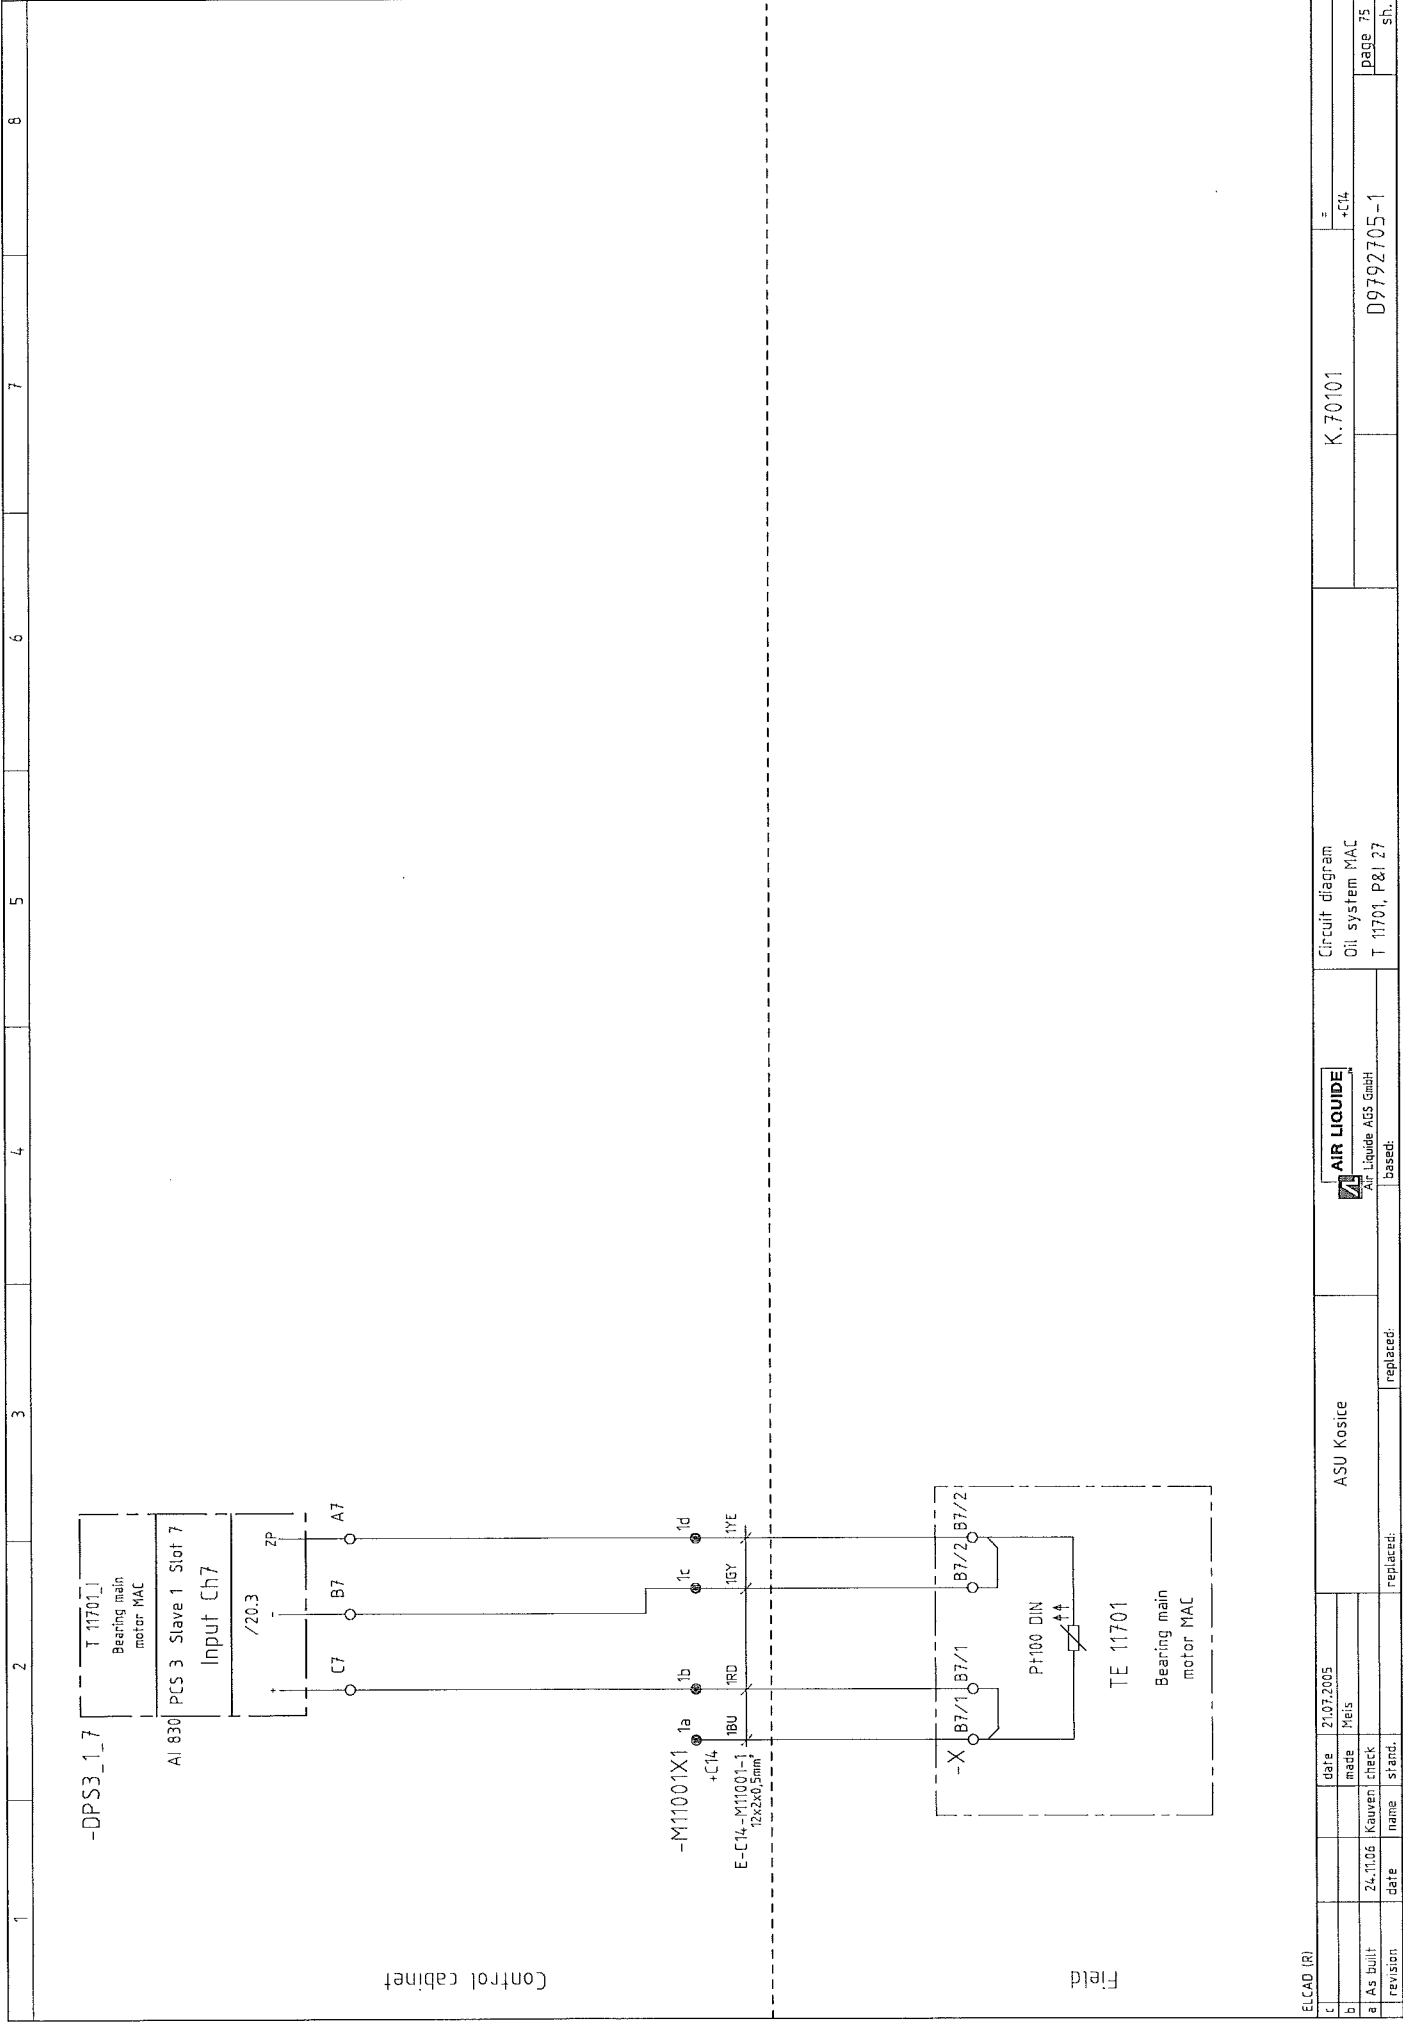

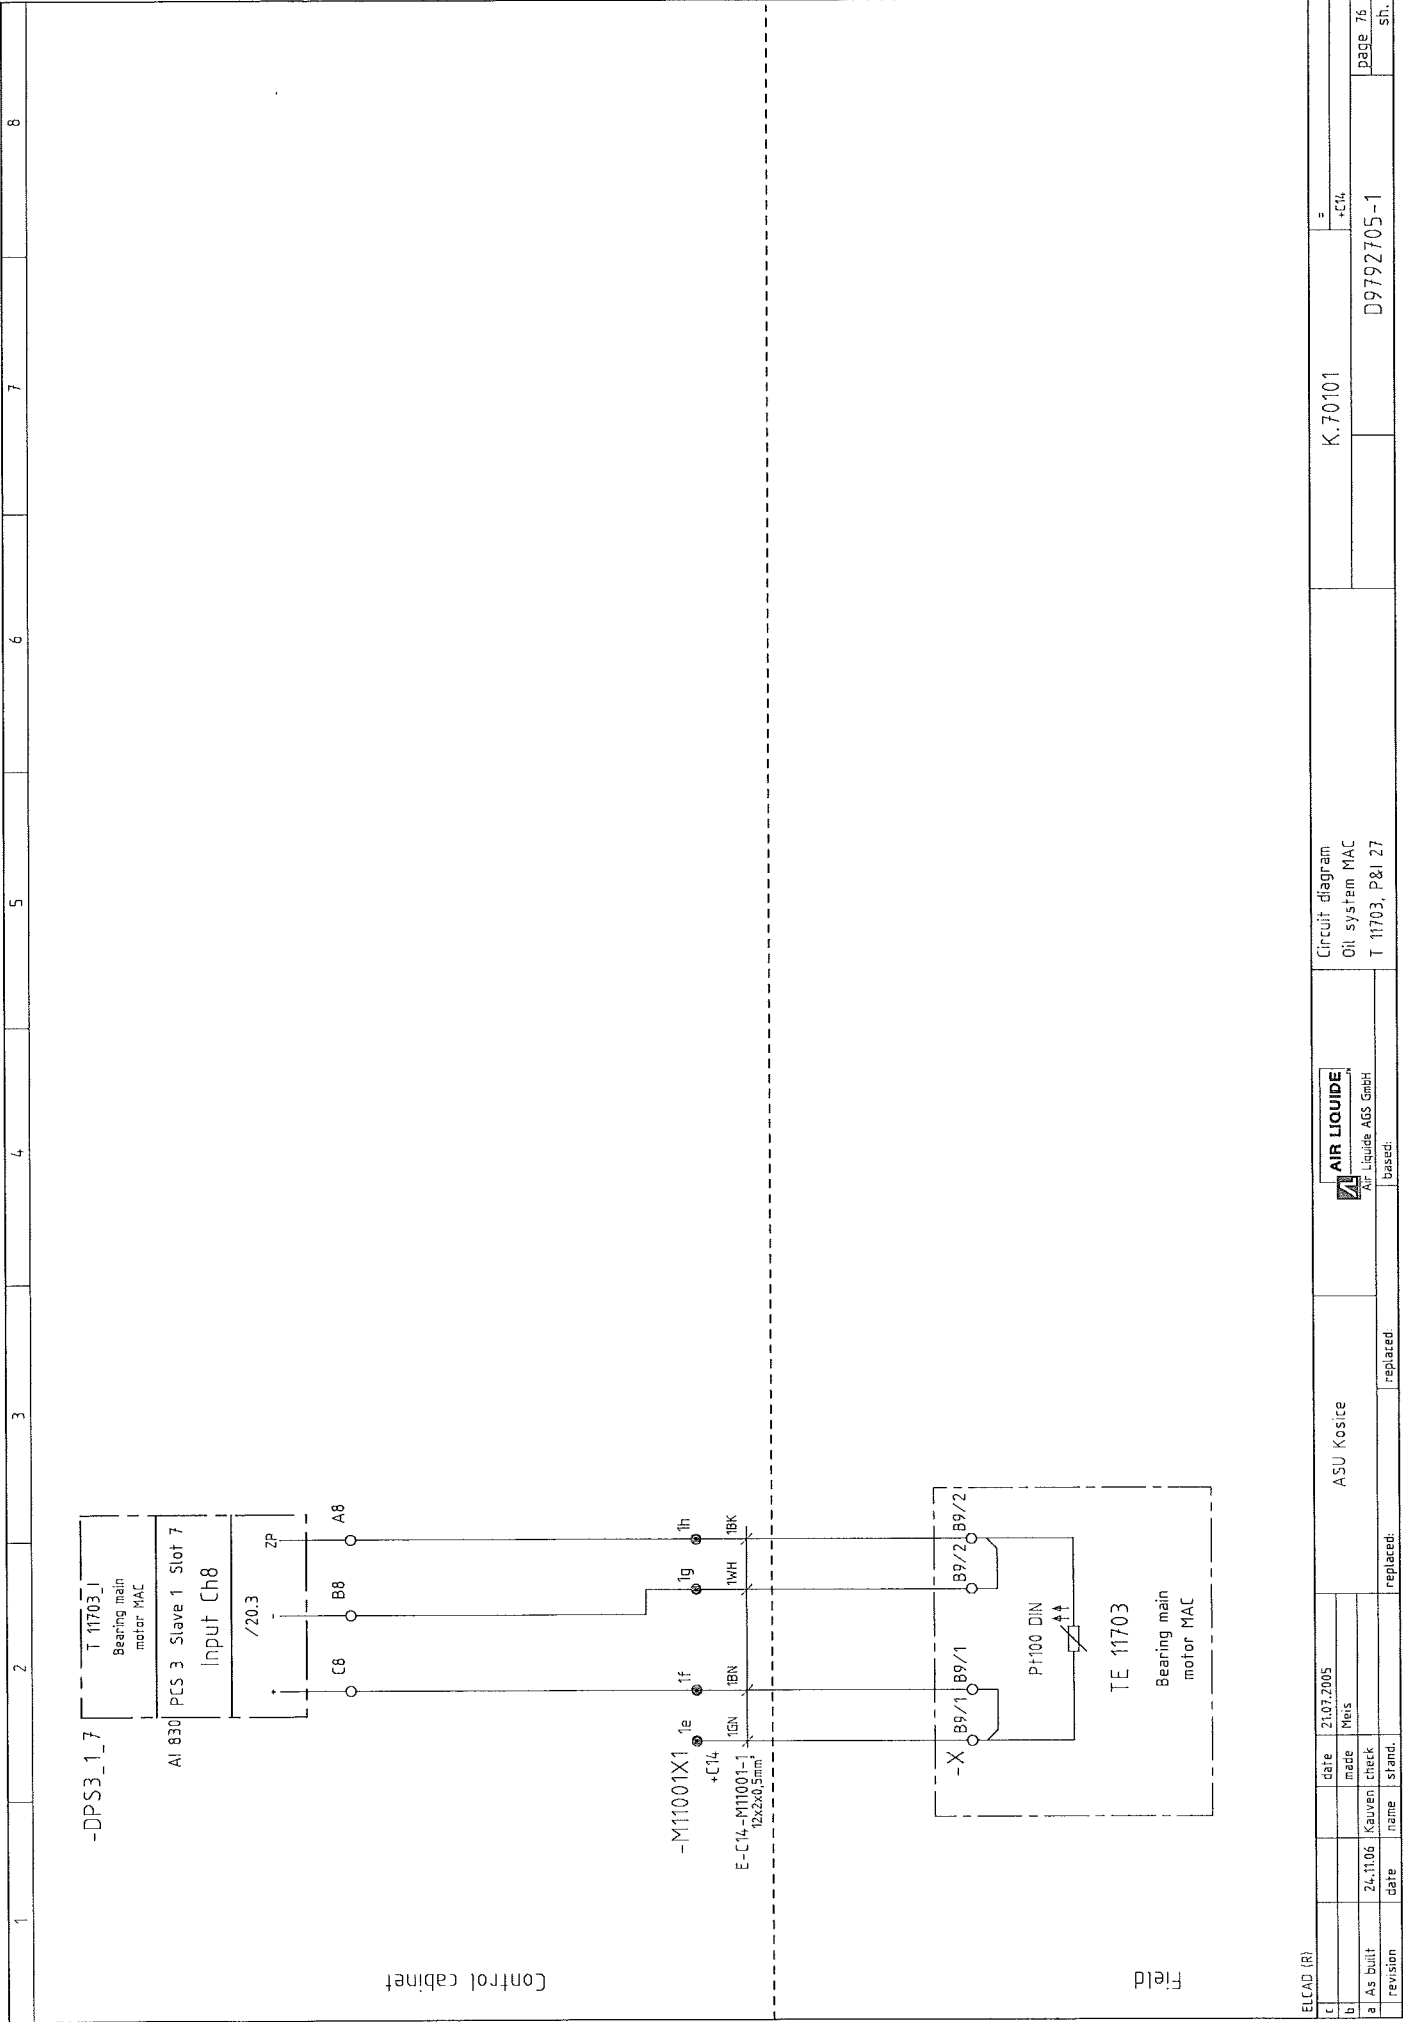


[illegible]

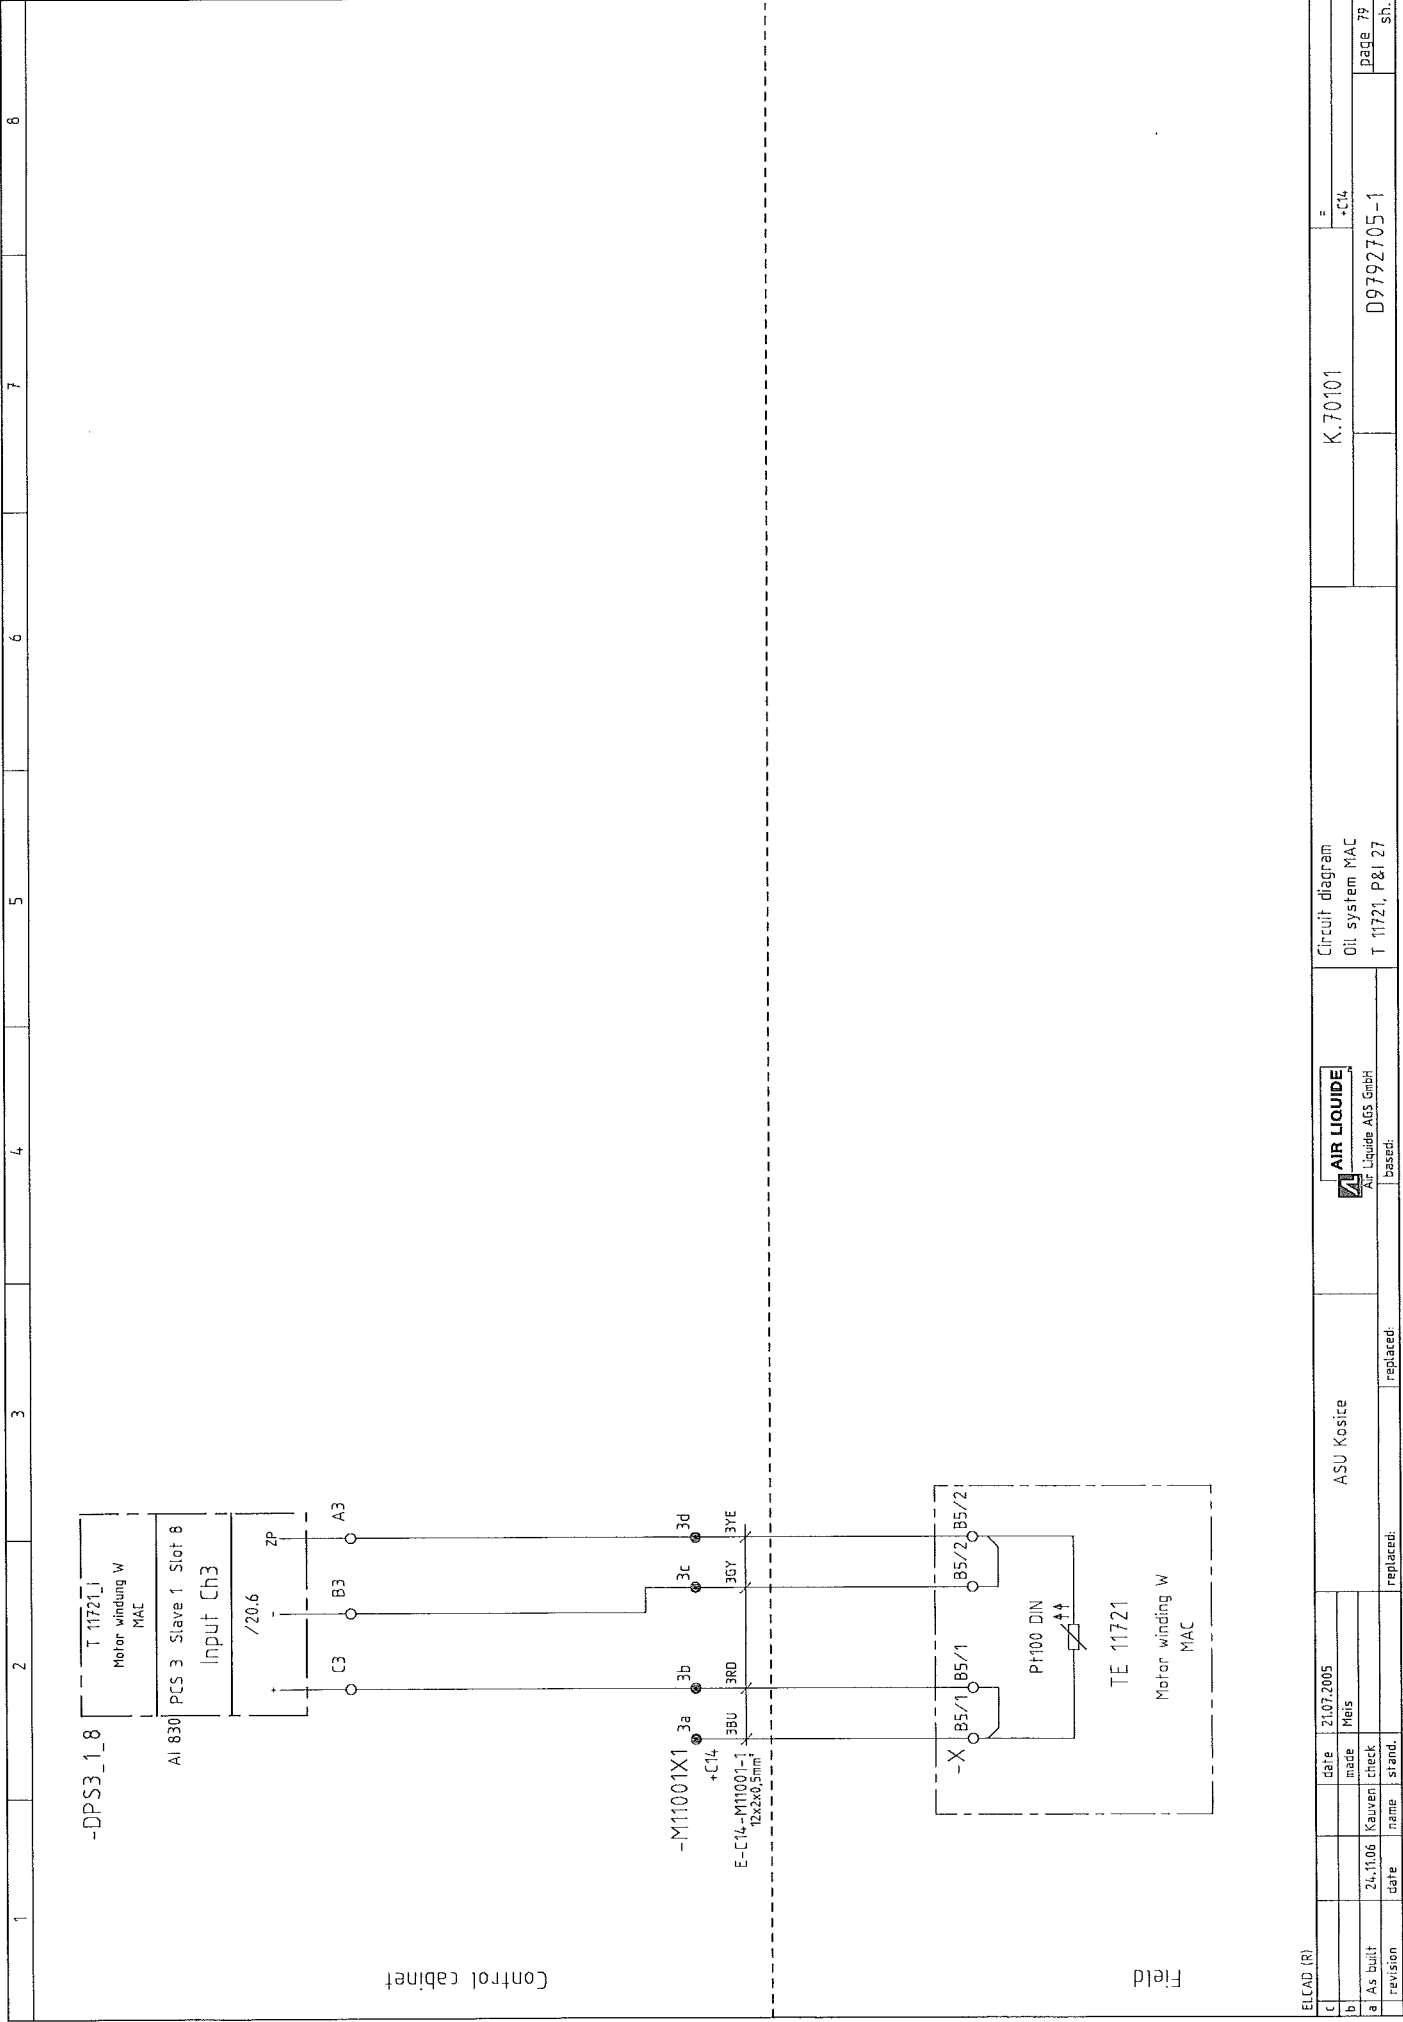


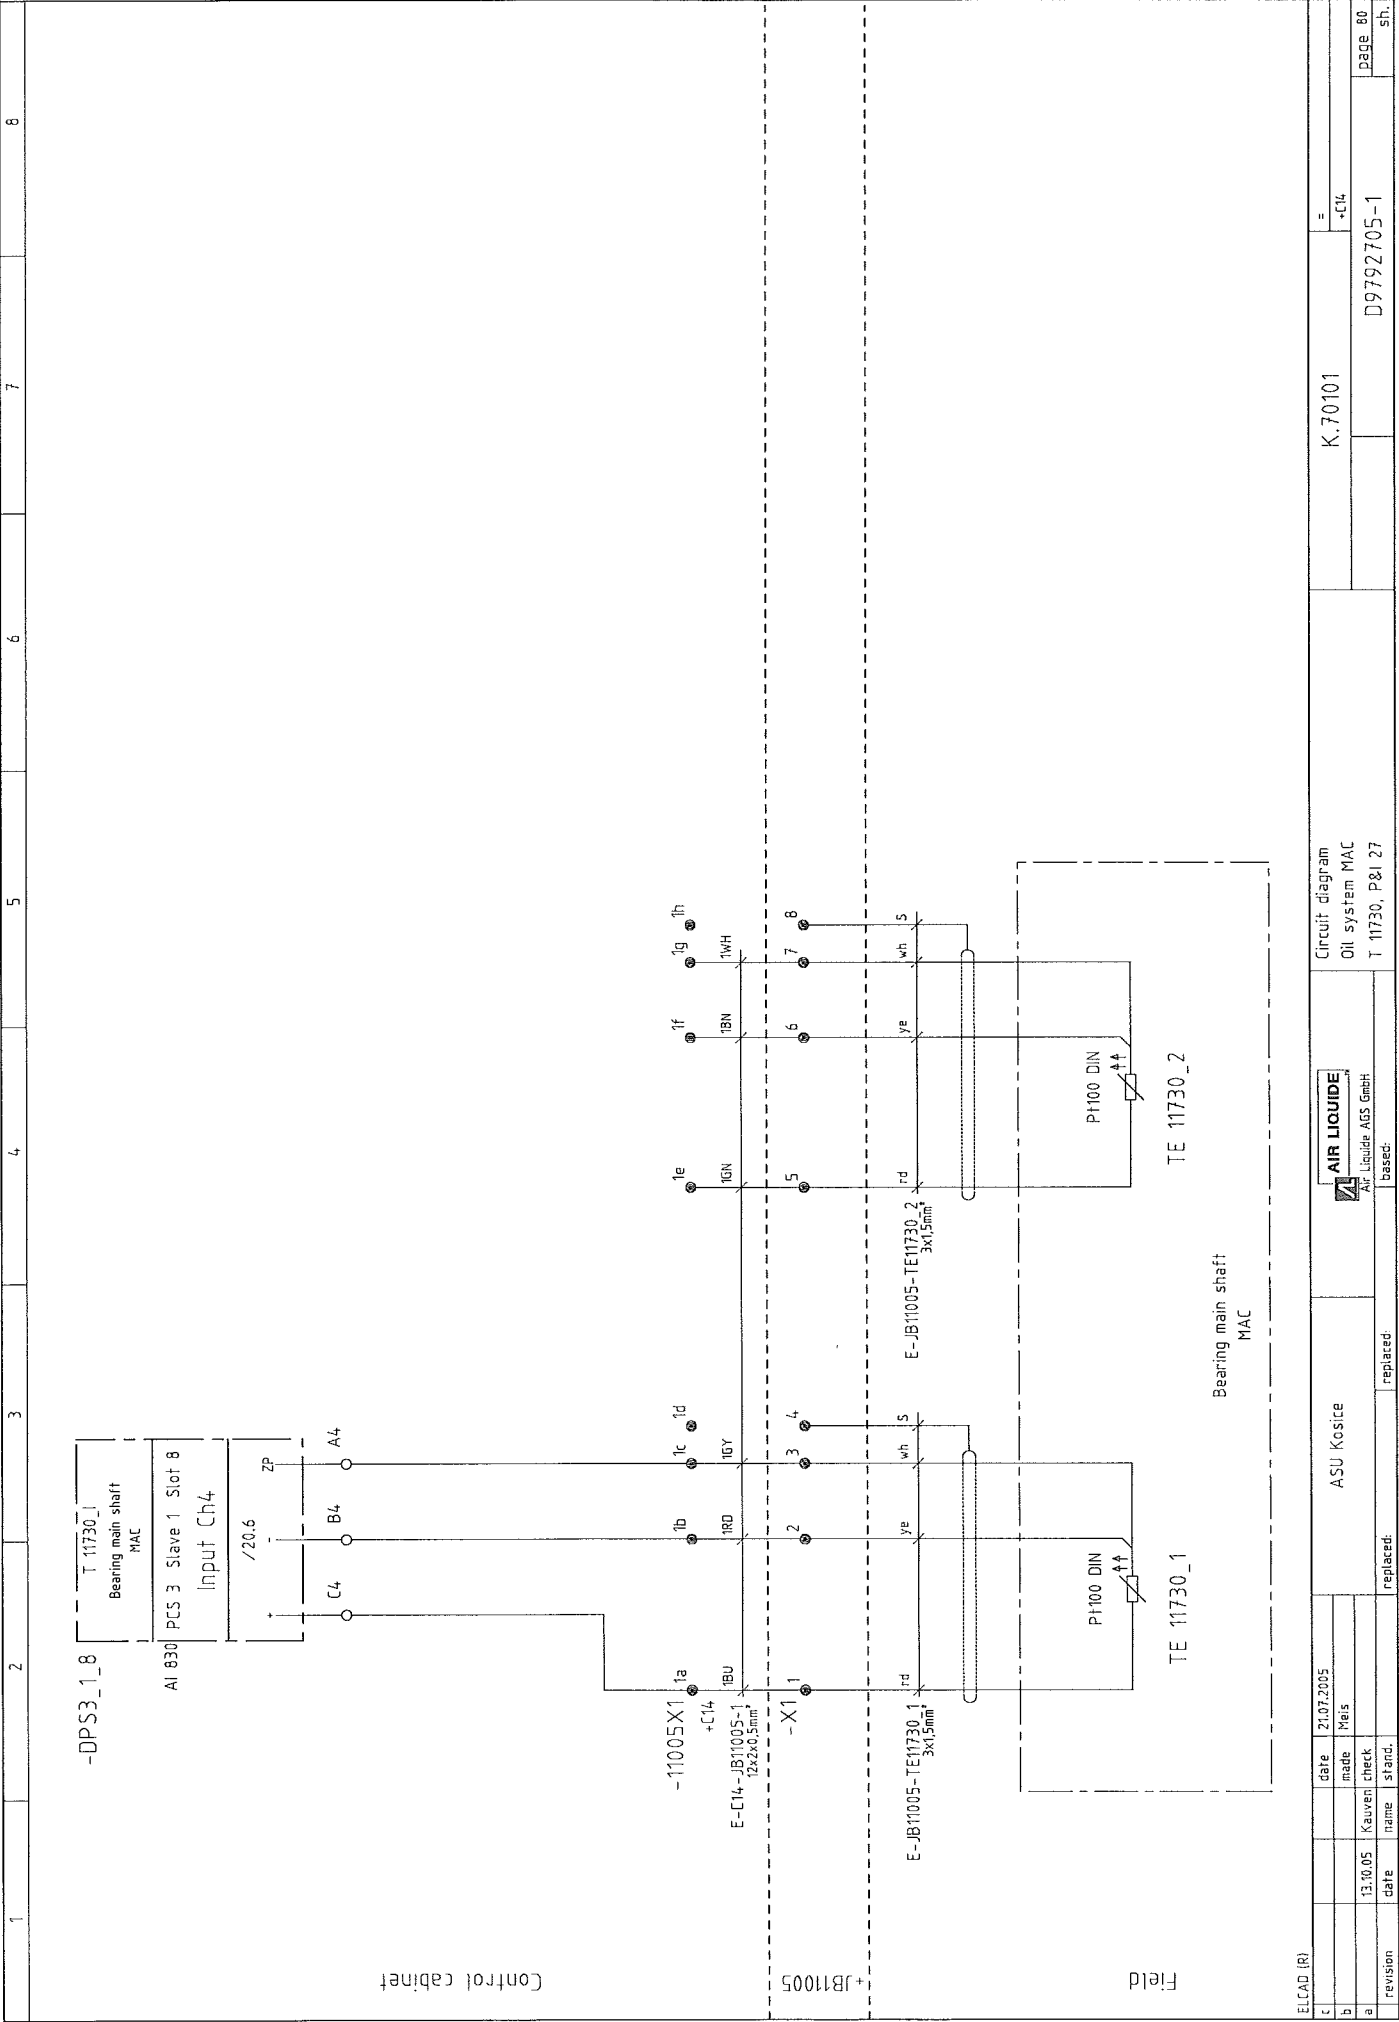


1		2	3	4	5	6	7	8
		Control cabinet						
		Field						
		+JB11005						
		Bearing main shaft MAC						
		<div> <div> <div>-DPS3_1_8</div> <div>T 11733_1</div> <div>Bearing main shaft</div> <div>MAC</div> </div> <div> <div>AI 830</div> <div>PCS 3 Slave 1 Slot 8</div> <div>Input Ch5</div> </div> <div> <div>/20.6</div> <div>ZP</div> <div>C5</div> <div>B5</div> <div>A5</div> </div> </div> <div> <div>-11005X1</div> <div>2a</div> <div>+C14</div> <div>E-C14-JB11005-1</div> <div>12x2x0.5mm</div> <div>-X1</div> <div>9</div> </div> <div> <div>2b</div> <div>2c</div> <div>2d</div> </div> <div> <div>2a</div> 4								
5								
6								
7								
8								

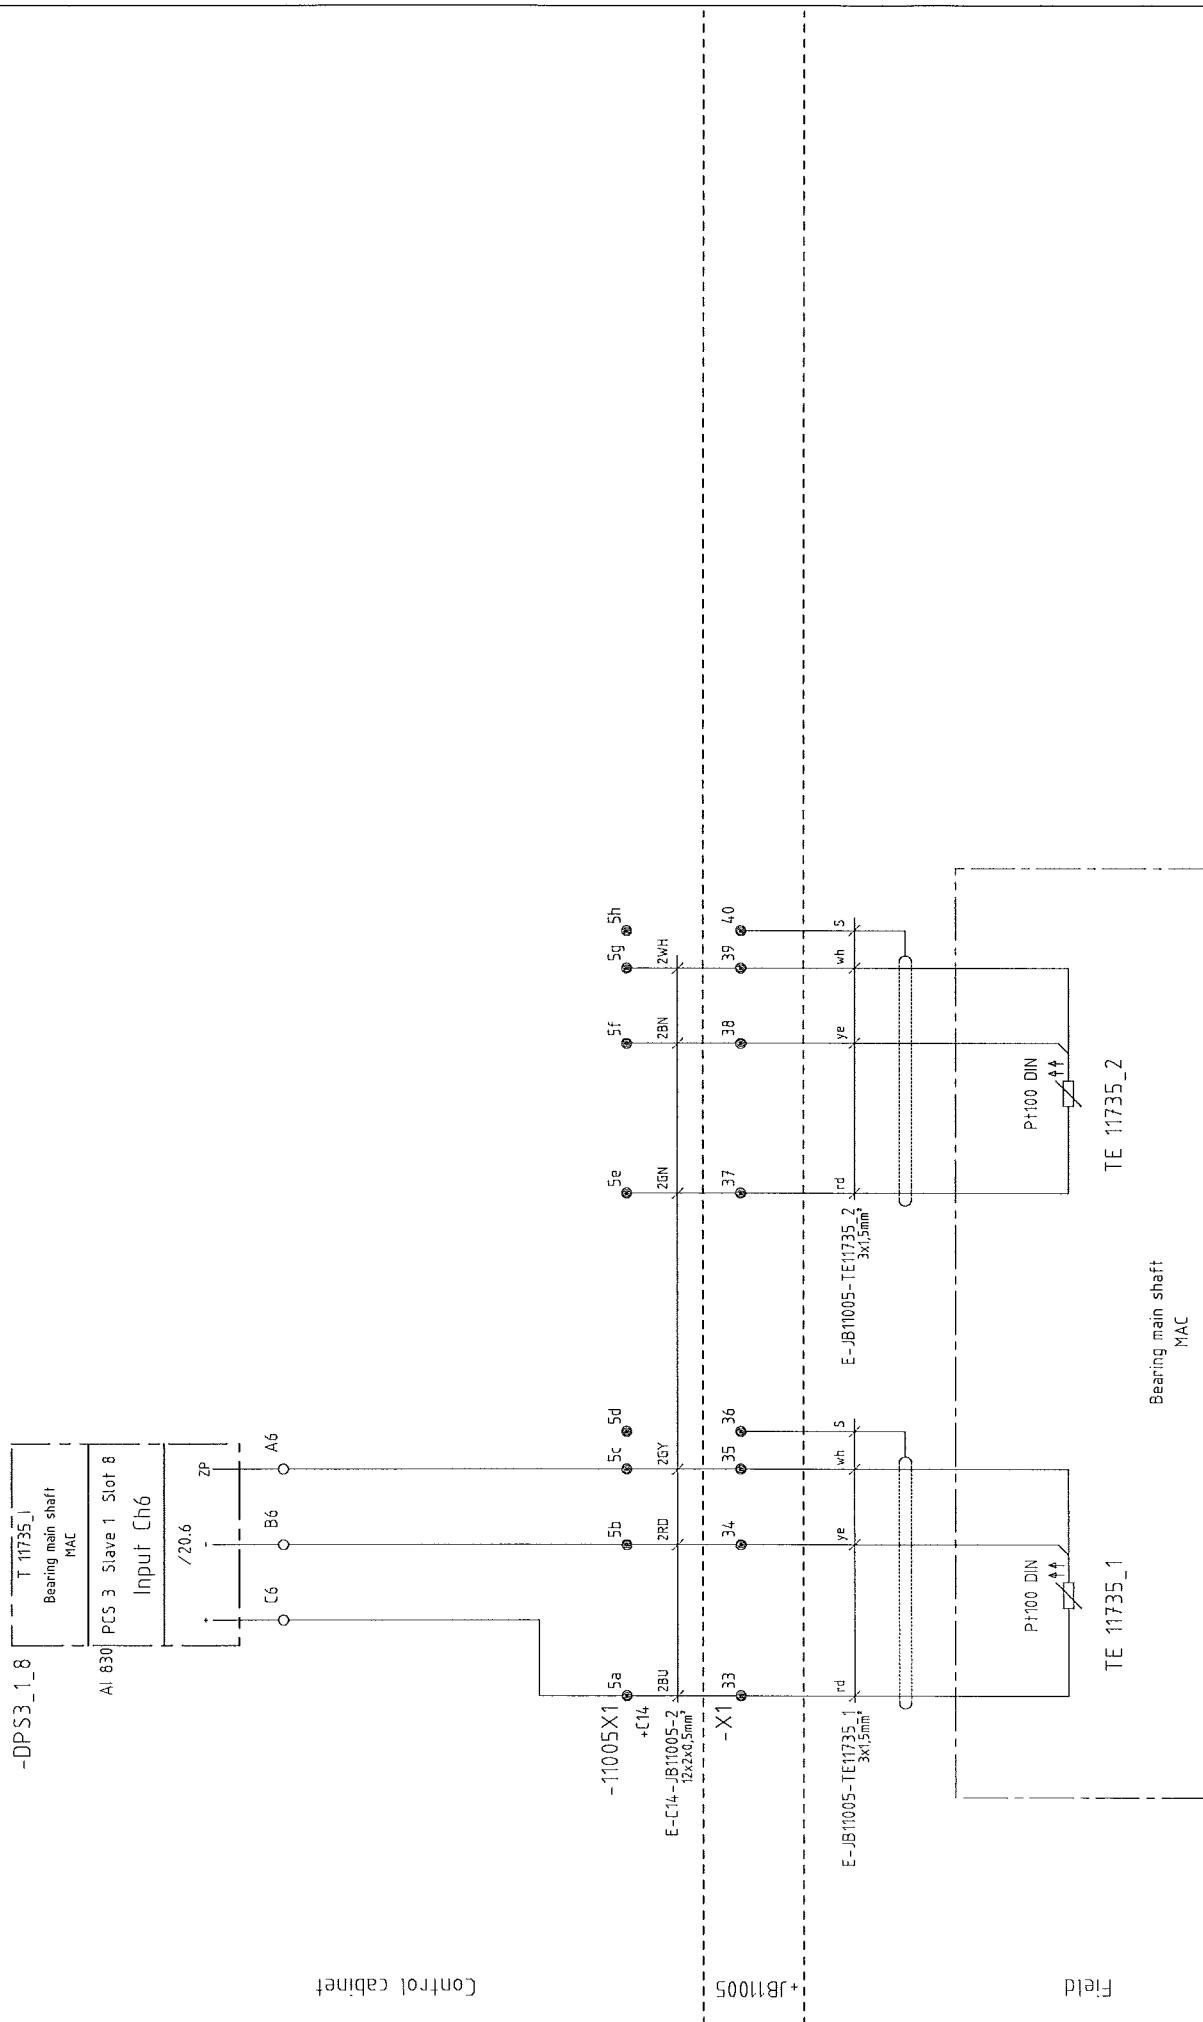
[illegible]

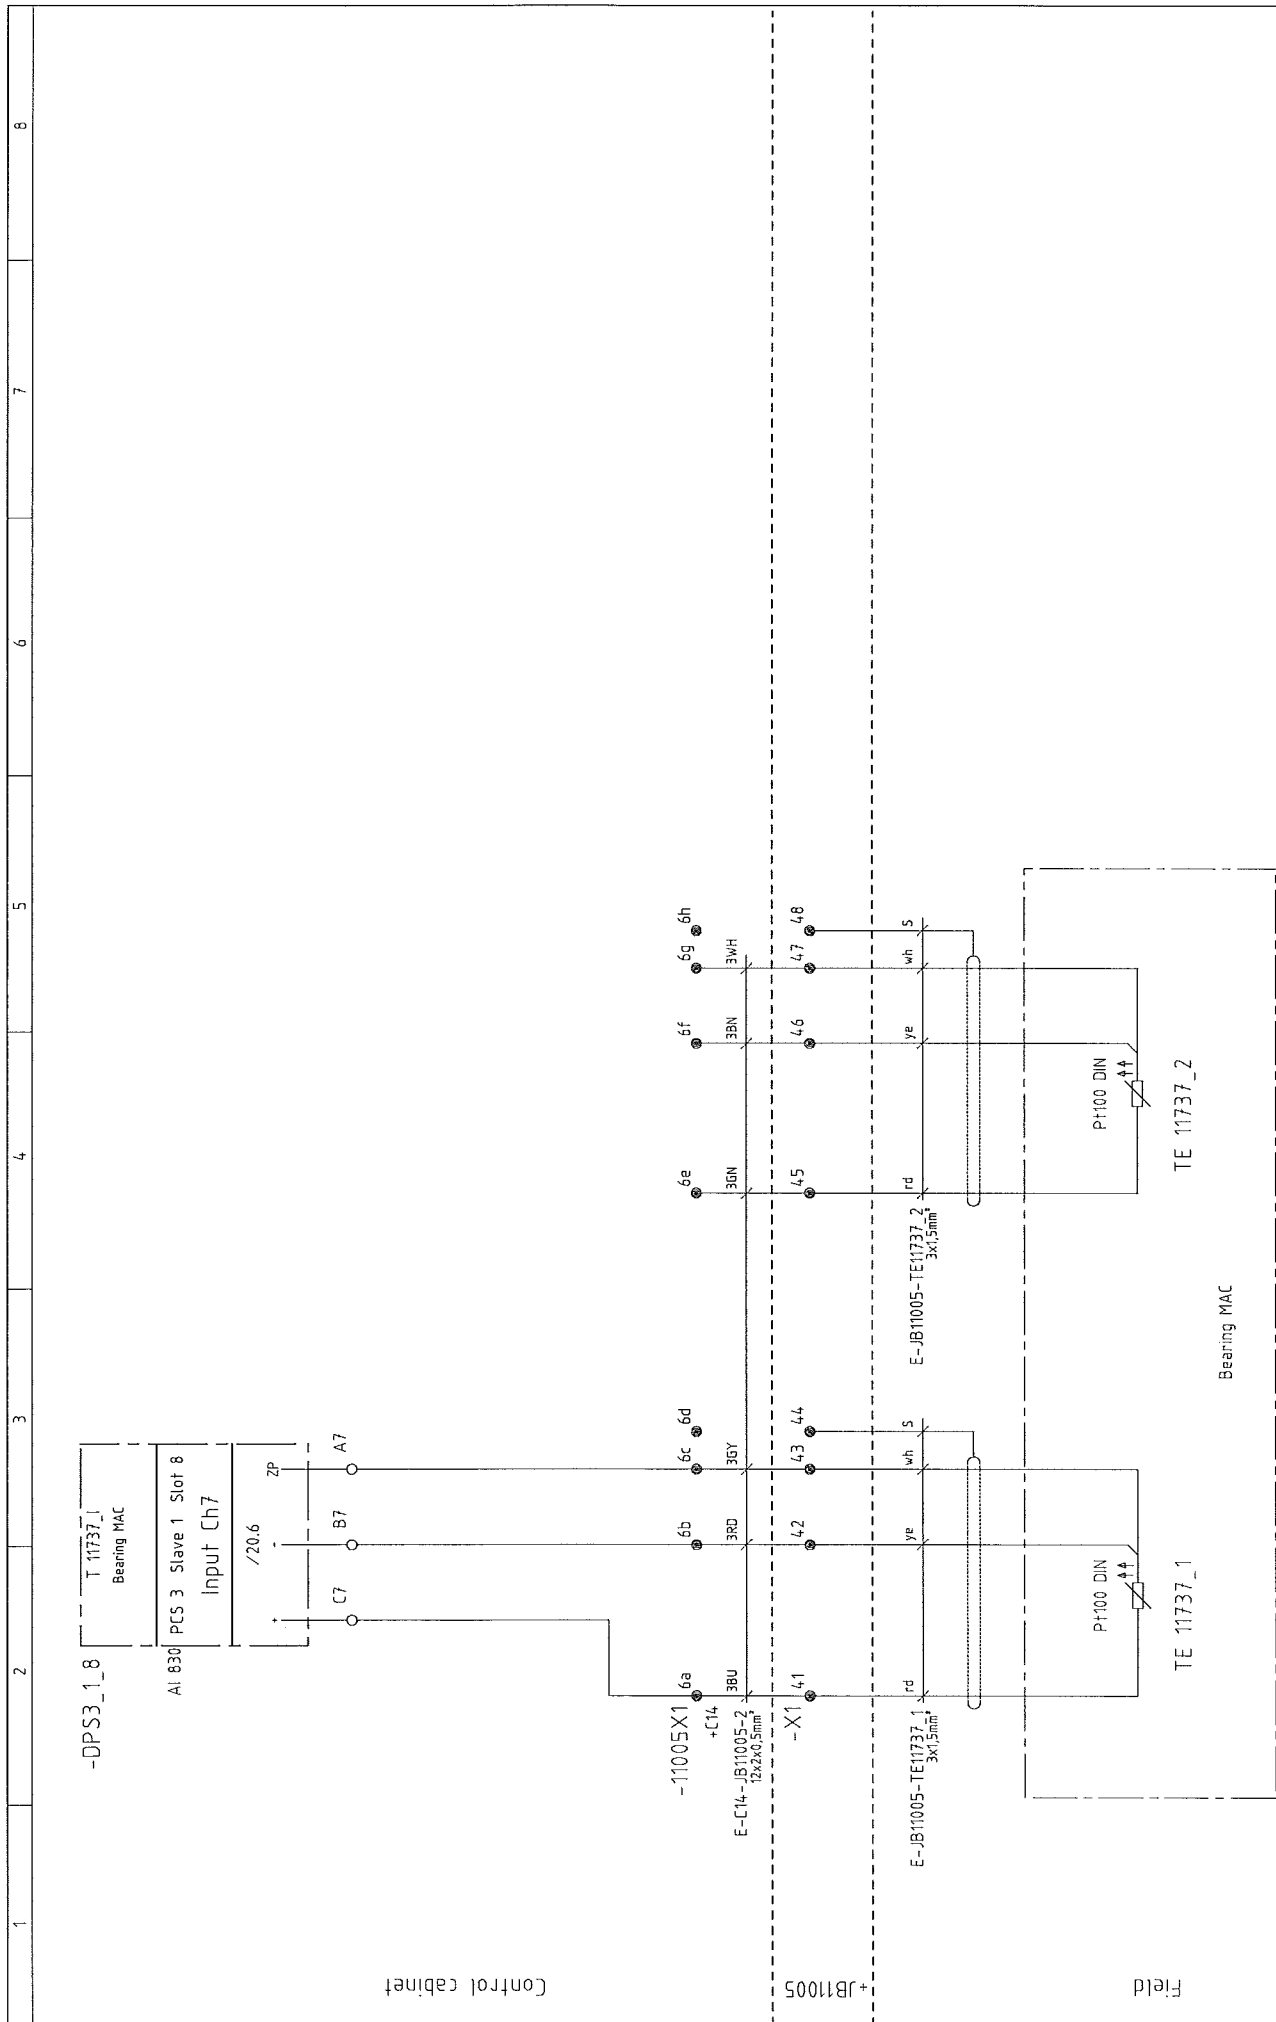


ELCAD (R)									
c			date	21.02.2005					
b			made	Meis					
a	13.10.05	Kauven	check						
	revision	date	name	stand.	replaced:		replaced:		
					<div style="display: flex; align-items: center;"> <div style="border: 1px solid black; padding: 2px; margin-right: 5px;"> </div> <div> <p>AIR LIQUIDE</p> <p>Air Liquide AGS GmbH</p> <p>based:</p> </div> </div>				
					<p>Circuit diagram</p> <p>Oil system MAC</p> <p>T 11737, P&I 27</p>				
					K.70101				
					=				
					+C14				
					D9792705-1				
					page 63				
					sh.				

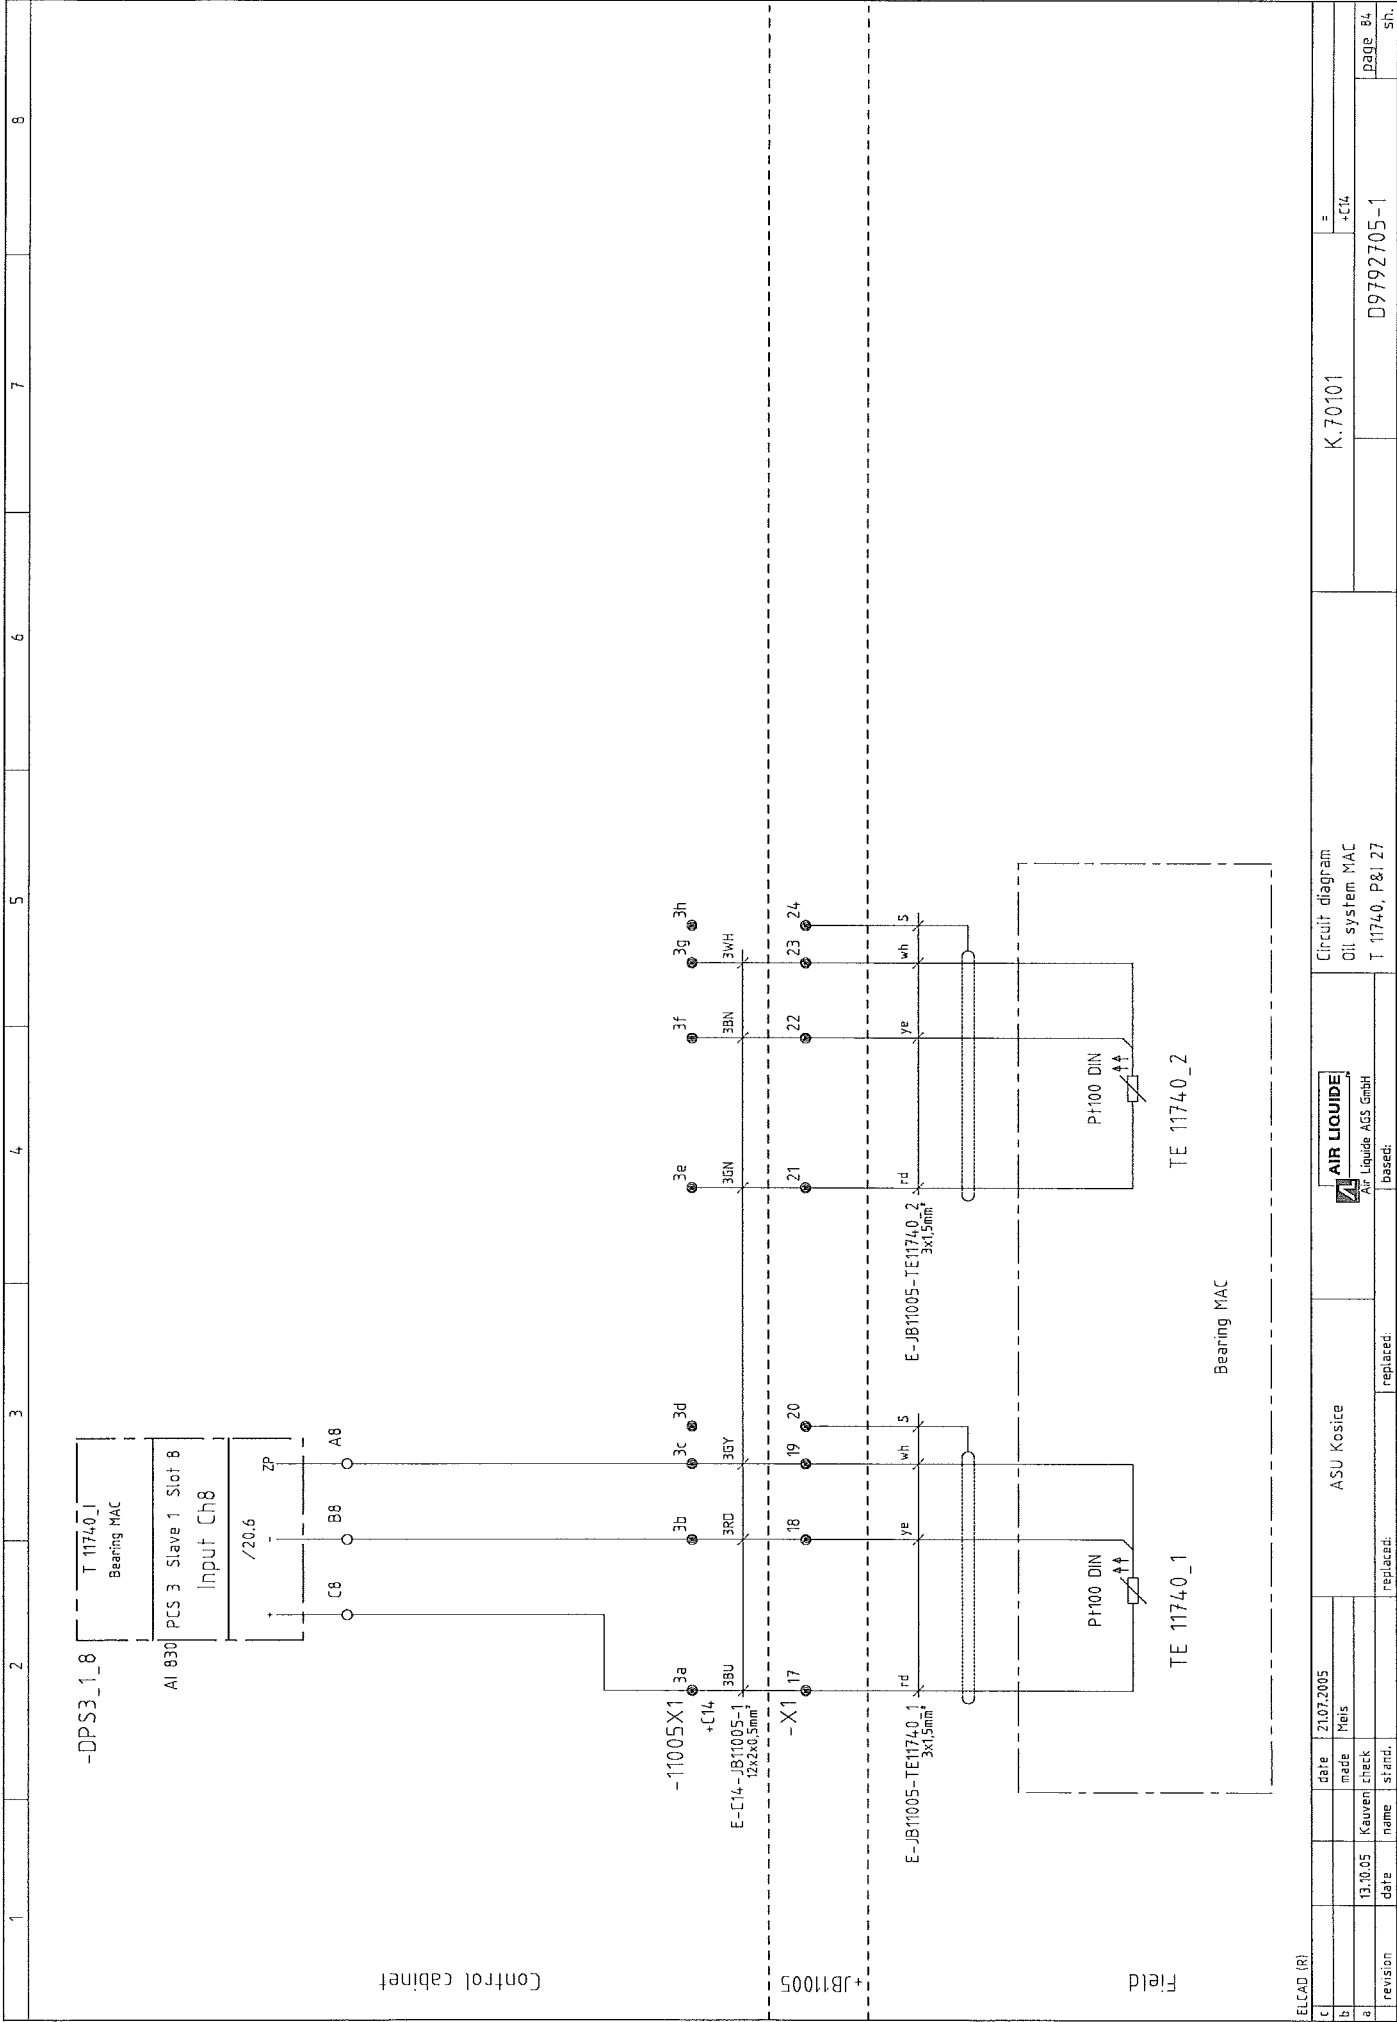

ELCAD (R)	date	21.07.2005	ASU Kosice	Circuit diagram	K.70101	
c	made	Mels		Oil system MAC	+C14	
a	revision	13.10.05	replaced:			
	date		replaced:			
	name					
	stand					
	sh.					
	page					
	D9792705-1					

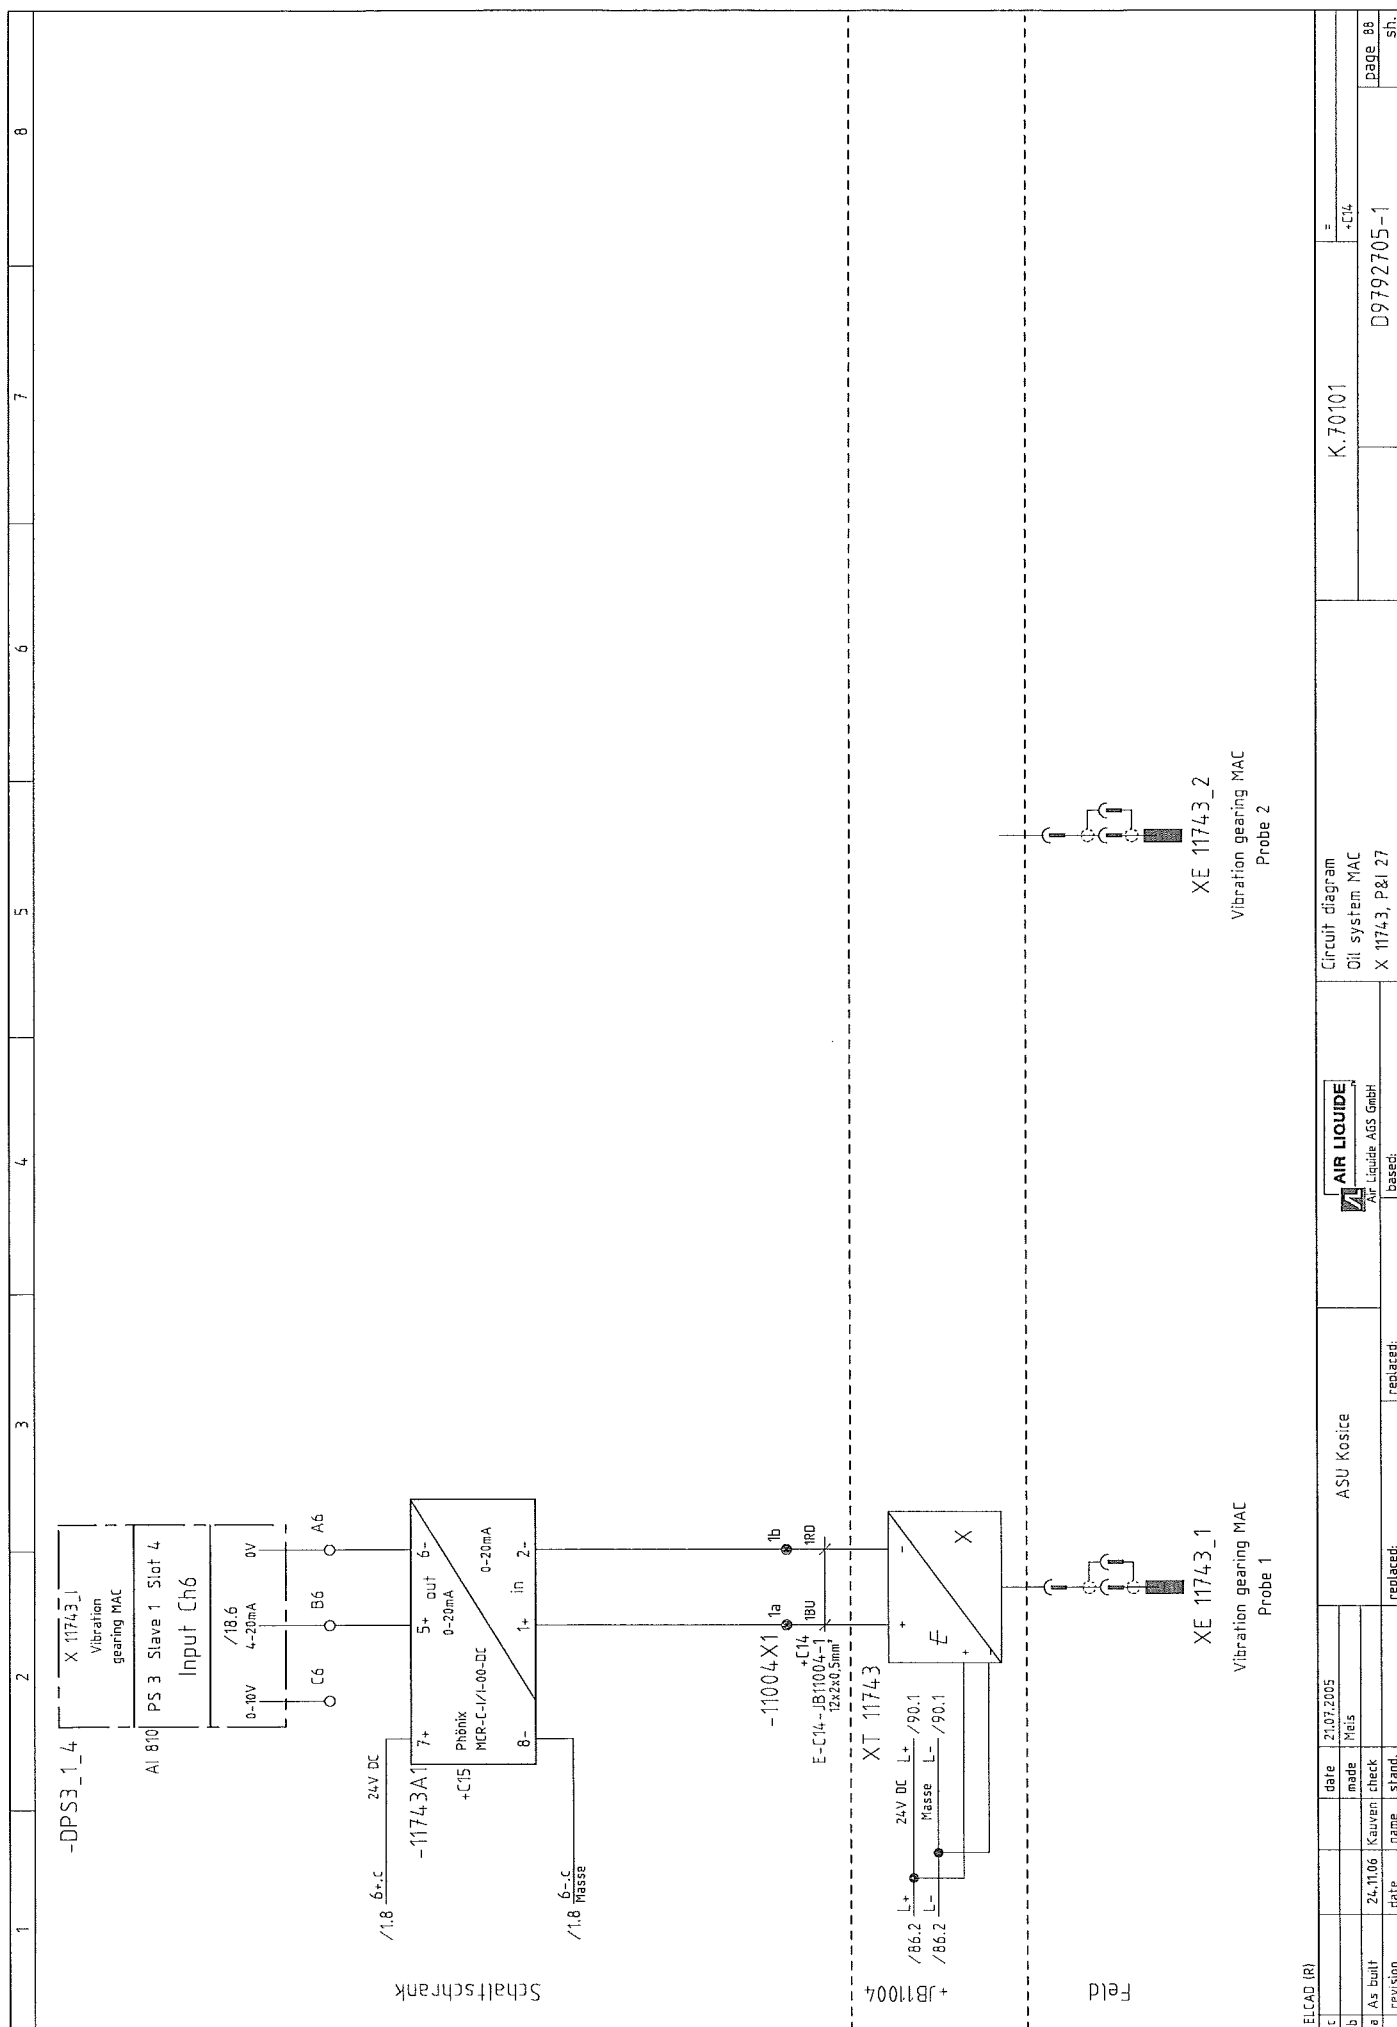

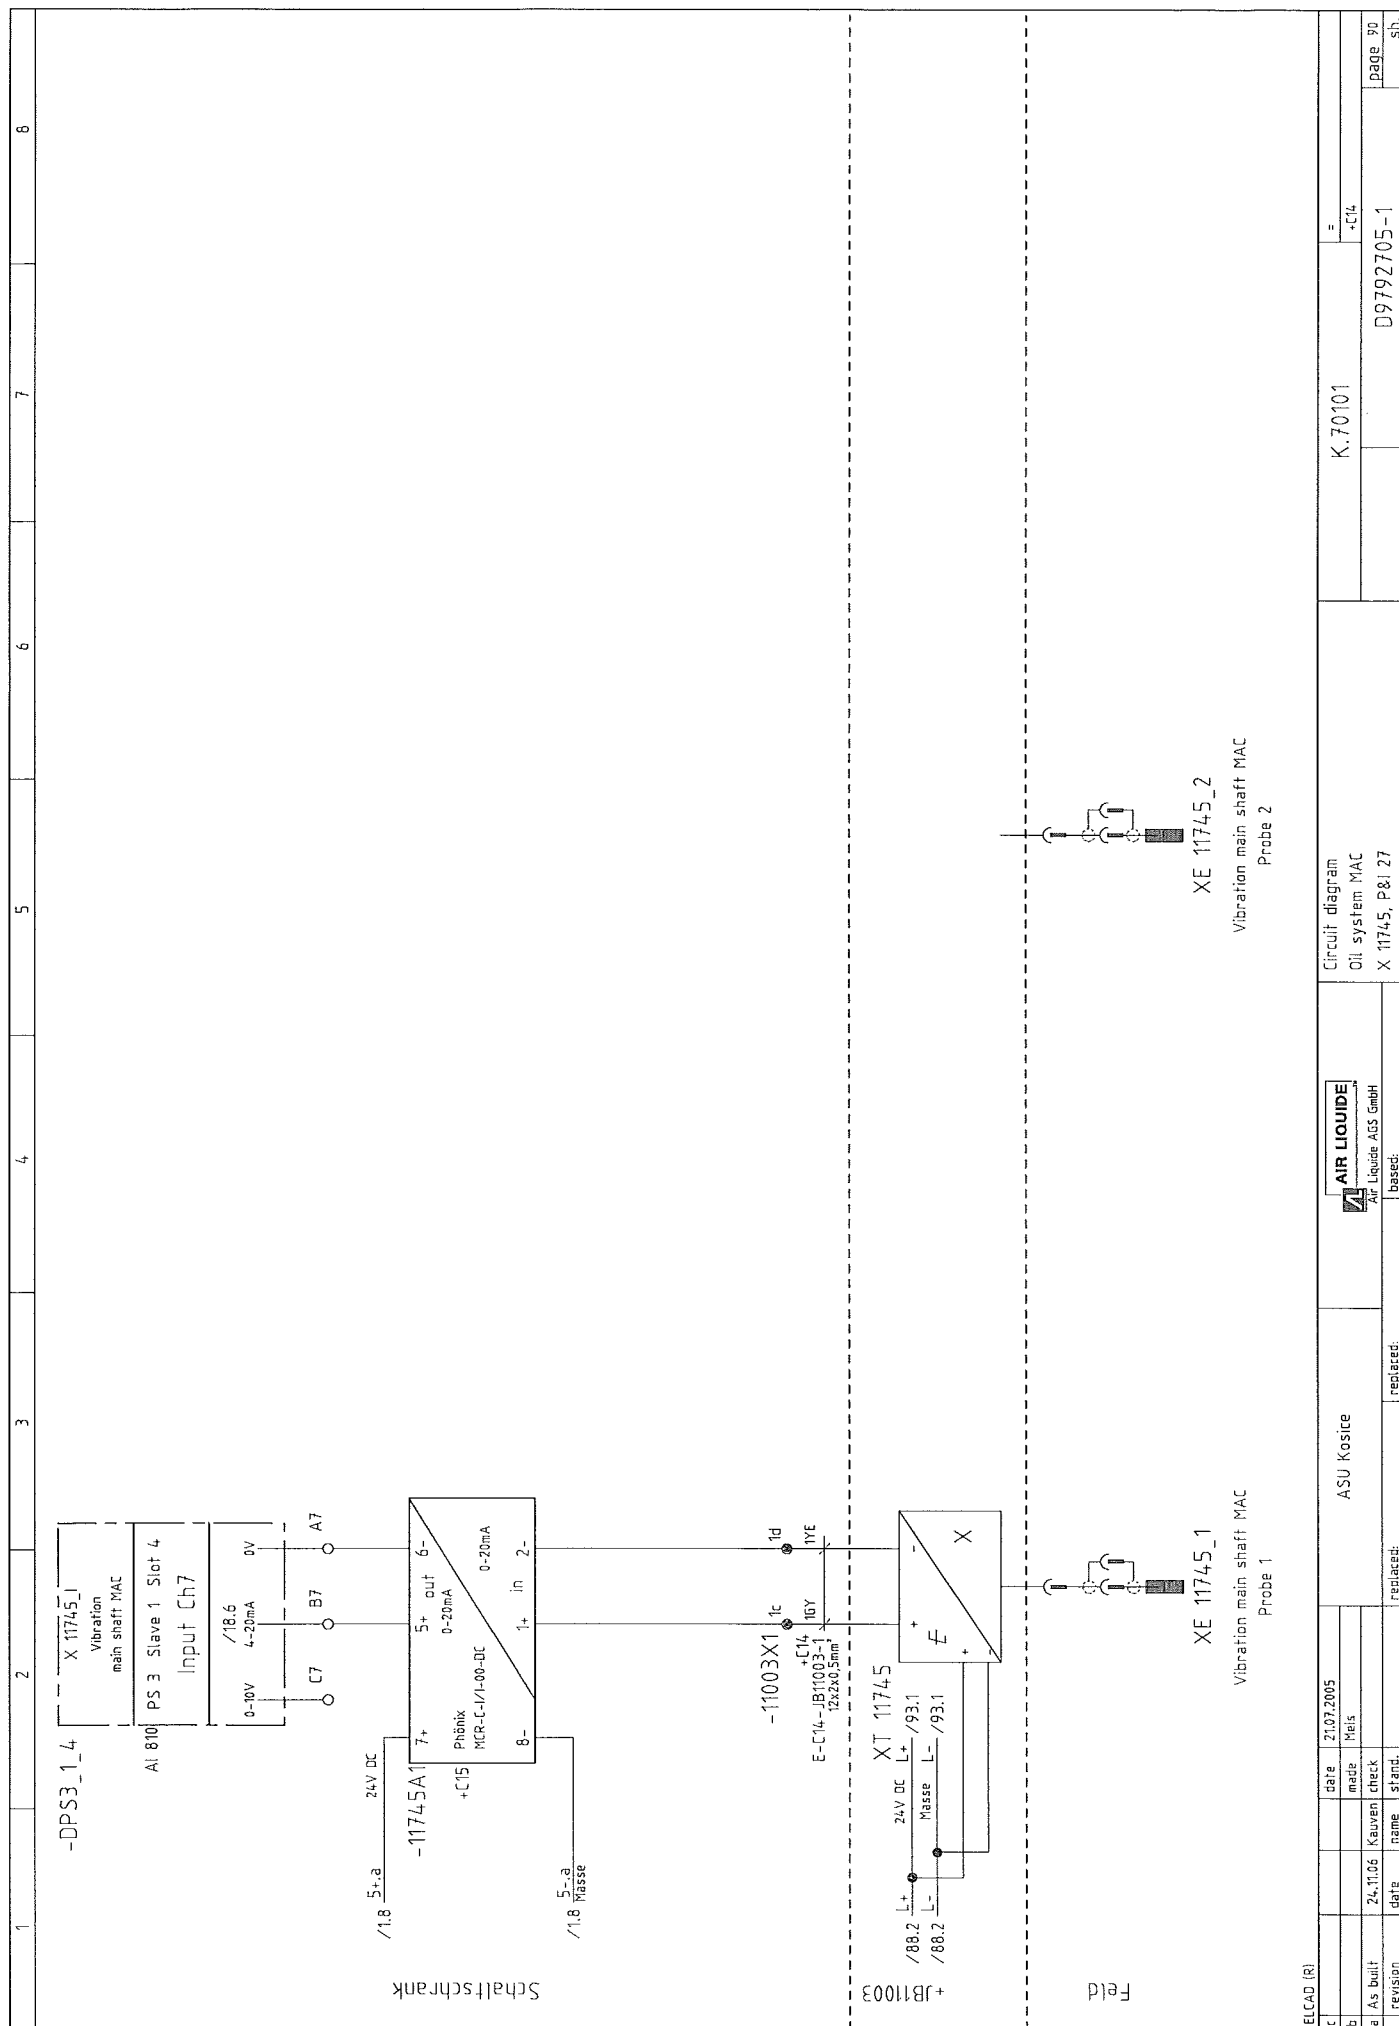










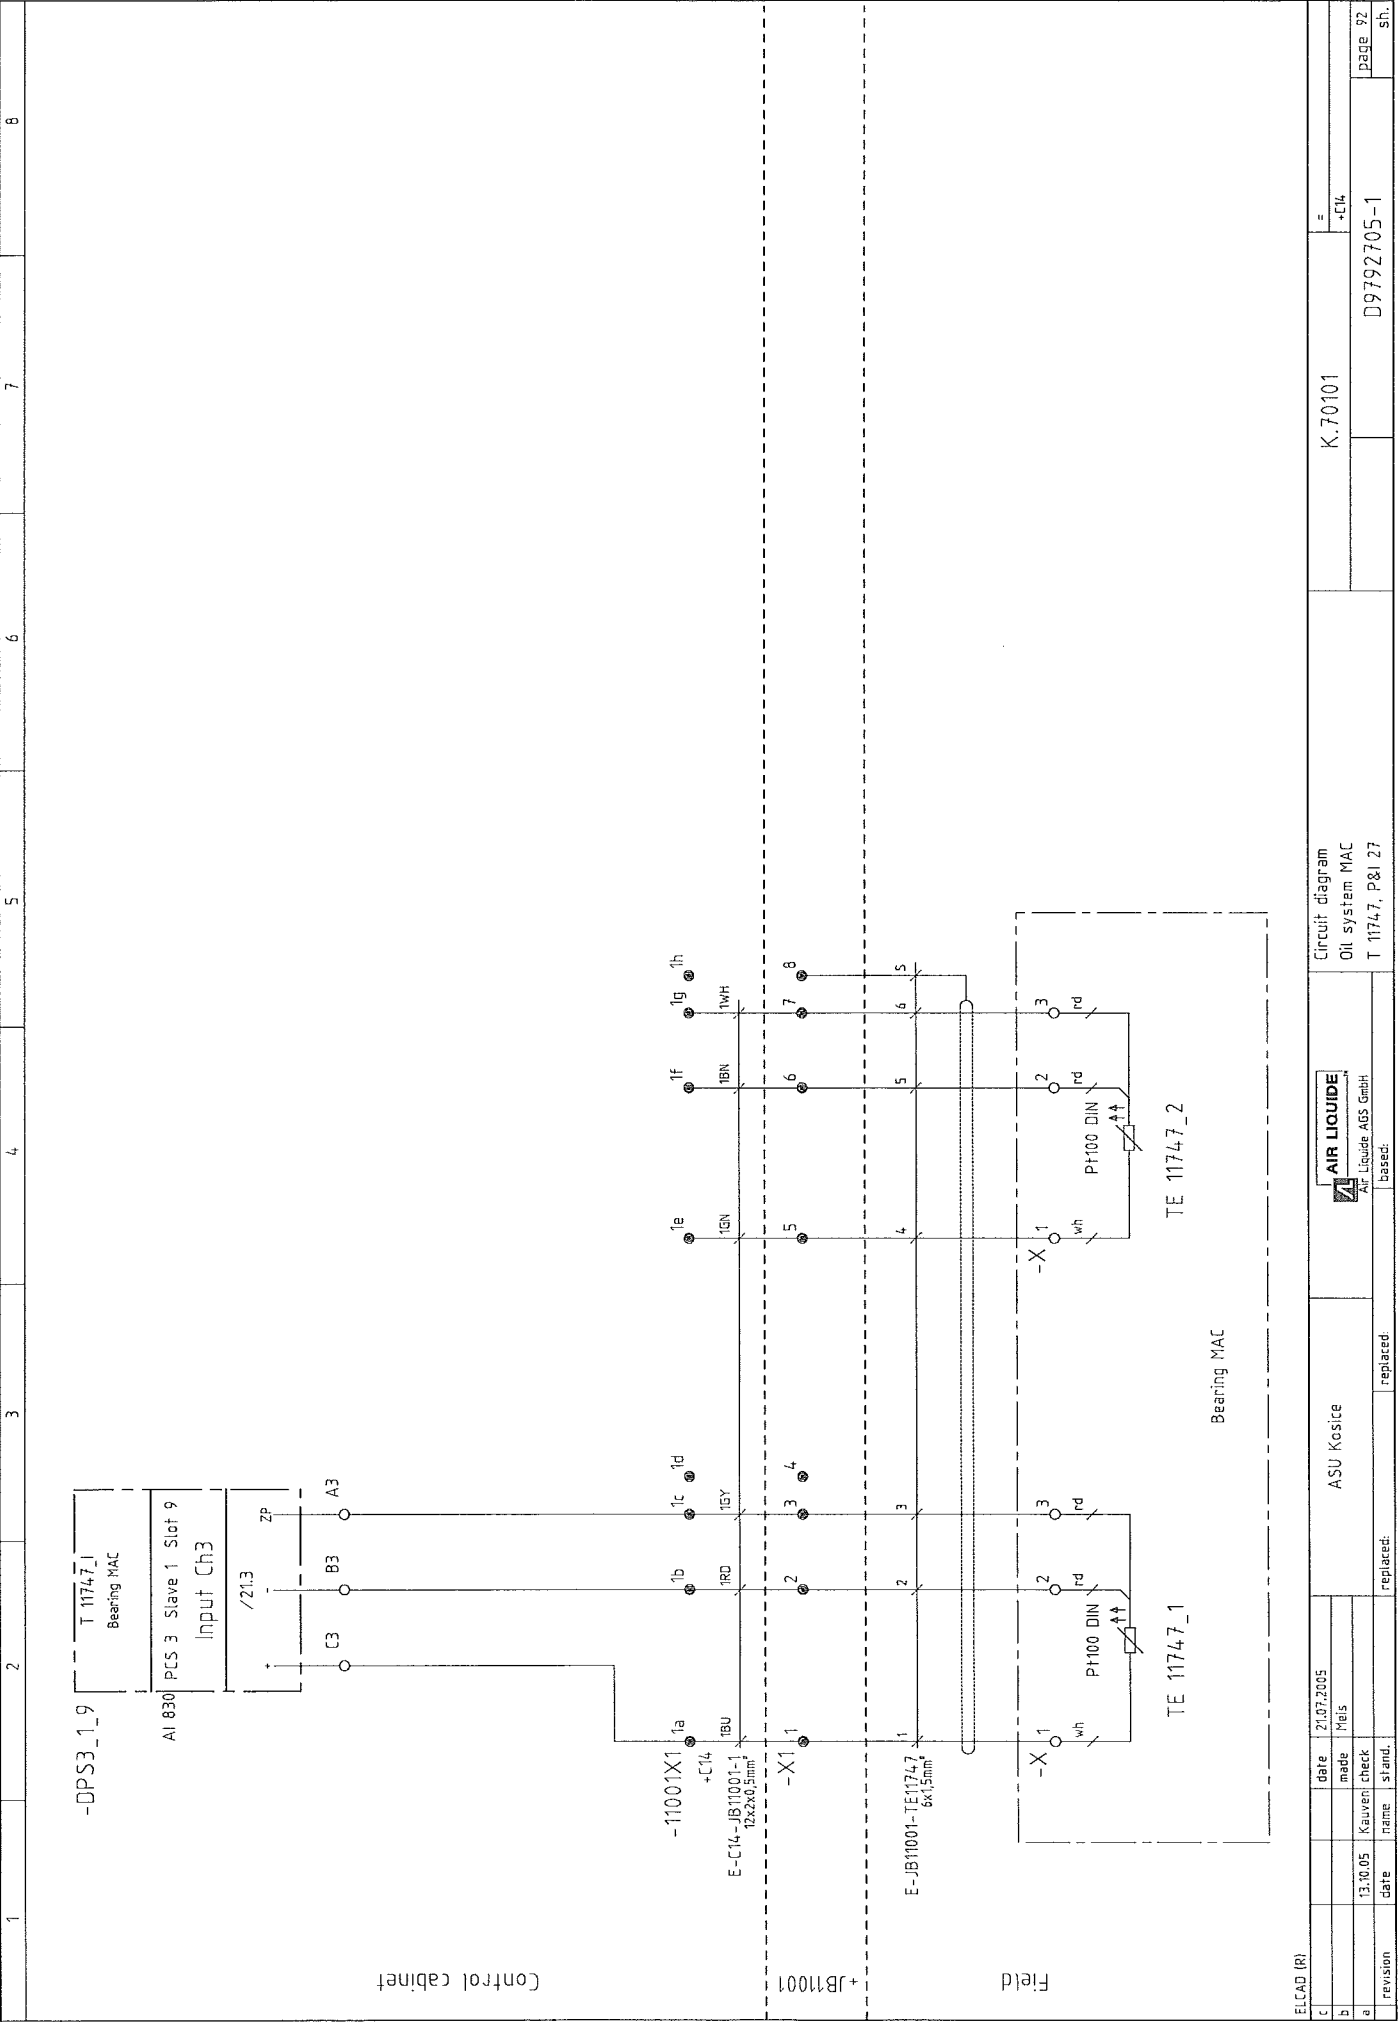

ELCAD (R)		date		21.07.2005		ASU Kosice		Circuit diagram		K.70101		=	
c		date	21.07.2005	made	Meis			Oil system MAC				+C14	
b		13.10.05	Kauven	check				T 1174.7, P&I 27					page 92
a		revision	date	name	stand.	replaced:	replaced:						sh.
												D9792705-1	