


VYKRES VÝSTUŽE (ZÁKLAD PRE BAC)
DRAWING OF REINFORCEMENT (FOUNDATION FOR BAC)

WYSTUŻENIE V STREDE ZÁKLADU (-0.850) M 1:25
REINFORCEMENT OF FOUNDATION CENTRE (-0.850) SCALE 1:25

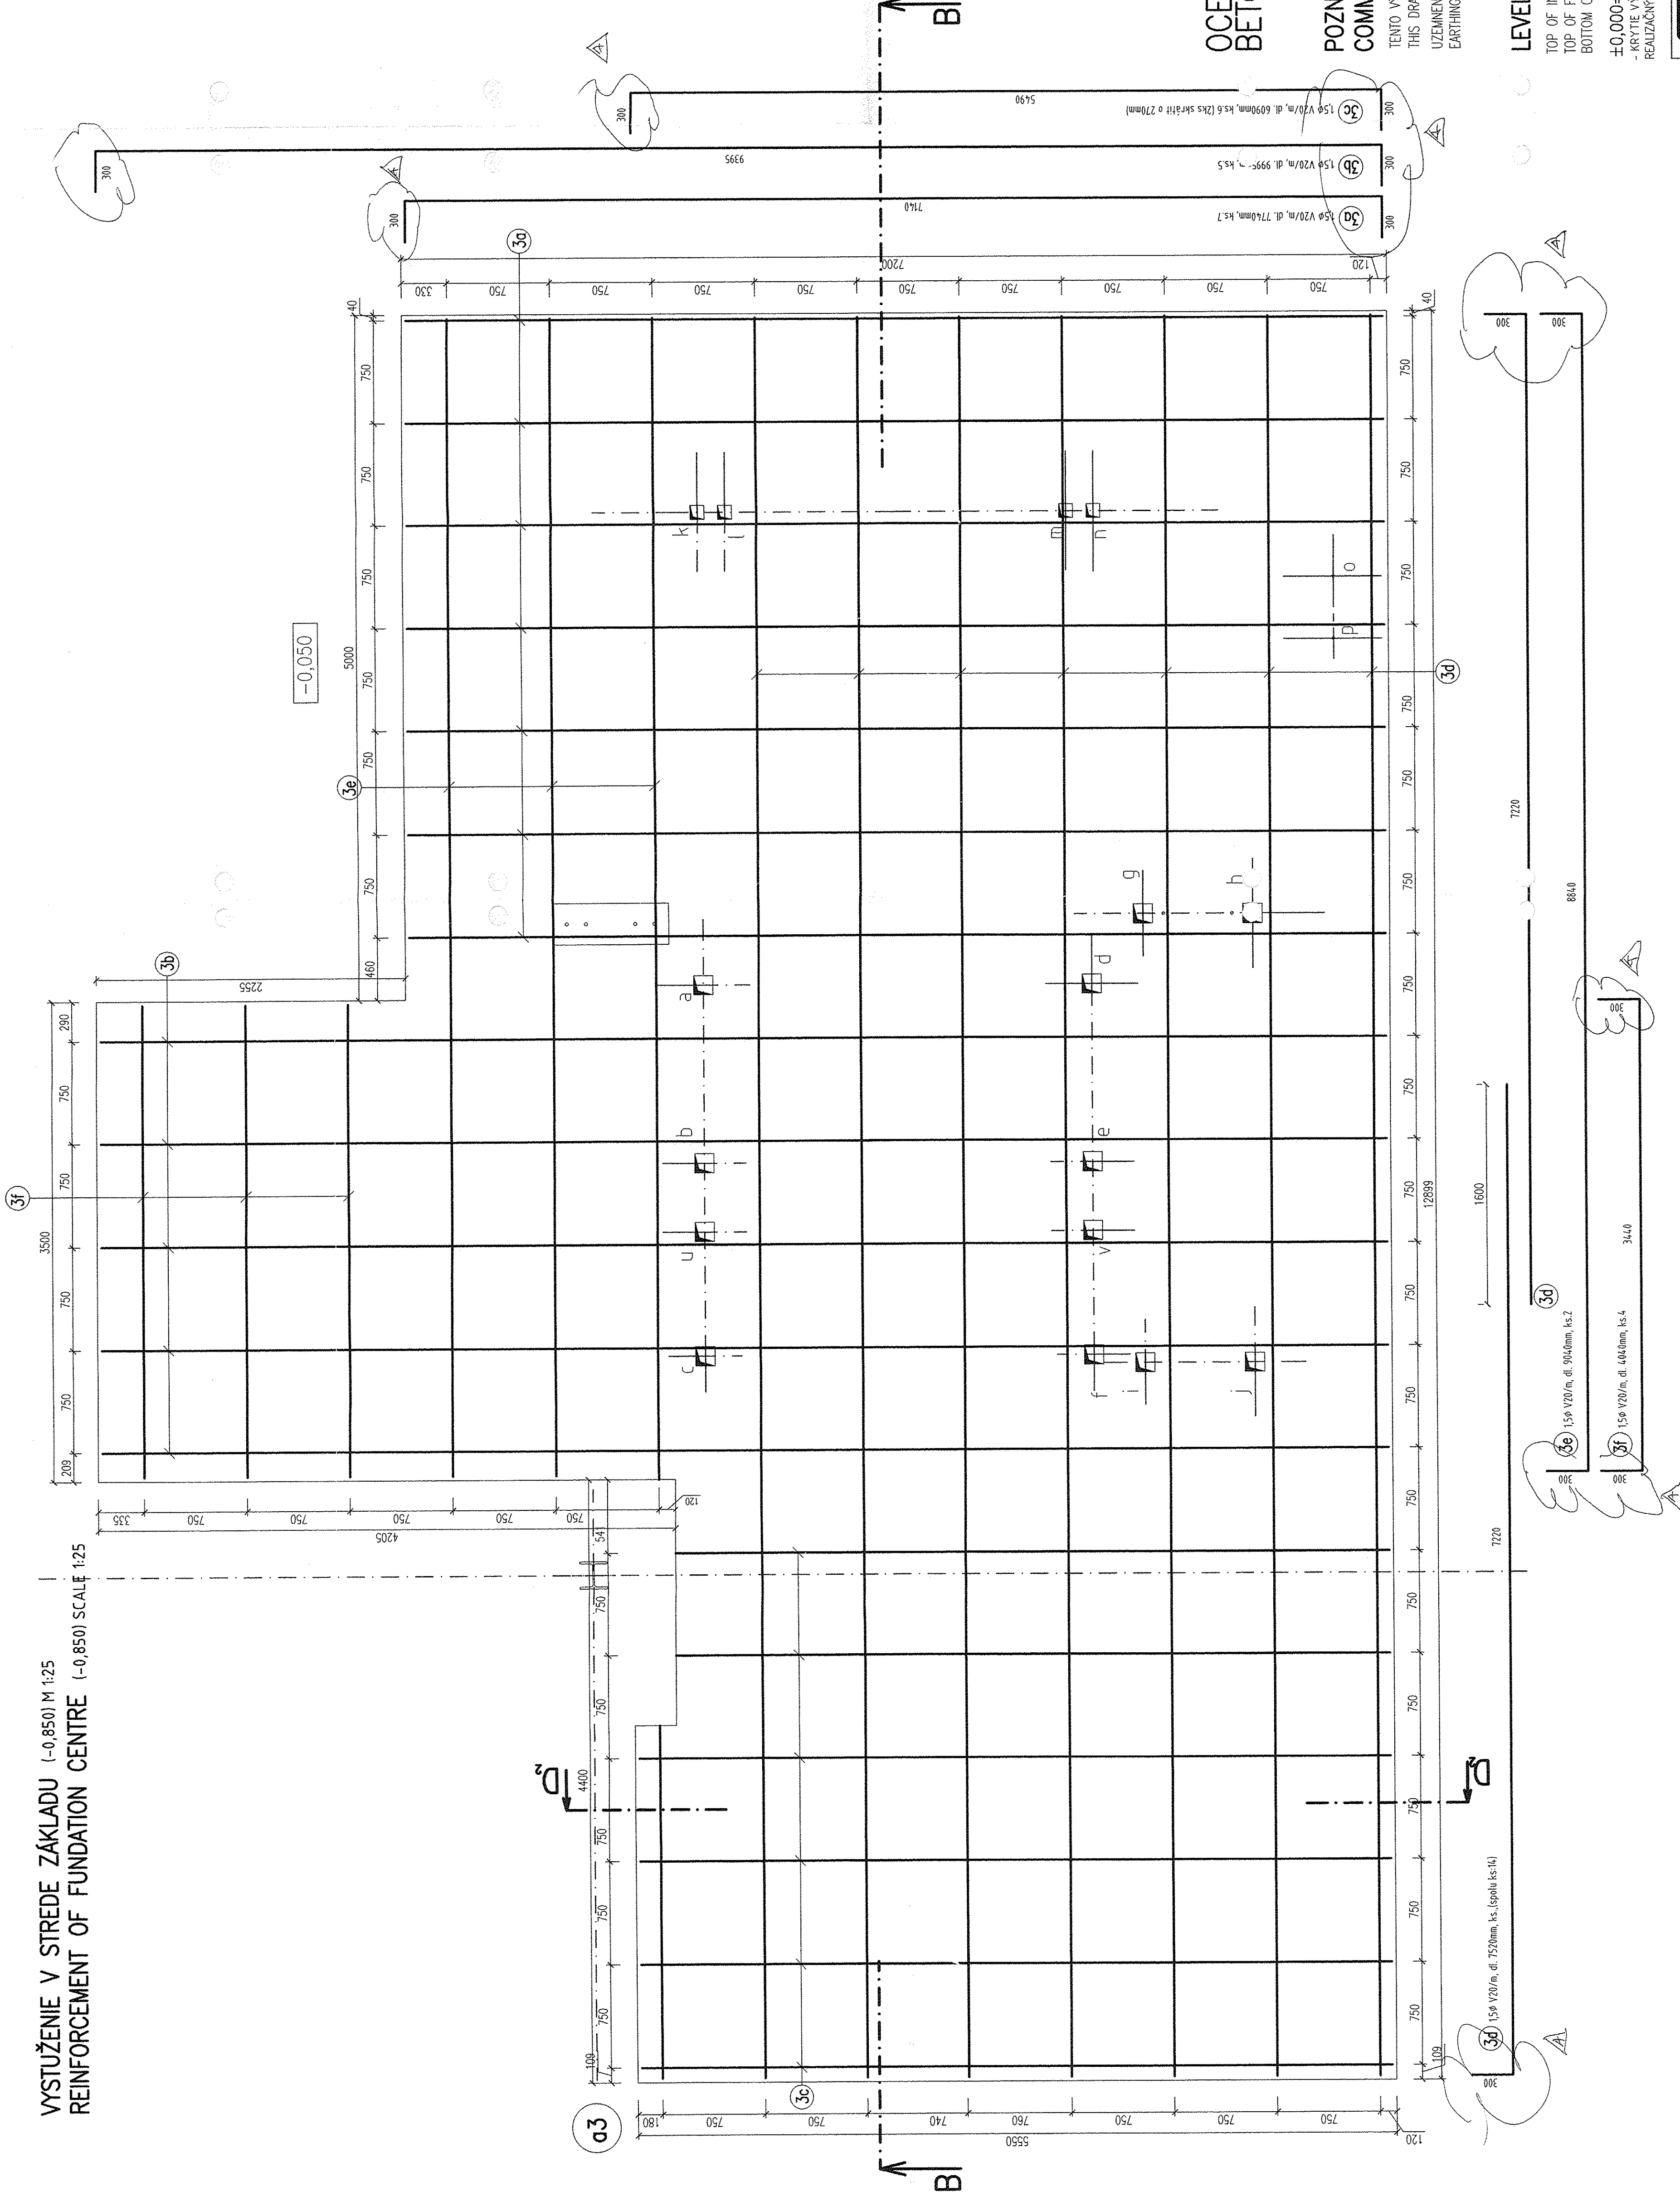


FREIGABE
FOR CONSTRUCTION

OCEL 10425 (V)
BETON B20

POZNÁMKA
COMMENT

TENTO VÝKRES SÓVISI Z VÝKRESOM č. 792.87443. 007
THIS DRAWING RELATED WITH DRW. No. 792.87443. 007
UZEMNENIE PRE ZÁKLADY POD KOMPRESORY VÍD VÝKRES č. 792.87443.002
EARTHING SEE DRW. No. 792.87443.002

LEVELS

TOP OF INTERNAL ROADS: 225.00m n.n.
TOP OF FOUNDATION: 225.10m
BOTTOM OF STEEL STRUCTURE: 225.15m = ±0.00

±0.000=225.150 m n.m Jadran

- KRYTIE VÝSTUŽE 30mm

REALIZAČNÝ PROJEKT JE SPRACOVANÝ POD Z.Č. 3821.2.002.AS-21

HPK
engineering s.r.o.

AIR LIQUIDE

REPLACES: 79














JOB CODE: K70101

REFERENCE: ASU No.9 KOŠICE

TITLE: UNIT 1 - COMPRESSOR BUILDING

FOUNDATION "BAC" DRW. OF REINFORCEMENT

792.87433

A

SCALE

1:25





ORIGINAL FORMAT

A1





ING. PAULČO






ING. MANIK






CHECKED
































