




REZ A-A
SECTION A-A

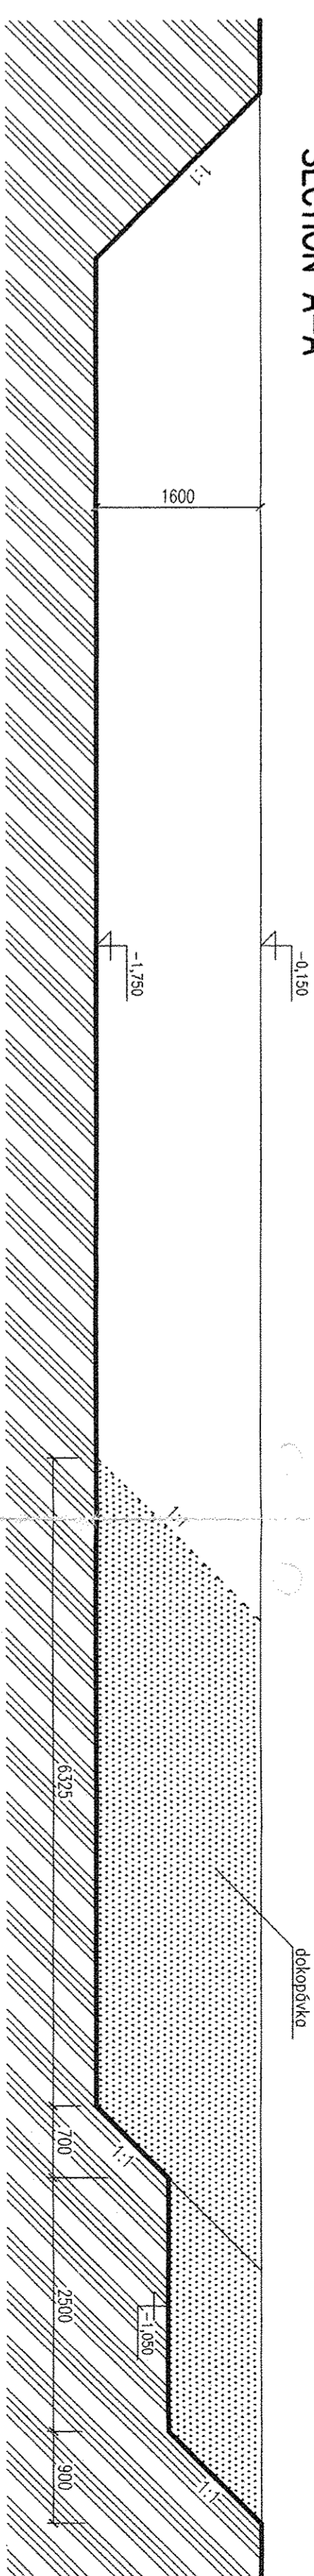

REZ B-B
SECTION B-B

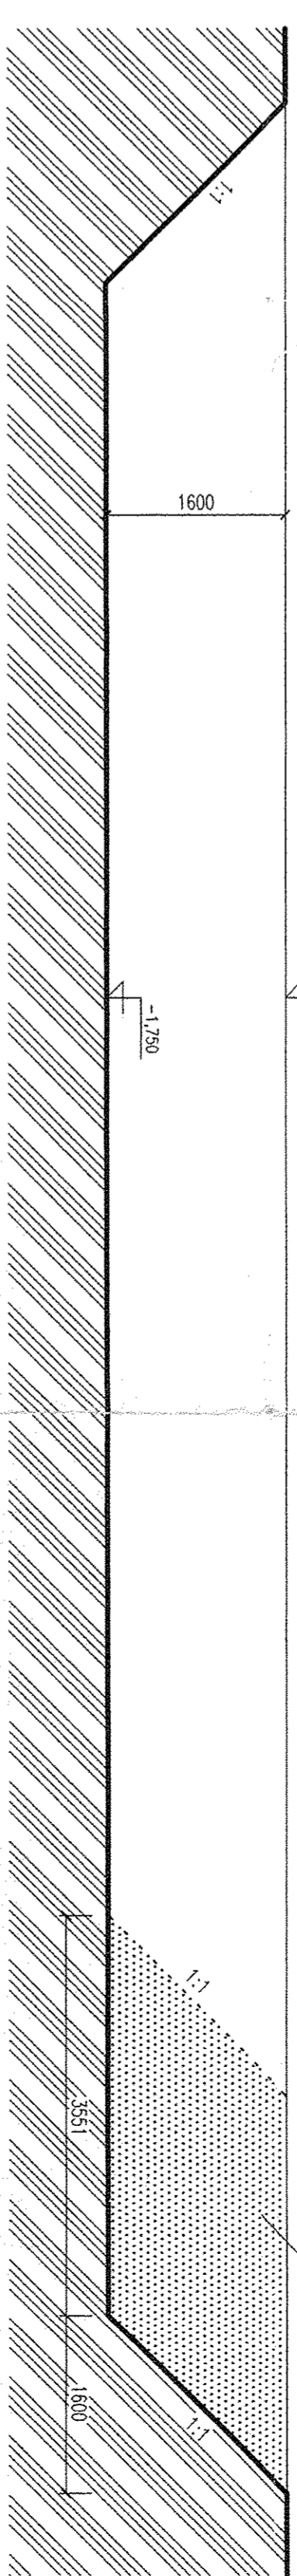

		AIR LIQUIDE	
6	13.06.2005	IN LAMIN	IN PAPI 000
0	28.04.2005	IN MAME	IN PAPI 000
REV	DATE	NAME	CHECKED
JOB CODE: K70101		SCALE	
REFERENCE ASU No.9 KOSICE		DRAWTN A0	
TITLE: UNIT 1 - COMPRESSION STAGING		1:50	
50 NO COMPRESSION STAGING		OF 009 SH	
EPOCH: DMS - VIKTOR		SHEET: D05	
DRAWING NO.:		792.87442	
HISTORY FILE			

LEVELS


TOP OF INTERNAL ROADS: 225.00m a.m.s.l.

TOP OF FOUNDATION: 225,10m
BOTTOM OF STEEL STRUCTURE: 225,15m = $\pm 0,00$

REALIZAČNÝ PROJEKT JE SPRACOVANÝ POD Z.Č. 3821.2.002.AS-02



FOR THE GENERAL

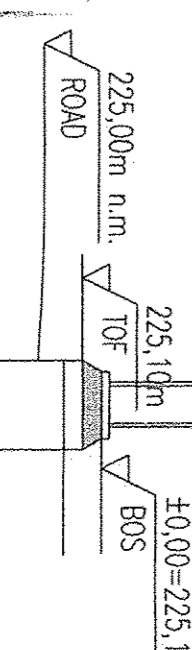

PROJEKT AUTOČIŤHO VÝHOTOVENIA

HS HSV s.r.o. KOŠICE
Technický úsek