


VÝKRES TVARU A VÝSTUŽE (ZAKLAD POD GAN)
DRAWING OF FORM AND REINFORCEMENT (FOUNDATION FOR GAN)

VÝKRES TVARU M 1:50
DRAWING OF FORM SCALE 1:50

PÓDORYS
PLAN

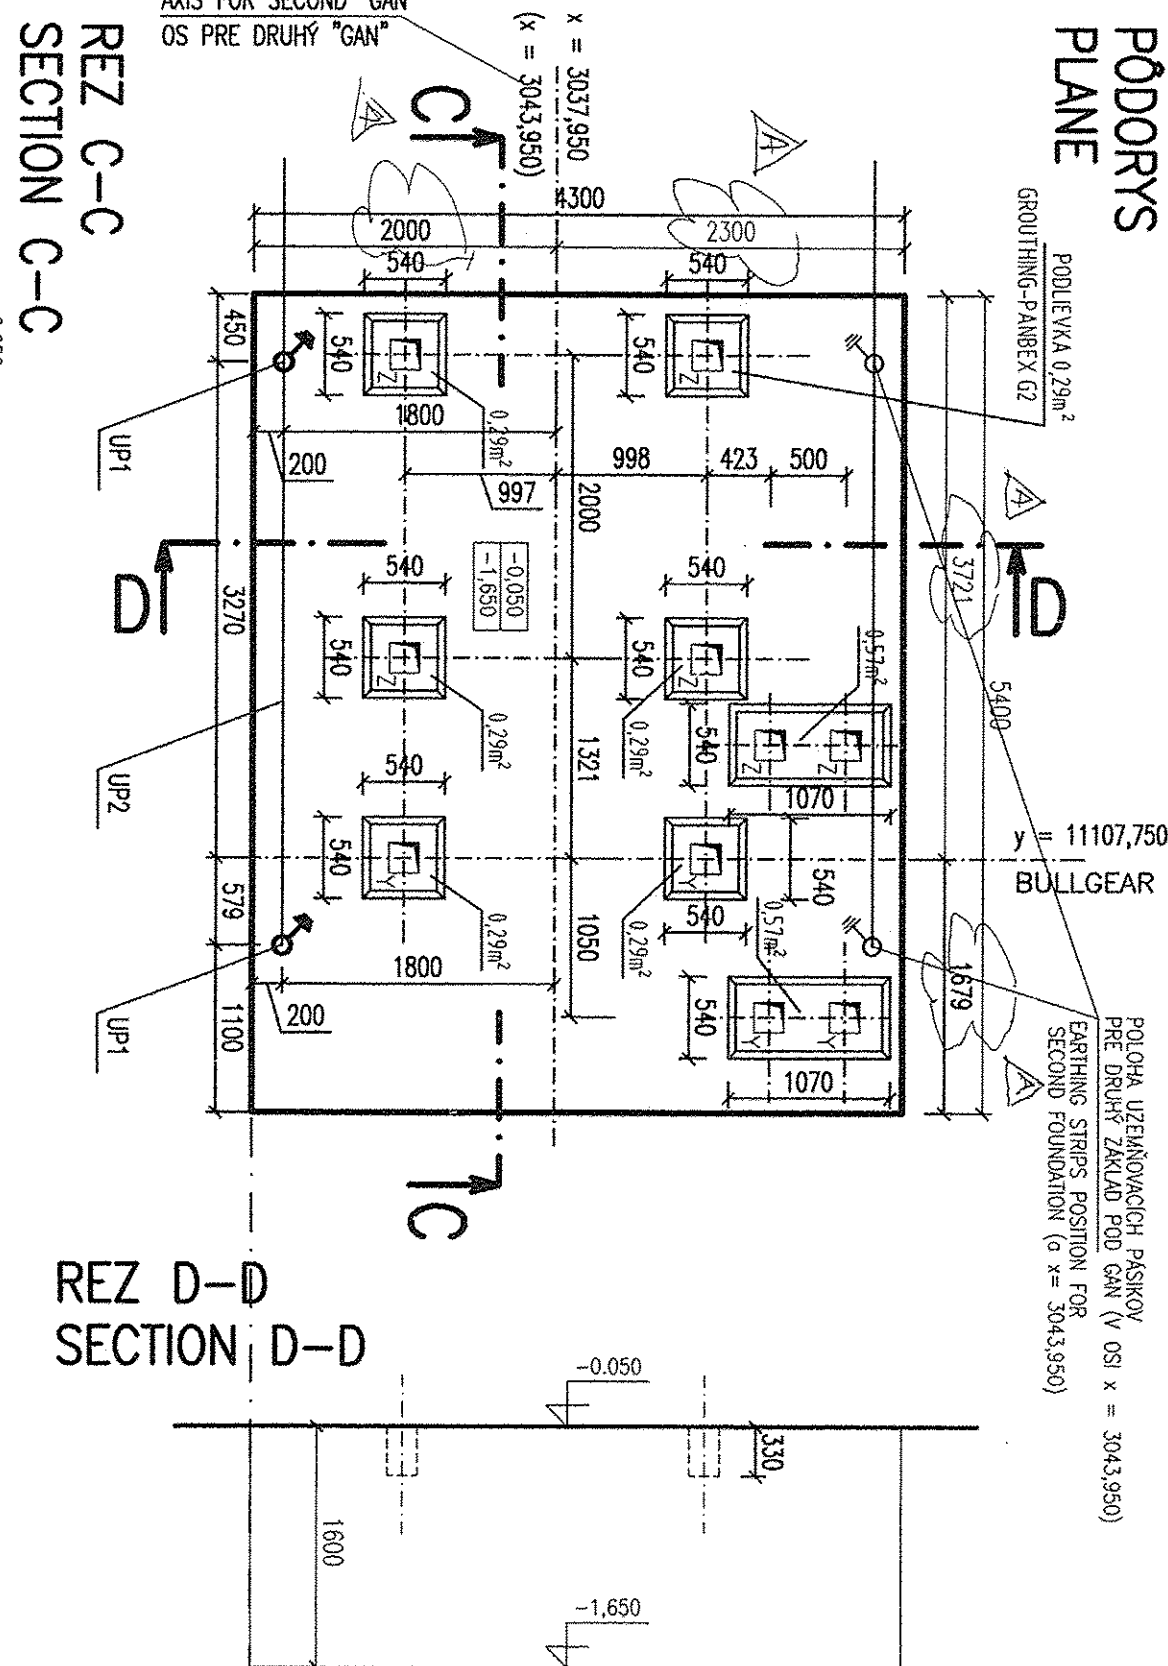


REZ D-D
SECTION D-D


OCEL 10425 (V)
BETÓN B20

DETAIL

REZ D-D
SECTION D-D

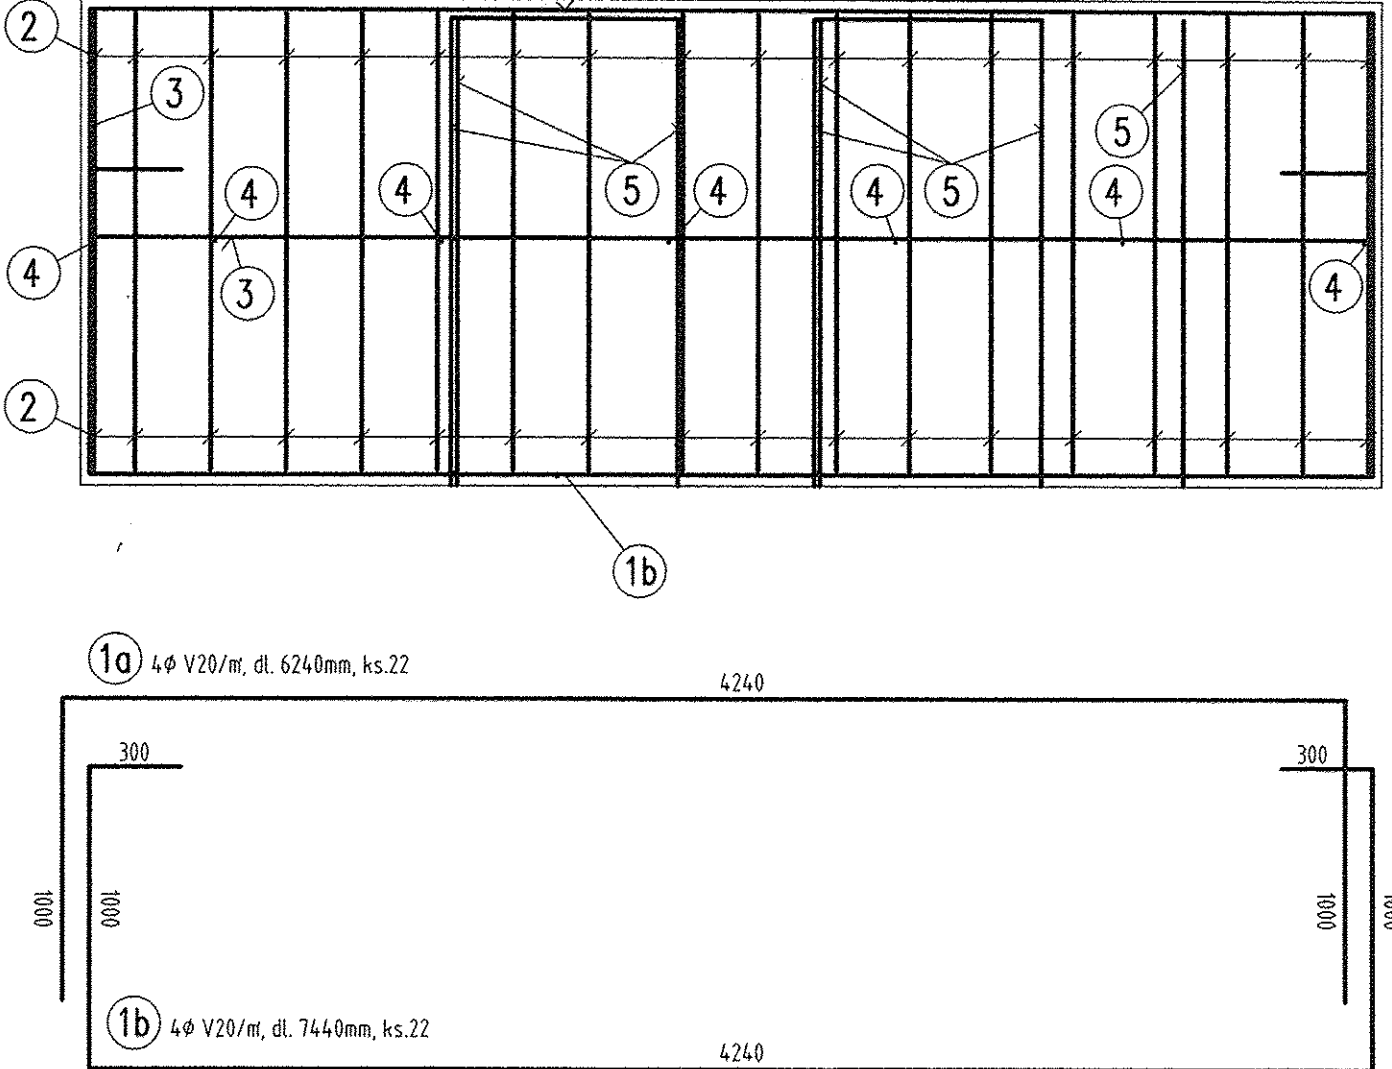

VÝSTUŽENIE PRI SPODNOM OKRAJI
REINFORCE FOR BOTTOM OF FOUNDATION

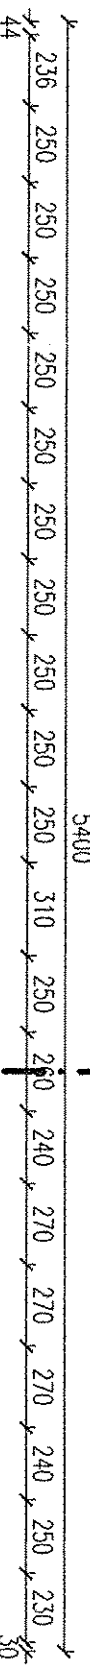


VÝKRES VÝSTUŽE M 1:25
DRAWING OF REINFORCEMENT SCALE 1:25

VÝSTUŽENIE V STREDE ZÁKLADU
REINFORCEMENT OF FUNDATION CENTRE


VÝKAZ UZEMŇOVACÍCH PÁSKOV FeZn
(PRE JEDEN ZÁKLAD)
(FOR ONE FOUNDATION)

| POL. | ROZMERY | DLŽKA | KS |
|-----------------------|---------|--------|----|
| UP1 | 30x4 | 2,750 | 2 |
| UP2 | 30x4 | 7,700 | 1 |
| DLŽKA SPOLU | | 13,200 | |
| DLŽKA PRE DVA ZÁKLADY | | 26,400 | |


DETAIL Y

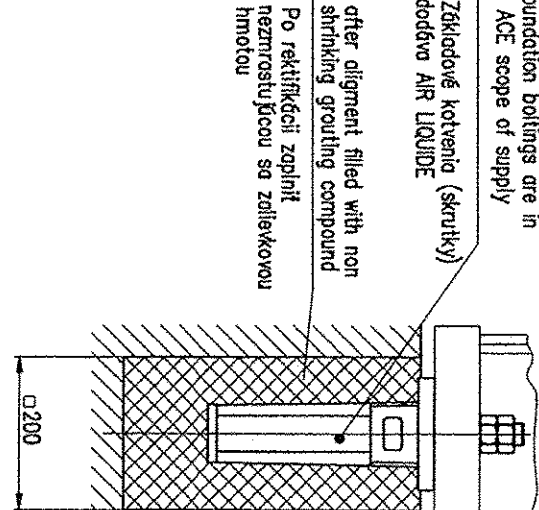


DETAIL Z

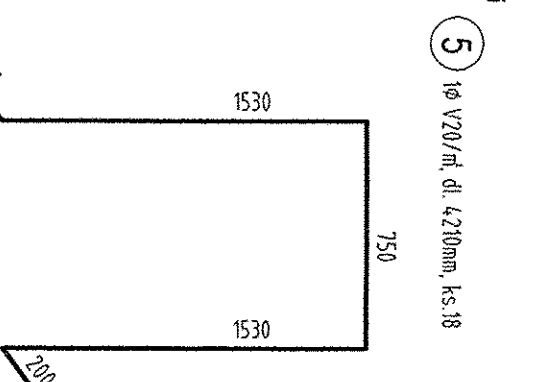

VÝSTUŽENIE PRI HORNOM OKRAJI
REINFORCE FOR TOP OF FOUNDATION

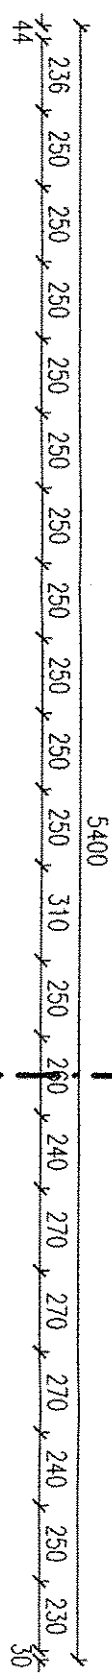

EDGES ADJUSTMENT

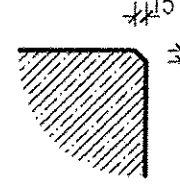

LEVELS

TOP OF INTERNAL ROADS: 225,00m n.n.
TOP OF FOUNDATION: 225,10m
BOTTOM OF STEEL STRUCTURE: 225,15m = ±0,00

±0,000=225,150 m n.n. Jodran

KRYTIE VÝSTUŽE 30mm
REINFORCEMENT PROTECT JE SPRACOVANÝ POD ZLČ. 3821.2.002.AS-16



HPK Engineering a.s.

| | | | |
|-----|------------|---------------|---------------|
| REV | DATE | NAME | CHECKED |
| A | 29.04.2005 | ING. PAULIČKO | ING. PAULIČKO |
| B | 29.04.2005 | ING. PAULIČKO | ING. PAULIČKO |

JOB CODE: K70101
REFERENCE: ASU No.9 KOŠICE

TITLE: UNIT 1 - COMPRESSOR BUILDING
"GAN" DRW. OF REINFORCEMENT AND FORM/92.87443

REPLACES: 79
REPLACED BY: 79

SCALE: 1:50, 1:25
ORIGINAL FORMAT: A1

DATE: 02.08.09

FOR CONSTRUCTION