



VYKRES TVARU (ZAKLAD PRE MAC)
DRAWING OF FORM (FOUNDATION FOR MAC)


PŌDORYS M 1:50
PLANE SCALE 1:50

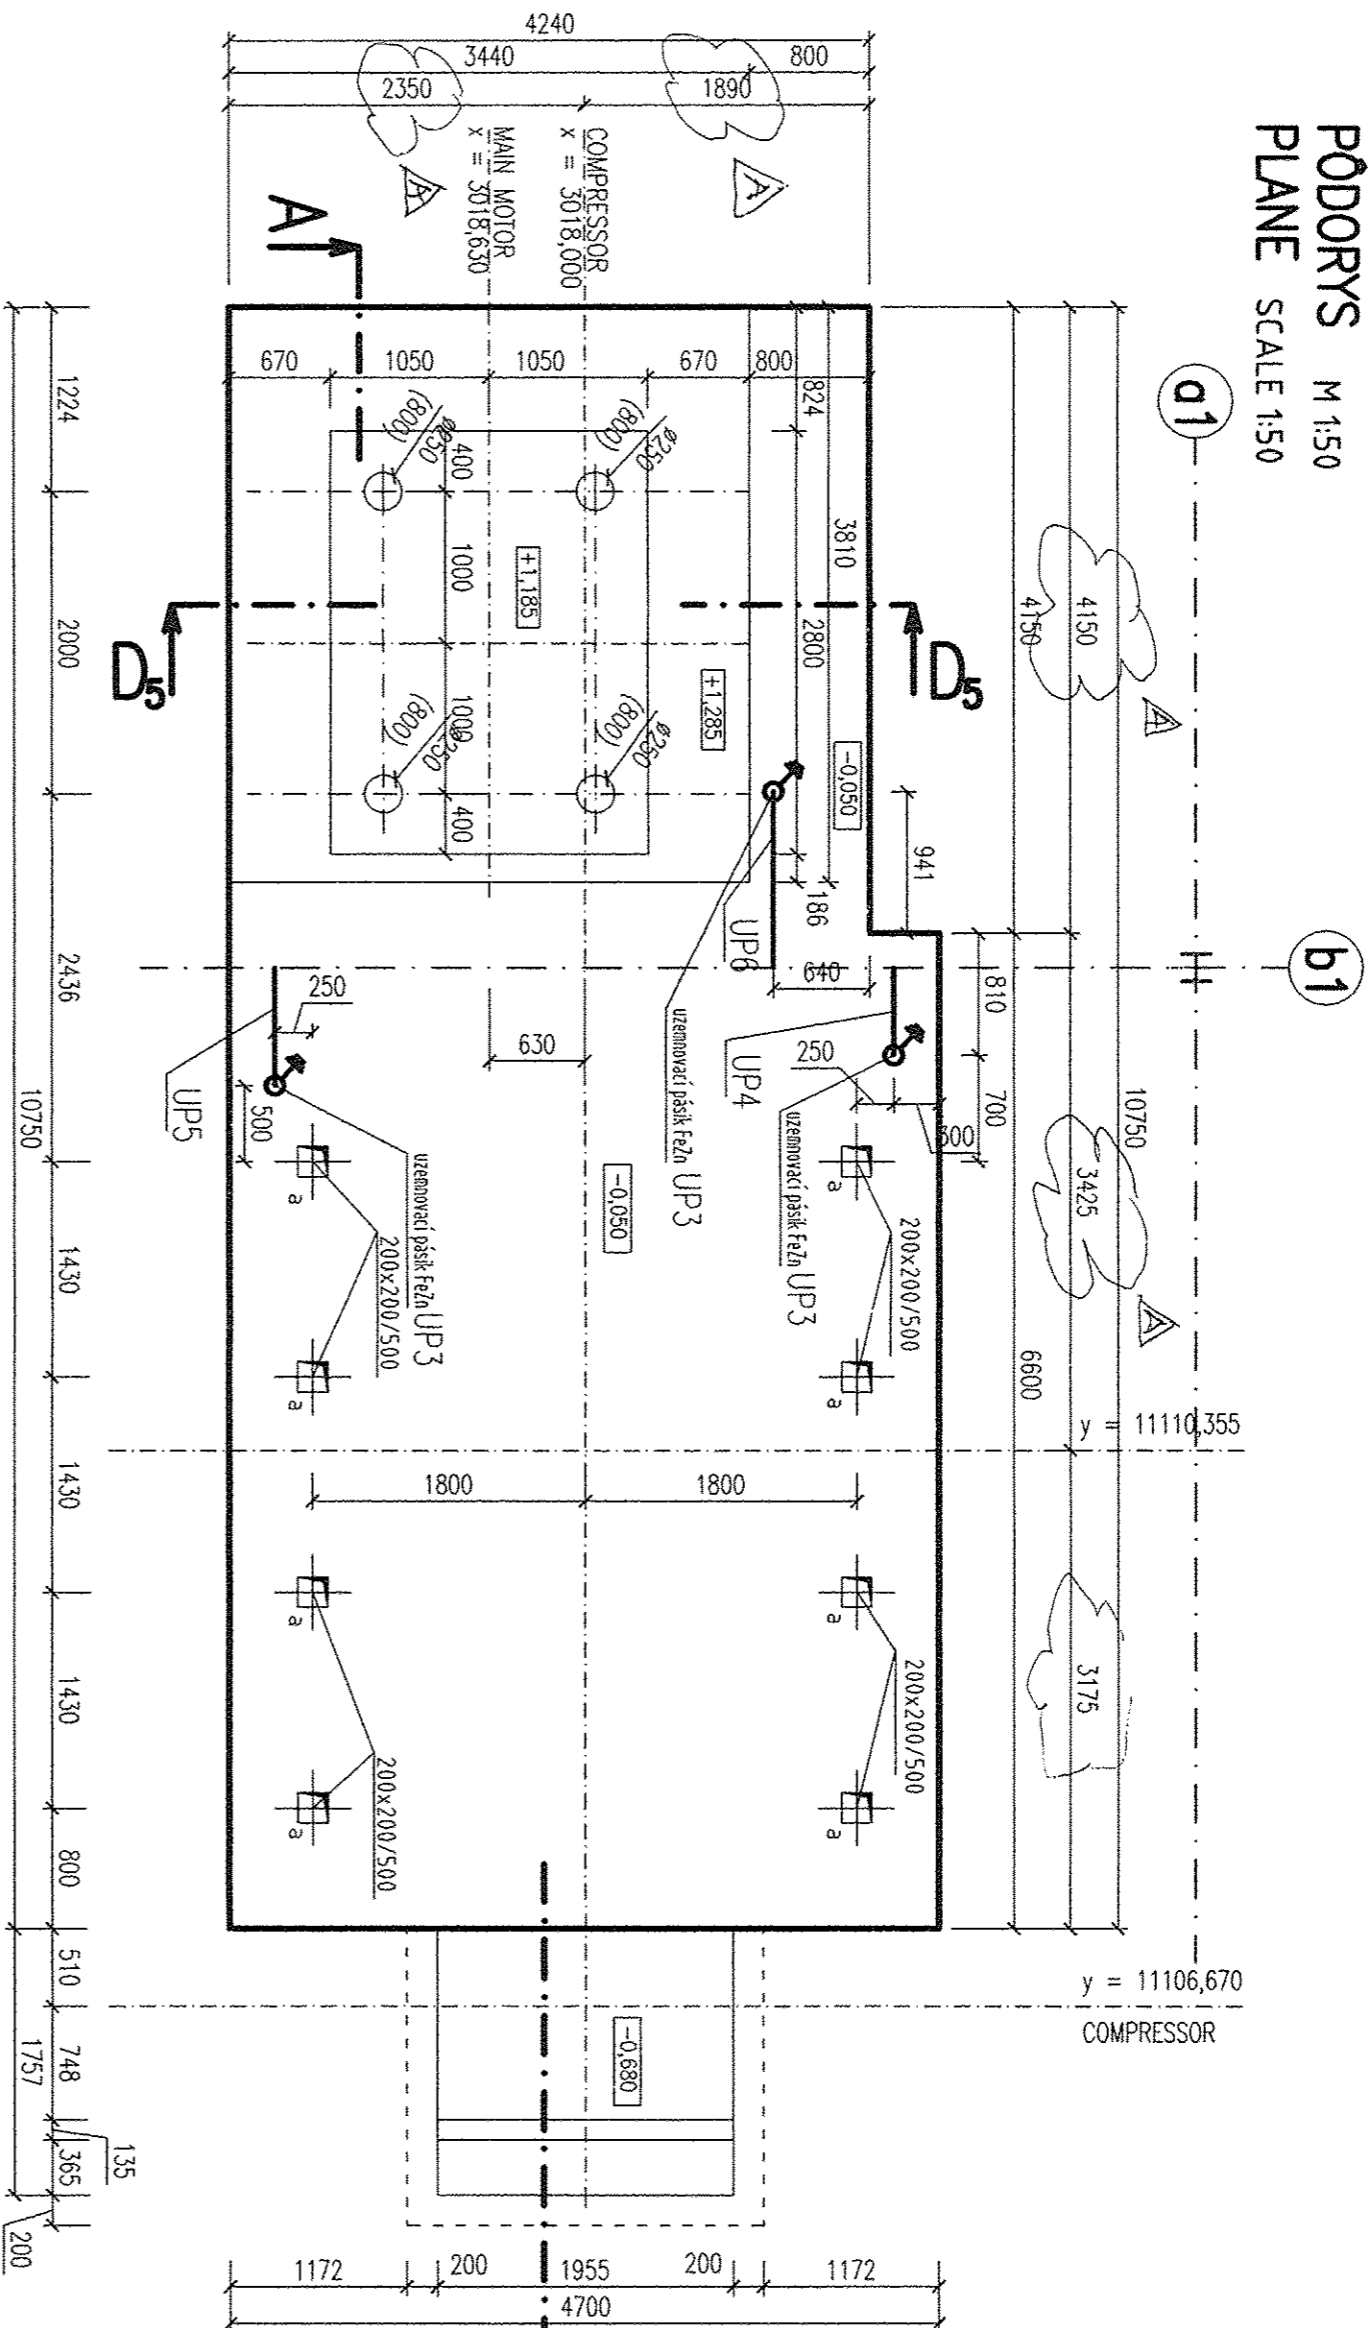


REZ A-A
SECTION A-A

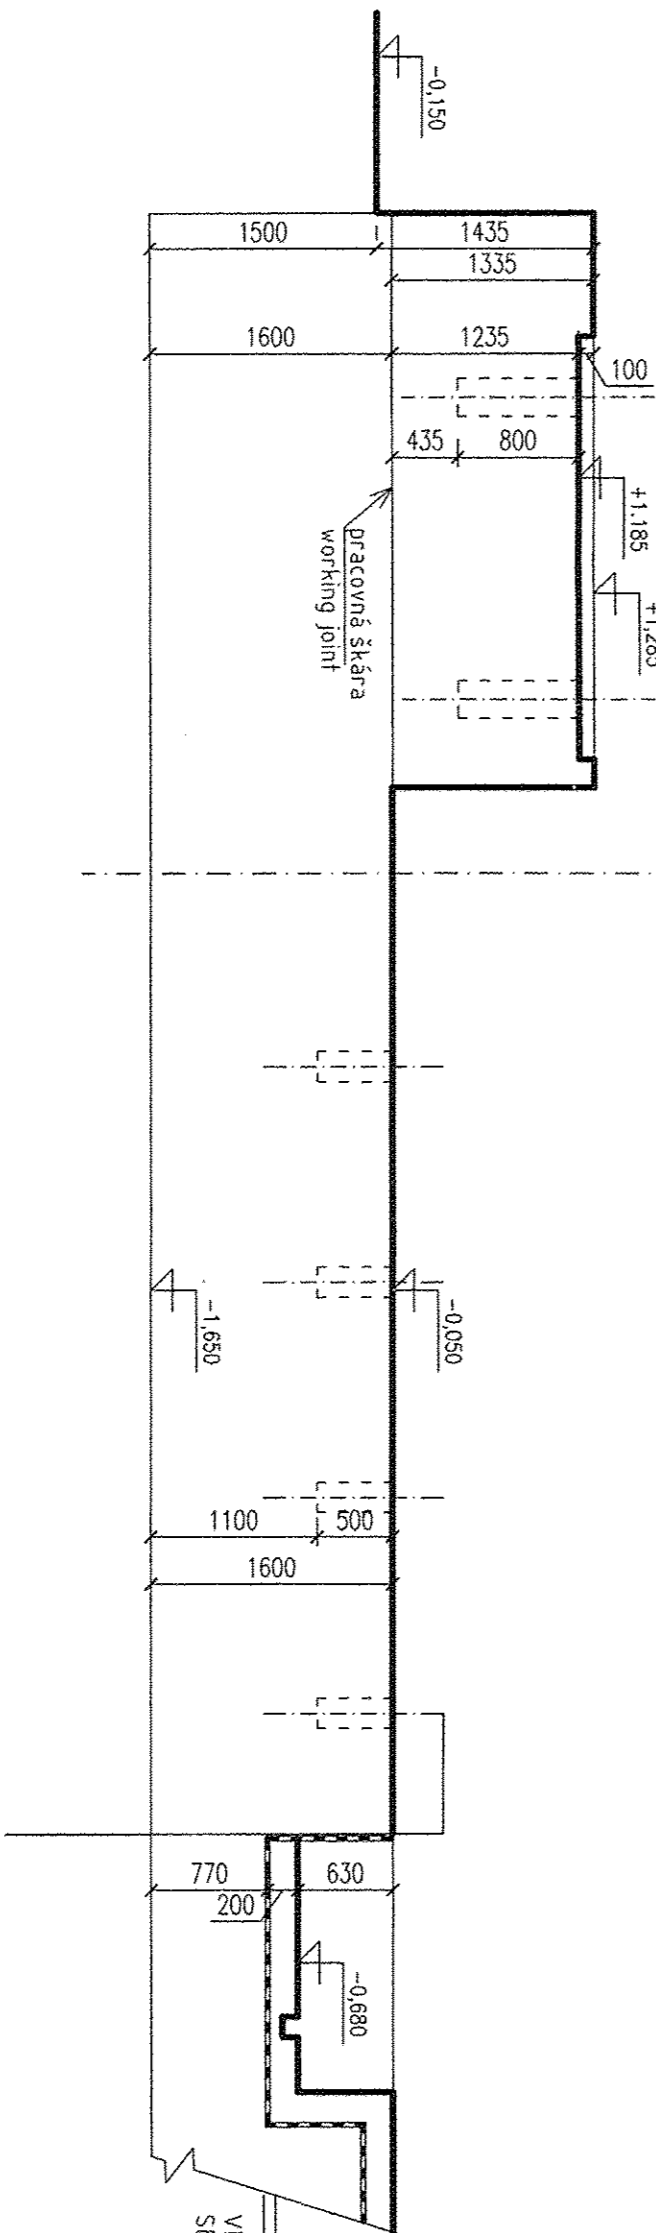

REZ D5-D5
SECTION D5-D5

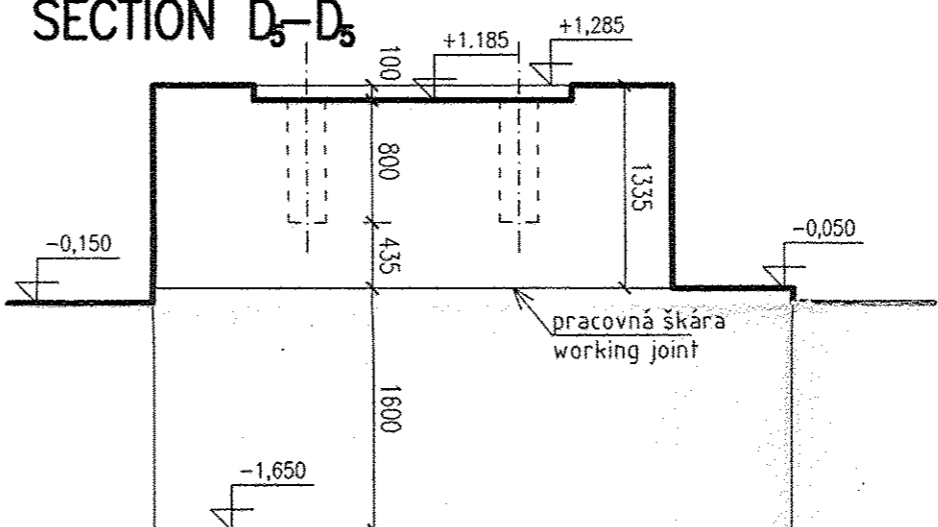


EDGES ADJUSTMENT

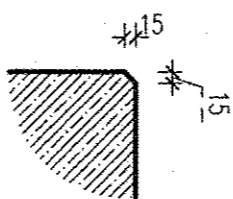

PROJEKT
FOR CONSTRUCTION

Řa 02.06.05

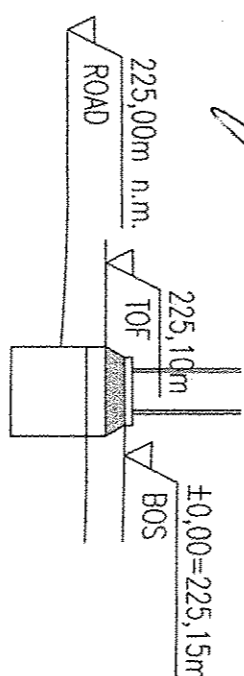

NORTH PLANT

LEVELS


TOP OF INTERNAL ROADS: 225,00m n.m.
TOP OF FOUNDATION: 225,10m
BOTTOM OF STEEL STRUCTURE: 225,15m = ±0,00

±0,00=225,150 m n.m Jadrán

- KRYTÉ VÝSTUŽE 30mm
REALIZAČNÝ PROJEKT JE SPRACOVANÝ POD Z.Č. 3821.2.002.AS-17



DETAIL FOR
POINT a
M 1:10

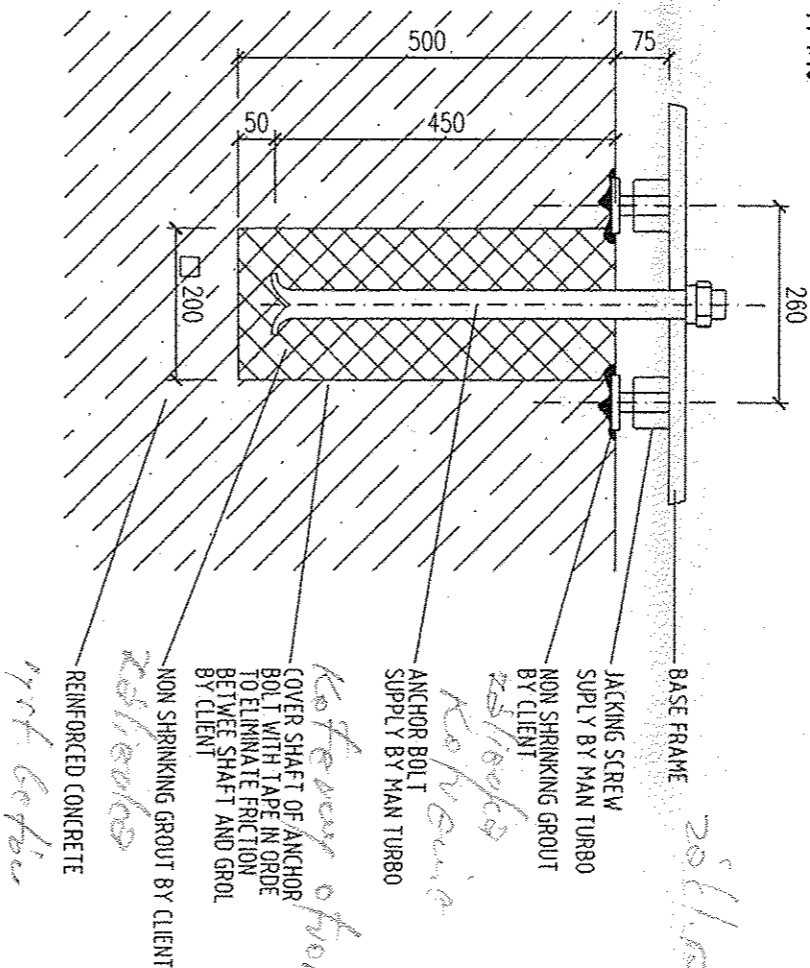

HPK
engineering a.s.

REV.	DATE	NAME	CHECKED	HISTORY FILE
A	29.04.2005	ING. MANIK	ING. PAULICKO	AS MARKED
0	29.04.2005	ING. MANIK	ING. PAULICKO	

JOB CODE: K70101
REFERENCE: ASU No.9 KOŠICE

REPLACES: 79
REPLACED BY: 79
TITLE: UNIT 1 - COMPRESSOR BUILDING
50 002 COMPRESSOR STATION-MAC VYKRES TVARU
FOUNDATION "MAC" DRW. OF FORM
DRAWING NO.: 792.87443
SHEET: 004 OF 008 SHEETS
SCALE: 1:50 ORIGINAL FORMAT: A2
REV. A