POHLAD D– JUHOVÝCHODNÝ
View D

SP32 KS:1 STENOVÝ PANEL–5245x995x120
POHLAD P32 M 1:25

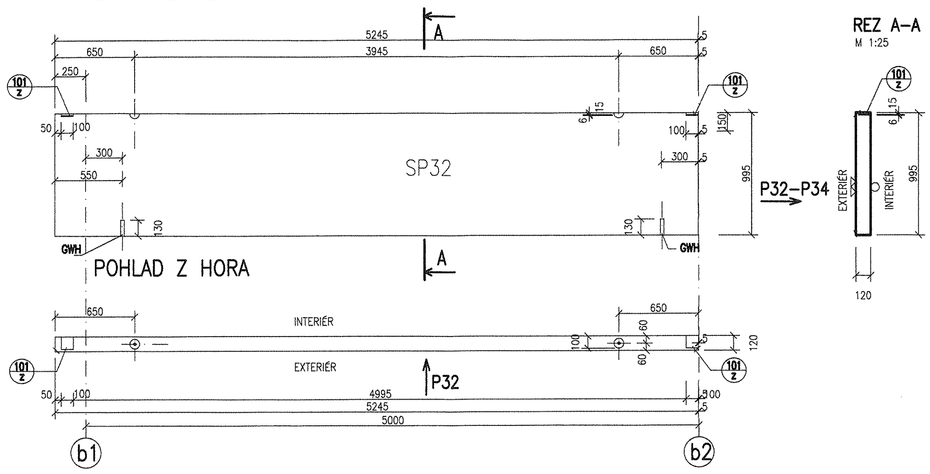

SP33 KS:1 STENOVÝ PANEL–4490x995x120
POHLAD P33 M 1:25

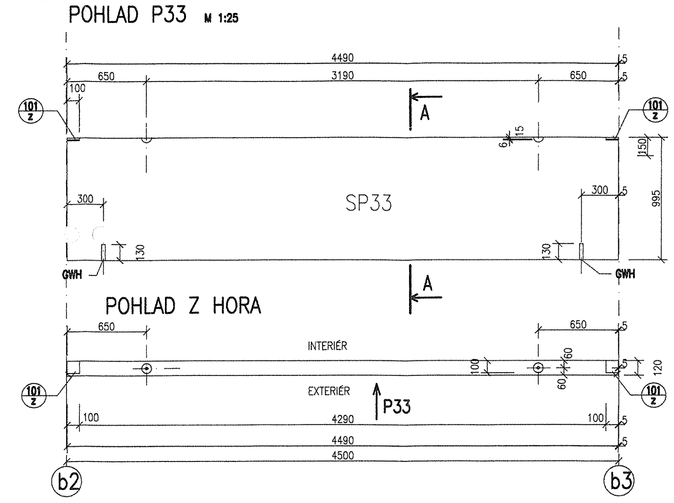

SP34 KS:1 STENOVÝ PANEL–2745x995x120
POHLAD P34 M 1:25

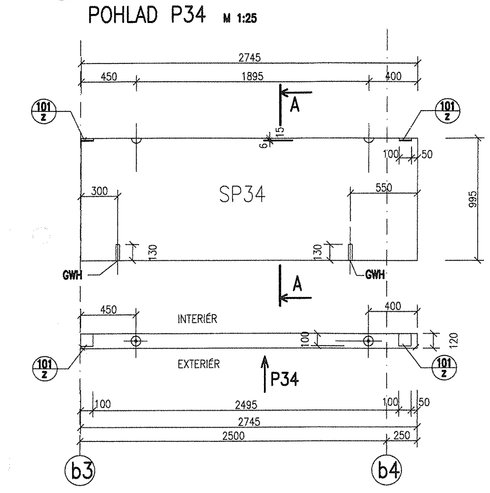

SP28 KS:1 STENOVÝ PANEL–5245x1990x120
POHLAD *P28 M 1:25

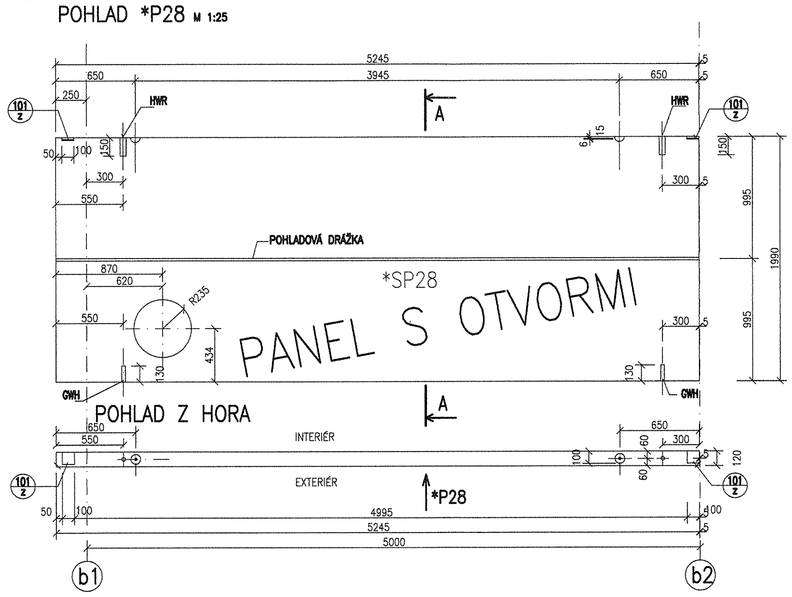

SP29 KS:2 STENOVÝ PANEL–4490x1990x120
POHLAD P29 M 1:25

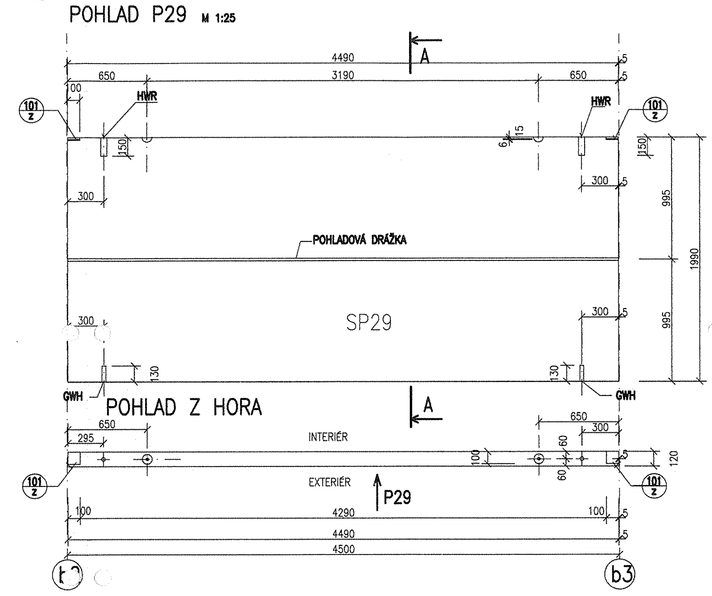

SP31 KS:1 STENOVÝ PANEL–2745x1990x120
POHLAD P31 M 1:25

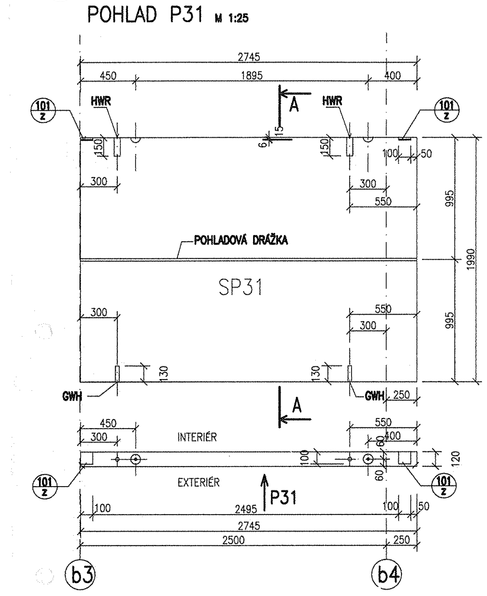

SP28 KS:1 STENOVÝ PANEL–5245x1990x120
POHLAD P28 M 1:25

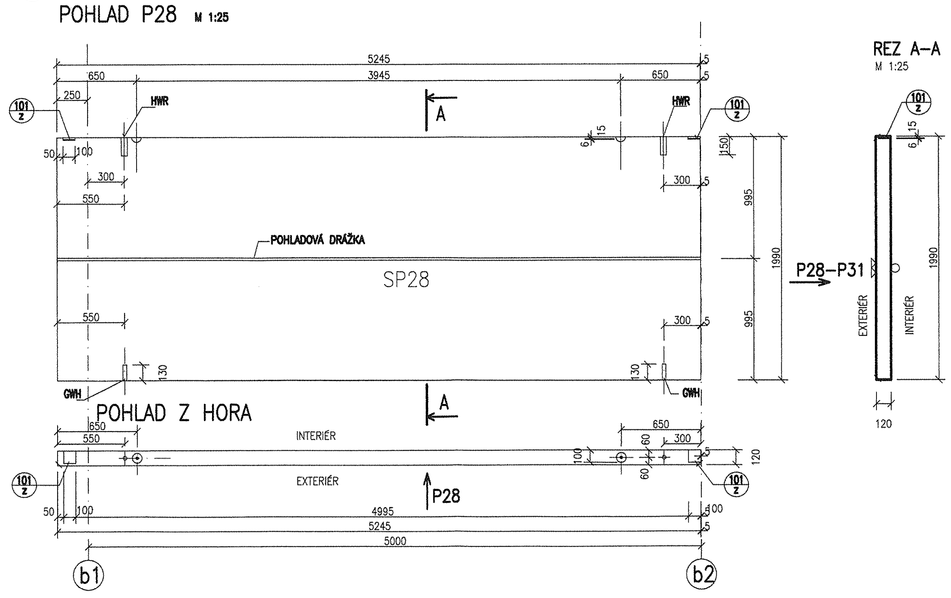

DETAIL 1 M1:10

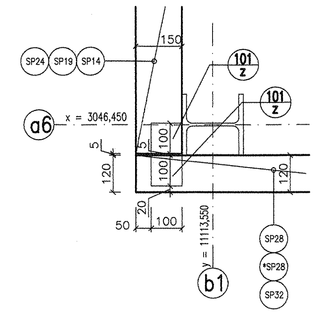

DETAIL 6 M1:10

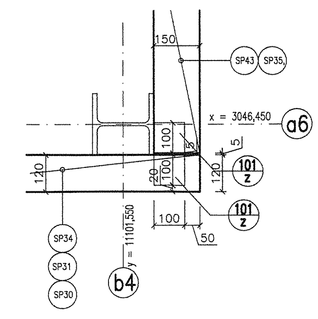

SP30 KS:1 STENOVÝ PANEL–2745x1990x120
POHLAD P30 M 1:25

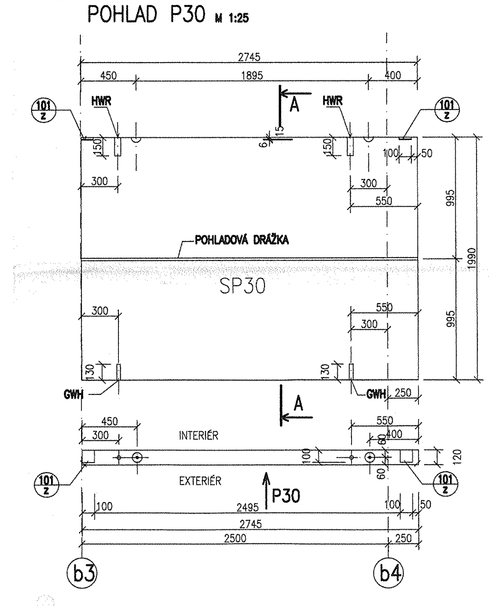

POHLAD D– JUHOVÝCHODNÝ
View D

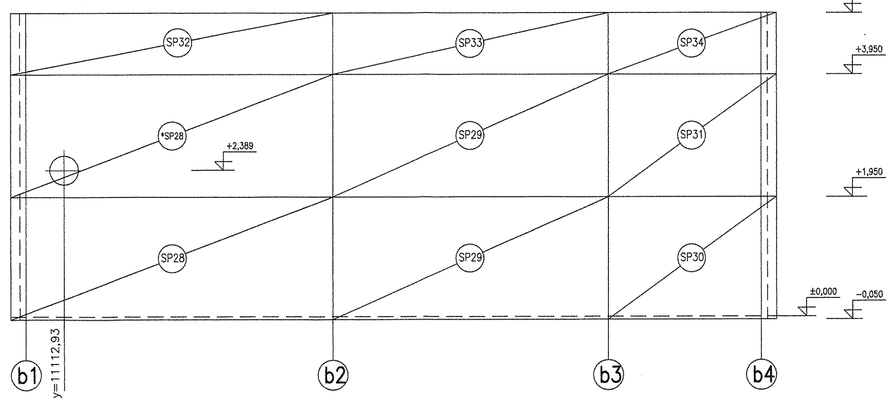

CHARAKTERISTICKÝ DETAIL

DETAIL PRICHYTENIA STENOVÉHO PANELA K OC. STĹPU /PÔDORYS/
DETAIL OF ATTACHMENT WALLS PREFABRICAT TO STEEL COLUMN /GROUNDPLAN/

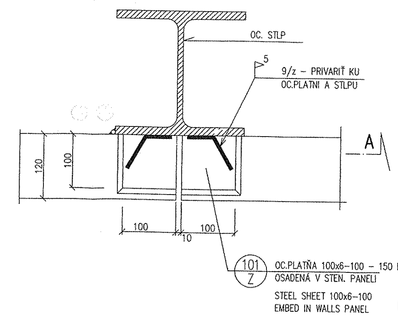

REZ A–A PRICHYTENIE PANELA ZHORA
ATTACHMENT PANEL FROM ABOVE

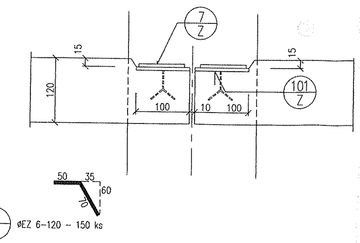

LEVELS

TOP OF INTERNAL ROADS: 225,00m n.m.
TOP OF FOUNDATION: 225,10m
BOTTOM OF STEEL STRUCTURE: 225,15m = ±0,00

±0,000=225,150 m n.m Jadran

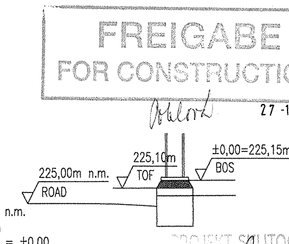

FREIGABE
FOR CONSTRUCTION
27-10-2005

PROJEKT SKUTOČNÉHO VYHOTOVENIA

REALIZAČNÝ PROJEKT JE SPRACOVANÝ POD Z.Č. 3821.2.002.AS–

REV.	DATE	NAME	CHECKED	HISTORY FILE
0	21.10.2005	ING.NOGA	ING.PAVLIČKO	

HPK engineering a.s.

AIR LIQUIDE

JOB CODE: K70101
REFERENCE: ASU No.9 KOŠICE

SCALE 1:25 | ORIGINAL FORMAT A0
SHEET: 005 | OF012 SHEETS

REPLACES: 79_____
REPLACED BY:79_____

TITLE: UNIT 1 – COMPRESSOR BUILDING
SO 002 KOMPRESOROVÁ STANICA–VÝKRES TVARU PANELOV
SHAPE OF WALL PANELS– VIEW D

DRAWING NO.: 792.87452 | REV. 0

This drawing is protected by copyright.
It may not be copied or used without our written consent and the contents of it are not permitted to disclose it to any third parties.