



This drawing is protected by copyright.
It may not be copied or used without our written
authorization and it is strictly prohibited
to disclose it to any third parties.

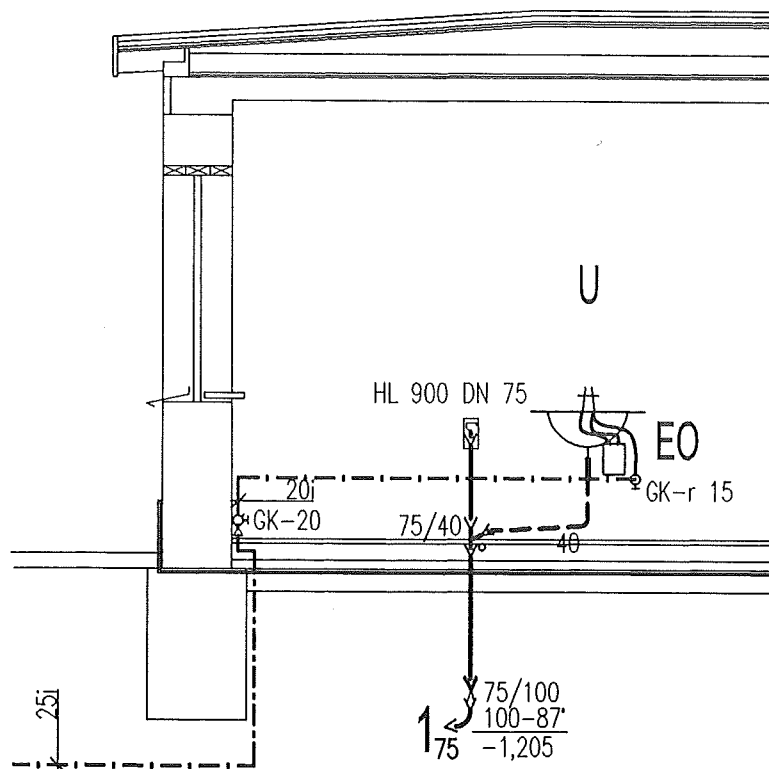

VZOROVÝ PRIEČNY REZ/SAMPLE CROSS SECTION

POTRUBIE IPE, rPE/PIPELINE IPE, rPE


KANALIZAČNÉ RÚRY PVC/ PVC SEWERAGE PIPE

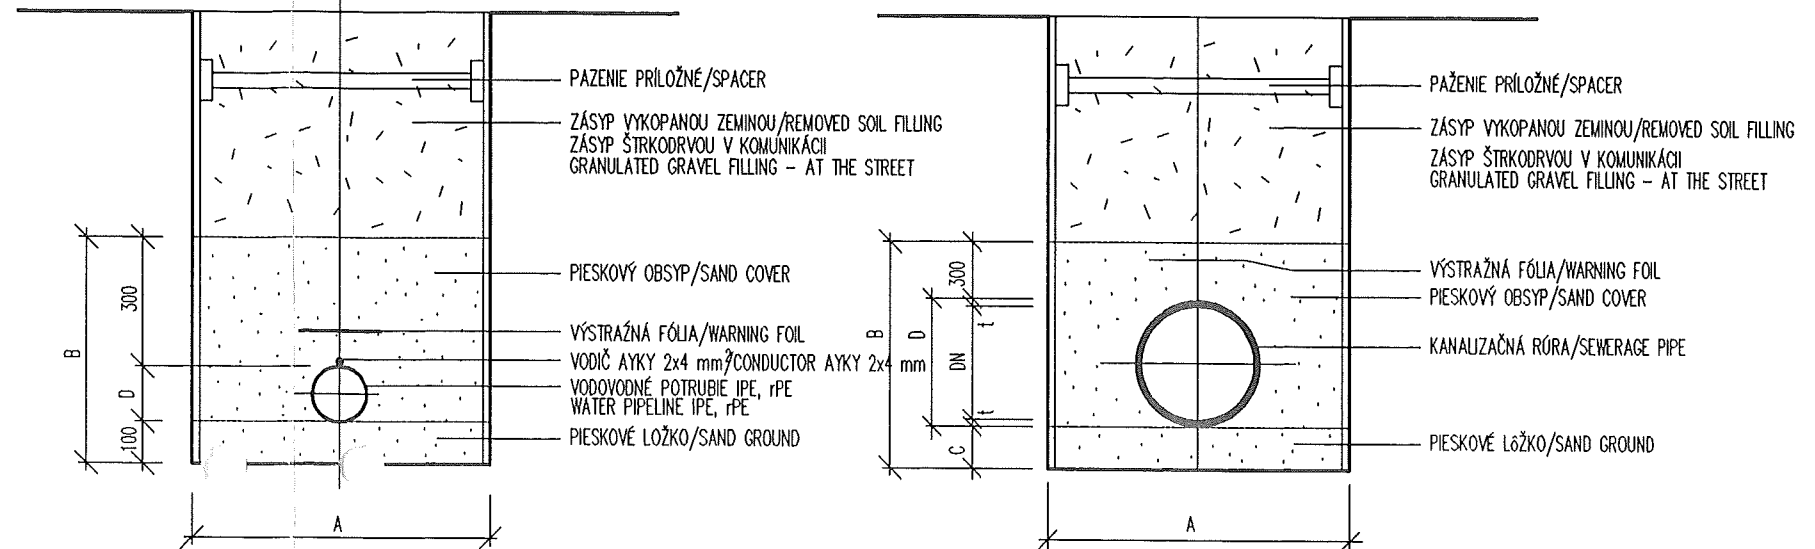

DN	D	A	B	KUBATÚRA/VOLUME [m³]		
				LOŽKA/GROUND	OBSYP/COVER	VYTĽAČ./FORCED OUT
25	32x2.9	1100	432	0,11	0,3644	0.4752
32	40x3.6	1100	440	0,11	0,3727	0.4840
40	50x4.5	1100	450	0,11	0,3830	0.495

DN	C	D	A	B	t	KUBATÚRA/VOLUME [m³]		
						LOŽKA/GROUND	OBSYP/COVER	VYTĽAČ./FORCED OUT
100	110	110	1100	520	3,0	0,121	0,4415	0,5720
125	120	125	1100	545	3,1	0,132	0,4557	0,6000
150	120	160	1100	580	4,0	0,132	0,4859	0,6380

PROJEKT SKUTOČNÉHO
VYHOTOVENIA

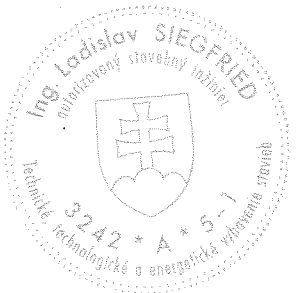

±0,000=225,150m.n.m
SPRACOVANÉ POD ZÁKAZKOVÝM ČÍSLOM:158/2004/SO/

REFLEX-PRO REFLEX-PRO spol. s r.o.		10.06. 2005		ING.GVALEEC	ING.SIEGFRIED	ZMENA DISPOZICIE CHANGE DISPOSITION	A
AIR LIQUIDE Air Liquide AGS GmbH		Date : 10.02.2005		Name : ING.GVALEEC	Checked: ING.SIEGFRIED	History file:	
Replaces: 792.87414 Replaced by: 792.87414		Job code: K 70101 Reference: ASU No.9 KOSICE		Scale 1:50		Original format DIN A2	
Title: ROZVODŇA T81/ELECT. ROOM T81 ZVSLA SCHÉMA/VERTICAL SCHEMA ZDRAVOTECHNICKÁ INŠTALÁCIA/PUBLIC HEALTH ENGINEERING		Drawing No.: 792.87414		Sheet: ---		of --- Sheets	
						Rev. A	