

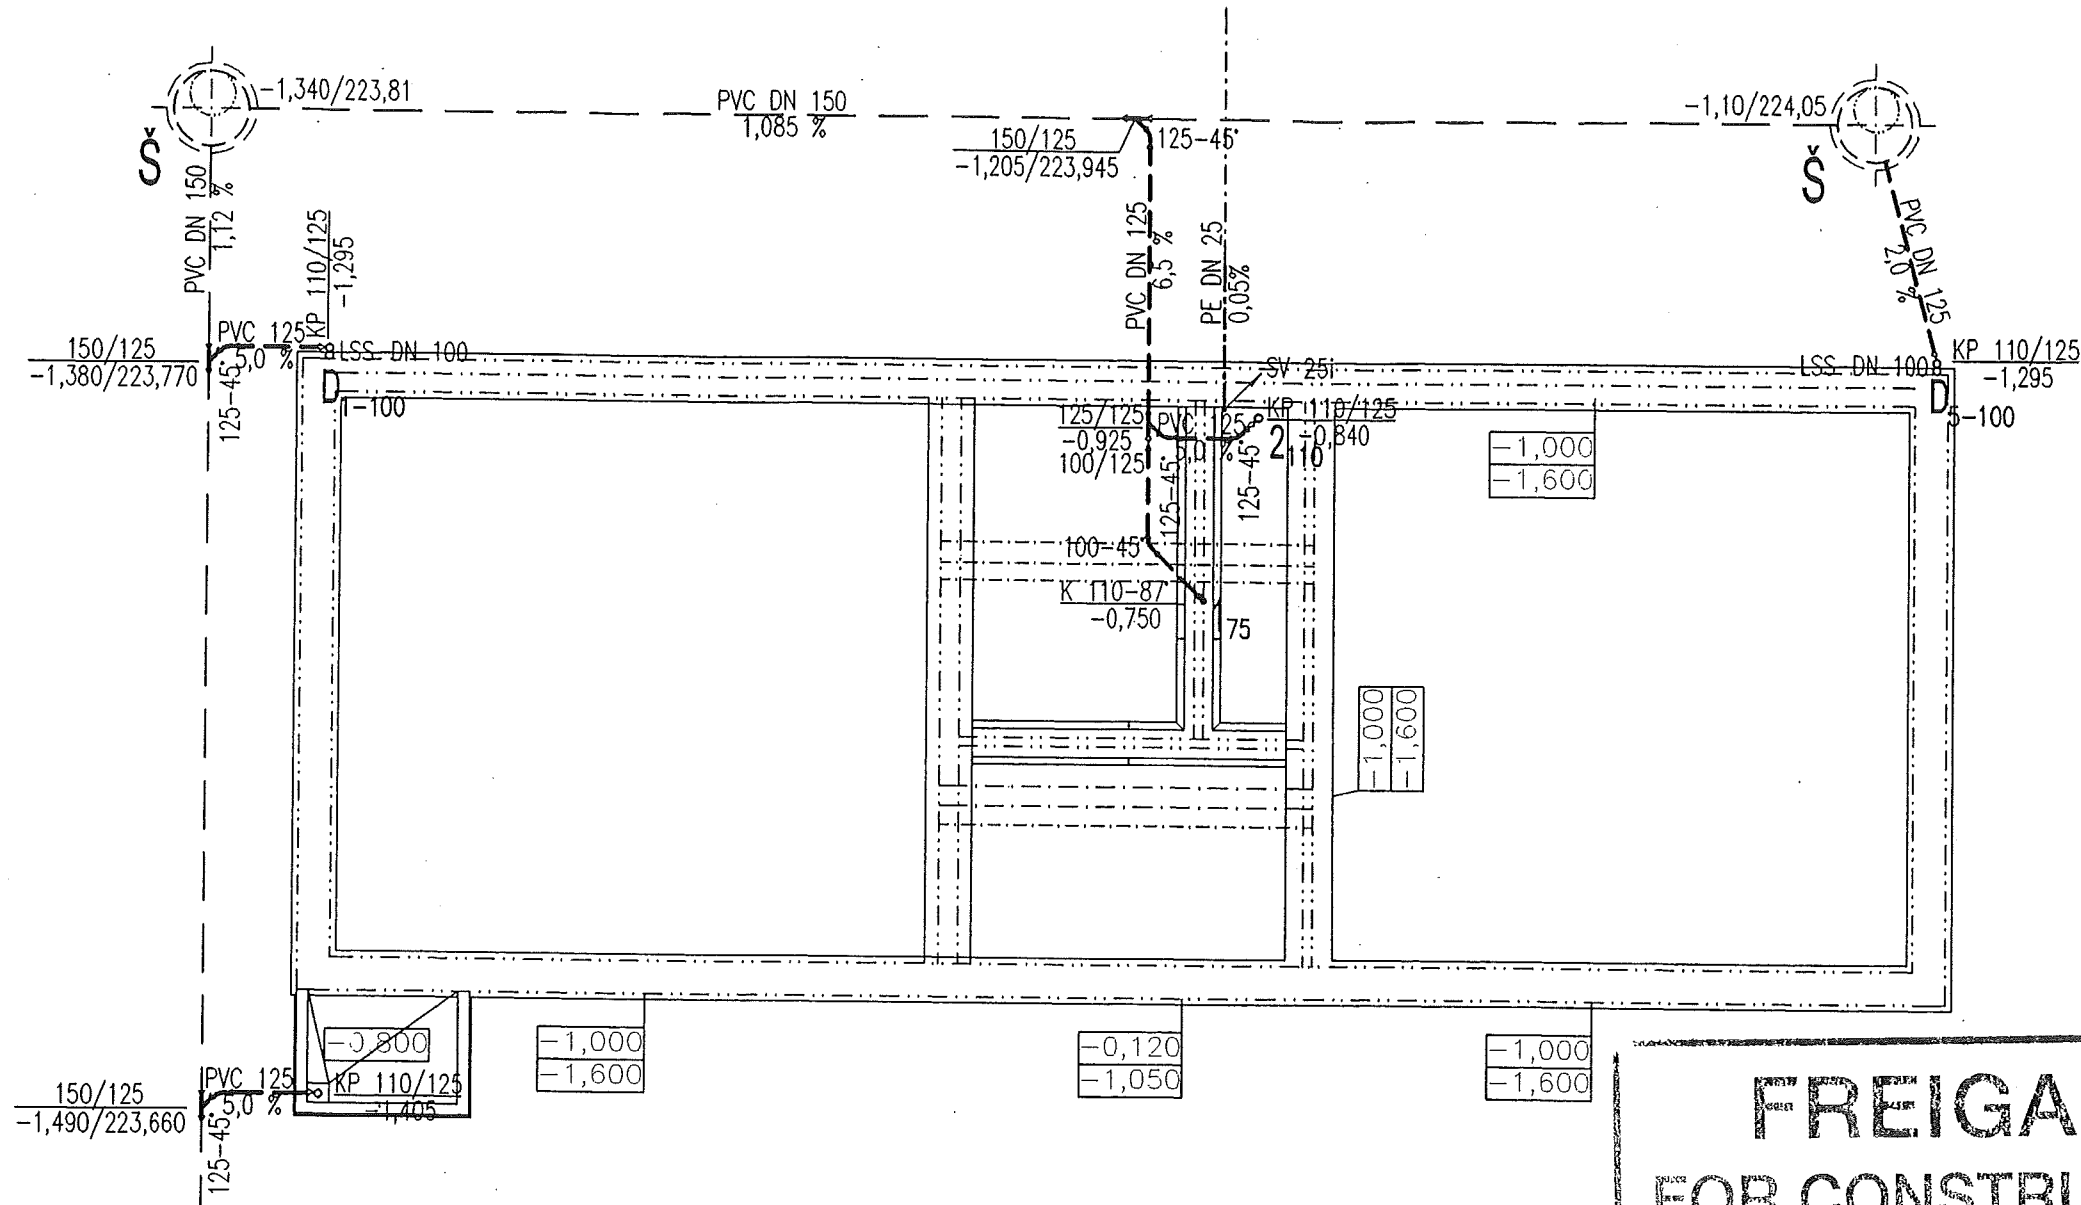


PŮDORYS ZÁKLADOV/PLANE OF FOUNDATIONS

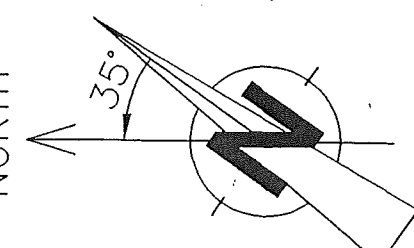

PROJEKT SKUTOČNÝ
VYHOTOVENIA

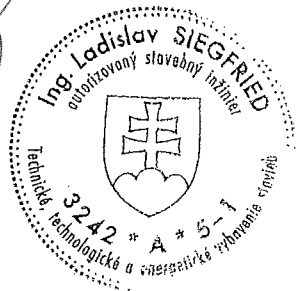

±0,000=225,150m.n.m

SPRACOVANÉ POD ZÁKAZKOVÝM ČÍSLOM:158/2004/SO/





Air Liquide AGS GmbH

Replaces: 792.87385
Replaced by: 792.87385


Date : 10.02.2005	Name : ING.GAVALEC	Checked: ING.SIEGFRIED	History file:	Rev. 0
Job code: K 70101	Reference: ASU No.9 KOSICE	Scale 1:100	Original format DIN A3	
Title: VELÍN/CONTROL BUILDING ZÁKLADY/FUNDATIONS	Drawing No.: 792.87385	Sheet: ---	of --- Sheets	Rev. 0
ZDRAVOTECHNICKÁ INŠTALÁCIA/PUBLIC HEALTH ENGINEERING				

PÔDORYS ±0,000 / PLANE ±0,000

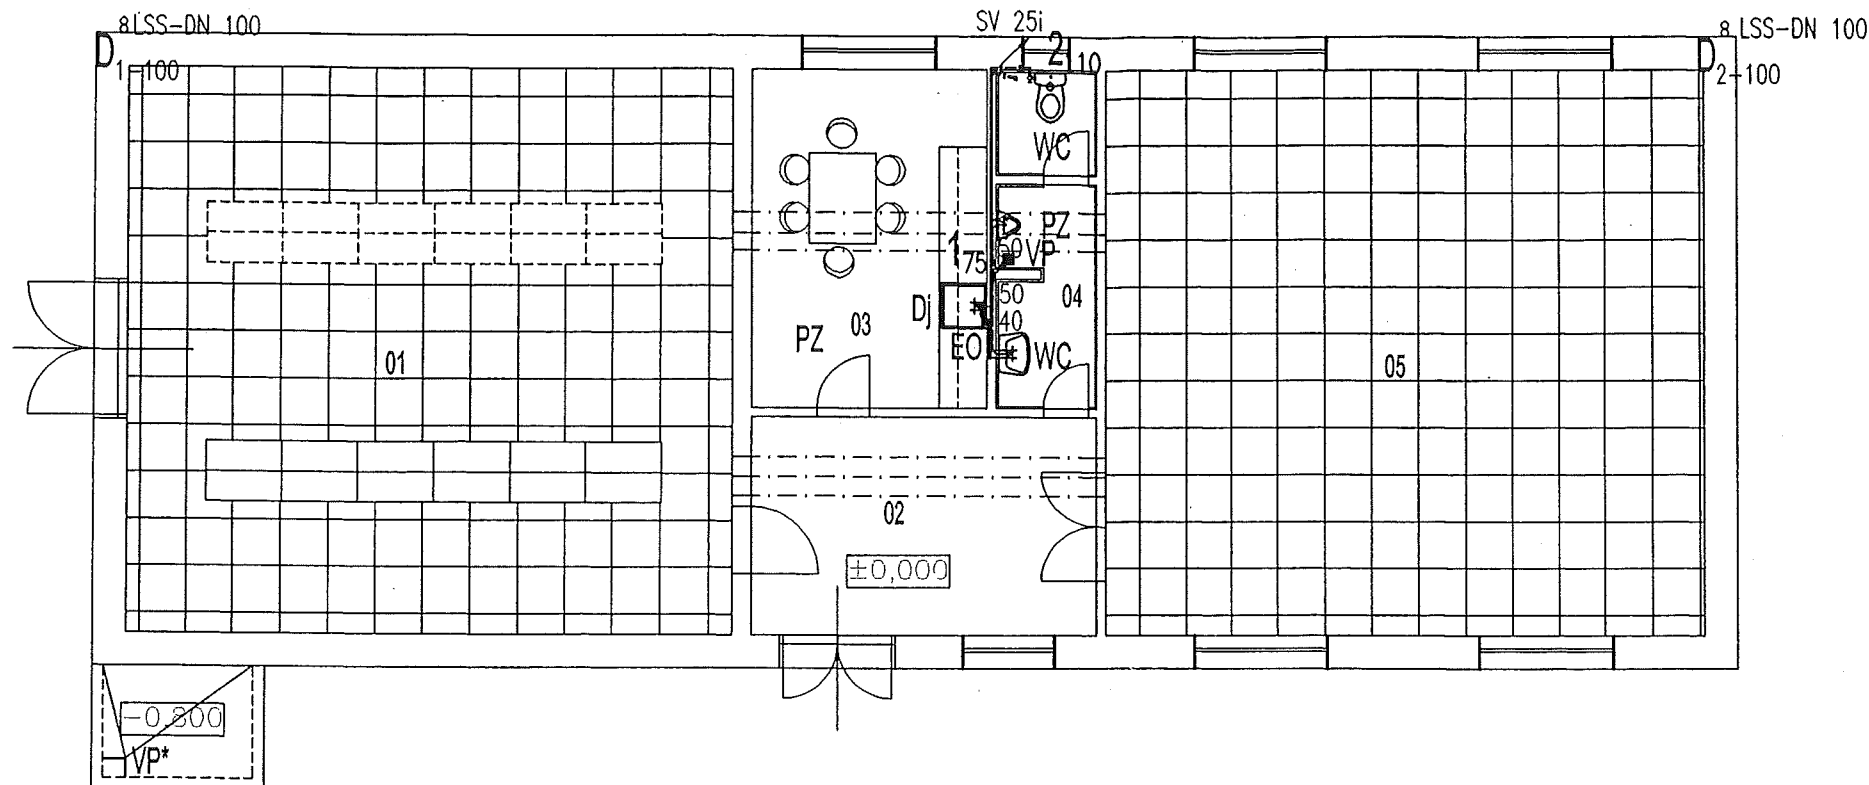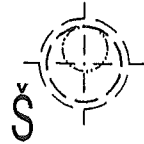

PROJEKT SKUTOČNÉHO
VYHOTOVENIA

**FREIGABE
FOR CONSTRUCTION**
Ra 06.04.05

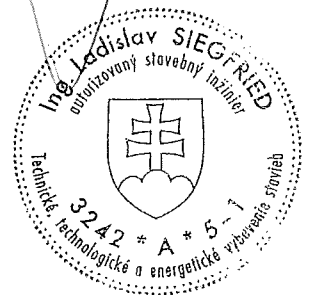

LEGENDA MIESTNOSTÍ/LEGEND OF ROOMS

Č.M. NO	NÁZOV MIESTNOSTI PURPOSE OF ROOMS	PLOCHA AREA m²	POVRCHOVÁ ÚPRAVA SURFACE FINISH			POZNÁMKA NOTES
			PODLAHY FLOORS	STIEN SURFACES	STROPU CEILINGS	
01	ELEKTROROZVODNA DCS ROOM	58,50m²	ZDVOJENA PODLAHA DOUBLE FLOOR	VÁP.CEM. OMIETKA PLASTER CALTIC-CEM.	VÁP.CEM. OMIETKA PLASTER CALTIC-CEM.	
02	CHODBA CORRIDOR	13,00m²	KERAM. DLAŽBA CERAMIC PAVING	VÁP.CEM. OMIETKA PLASTER CALTIC-CEM.	VÁP.CEM. OMIETKA PLASTER CALTIC-CEM.	
03	DENNÁ MIESTNOSŤ TEA PLACE	13,80m²	KERAM. DLAŽBA CERAMIC PAVING	VÁP.CEM. OMIETKA PLASTER CALTIC-CEM.	VÁP.CEM. OMIETKA PLASTER CALTIC-CEM.	
04	WC TOILET	13,55m²	KERAM. DLAŽBA CERAMIC PAVING	VÁP.CEM. OMIETKA PLASTER CALTIC-CEM.	VÁP.CEM. OMIETKA PLASTER CALTIC-CEM.	KER.OBKLAÐ-VÝŠKA 2000mm CERAMIC FACING-HEIGHT 2000mm
05	RIADIACA MIESTNOSŤ CONTROL ROOM	58,50m²	ZDVOJENA PODLAHA DOUBLE FLOOR	VÁP.CEM. OMIETKA PLASTER CALTIC-CEM.	VÁP.CEM. OMIETKA PLASTER CALTIC-CEM.	

±0,000=225,150m.n.m

SPRACOVANÉ POD ZÁKAZKOVÝM ČÍSLOM:158/2004/S0/




Replaces: 792.87386
Replaced by: 792.87386

Date : 10.02.2005	Name : ING.GAVALEC	Checked: ING.SIEGFRIED	History file:	Rev. 0
Job code: K 70101	Reference: ASU No.9 KOSICE	Scale: 1:100	Original format: DIN A2	
Title: VELÍN/CONTROL BUILDING PÔDORYS±0,000/PLANE±0,000 ZDRAVOTECHNICKÁ INŠTALÁCIA/PUBLIC HEALTH ENGINEERING		Drawing No.: 792.87386	Sheet: --- of --- Sheets	Rev. 0

This drawing is protected by copyright. It may not be copied or used without our written authorization and it is strictly prohibited to disclose it to any third parties.


ZVISLÁ SCHÉMA / VERTICAL SCHEMA

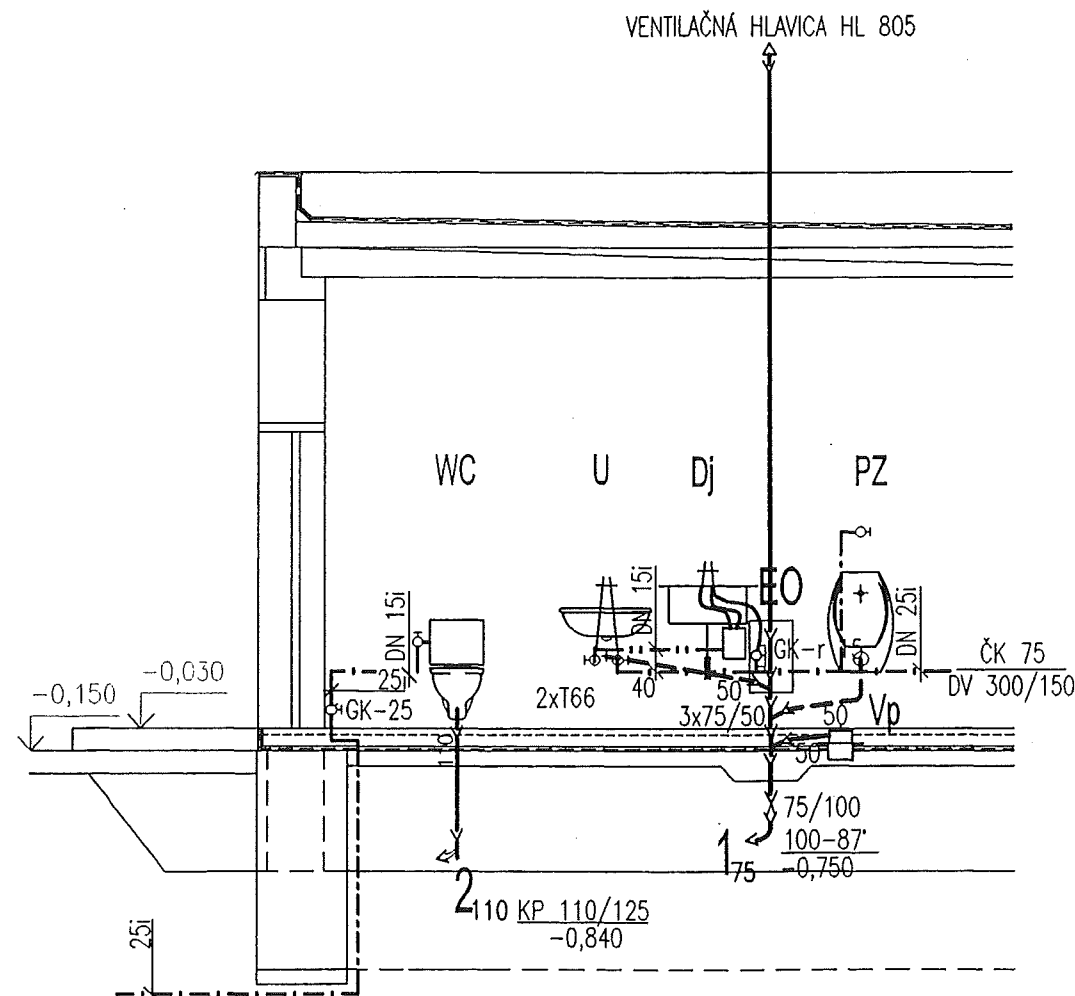

VZOROVÝ PRIEČNY REZ/SAMPLE CROSS SECTION

POTRUBIE IPE, rPE/PIPELINE IPE, rPE

KANALIZAČNÉ RÚRY PVC/ PVC SEWERAGE PIPE

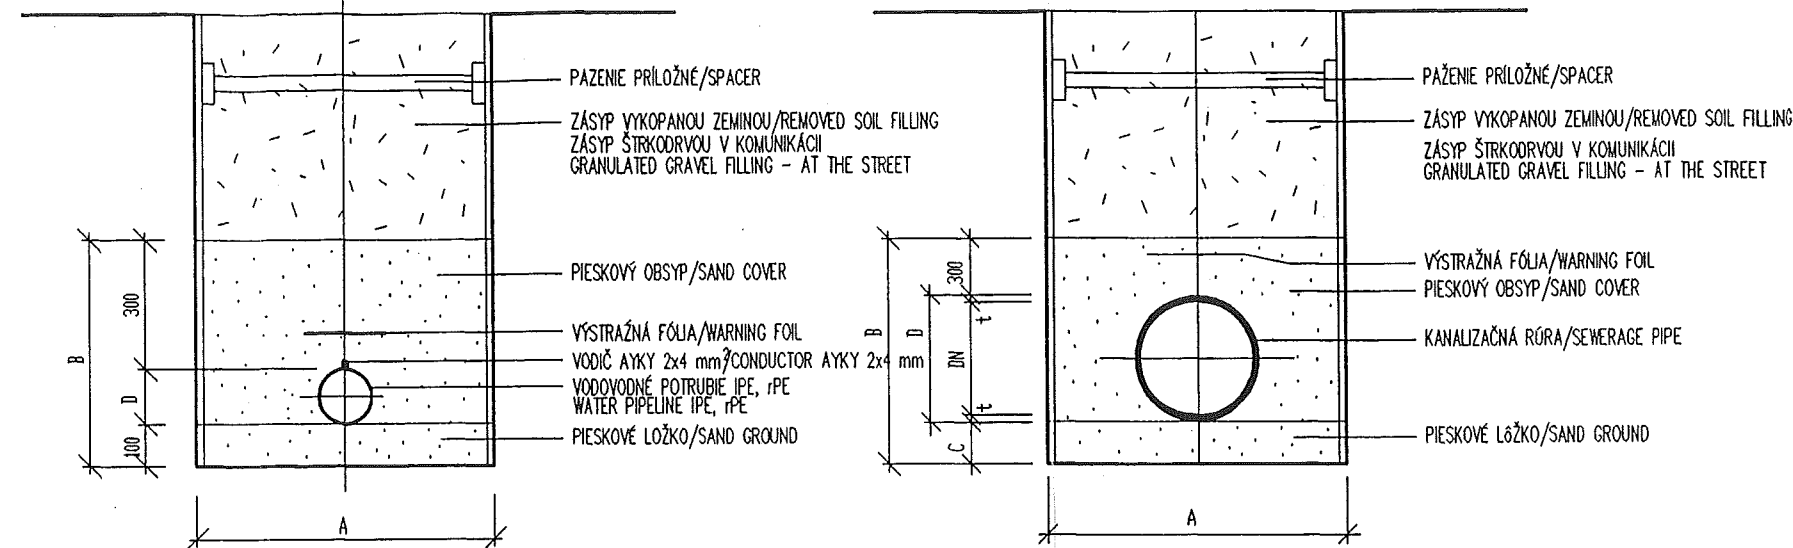


DN	D	A	B	KUBATÚRA/VOLUME [m³]		
				LOŽKA/GROUND	OBSYP/COVER	VYTLAČ./FORCED OUT
25	32x2.9	1100	432	0,11	0,3644	0.4752
32	40x3.6	1100	440	0,11	0,3727	0.4840
40	50x4.5	1100	450	0,11	0,3830	0.495

DN	C	D	A	B	t	KUBATÚRA/VOLUME [m³]		
						LOŽKA/GROUND	OBSYP/COVER	VYTLAČ./FORCED OUT
100	110	110	1100	520	3,0	0,121	0,4415	0,5720
125	120	125	1100	545	3,1	0,132	0,4557	0,6000
150	120	160	1100	580	4,0	0,132	0,4859	0,6380

FREIGABE
FOR CONSTRUCTION
Ra 16.04.05


PROJEKT SKUTOČNÉHO
VYHOTOVENIA

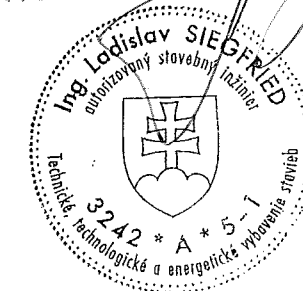

±0,000=225,150m.n.m

10

SPRACOVANÉ POD ZÁKAZKOVÝM ČÍSLOM:158/2004/S0/

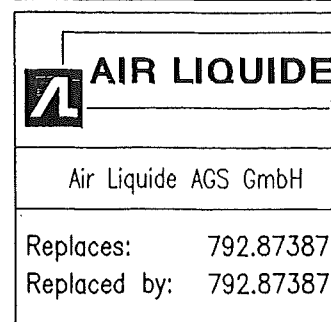

Date : 10.02.2005	Name : ING.GAVALEC	Checked: ING.SIEGFRIED	History file:	Rev. 0
Job code: K 70101	Reference: ASU No.9 KOSICE	Scale 1:50	Original format DIN A3	
Title: VELÍN/CONTROL BUILDING ZVISLÁ SCHÉMA/VERTICAL SCHEMA ZDŤAVOTECHNICKÁ INŠTALÁCIA/PUBLIC HEALTH ENGINEERING	Drawing No.: 792.87,387	Sheet: --- of --- Sheets	Rev. 0	