

PODORYS ±0,000/ PLANE ±0,000

Ventilátor - TD 250/100 (90-140 m³/h)
Fan - TD 250/100 (90 - 140 m³/h)
26-40 W, 220-240 V, 50 Hz, 0,18-0,26 A
OM.AD.-KLIMATIZAČ. JEDNOTOU
HANDL.- AIRCONDITIONING UNIT


VNÚTERNÁ JED. FT060BY1B
INSIDE UNIT FT060BY1B
PRÍKON 140 W, 240 V, 50 Hz
INPUT POWER 140 W, 240V, 50Hz
OVLAD.- VLASTNÉ INFRA
HANDL.- INFRA CONTROL SYSTEM

VONKAJŠIA JEDNOTKA RXS60BYMB
OUTSIDE UNIT RXS60BYMB
CHLAD. VÝKON 0,90-5,80-6,00 kW
COOLING POWER 0,90-5,80-6,00 kW
PRÍKON - CHLADENIE 0,45-2,07-2,15 kW
COOLING INPUT POWER 0,45-2,07-2,15 kW
VÝKUR. VÝKON 0,90-7,00-8,00 kW
HEATING POWER 0,90-7,00-8,00 kW
PRÍKON - KŮŘENÍ 0,45-2,49-2,92 kW
HEATING INPUT POWER 0,45-2,49-2,92 kW
OVLAD.- VLASTNÉ AUTOM.
HANDL.- CUSTOM CONTROL SYSTEM

VONKAJŠIA JEDNOTKA RXS60BYMB
OUTSIDE UNIT RXS60BYMB
CHLAD. VÝKON 0,90-5,80-6,00 kW
COOLING POWER 0,90-5,80-6,00 kW
PRÍKON - CHLADENIE 0,45-2,07-2,15 kW
COOLING INPUT POWER 0,45-2,07-2,15 kW
VÝKUR. VÝKON 0,90-7,00-8,00 kW
HEATING POWER 0,90-7,00-8,00 kW
PRÍKON - KŮŘENÍ 0,45-2,49-2,92 kW
HEATING INPUT POWER 0,45-2,49-2,92 kW
OVLAD.- VLASTNÉ AUTOM.
HANDL.- CUSTOM CONTROL SYSTEM

VNÚTERNÁ JED. FT060BY1B
INSIDE UNIT FT060BY1B
PRÍKON 140 W, 240 V, 50 Hz
INPUT POWER 140 W, 240V, 50Hz
OVLAD.- VLASTNÉ INFRA
HANDL.- INFRA CONTROL SYSTEM

Ventilátor - TD 250/100 (90-140 m³/h)
Fan - TD 250/100 (90 - 140 m³/h)
26-40 W, 220-240 V, 50 Hz, 0,18-0,26 A
OM.AD.-KLIMATIZAČ. JEDNOTOU
HANDL.- AIRCONDITIONING UNIT

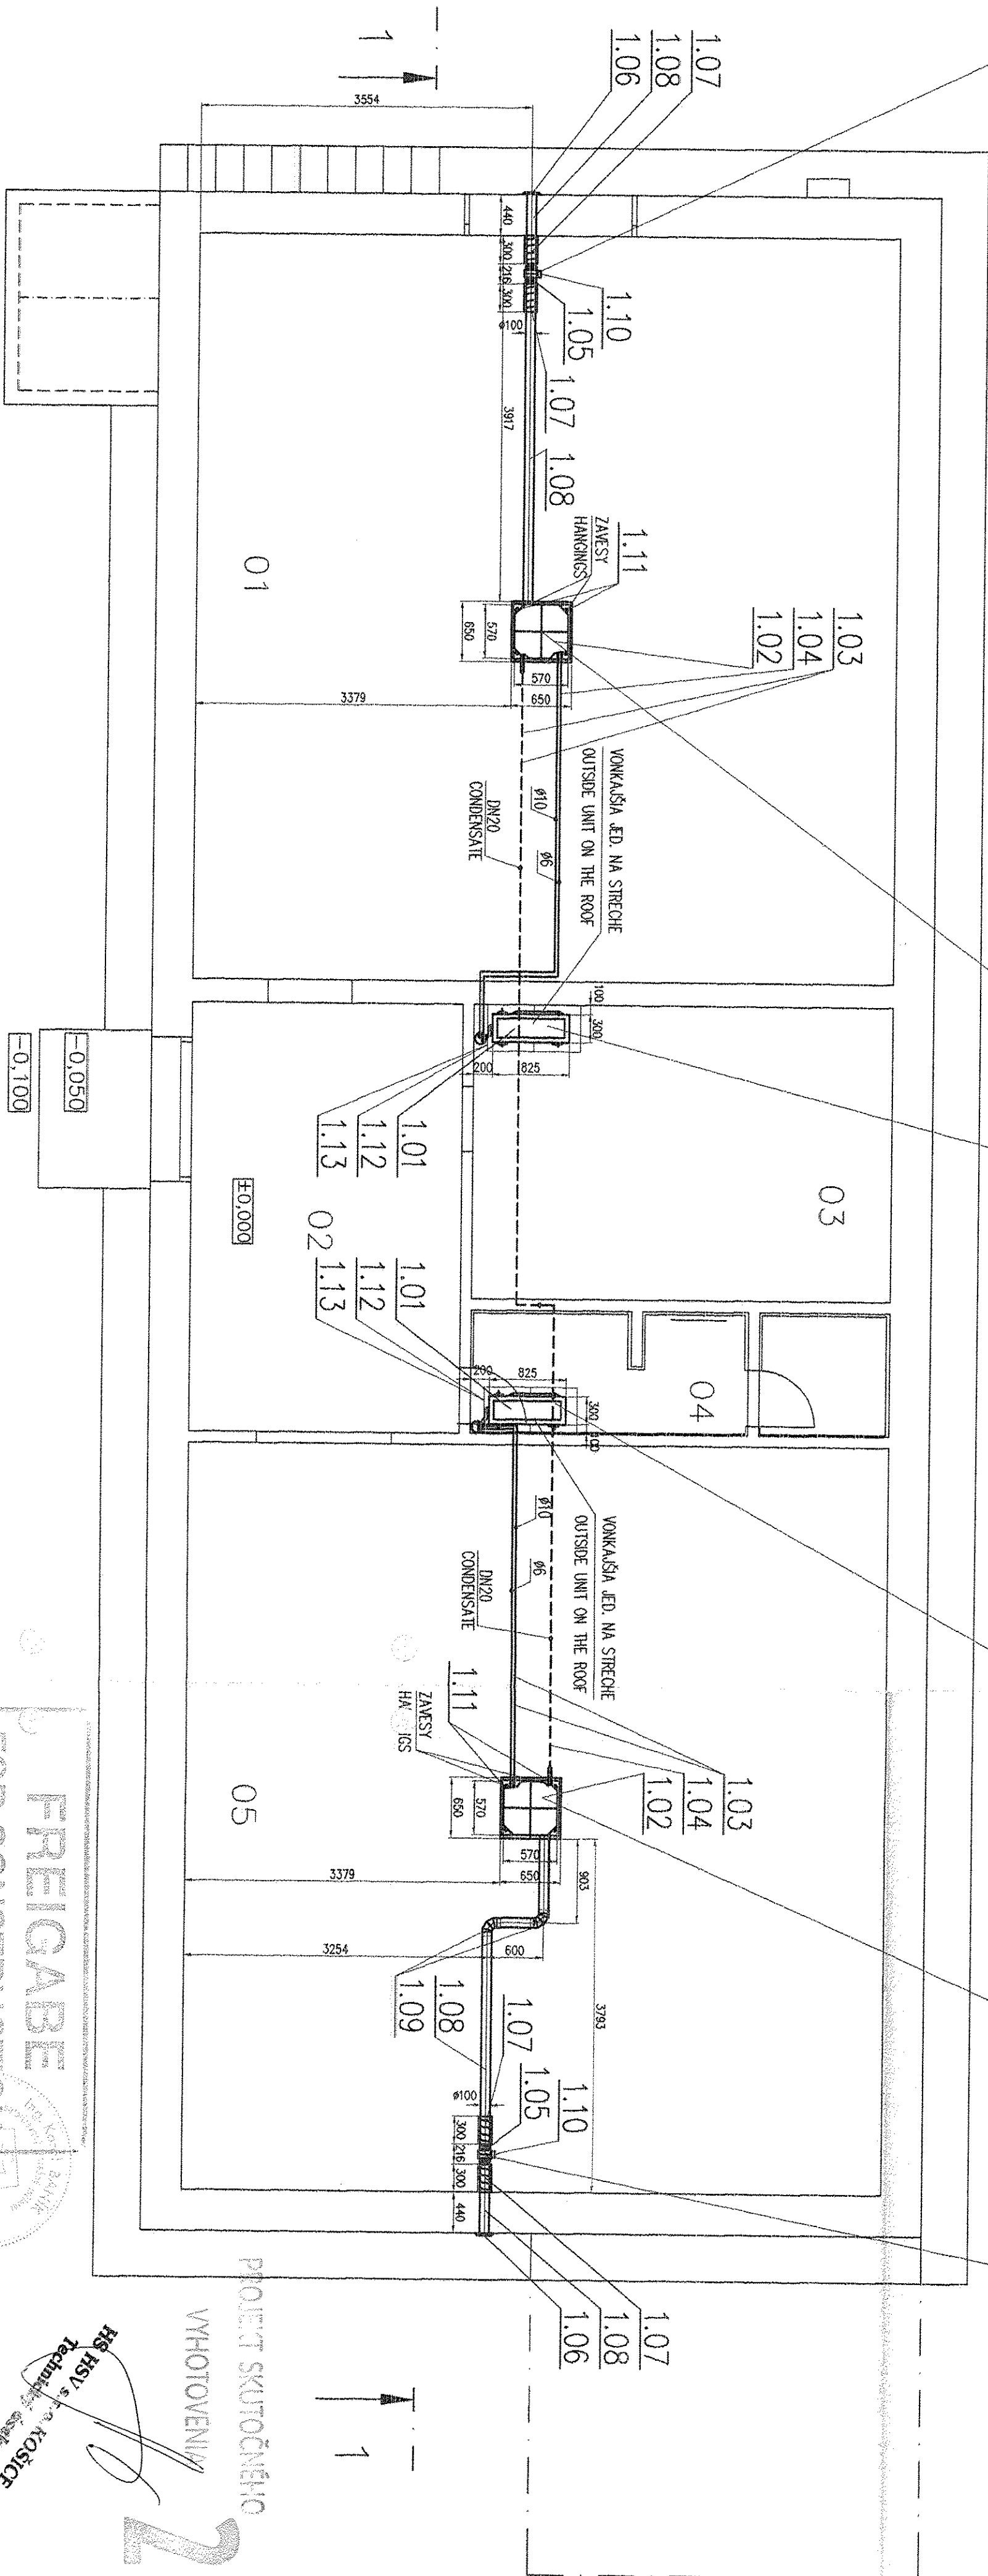

LEGENDA MIESTNOSTI
LEGEND OF ROOMS

Č.M. NO	NÁZOV MIESTNOSTI PURPOSE OF ROOMS	PLOCHA AREA m ²
01	MIESTNOST DCS DCS ROOM	58,50m ²
02	CHODBA CORRIDOR	13,00m ²
03	DENNÁ MIESTNOST TEA PLACE	13,80m ²
04	TOILET WC	13,55m ²
05	RADIČNÁ MIESTNOST CONTROL ROOM	58,50m ²

±0,000=225,150m.n.m

PLANT NORTH

SPRACOVANÉ POD ZAKAZKOVÝM ČÍSLOM:158/2004/50/

PREIGABE
FOR CONSTRUCTION

AIR LIQUIDE

Date : JANUAR 2005 Name : ING.BANK Checked: ING.RACK History file: Rev. 0

Job code: K 70101 Reference: ASU No.9 KOSICE

Title:VEJN/CONTROL BUILDING DISPOZICIA/DISPOSITION VZDUCHOTECHNIKA/VENTILATION

Replaces: 79 Replaced by: 79

Drawing No.: 792.87393 Rev. 0

Scale 1:50 Original format DIN A2

Sheet: 1 of 1

This drawing is protected by copyright. It may not be copied or used without our written authorization and it is strictly prohibited to disclose it to any third parties.