POHLAD JUHOZÁPADNÝ/ SOUTHWEST VIEW

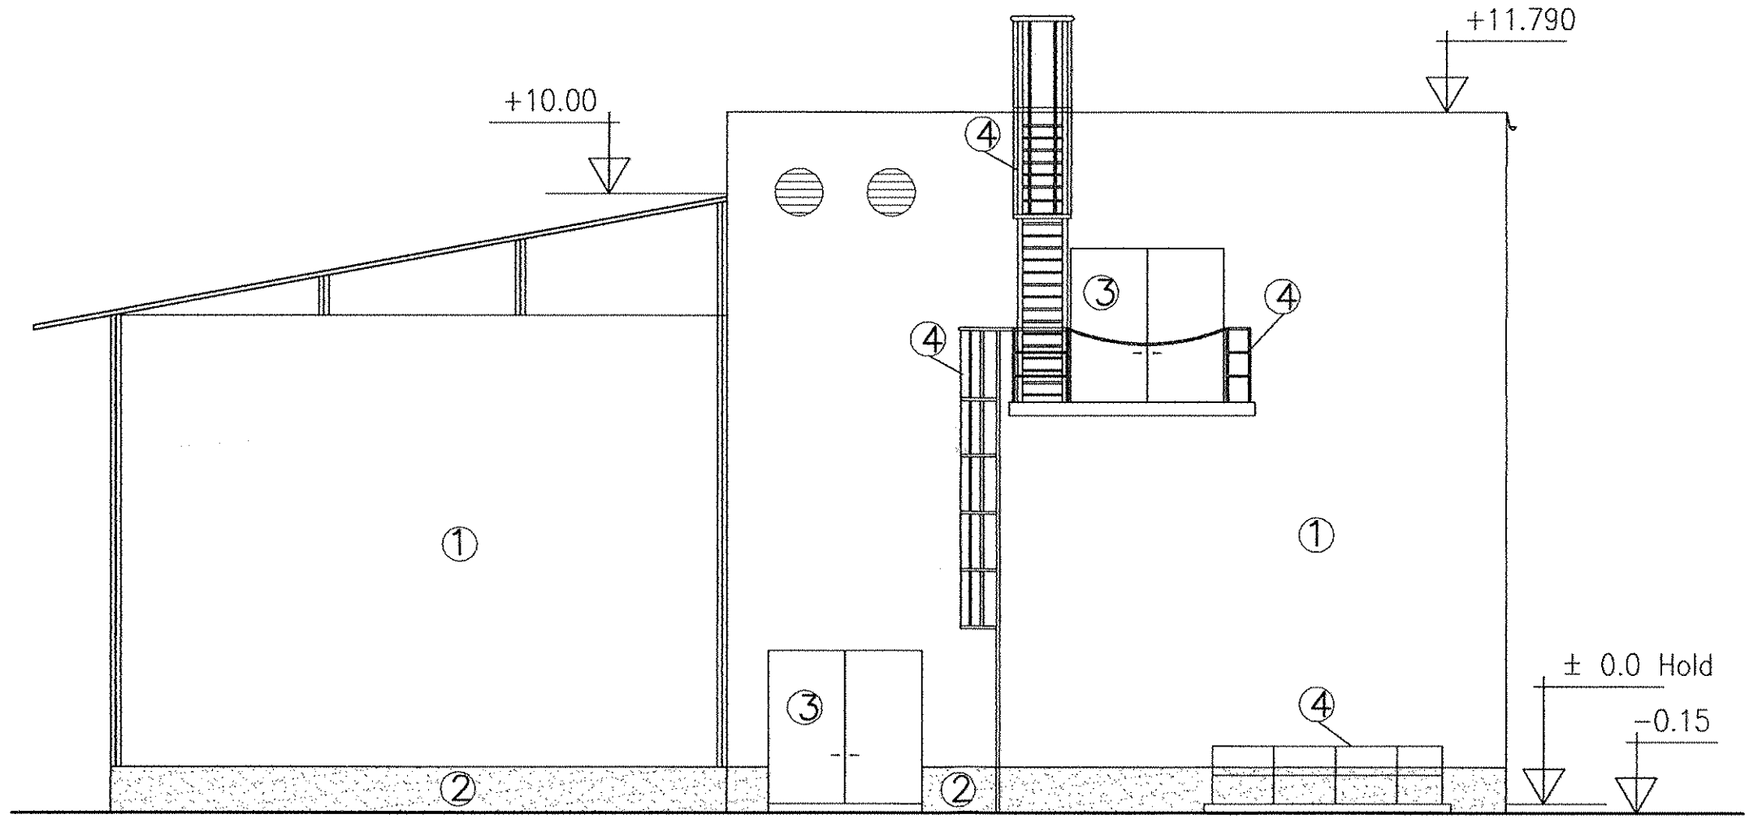

POHLAD JUHOVÝCHODNÝ/SOUTH-EAST VIEW

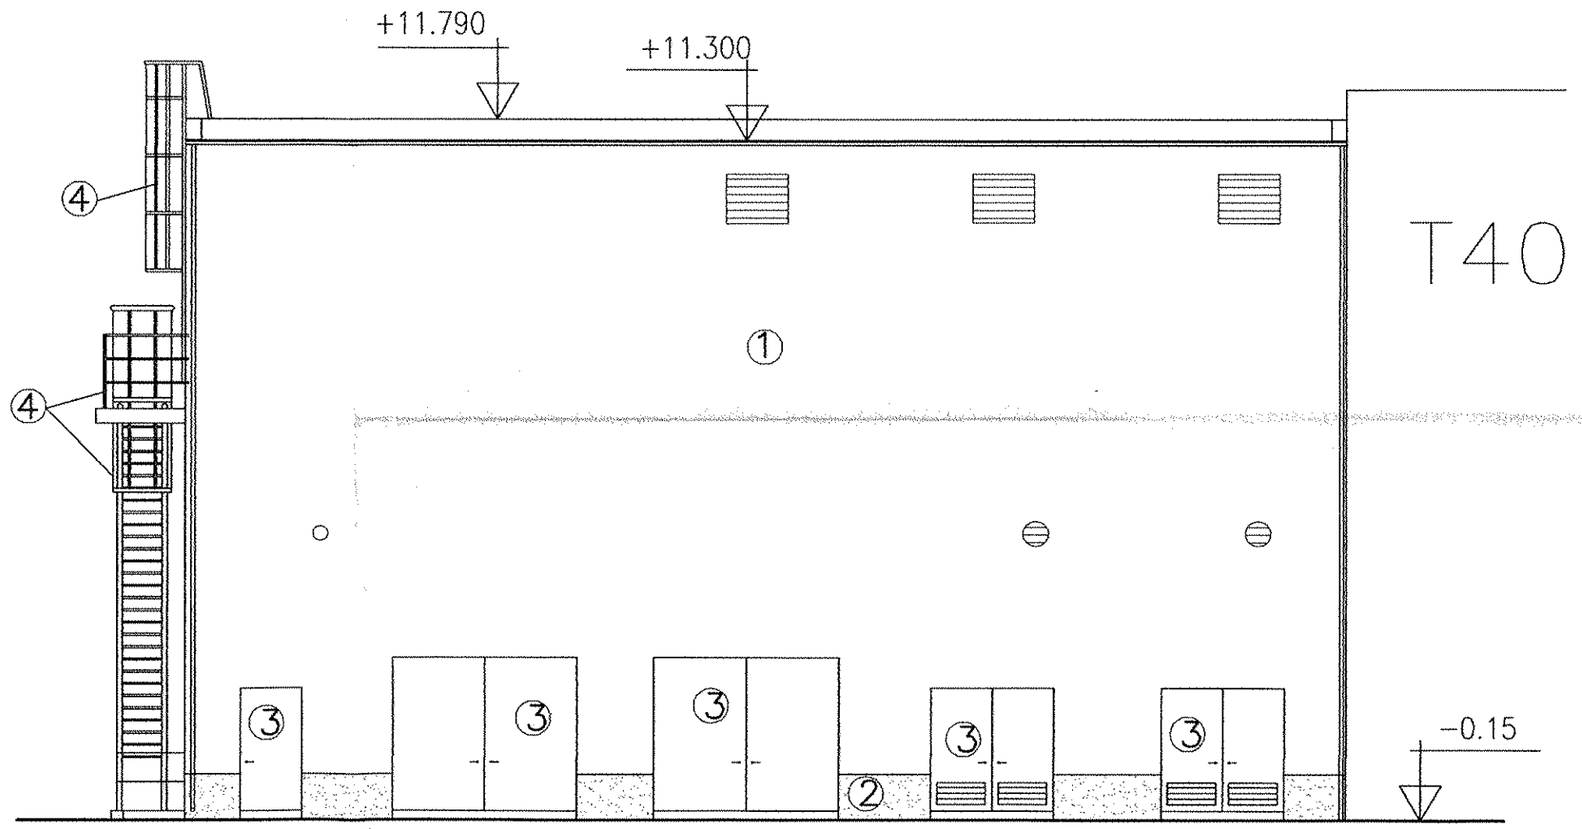

POHLAD SEVEROZÁPADNÝ/NORTHWEST VIEW

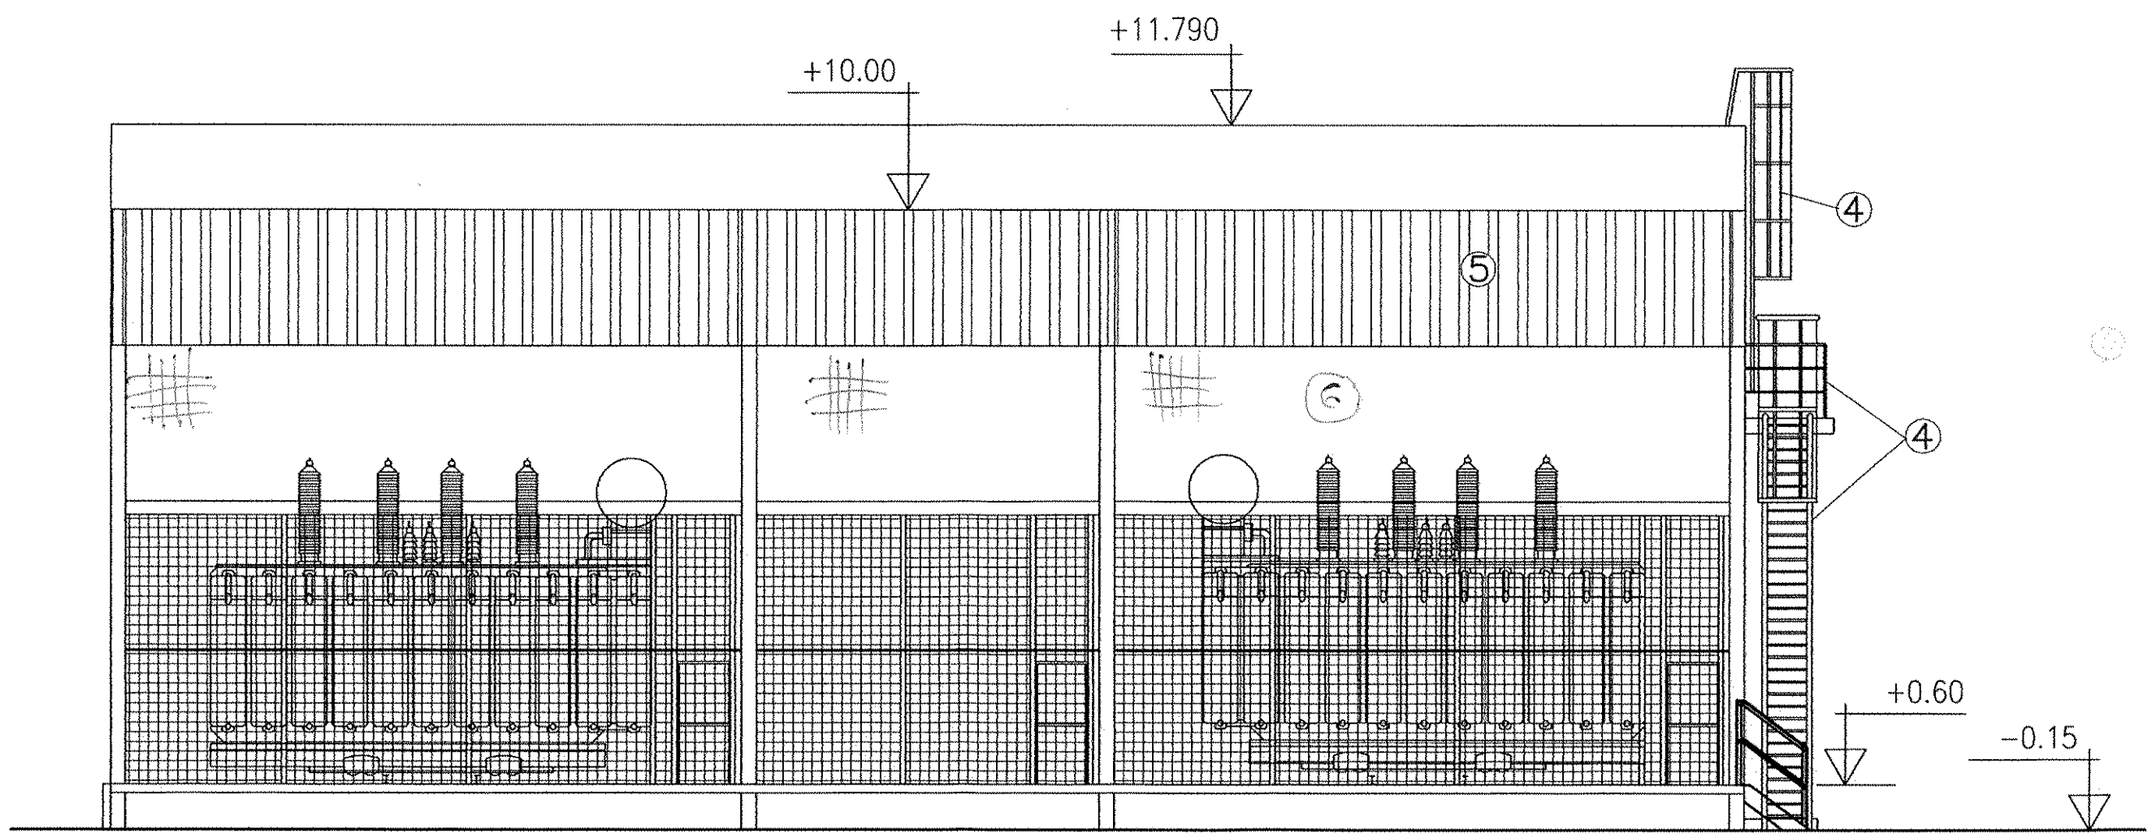

① OMIETKA BAUMIT GRANOLAN/ EXTERNAL RENDERING BAUMIT GRANOLAN-SMILE 3045

② SOKEL BAUMIT MOZIAKOVA OMIETKA/SOCLE BAUMIT MOSAIKRENDERING-070

③ DVERE-FARBA MODRÁ/ DOORS-RAL 5005

④ KLAMPIARSKE A ZÁMOČNÍCKE PRÁCE-FARBA MODRÁ/PLUMBERING,FITTING WORKS-RAL 5005

⑤ STRECHA-FARBA MODRÁ/PLUMBERING,FITTING WORKS-RAL 5005

⑥ OCHRANÁ SIEŤ PROTI VTÁKOM
PROTECTED GRID (BIRD)

FREIGABE
FOR CONSTRUCTION
Ra 17.08.05

PROJEKT SKUTOČNÉHO VYHOTOVENIA
Ing. Beáta KOVÁČOVÁ
1215 * Z * A-1
Stavebné konštrukcie

HS HSV s.r.o. KOŠICE
Technický

±0,000=224,530m.n.m
SPRACOVANÉ POD ZÁKAZKOVÝM ČÍSLOM:158/2004/SO/

4

REFLEX-PRO spol. s r.o.				
15.08. 2005	ING.KOŠTENSKÁ	ING.RAČEK	ZMENA JUHOZÁPADNÉHO POHLADU / CHANGE SOUTHWEST VIEW	A
Date :	Name :	Checked:	History file:	Rev.
25.07. 2005	ING.KOŠTENSKÁ	ING.RAČEK		0

AIR LIQUIDE

Air Liquide AGS GmbH

Job code: K 70101
Reference: ASU No.9 KOSICE

Scale 1:100 | Original format DIN A2
Sheet: --- | of --- Sheets

Replaces: 79_.-----
Replaced by: 79_.-----

Title: ROZVODŇA T80
ELECTRICAL ROOM T80
POHLADY/VIEW

Drawing No.: 792.87663 | Rev. A

This drawing is protected by copyright. It may not be copied or used without our written authorization and it is strictly prohibited to disclose it to any third parties.