


STAV PO MONTÁŽNEJ ÚPRAVE

^PŮVODNÝ STAV

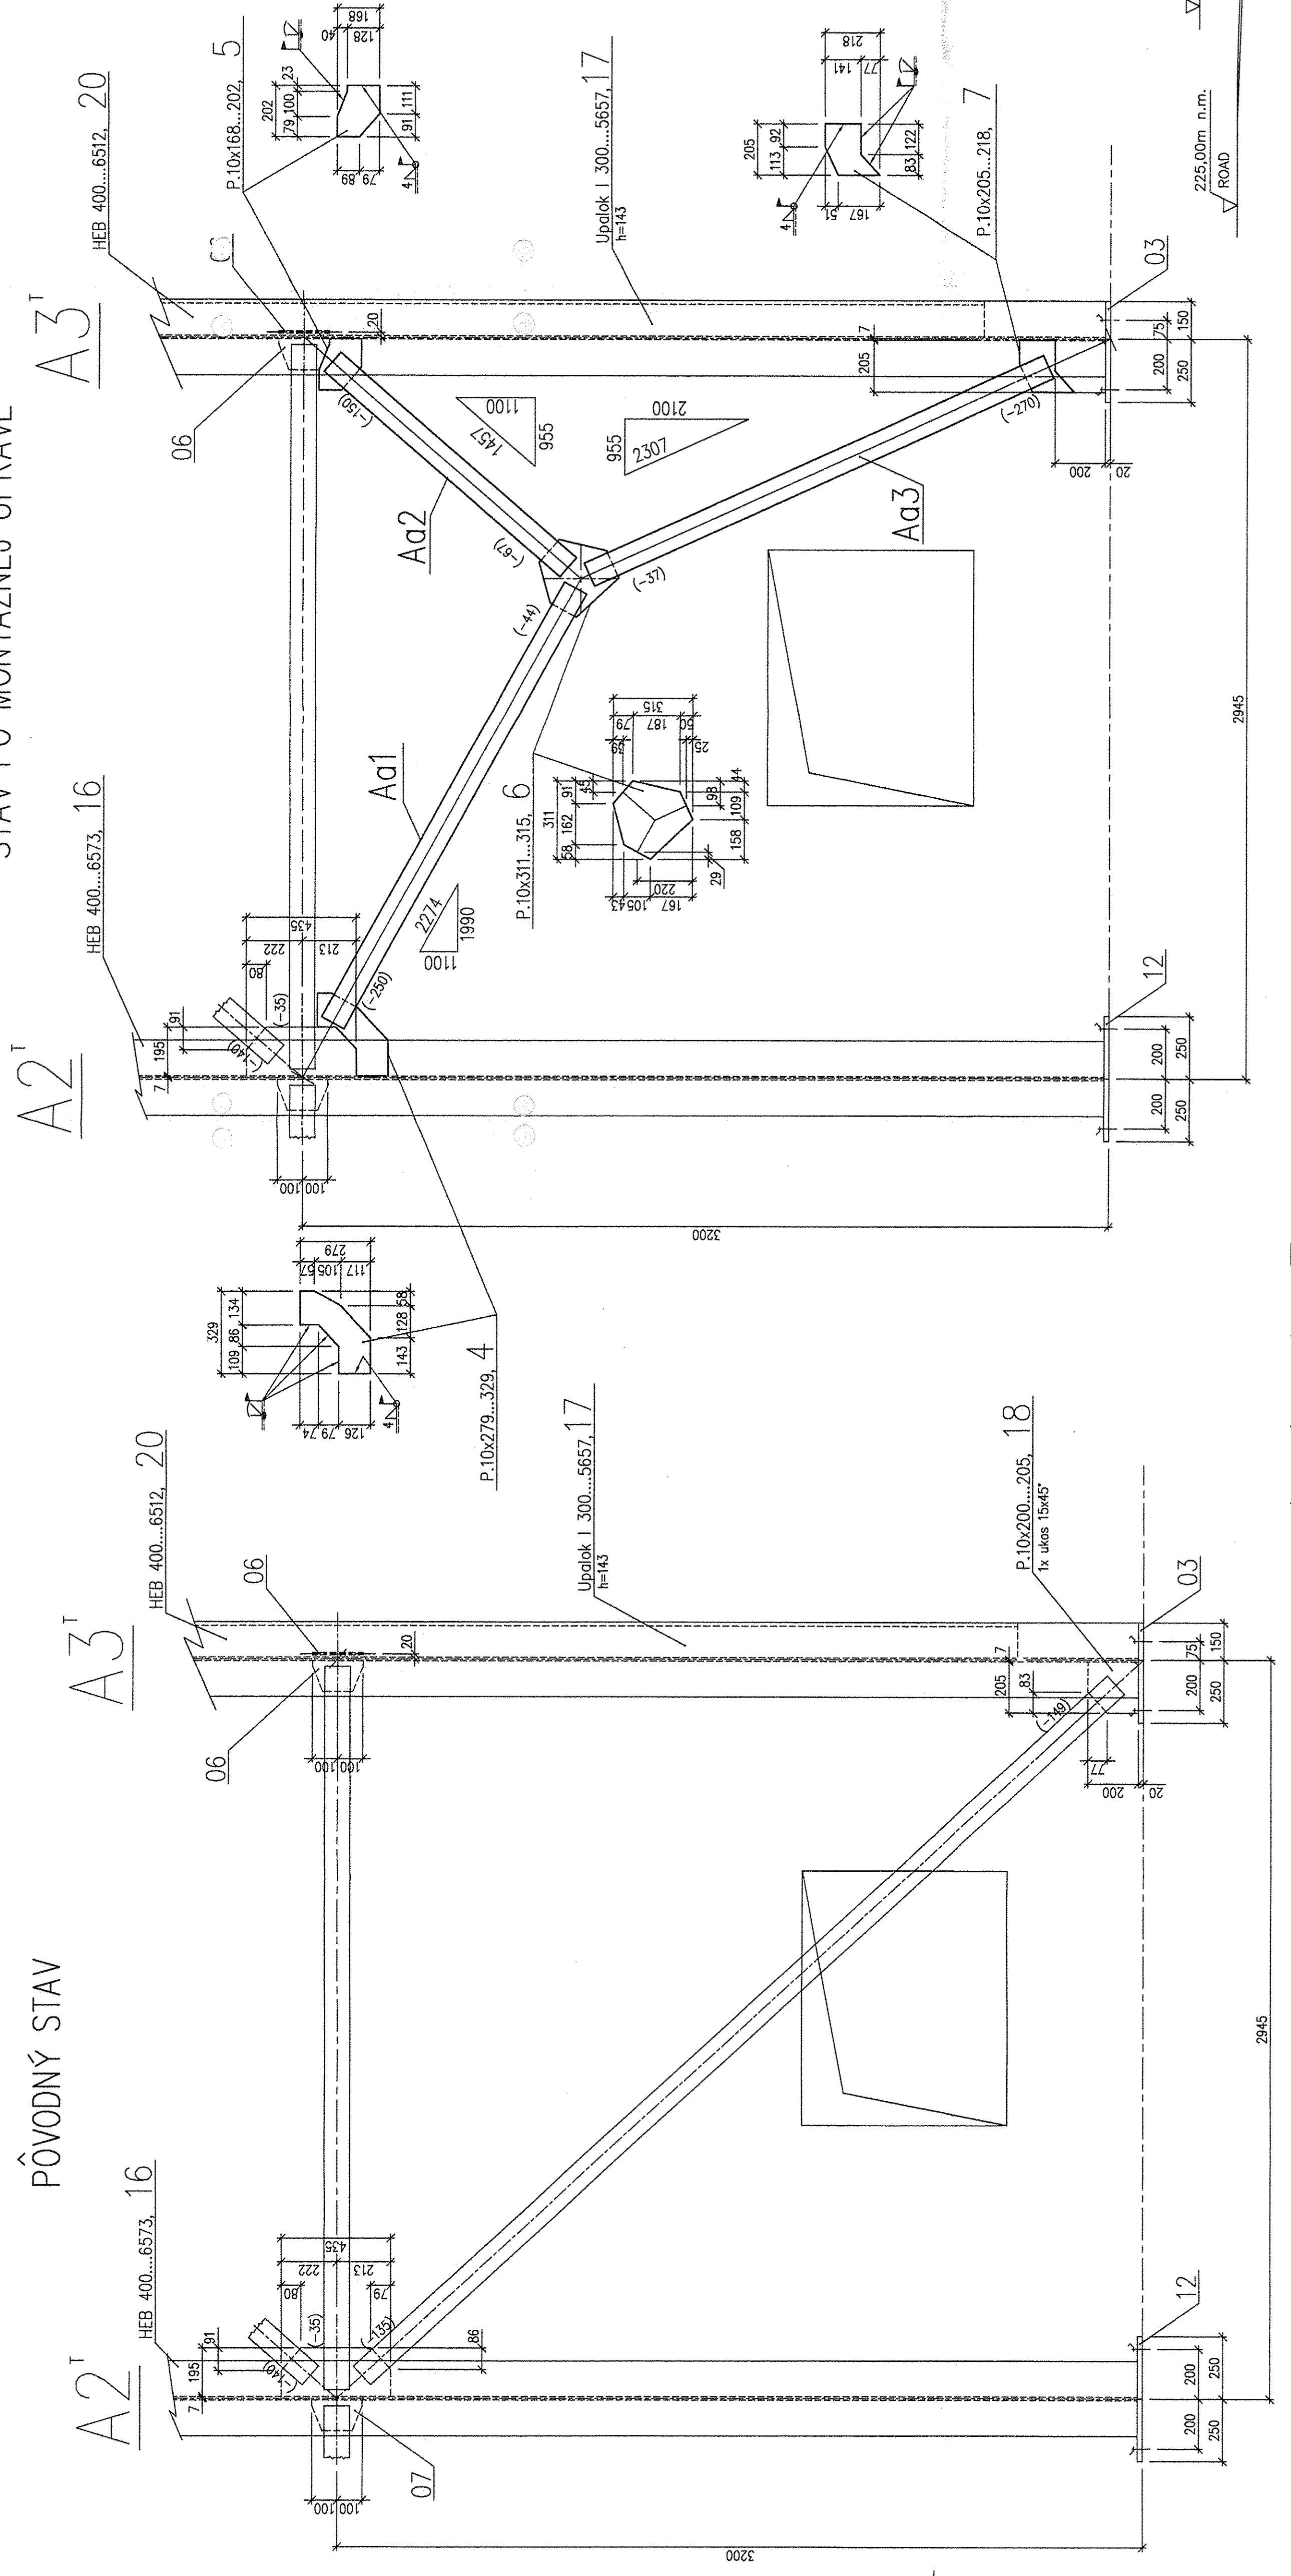

LEVELS

TOP OF INTERNAL ROADS:

TOP OF FOUNDATION:

BOTTOM OF STEEL STRUCTURE OR EQUIPMENT: 225,15m = $\pm 0,00$

HS HSV s.r.o. KOŠICE
Technický úsek


PLANT
NORTH

**FREIGABE
FOR CONSTRUCTION**

Na 10.00.05
PROJEKT SKITOČ

$\pm 0,000 = 225,15$ m n. Jadran

PROJEKT PRE REALIZÁCIU STAVBY POD Z. č. 3821.2.001.0K-01

	<div style="border: 1px solid black; padding: 2px; display: inline-block;"> AIR LIQUIDE </div>		JOB CODE: K70101		SCALE 1:15		ORIGINAL FORMAT 8x44	
	B A	O REV	05.08.2005 DATE	INC. PAVLOV CHECKED	DOKSANA NAME	SHEET 001b	OF 003 SHEETS	REV.
TITLE: UNIT 6 AIR SEPARATION - CONSTRUCTION DESIGN-BUILDING PART 1 501 001 LOW TEMPERATURE BLOCK GROUND STABILIZATION / MODIFICATION OF BLOCK								
REPLACES: 79...		DRAWING NO.: 792.87437 B						
REPLACED BY: 79...								

DIELEC	P	PROFIL	L	S	X1	X2	KS
Aa1	1	TR 4HR 100x5	1980	2274	250	44	-1x
Aa2	2	TR 4HR 100x5	1240	1457	150	67	-1x
Aa3	3	TR 4HR 100x5	2000	2307	37	270	-1x