C – C

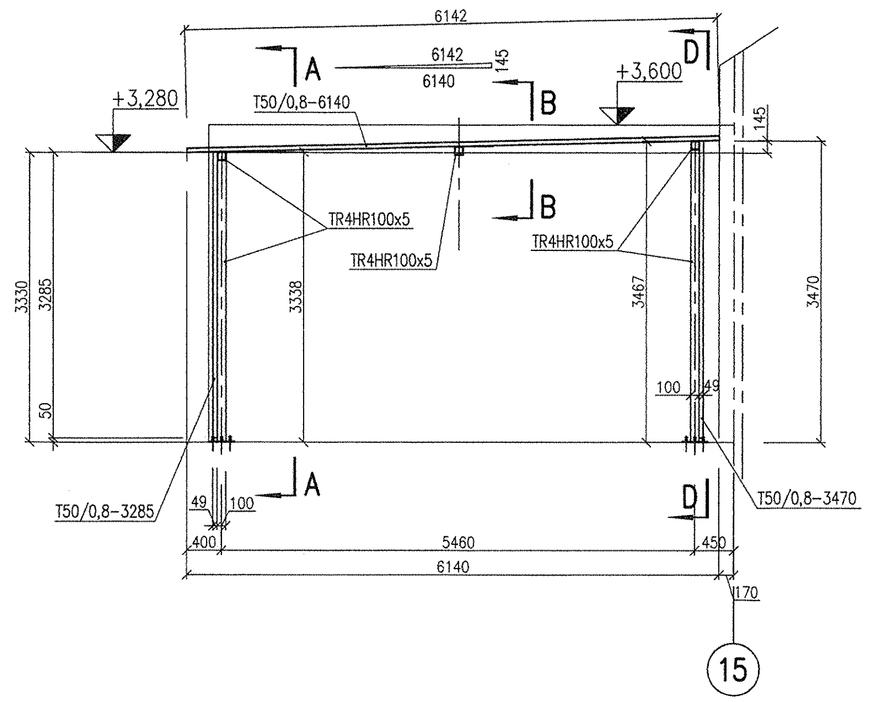

A – A

M 1:20

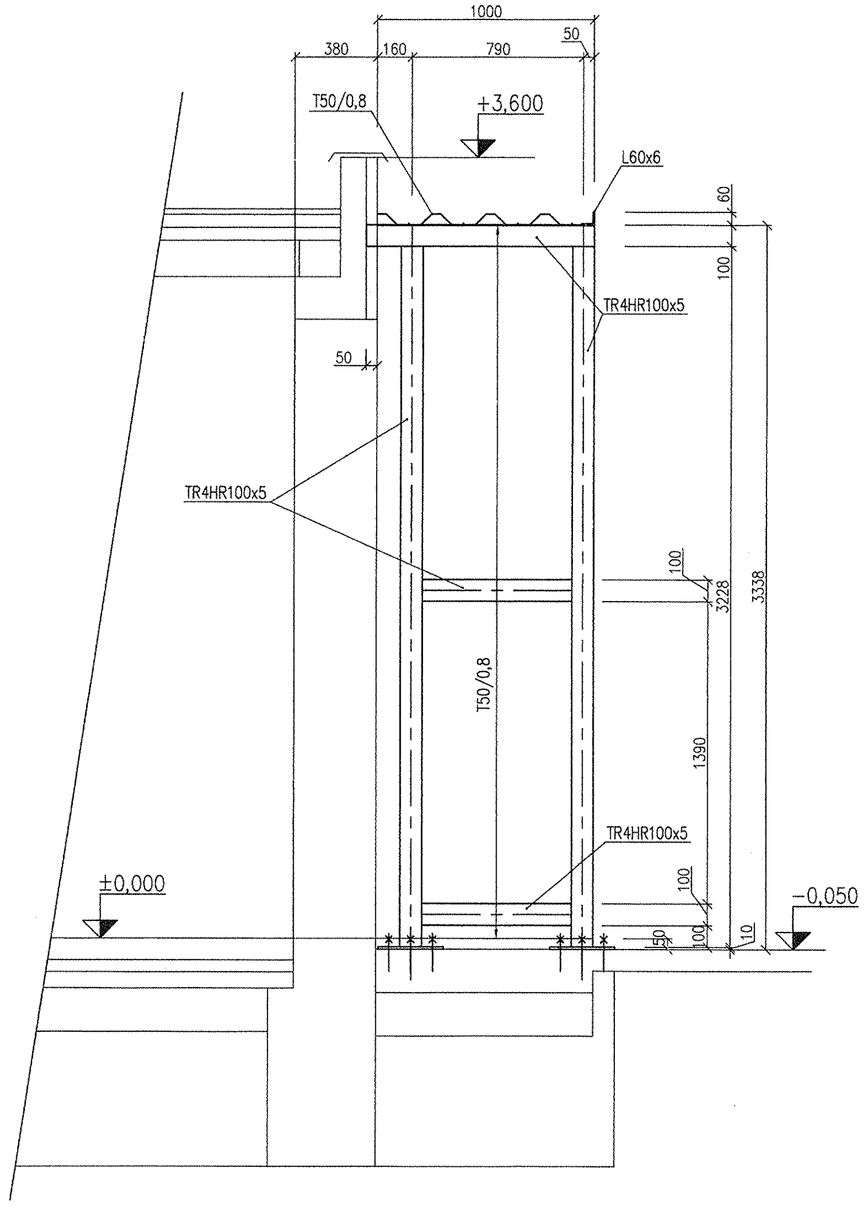

D – D

M 1:20

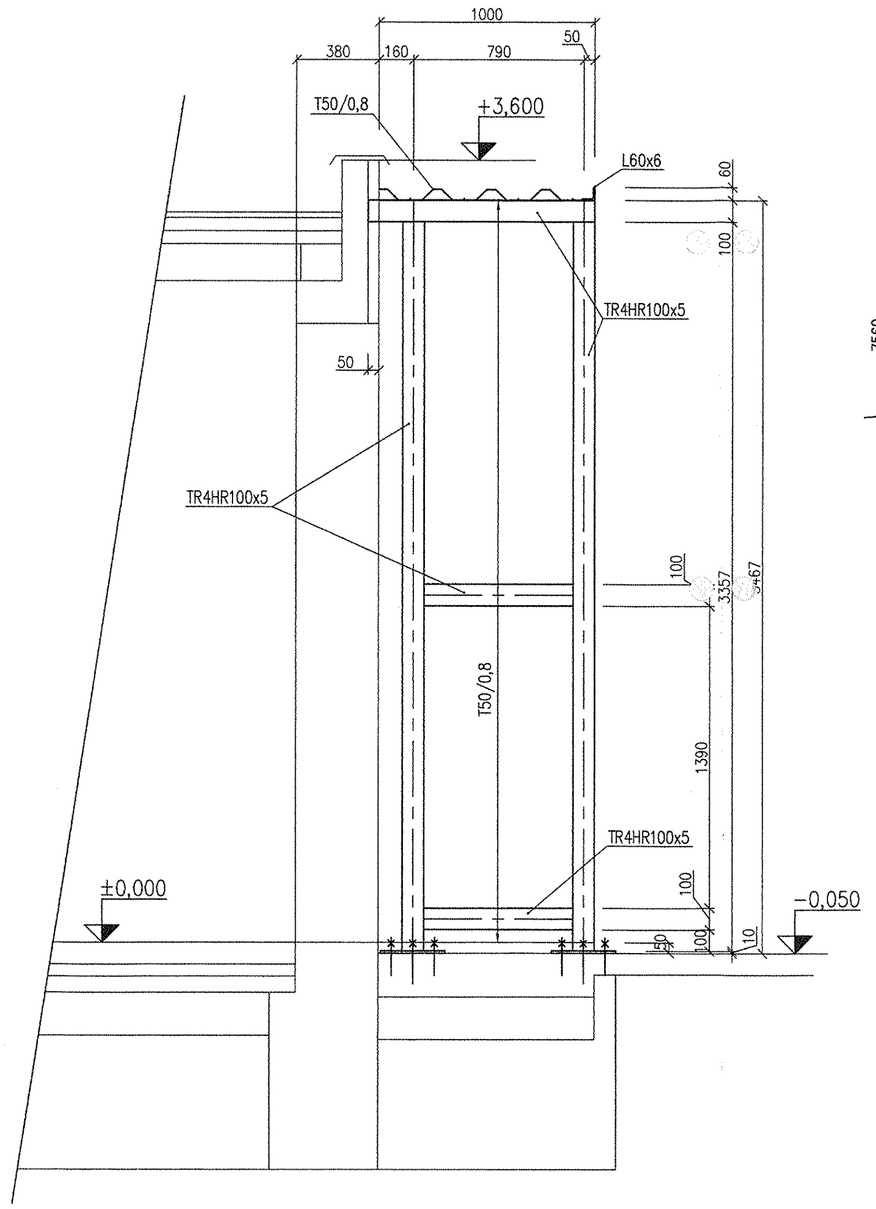

DETAIL "a"

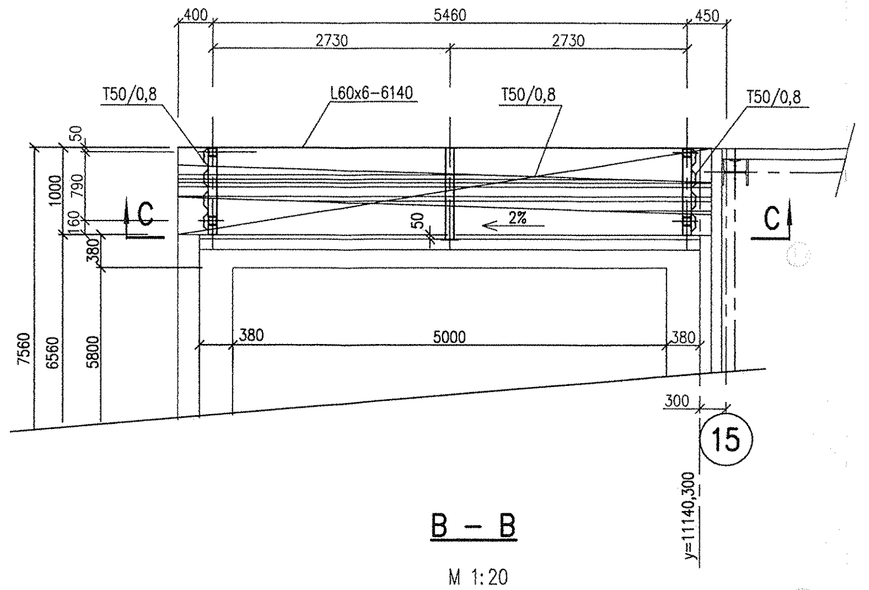

B – B

M 1:20

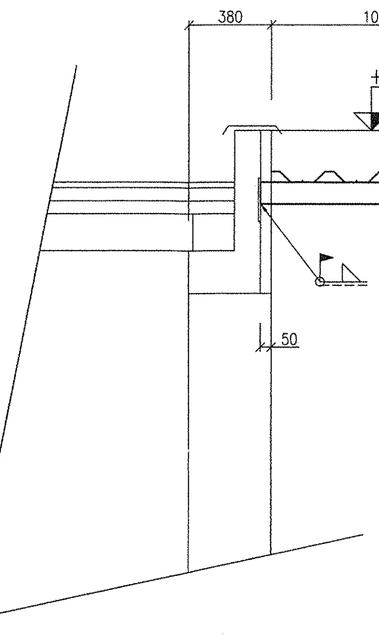

PÔDORYS
GROUNDPLANE

M 1:200

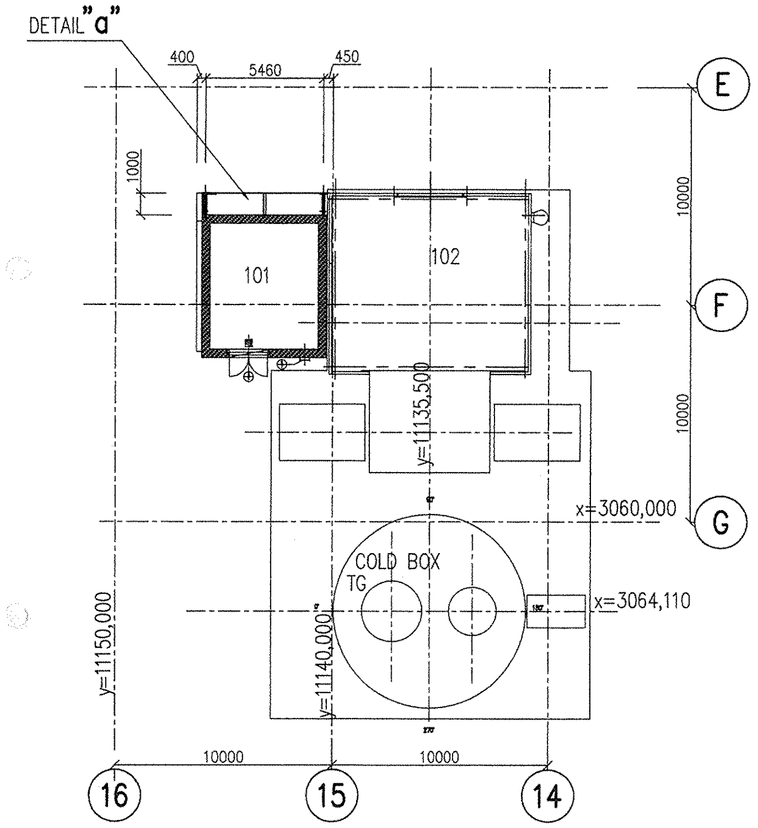

KOTVENIE
ANCHORING

M 1:10

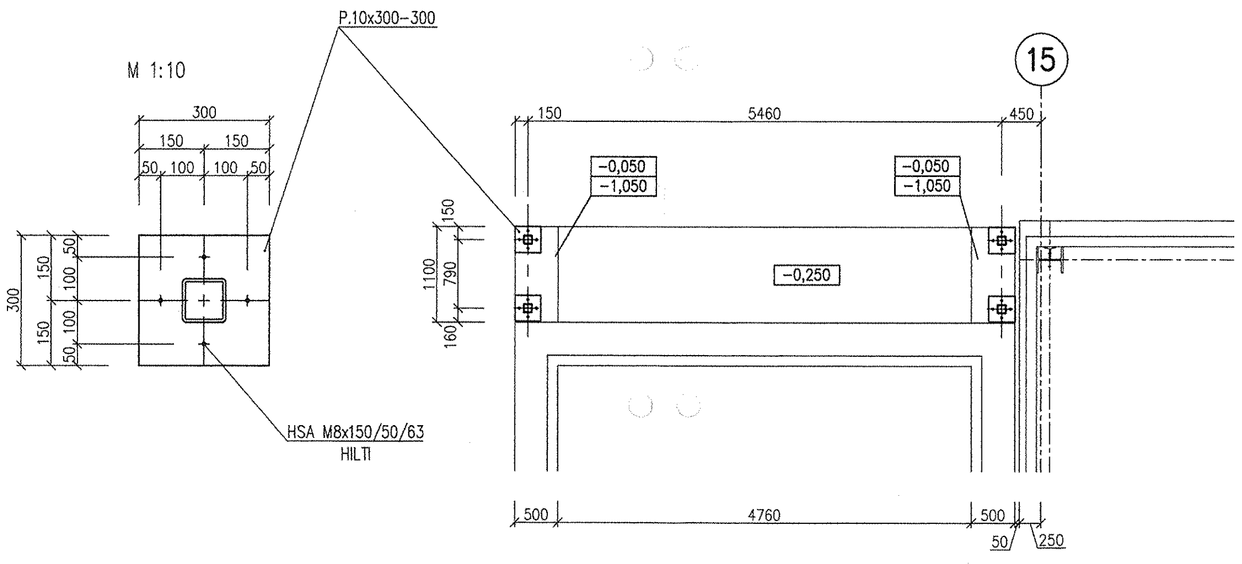

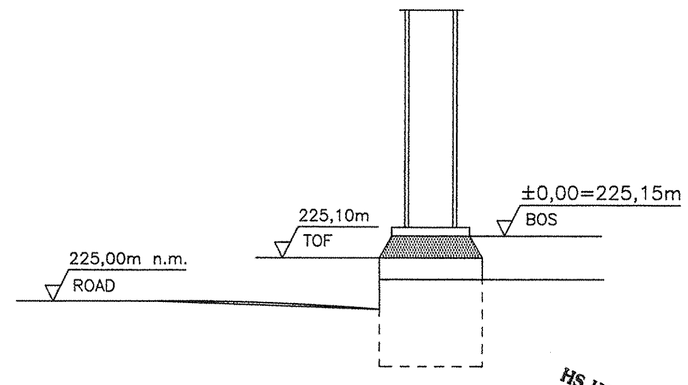

HS HSV s.r.o. KOŠICE
Technický úsek

LEVELS

TOP OF INTERNAL ROADS:

TOP OF FOUNDATION:

BOTTOM OF STEEL STRUCTURE OR EQUIPMENT: 225,15m = ±0,00

PLANT NORTH

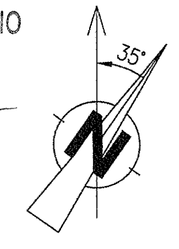

PROJEKT SKUTOČNÉHO VYHOTOVENIA

FREIGABE FOR CONSTRUCTION 14.6.2005

±0,000=225,15 m n. m. Jadran

PROJEKT PRE REALIZÁCIU STAVBY POD z. č. 3821.2.001.OK–02

HPK engineering a.s.	C				
	B				
	A				
	DATE	NAME	CHECKED	HISTORY FILE	
AIR LIQUIDE	0 13.06.2005	ING.ĎURAŠKOVÁ	ING.PAVLIČKO	REAL.PROJEKT/CONSTRUCTION DESIGN	
	JOB CODE: K70101			SCALE 1:100	ORIGINAL FORMAT 8xA4
	REFERENCE: ASU No. 9 KOŠICE			SHEET: 002	OF 003 SHEETS
REPLACES: 79_____	TITLE: UNIT 6 AIR SEPARATION – CONSTRUCTION DESIGN–BUILDING PART 1 SO 001 NÍZKOTEPLOTNÝ BLOK SO 001 LOW TEMPERATURE BLOCK OK PRE ANALYTICKÚ MIESTNOSŤ–STEEL STRUCTURE FOR ANALYTIC ROOM			DRAWING NO.: 792.87437	REV. 0
REPLACED BY: 79_____					

This drawing is protected by copyright.
It may not be copied or used without our written authorization and it is strictly prohibited to disclose it to any third parties.