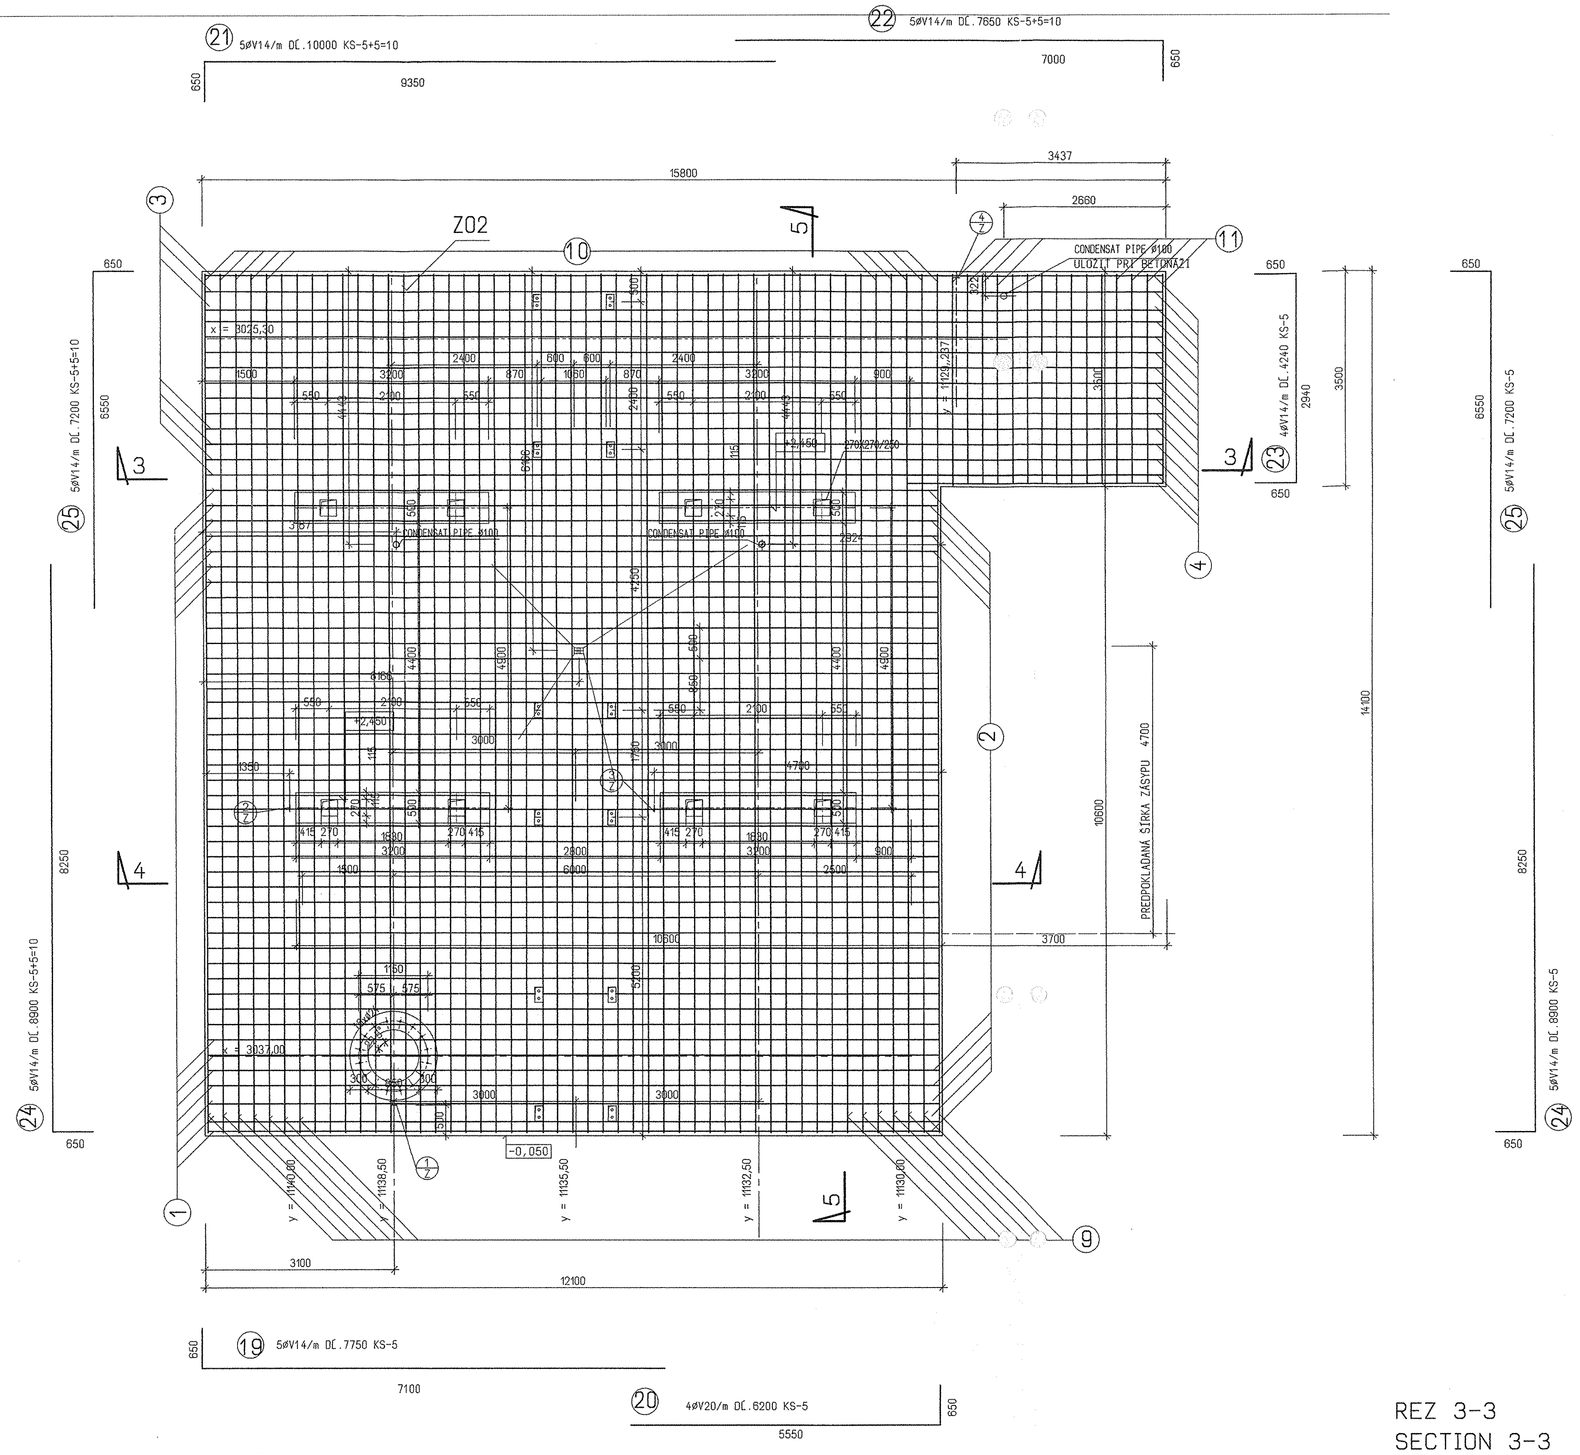

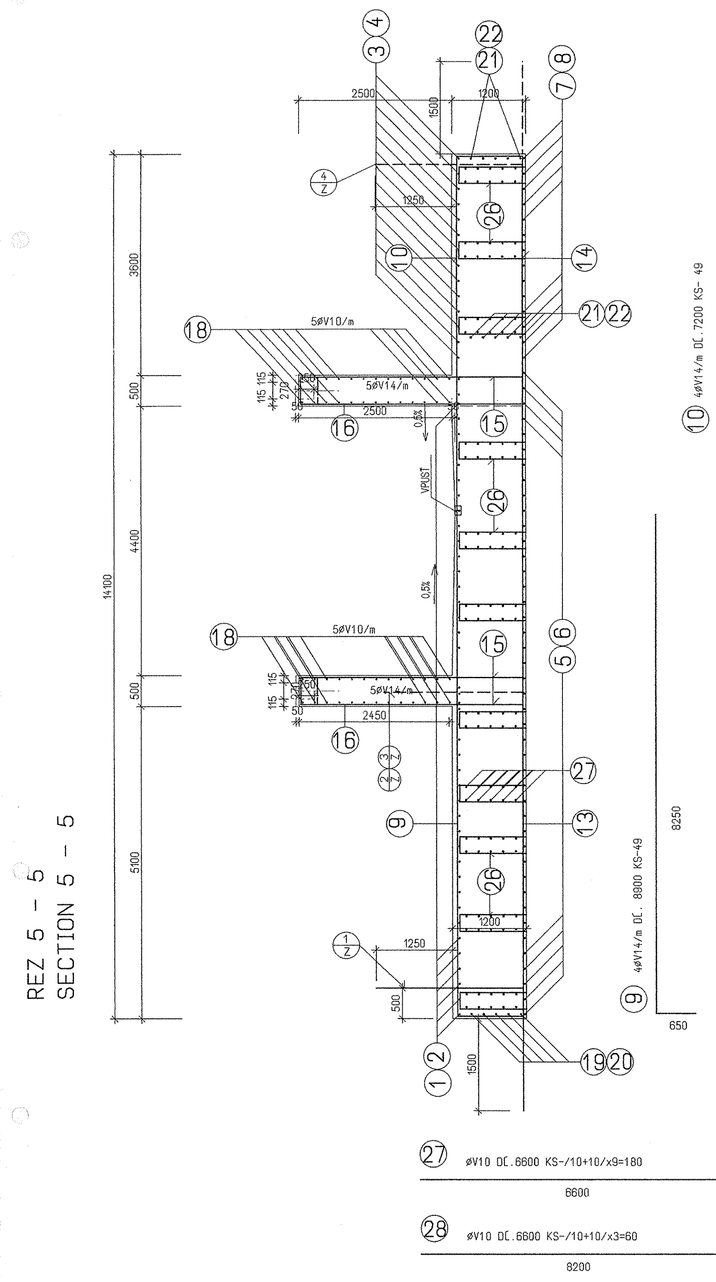

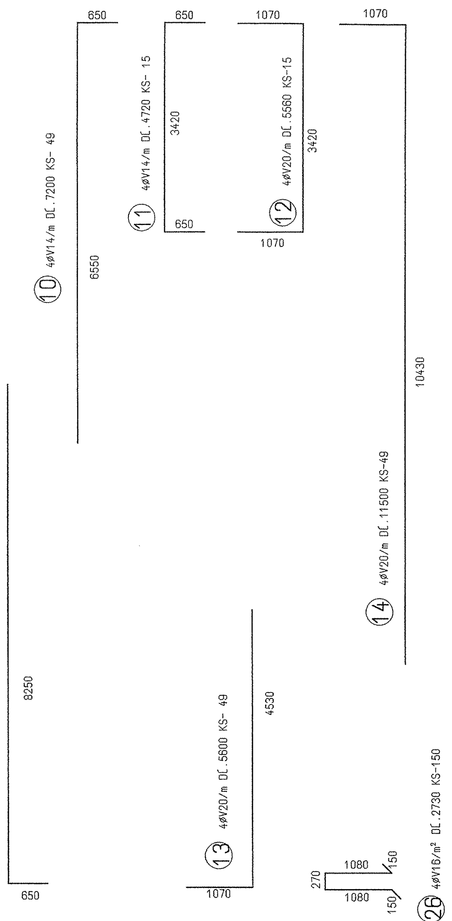

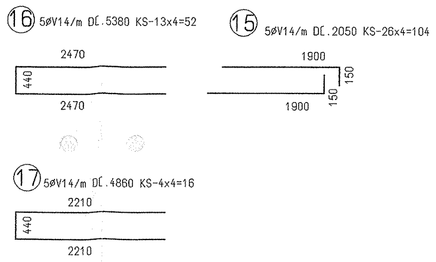

VÝKAZ VÝSTUŽE

	POL.	Ø mm	DĹŽKA bm	POČET AMOUNT KS	DĹŽKA CELKOM /bm			
					Ø V10	Ø V14	Ø V16	Ø V20
Z02	1	V14	7,75	43		333,25		
	2	V14	6,2	43		266,6		
	3	V14	10,0	14		140,0		
	4	V14	7,65	15		114,75		
	5	V14	7,50	43		322,5		
	6	V14	7,50	43		322,5		
	7	V14	7,5	14		105,0		
	8	V14	11,0	15		165,0		
	9	V14	8,9	49		436,1		
	10	V14	7,2	49		352,8		
	11	V14	4,72	15		70,8		
	12	V20	5,56	15				83,4
	13	V20	5,6	49				274,4
	14	V20	11,5	49				563,5
	15	V14	2,05	104		213,2		
	16	V14	5,38	52		279,76		
	17	V14	4,86	16		77,76		
	18	V10	3,96	104	411,84			
	19	V14	7,75	5		38,75		
	20	V14	6,20	5		31,0		
	21	V14	10,0	10		100,0		
	22	V14	7,65	10		76,5		
	23	V14	4,24	5		21,2		
	24	V14	8,9	10		89,0		
	25	V14	7,2	10		72,0		
	26	V18	2,73	150			409,5	
	27	V10	6,6	240	1584,0			
DĹŽKA CELKOM					1995,84	3628,47	409,5	921,3
HMOTNOSŤ 1BM/WEIGHT PER 1M					0,817	1,21	1,58	2,47
HMOTNOSŤ SPOLU V kg					1231,43	4390,44	647,01	2275,6

OCEĽ STEEL GRADE /V/ 10425
BETÓN /CONCRETE GRADE: C20/25/B25/

UPOZORNENIE : V PRÍPADE PRECHODU VÝSTUŽE CEZ KOTVIACI OTVOR SA VÝSTUŽ POSUNIE K OKRAJU OTVORU

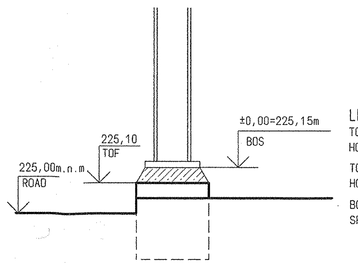

LEVELS
TOP OF INTERNAL ROADS: 225,00m.n.m.
HORNÁ ÚROVEŇ VNÚTORNÝCH CIEST 225.00n.m.
TOP OF FOUNDATION: 225,10m
HORNÁ ÚROVEŇ ZÁKLADOV 225,10m
BOTTOM OF STEEL STRUCTURE: 225,15m=±0,00
SPODNÁ ÚROVEŇ OK:225,15m=±0,00

HS HSV s.r.o. KOŠICE Technický úsek

FREIGABE FOR CONSTRUCTION
Re 21.04.05

SEVER NORTH

±0,000=225,15 m n.m. Jadran

PROJEKT SKUTOČNÉHO VYHOTOVENIA

PROJEKT PRE REALIZÁCIU STAVBY SPRACOVANÝ PRÍ Č.č.3821.2.003.AS-06

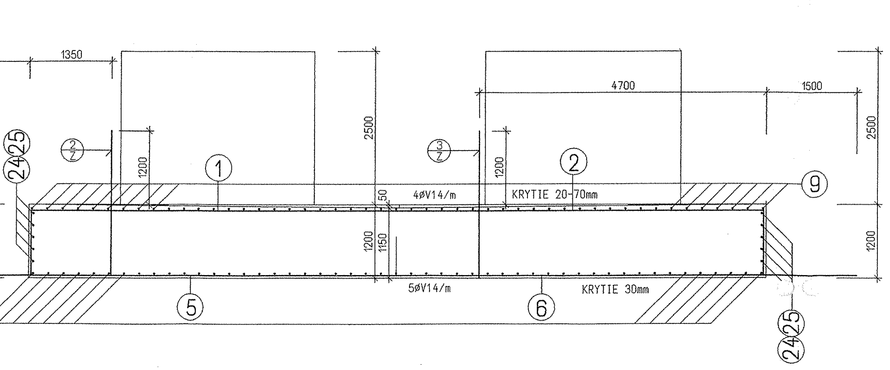

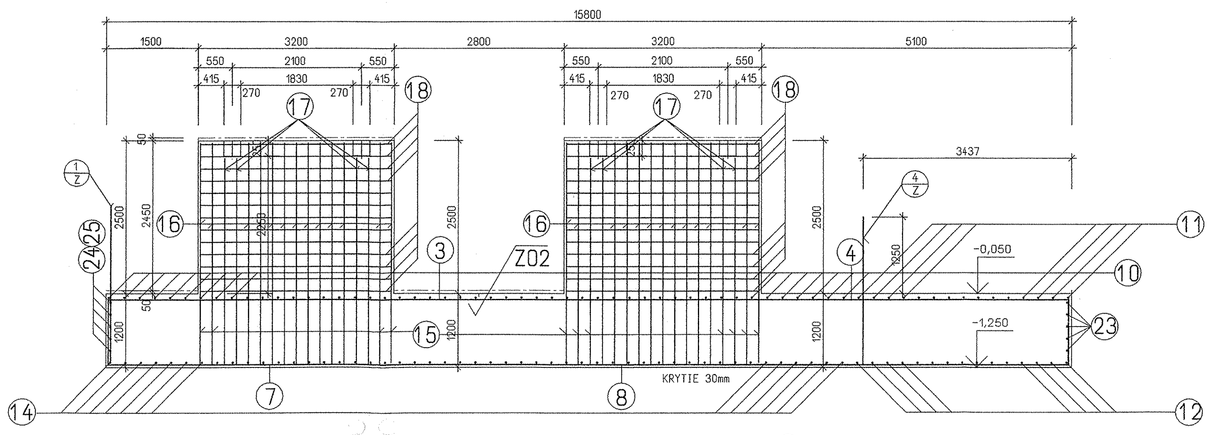

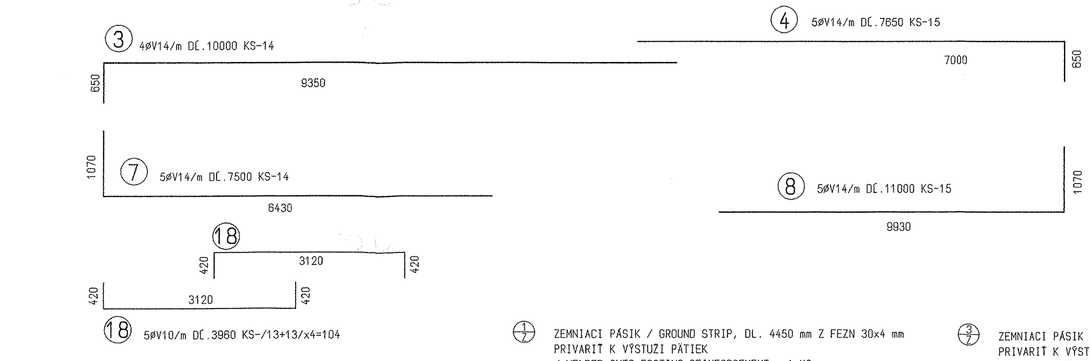

⊕ ZEMNIACI PÁSIK / GROUND STRIP, DL. 4450 mm Z FEZN 30x4 mm PRIVARIŤ K VÝSTUŽI PÄTIEK / WELDED ONTO FOOTING REINFORCEMENT - 1 KS - CELKOVÁ DĹŽKA / TOTAL LENGTH / - 4,45 bm

⊕ ZEMNIACI PÁSIK / GROUND STRIP, DL. 5250 mm Z FEZN 30x4 mm PRIVARIŤ K VÝSTUŽI PÄTIEK / WELDED ONTO FOOTING REINFORCEMENT - 1 KS - CELKOVÁ DĹŽKA / TOTAL LENGTH / - 5,25 bm

⊕ ZEMNIACI PÁSIK / GROUND STRIP, DL. 7400 mm Z FEZN 30x4 mm PRIVARIŤ K VÝSTUŽI PÄTIEK / WELDED ONTO FOOTING REINFORCEMENT - 1 KS - CELKOVÁ DĹŽKA / TOTAL LENGTH / - 7,40 bm

⊕ ZEMNIACI PÁSIK / GROUND STRIP, DL. 3950 mm Z FEZN 30x4 mm PRIVARIŤ K VÝSTUŽI PÄTIEK / WELDED ONTO FOOTING REINFORCEMENT - 1 KS - CELKOVÁ DĹŽKA / TOTAL LENGTH / - 3,95 bm

HPK engineering a.s.	B	11.04.2005	HUŽVÁR	ING. PAVLIČKO	REVISION GROUND STRIP
	A	31.03.2005	HUŽVÁR	ING. PAVLIČKO	
	Rev.	Date :	Name :	Checked:	History file:
AIR LIQUIDE	Job code: K70101			Scale 1:50	Original format DIN A0
	Reference: ASU No. 9 KOŠICE			Sheet: 004	of 010 Sheets
Replaces: 79_-_____	Title: UNIT 7- FRONT END			Drawing No.:	Rev.
Replaced by: 79_-_____	SO 003 PRÍPRAVA VZDUCHU / 003 AIR PREPARATION / VÝSTUŽ ZÁKLADU Z02 /DRAWING OF REINFORCEMENT Z02			792.87456	B

This drawing is the property of AIR LIQUIDE. It must not be communicated, reproduced or used without written authorization. / S M4841.0 / 1189.0 (1.00m2) 15 16 ALLPLAN FT