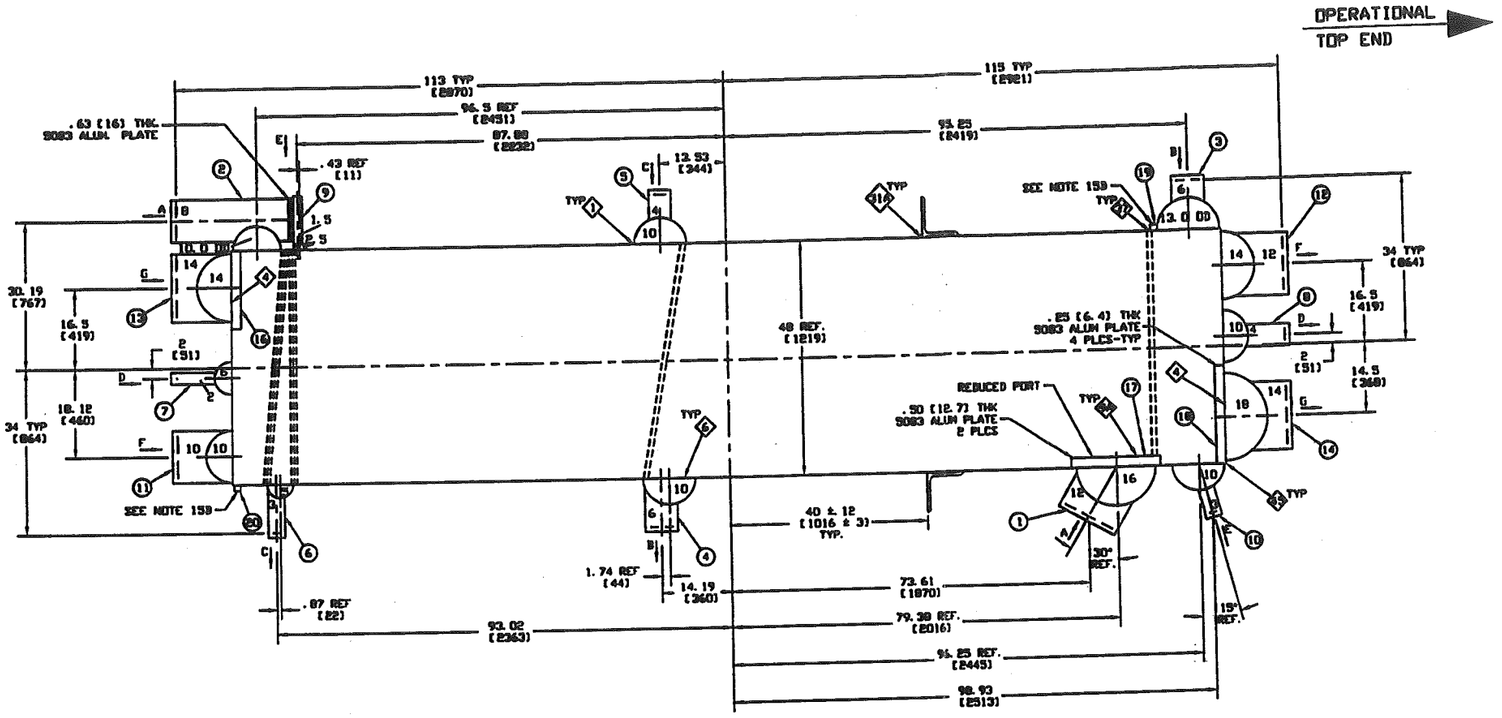

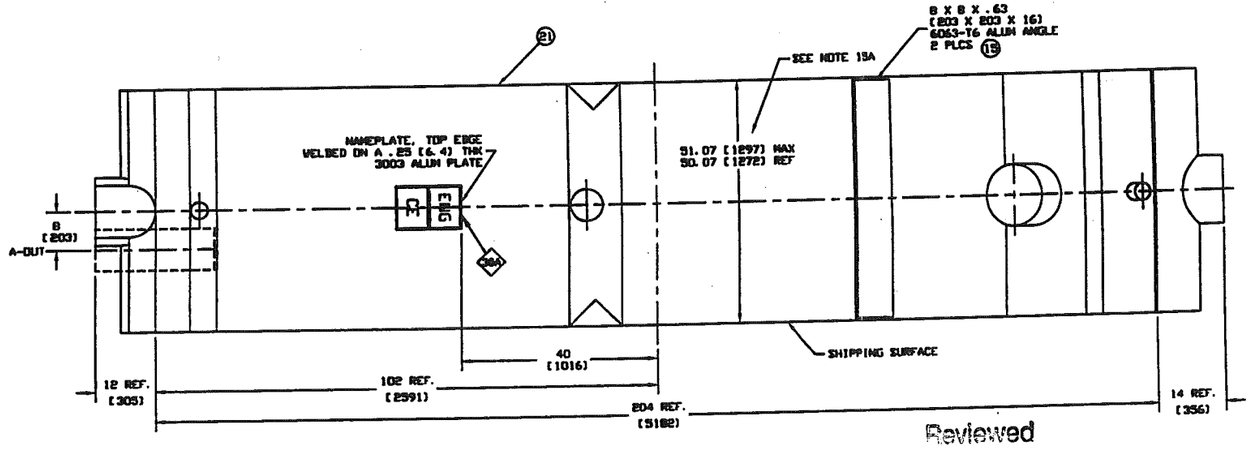

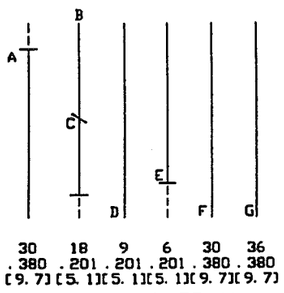

FLOW DIAGRAM

STREAM	INLET		OUTLET	
	HEADER O.D. X WALL	NOZZLE O.D. X WALL	HEADER O.D. X WALL	NOZZLE O.D. X WALL
A (HP-AIR)	16.000 X .375 (406 X 9.5)	12.750 X .375 (324 X 9.5)	10.000 X .250 (254 X 6.4)	8.625 X .322 (219 X 8.2)
B (HP-AIR)	13.000 X 1.000 (330 X 25.4)	6.625 X .432 (168 X 11.0)	10.750 X .750 (273 X 19.1)	6.625 X .432 (168 X 11.0)
C (HPC-AIR)	10.750 X .750 (273 X 19.1)	4.500 X .237 (114 X 6.0)	5.563 X .375 (141 X 9.5)	3.500 X .216 (89 X 5.5)
D (HP-GOO)	6.625 X .375 (168 X 9.5)	2.375 X .154 (60 X 3.9)	10.750 X .500 (273 X 12.7)	4.500 X .237 (114 X 6.0)
E (HP-GAN)	2.875 X .203 (73 X 5.2)	1.900 X .145 (48 X 3.7)	10.750 X .375 (273 X 9.5)	3.500 X .216 (89 X 5.5)
F (LP-GAN)	10.750 X .250 (273 X 6.4)	10.750 X .365 (273 X 9.3)	14.000 X .250 (356 X 6.4)	12.750 X .375 (324 X 9.5)
G (WD)	14.000 X .250 (356 X 6.4)	14.000 X .250 (356 X 6.4)	18.000 X .250 (457 X 6.4)	14.000 X .250 (356 X 6.4)

ALL MATERIAL IN TABLE ABOVE IS 5083 ALUMINUM

Reviewed
Tüv Süddeutschland Bau und Betrieb GmbH
... to Pressure
... Equipment Directive 97/23/EC
... Testing Laboratory
MAR 29 2005

NOTES:

1. REFER TO BRAL-IOM FOR INSTALLATION, OPERATION AND MAINTENANCE INSTRUCTIONS. ABUSE OR FAILURE TO COMPLY WITH REQUIREMENTS PARTICULARLY OPERATING CONDITIONS TO PREVENT ENDS FREEZING, THERMAL SHOCK AND OPERATION ENTIRE DESIGN TEMPERATURE RANGE. REFER TO DRAWING 910-6847 FOR VERTICAL HEAT EXCHANGER LIFTING INSTRUCTIONS AND DRAWING 910-6871 FOR INSTRUCTIONS ON ROLLING HEAT EXCHANGER TO SIDE OTHER THAN SHIPPING SURFACE.
2. CUSTOMER TO DRILL APPROPRIATE HOLES OR SLOTS IN SUPPORT ANGLES FOR MOUNTING HEAT EXCHANGER AS DESCRIBED IN BRAL-IOM.
3. HEAT EXCHANGER DESIGNED, CONSTRUCTED, AND STAMPED PER THE LATEST MANDATORY EDITION AND ADDENDA OF THE ASME PRESSURE VESSEL CODE, SECTION VIII, DIV. 1 AND REGISTERED WITH THE NATIONAL BOARD.
4. CORROSION ALLOWANCE: ALUMINUM = 0.0000 INCHES
5. SEE DRAWING 15770C FOR MAXIMUM ALLOWABLE PIPE LOADS.
6. THE NOZZLES AND NOZZLES ARE LABELED ON THE DRAWING WITH THEIR NOMINAL PIPE SIZE (NPS). IF A STANDARD SIZE IS NOT USED THE PIPING IS LISTED AT ITS ACTUAL OUTSIDE DIAMETER AND LABELED "OD". UNLESS SHOWN OTHERWISE ALL NOZZLES ARE ON THE HEAT EXCHANGER CENTERLINE.
7. TOLERANCE ON ALL DIMENSIONS IS +/- .03 INCH [1] UNLESS OTHERWISE NOTED. ANGULAR TOLERANCE ON NOZZLES IS CONTROLLED BY THE TOLERANCE ON THE CARTESIAN COORDINATE DIMENSIONS (X, Y, Z). IN NO CASE SHALL THE ANGULAR TOLERANCE EXCEED 3 DEGREES.
8. STREAM A B C D E F G
   MAWP (PSIG) [BARG] 189 [12.5] 914 [63.0] 914 [63.0] 580 [40.0] 435 [30.0] 29 [2.0] 29 [2.0]
   DESIGN TEMP DEG. F + 150 MAX. - 380 MIN.
   (C) + [65]MAX. -[196]MIN.
9. TESTING INFORMATION:

INJECTIVE AREAS - 15 PSIG [1.03 BARG]							
STREAM FIRST AIR	(PSIG) [BARG]	A 25 [2.5]	B 50 [3.4]	C 50 [3.4]	D 50 [3.4]	E 50 [3.4]	F 10 [.7]	G 10 [.7]
PRETEST W/ WATER	(PSIG) [BARG]	— —	1371 [94.5]	1371 [94.5]	870 [60.0]	653 [45.0]	— —	— —
(OPTIONAL)	(PSIG) [BARG]	164 [11.3]	1005 [69.3]	1005 [69.3]	638 [44.0]	479 [33.0]	44 [3.0]	44 [3.0]
LEAK	(PSIG) [BARG]	189 [7.5]	914 [63.0]	914 [63.0]	580 [40.0]	435 [30.0]	SEE NOTES 18A	SEE NOTES 18B

   = A.I. WITNESS REQUIRED.
   MAXIMUM DRYING TEMP 250 DEG F. [121 DEG C.]

HELIUM VACUUM LEAK TEST STREAMS	MAX. ALLOW. LEAKAGE
A	1.0 E-3 STD CC/SEC. [1.0 E-3 MBAR - L/SEC]
B	1.0 E-3 STD CC/SEC. [1.0 E-3 MBAR - L/SEC]
C	1.0 E-3 STD CC/SEC. [1.0 E-3 MBAR - L/SEC]
D	1.0 E-3 STD CC/SEC. [1.0 E-3 MBAR - L/SEC]
E	1.0 E-3 STD CC/SEC. [1.0 E-3 MBAR - L/SEC]
F	1.0 E-3 STD CC/SEC. [1.0 E-3 MBAR - L/SEC]
G	1.0 E-3 STD CC/SEC. [1.0 E-3 MBAR - L/SEC]

10. THE "B" STREAM TO BE CLEANED FOR OXYGEN SERVICE.
11. CONNECTIONS TO BE SUITABLY MARKED FOR FIELD TRIM.
12. UNIT TO SHIP WITH DRY AIR AT 5 PSIG [.34 BARG] IN ALL STREAMS. GAUGES ARE REQUIRED.
13. ESTIMATED WEIGHT = 19600 LBS. (DRY)
    (7900 KG)
    39800 LBS. (FILLED WITH WATER)
    (18056 KG)
    (WARNING DO NOT HYDRO TEST IN FIELD WITH WATER)
14. STREAM VOLUME:

STREAM	A	B	C	D	E	F	G
CU.FT.	91.1	9.6	6.3	7.9	5.2	56.4	69.5
(CU.M.)	[1.45]	[.27]	[1.8]	[.22]	[.15]	[1.59]	[1.97]

15. CUSTOMER NOTE:
    A. ESTIMATED BRAZE HEIGHT. ACTUAL BRAZE HEIGHT MAY VARY +/- .12 INCH/FOOT [+/- 10 MM/M] OF BRAZE HEIGHT. MAX DIMENSION INCLUDES TOLERANCE ON BRAZE HEIGHT PLUS HEADER ATTACHMENT PLATES.
    B. CUSTOMER TO REMOVE PLASTIC PLUGS FOLLOWING INSTALLATION AND JUST PRIOR TO INSULATING UNIT.
16. CUSTOMER REQUIREMENT:
    A. ONE MITERED END PIECE JOINT TO BE SPOT RADIOGRAPH INSPECTED PER ASME PRESSURE VESSEL CODE, SECT. VIII, DIV. 1, PAR. UW-52.
    B. ALL LONGITUDINAL NOZZLE JOINTS TO BE 100% RADIOGRAPH INSPECTED PER ASME PRESSURE VESSEL CODE, SECT. VIII, DIV. 1, PAR UW-51.
    C. ALL WELDS TO BE 100% DYE PENETRANT EXAMINED PER ASME CODE, SECTION VIII, DIVISION 1.
    D. UNIT TO BE SHRINK WRAPPED IN PLASTIC W/DESICCANT.
17. PED NOTE:
    A. HEAT EXCHANGER TO COMPLY WITH EU PED 97/23/EC; ASSESSMENT MODULE "B & D"
    B. PED NOTIFIED BODY IS TUV INDUSTRIE SERVICE GMBH, SUD GRUPPE.
    C. ASSESSMENT CATEGORY IS "IV". ALL WORKING FLUIDS ARE GROUP 1.
18. PRODUCTION NOTES:
    A. INSTALL TWO RELIEF VALVES NOT EXCEEDING 74 PSIG [5.1 BARG] ON F STREAM.
       PERFORM LEAK TEST AT 29 PSIG [2.0 BARG].
       REMOVE RELIEF VALVES AFTER TEST.
       PRIOR TO SHIPMENT.
    B. INSTALL TWO RELIEF VALVES NOT EXCEEDING 74 PSIG [5.1 BARG] ON G STREAM.
       PERFORM LEAK TEST AT 29 PSIG [2.0 BARG].
       REMOVE RELIEF VALVES AFTER TEST.
       PRIOR TO SHIPMENT.

REVISION RECORD			
	A	B	
ADDED PRODUCTION SYMBOLS. A-IN HDR WAS 12.75 X .250W. UPDATED ESTIMATED WEIGHT AND A-STREAM TITLE. A-STREAM WAS 16 C-OUT NOZZLES A-OUT HDR WAS 9.0 O.D. A-OUT STRAIGHT OUT.		1-17-05 ECO 3982	RSMITH
		REVISED NOTE 17B ECO 3983	RSMITH
		3-18-05	

BY	SMITH	STD ENGR SPEC 11-6.89
DATE	11-3-04	
CHKD	EBERT	NOTE 9: SEE 9-8.01 PARA 1.2, 1.3, 1.3.2 & 4.1
DATE	11-15-04	
PROD ENG	GOETHEL	NOTE 10: SEE 9-14.00
DATE	11-17-04	
MFG ENG		THIRD ANGLE PROJECTION
DATE		
WELD ENG		
DATE		

CHART HEAT EXCHANGERS, LP. ALL RIGHTS RESERVED
THIS DRAWING AND INFORMATION ARE THE CONFIDENTIAL PROPERTY OF CHART HEAT EXCHANGERS, LP. WITHOUT LIMITING THE FOREGOING NEITHER IT NOR ANY PART OF IT SHALL BE COPIED, USED OR DISCLOSED TO OTHERS WHOLLY OR IN PART.
© CHART HEAT EXCHANGERS, LP. ALL RIGHTS RESERVED

LEGEND
○ PART NUMBER (PRODUCTION USE ONLY)
◇ JOINT DETAIL-REF. (PRODUCTION USE ONLY)
□ FIN DATA INFORMATION
△ DIMENSIONAL REVISION
⬠ SPECIAL NOTATION

DIMENSIONS: PRIMARY IN INCHES, SECONDARY IN [MM] OR [DEG]

Chart He

BRAZED ALUMI
HEAT EXCHANG
7 STREAM PLATE
ITEM NO. V20000

SIZE: D | DWG NO: 15770A

509.8 (4) 11/04